


LEGEND	
	LIMITS OF SOIL DISTURBANCE
	DISTURBED AREAS REQUIRING RE-VEGETATION
	1'-0" STONE FILL, TYPE I
	RIPARIAN BUFFER ZONE

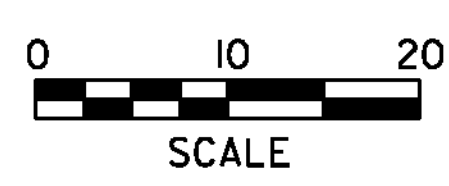

EPSC FINAL CONDITIONS SITE PLAN

PROJECT NAME: BRIDPORT	PLOT DATE: 10/7/2010
PROJECT NUMBER: STP CULV(2)	DRAWN BY: E. ALLING
FILE NAME: ...\\14-erosion controlsheets.dgn	CHECKED BY: G. BOGUE
PROJECT LEADER: G. BOGUE	
DESIGNED BY: M. CHENETTE	
EPSC FINAL CONDITIONS SITE PLAN	SHEET 10 OF 14