

646.402 DURABLE 4 INCH WHITE LINE, THERMOPLASTIC
 (ALL LINES WILL INCLUDE EDGE LINE BREAKS
 AND RADII FOR SIDE ROADS)
 STA. 68+85 TO 72+00, SOLID LT & RT


646.412 DURABLE 4 INCH YELLOW LINE, THERMOPLASTIC
 (ALL LINES WILL INCLUDE G BREAKS FOR SIDE ROADS)
 STA. 68+85 TO 72+00, SOLID LT & RT

646.602 TEMPORARY 4 INCH WHITE LINE, PAINT
 (ALL LINES WILL INCLUDE EDGE LINE BREAKS
 AND RADII FOR SIDE ROADS)
 STA. 68+85 TO 72+00, SOLID LT & RT

646.612 TEMPORARY 4 INCH YELLOW LINE, PAINT
 (ALL LINES WILL INCLUDE G BREAKS FOR SIDE ROADS)
 STA. 68+85 TO 72+00, SOLID LT & RT

675.50 REMOVING SIGNS
 AS SHOWN - I

**BEGIN STP 2804(1) VT ROUTE 128
 WESTFORD STA. 68+85.12 = MM 1.304**


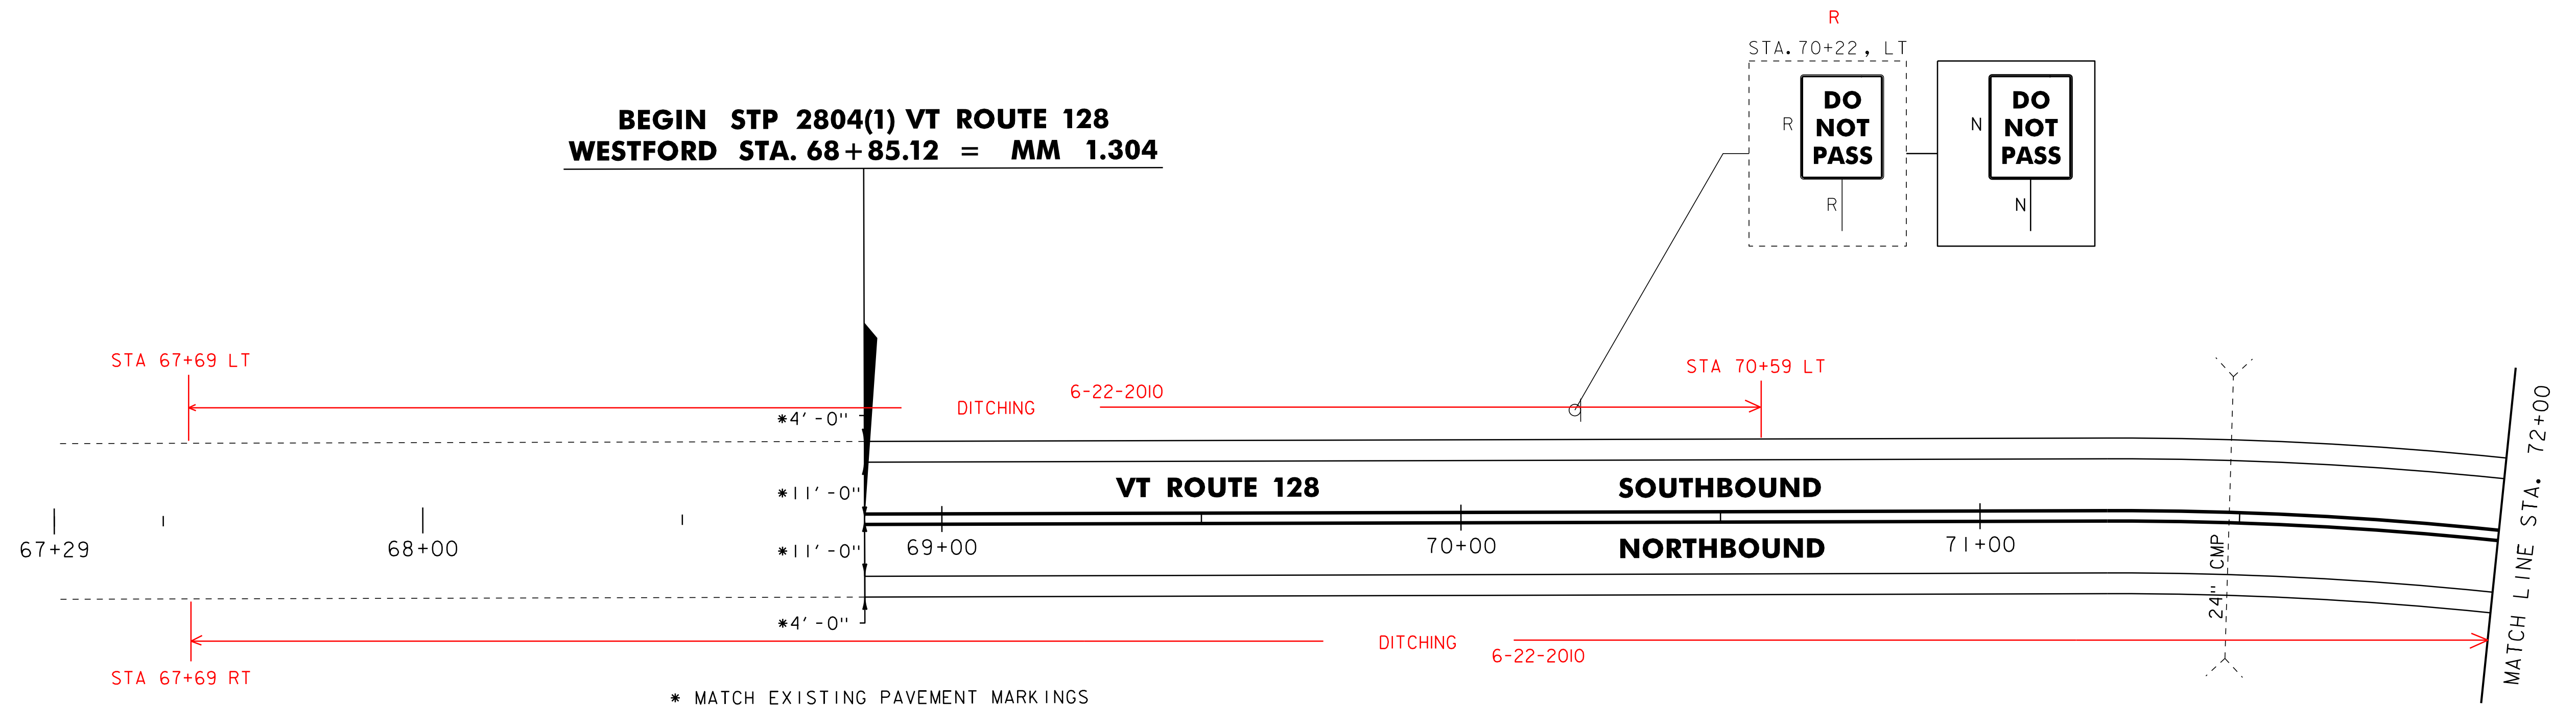


* MATCH EXISTING PAVEMENT MARKINGS

CURVE #1
 PC = 71+25
 PT = 72+67
 R = 716'
 $\Delta = 11^{\circ}23'28''$, RT
 D = 8'00'00"
 e = 3.55
 L = 142'
 SEE SUPERELEVATION
 BANKING DIAGRAM SHEET #1

R=1

NOTE:
 ALL EXISTING SIGNS NOT SHOWN SHALL BE RETAINED.
NOT TO SCALE

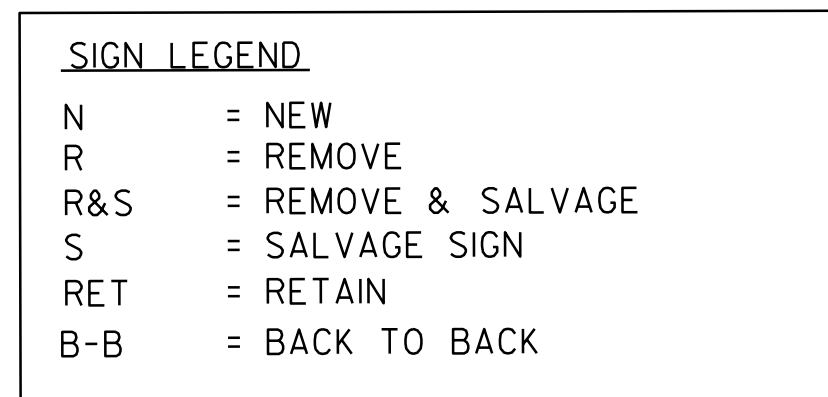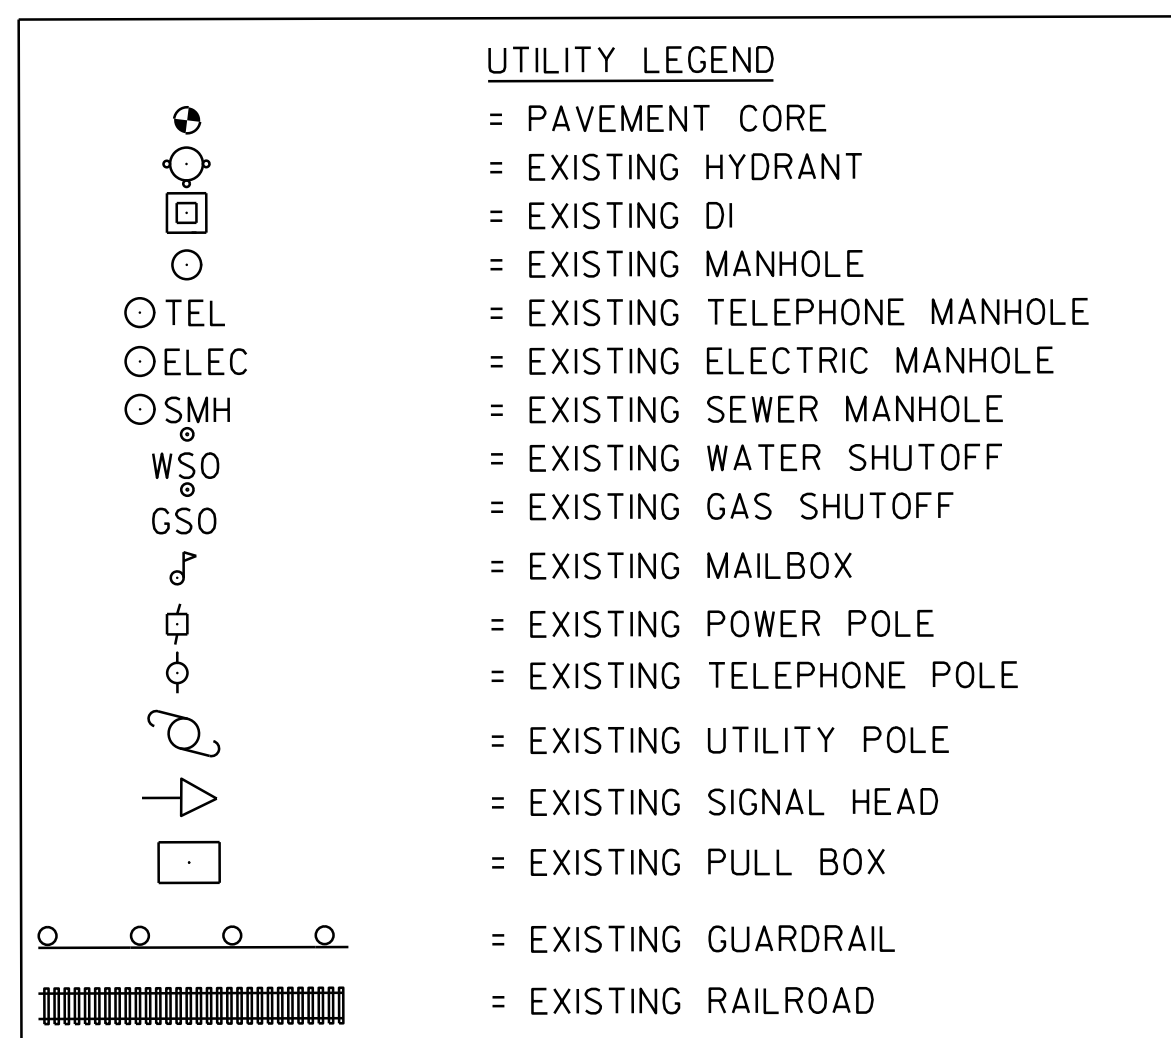

PROJECT LAYOUT SHEET #1

PROJECT NAME: WESTFORD - FAIRFAX
 PROJECT NUMBER: STP 2804(1)

FILE NAME: p08c212.dgn
 PROJECT LEADER: JLL
 DESIGNED BY: STANTEC
 IPARM FILE: p08c212101.i

PLOT DATE: 31-OCT-2012 13:57
 DRAWN BY: STANTEC
 CHECKED BY: JLL
 SHEET 17 OF 79