


646.402 DURABLE 4 INCH WHITE LINE, THERMOPLASTIC
 (ALL LINES WILL INCLUDE EDGE LINE BREAKS
 AND RADII FOR SIDE ROADS)
 STA. 84+00 TO 90+00, SOLID LT & RT

646.412 DURABLE 4 INCH YELLOW LINE, THERMOPLASTIC
 (ALL LINES WILL INCLUDE C BREAKS FOR SIDE ROADS)
 STA. 84+00 TO 90+00, SOLID LT, DASHED RT

646.602 TEMPORARY 4 INCH WHITE LINE, PAINT
 (ALL LINES WILL INCLUDE EDGE LINE BREAKS
 AND RADII FOR SIDE ROADS)
 STA. 84+00 TO 90+00, SOLID LT & RT

646.612 TEMPORARY 4 INCH YELLOW LINE, PAINT
 (ALL LINES WILL INCLUDE C BREAKS FOR SIDE ROADS)
 STA. 84+00 TO 90+00, SOLID LT, DASHED RT

675.50 REMOVING SIGNS
 AS SHOWN - 1

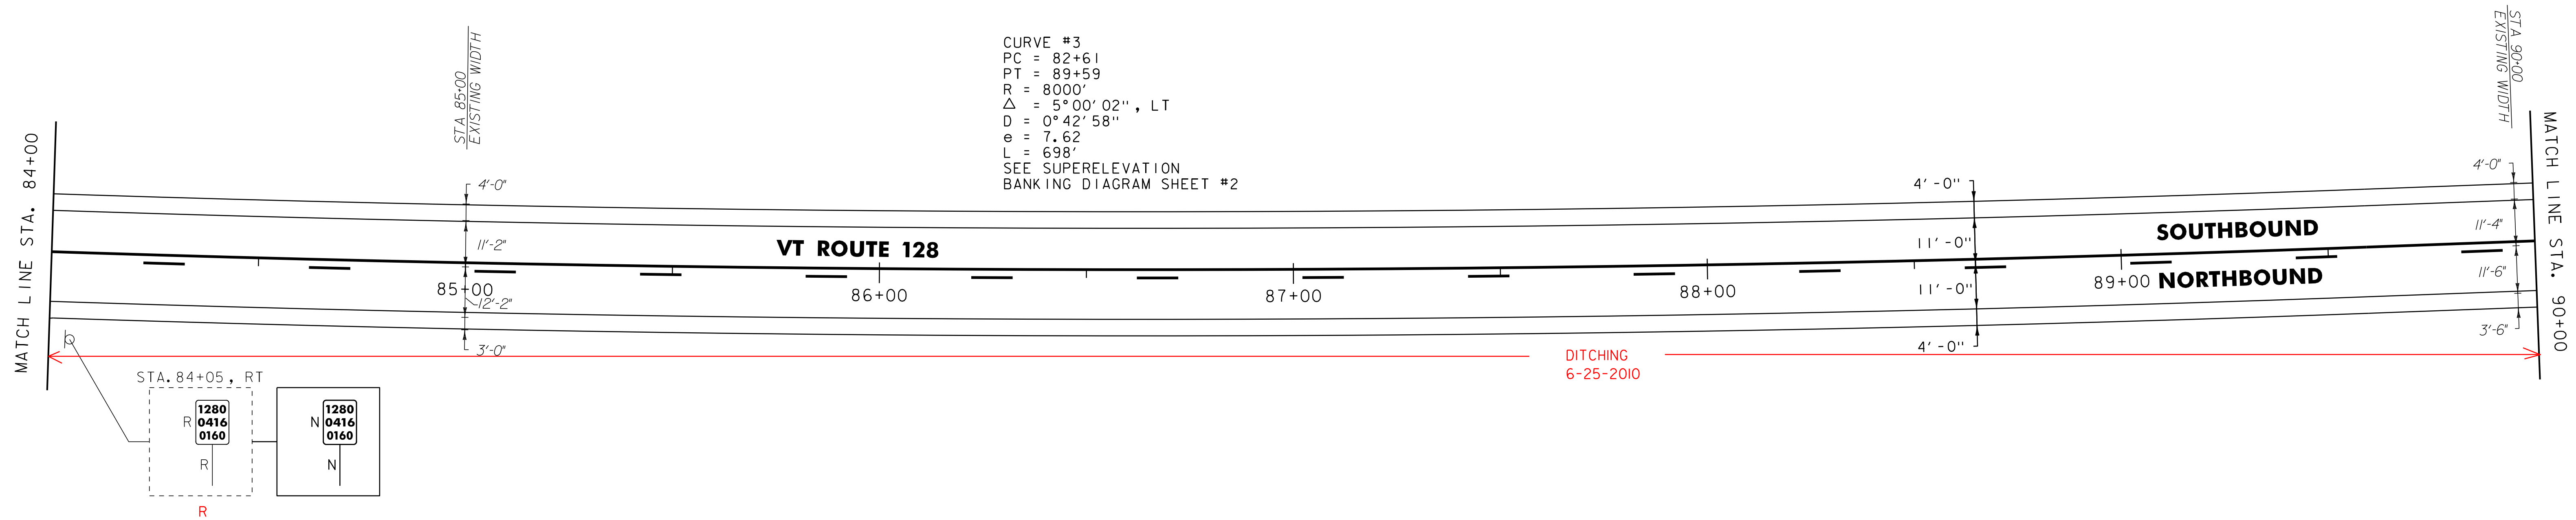


646.402 DURABLE 4 INCH WHITE LINE, THERMOPLASTIC
 (ALL LINES WILL INCLUDE EDGE LINE BREAKS
 AND RADII FOR SIDE ROADS)
 STA. 90+00 TO 96+00, SOLID LT & RT

646.412 DURABLE 4 INCH YELLOW LINE, THERMOPLASTIC
 (ALL LINES WILL INCLUDE C BREAKS FOR SIDE ROADS)
 STA. 90+00 TO 90+02, SOLID LT, DASHED RT
 STA. 90+02 TO 91+71, DASHED C
 STA. 91+71 TO 96+00, DASHED LT, SOLID RT

646.602 TEMPORARY 4 INCH WHITE LINE, PAINT
 (ALL LINES WILL INCLUDE EDGE LINE BREAKS
 AND RADII FOR SIDE ROADS)
 STA. 90+00 TO 96+00, SOLID LT & RT

646.612 TEMPORARY 4 INCH YELLOW LINE, PAINT
 (ALL LINES WILL INCLUDE C BREAKS FOR SIDE ROADS)
 STA. 90+00 TO 90+02, SOLID LT, DASHED RT
 STA. 90+02 TO 91+71, DASHED C
 STA. 91+71 TO 96+00, DASHED LT, SOLID RT

675.50 REMOVING SIGNS
 AS SHOWN - 1

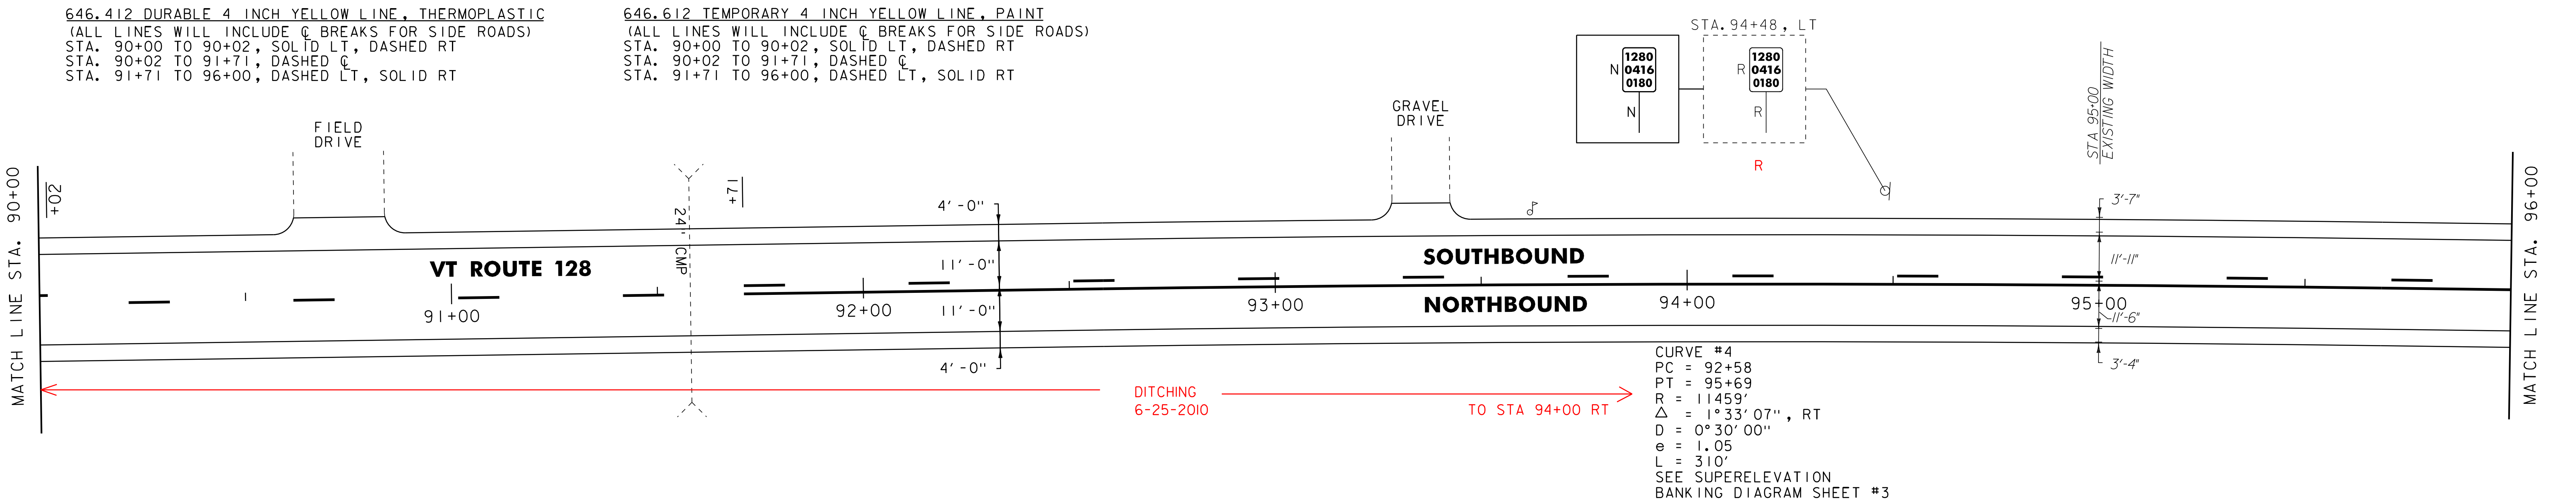

CURVE #4
 PC = 92+58
 PT = 95+69
 R = 11459'
 $\Delta = 1^{\circ}33'07''$, RT
 D = 0°30'00"
 e = 1.05
 L = 310'
 SEE SUPERELEVATION
 BANKING DIAGRAM SHEET #3

- NOTES:
 1. ALL EXISTING SIGNS NOT SHOWN SHALL BE RETAINED.
 2. FOR LEGENDS, SEE LAYOUT SHEET #1.

NOT TO SCALE

**PROJECT
 LAYOUT
 SHEET #3**

PROJECT NAME: WESTFORD - FAIRFAX
 PROJECT NUMBER: STP 2804(1)

FILE NAME: p08c212.dgn
 PROJECT LEADER: JLL
 DESIGNED BY: STANTEC
 IPARM FILE: p08c212103.i

PLOT DATE: 31-OCT-2012 13:57
 DRAWN BY: STANTEC
 CHECKED BY: JLL
 SHEET 19 OF 79

