


646.402 DURABLE 4 INCH WHITE LINE, THERMOPLASTIC
 (ALL LINES WILL INCLUDE EDGE LINE BREAKS
 AND RADII FOR SIDE ROADS)
 STA. 96+00 TO 102+00, SOLID LT & RT

646.412 DURABLE 4 INCH YELLOW LINE, THERMOPLASTIC
 (ALL LINES WILL INCLUDE C BREAKS FOR SIDE ROADS)
 STA. 96+00 TO 99+79, DASHED LT, SOLID RT
 STA. 99+79 TO 102+00, SOLID LT & RT

646.602 TEMPORARY 4 INCH WHITE LINE, PAINT
 (ALL LINES WILL INCLUDE EDGE LINE BREAKS
 AND RADII FOR SIDE ROADS)
 STA. 96+00 TO 102+00, SOLID LT & RT

646.612 TEMPORARY 4 INCH YELLOW LINE, PAINT
 (ALL LINES WILL INCLUDE C BREAKS FOR SIDE ROADS)
 STA. 96+00 TO 99+79, DASHED LT, SOLID RT
 STA. 99+79 TO 102+00, SOLID LT & RT

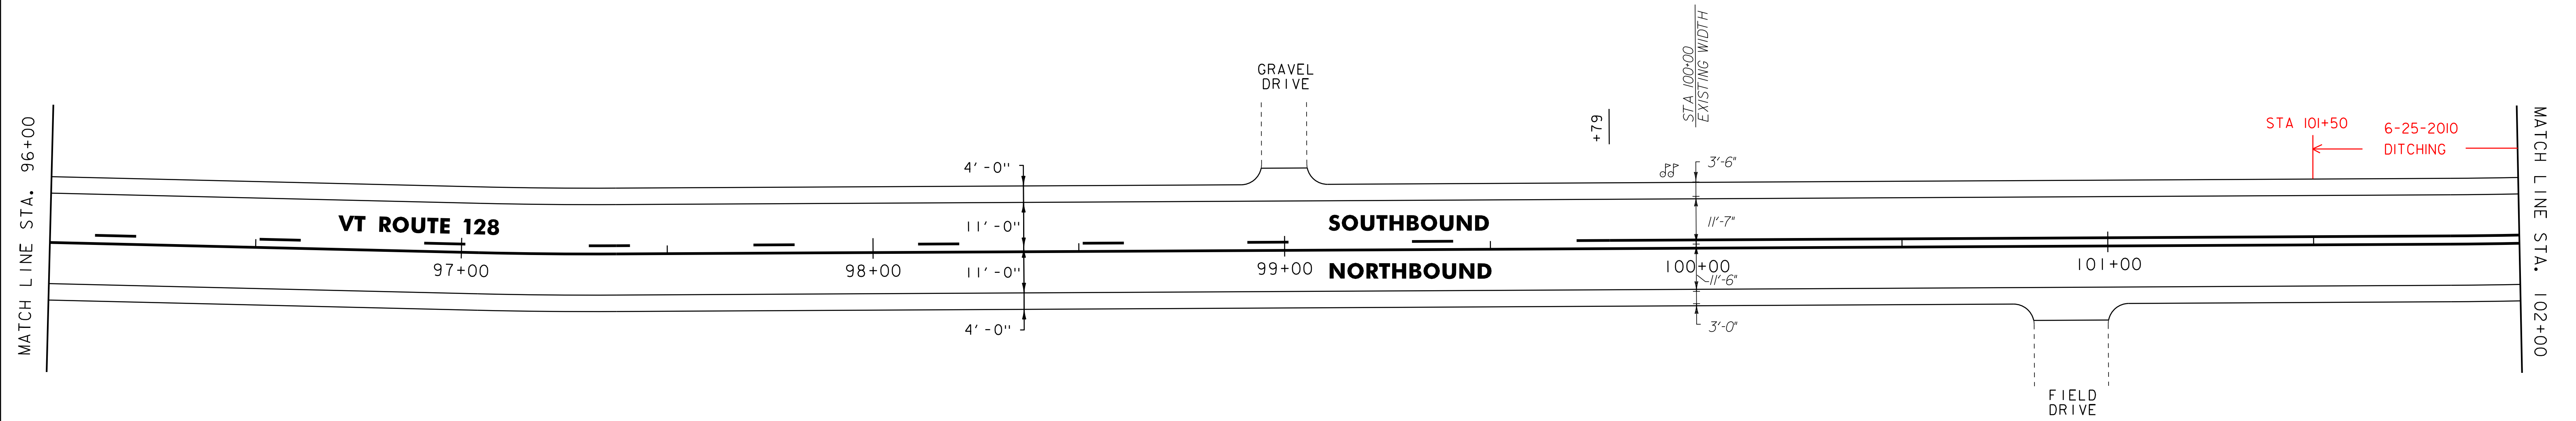


646.402 DURABLE 4 INCH WHITE LINE, THERMOPLASTIC
 (ALL LINES WILL INCLUDE EDGE LINE BREAKS
 AND RADII FOR SIDE ROADS)
 STA. 102+00 TO 108+00, SOLID LT & RT

646.412 DURABLE 4 INCH YELLOW LINE, THERMOPLASTIC
 (ALL LINES WILL INCLUDE C BREAKS FOR SIDE ROADS)
 STA. 102+00 TO 108+00, SOLID LT & RT

646.602 TEMPORARY 4 INCH WHITE LINE, PAINT
 (ALL LINES WILL INCLUDE EDGE LINE BREAKS
 AND RADII FOR SIDE ROADS)
 STA. 102+00 TO 108+00, SOLID LT & RT

646.612 TEMPORARY 4 INCH YELLOW LINE, PAINT
 (ALL LINES WILL INCLUDE C BREAKS FOR SIDE ROADS)
 STA. 102+00 TO 108+00, SOLID LT & RT

675.50 REMOVING SIGNS
 AS SHOWN - 1

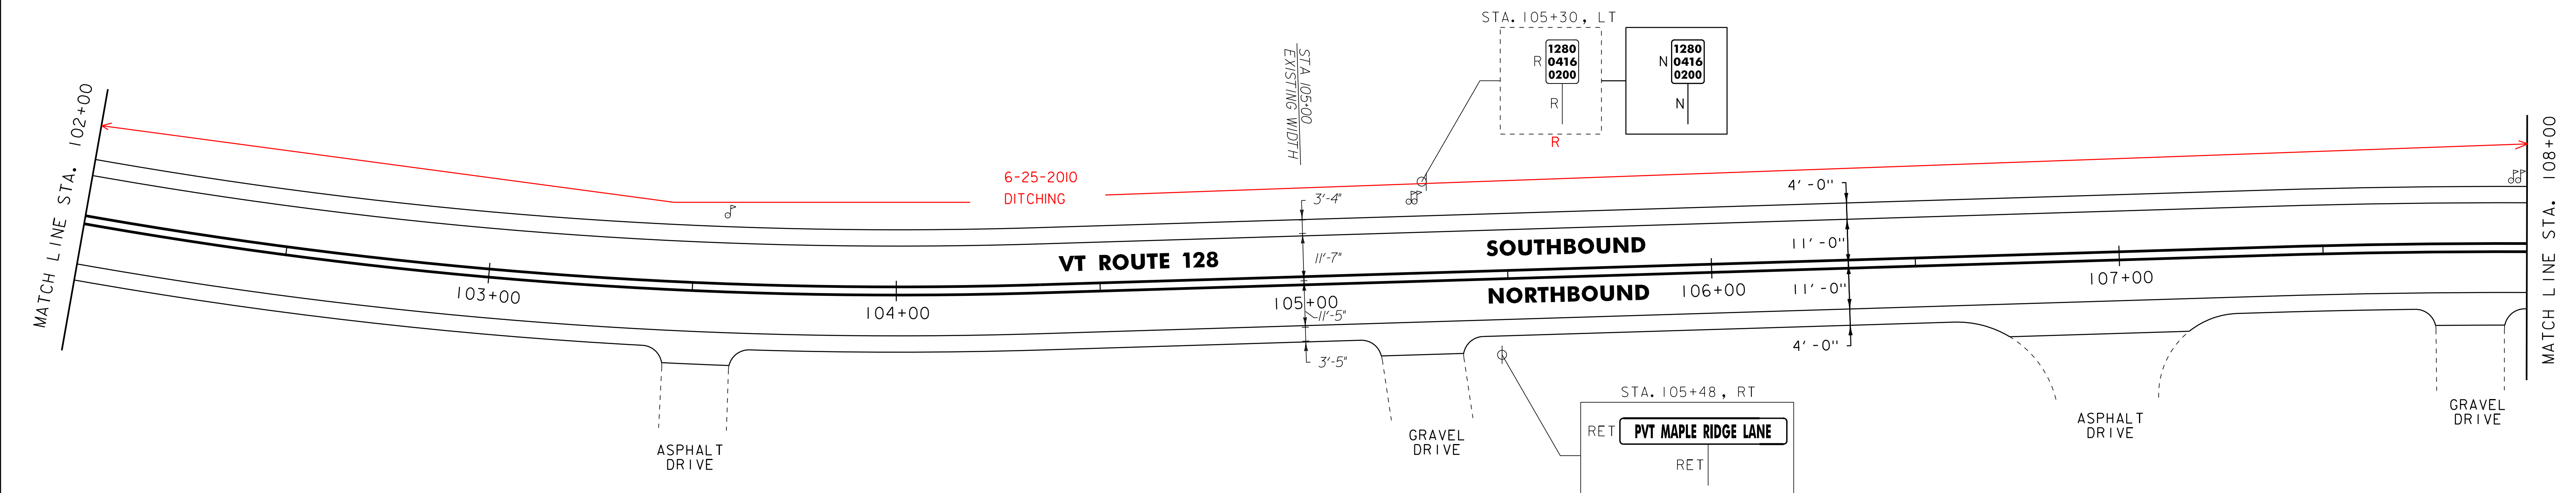

- NOTES:
 1. ALL EXISTING SIGNS NOT SHOWN SHALL BE RETAINED.
 2. FOR LEGENDS, SEE LAYOUT SHEET #1.
NOT TO SCALE

**PROJECT
 LAYOUT
 SHEET #4**

PROJECT NAME: WESTFORD - FAIRFAX
 PROJECT NUMBER: STP 2804(1)

FILE NAME: p08c212.dgn
 PROJECT LEADER: JLL
 DESIGNED BY: STANTEC
IPARM FILE: p08c212104.i

PLOT DATE: 31-OCT-2012 13:57
 DRAWN BY: STANTEC
 CHECKED BY: JLL
 SHEET 20 OF 79

