

621.20 STEEL BEAM GUARDRAIL, GALVANIZED
STA. 113+32.5 TO 114+00, RT

621.50 MANUFACTURED TERMINAL SECTION, FLARED
STA. 112+95 TO 113+32.5, RT
STA. 113+75 TO 114+00, LT


621.80 REMOVAL AND DISPOSAL OF GUARDRAIL
STA. 112+96 TO 114+00, RT
STA. 113+97 TO 114+00, LT

646.402 DURABLE 4 INCH WHITE LINE, THERMOPLASTIC
(ALL LINES WILL INCLUDE EDGE LINE BREAKS
AND RADII FOR SIDE ROADS)
STA. 108+00 TO 114+00, SOLID LT & RT

646.412 DURABLE 4 INCH YELLOW LINE, THERMOPLASTIC
(ALL LINES WILL INCLUDE C BREAKS FOR SIDE ROADS)
STA. 108+00 TO 109+56, SOLID LT & RT
STA. 109+56 TO 114+00, SOLID LT, DASHED RT

646.602 TEMPORARY 4 INCH WHITE LINE, PAINT
(ALL LINES WILL INCLUDE EDGE LINE BREAKS
AND RADII FOR SIDE ROADS)
STA. 108+00 TO 114+00, SOLID LT & RT

646.612 TEMPORARY 4 INCH YELLOW LINE, PAINT
(ALL LINES WILL INCLUDE C BREAKS FOR SIDE ROADS)
STA. 108+00 TO 109+56, SOLID LT & RT
STA. 109+56 TO 114+00, SOLID LT, DASHED RT

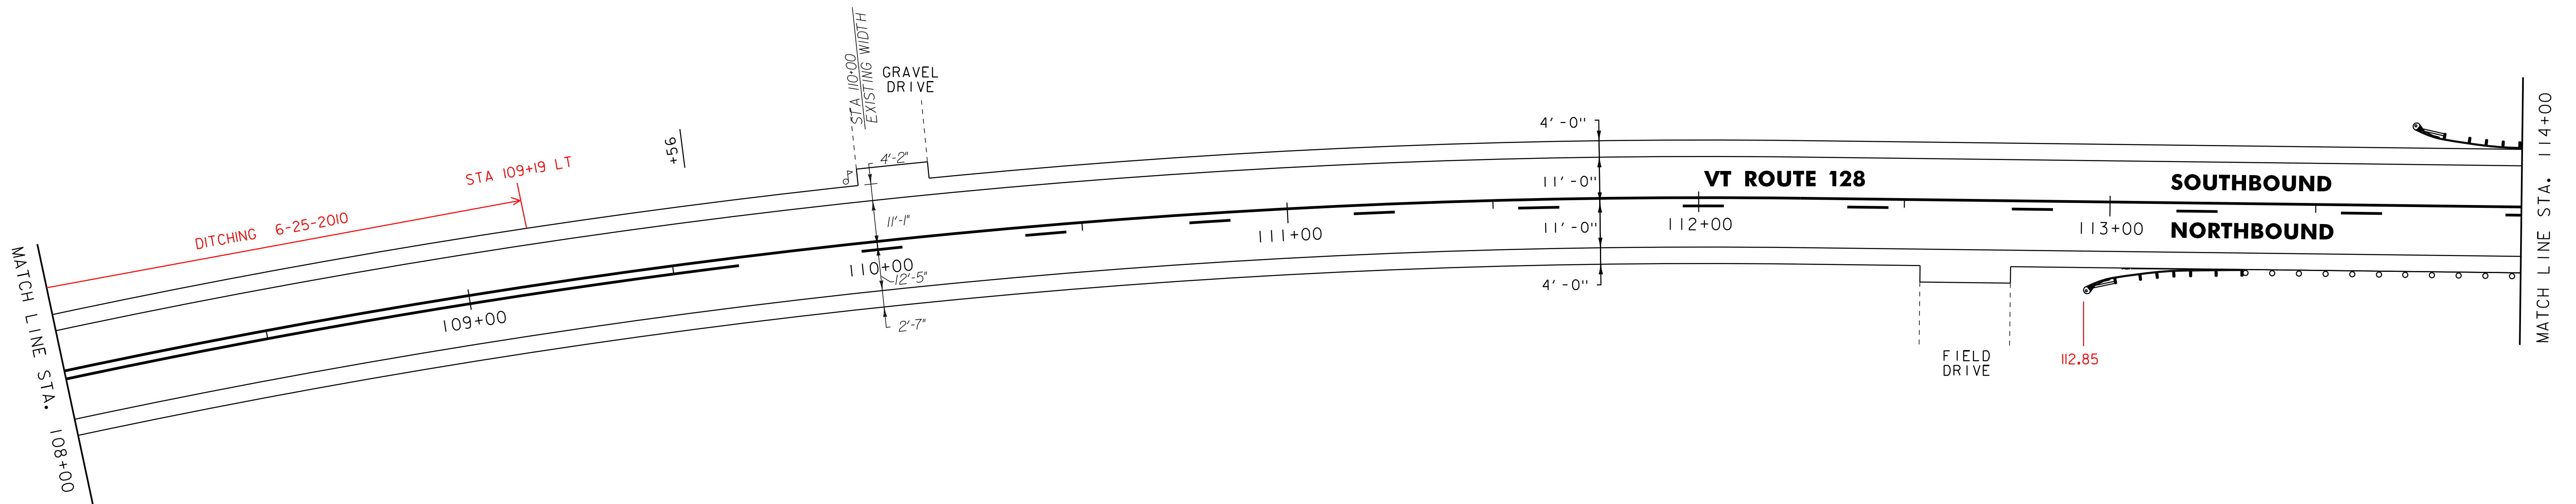

NOTES:

1. ALL EXISTING SIGNS NOT SHOWN SHALL BE RETAINED.
2. FOR LEGENDS, SEE LAYOUT SHEET #1.

NOT TO SCALE



**PROJECT
LAYOUT
SHEET #5**

PROJECT NAME: WESTFORD - FAIRFAX
PROJECT NUMBER: STP 2804(1)

FILE NAME: p08c212.dgn
PROJECT LEADER: JLL
DESIGNED BY: STANTEC
IPARM FILE: p08c212105.i

PLOT DATE: 31-OCT-2012 13:57
DRAWN BY: STANTEC
CHECKED BY: JLL
SHEET 21 OF 79