

621.20 STEEL BEAM GUARDRAIL, GALVANIZED
 STA. 114+12.5 TO 116+87.5, LT
 STA. 114+00 TO 117+07.5, RT

646.402 DURABLE 4 INCH WHITE LINE, THERMOPLASTIC
 (ALL LINES WILL INCLUDE EDGE LINE BREAKS
 AND RADII FOR SIDE ROADS)
 STA. 114+00 TO 120+00, SOLID LT & RT

646.602 TEMPORARY 4 INCH WHITE LINE, PAINT
 (ALL LINES WILL INCLUDE EDGE LINE BREAKS
 AND RADII FOR SIDE ROADS)
 STA. 114+00 TO 120+00, SOLID LT & RT


675.50 REMOVING SIGNS
 AS SHOWN - 1

621.50 MANUFACTURED TERMINAL SECTION, FLARED
 STA. 114+00 TO 114+12.5, LT
 STA. 116+87.5 TO 117+25, LT
 STA. 117+07.5 TO 117+45, RT

646.412 DURABLE 4 INCH YELLOW LINE, THERMOPLASTIC
 (ALL LINES WILL INCLUDE C BREAKS FOR SIDE ROADS)
 STA. 114+00 TO 116+16, SOLID LT, DASHED RT
 STA. 116+16 TO 116+69, SOLID LT & RT
 STA. 116+69 TO 120+00, DASHED LT, SOLID RT

646.612 TEMPORARY 4 INCH YELLOW LINE, PAINT
 (ALL LINES WILL INCLUDE C BREAKS FOR SIDE ROADS)
 STA. 114+00 TO 116+16, SOLID LT, DASHED RT
 STA. 116+16 TO 116+69, SOLID LT & RT
 STA. 116+69 TO 120+00, DASHED LT, SOLID RT

621.80 REMOVAL AND DISPOSAL OF GUARDRAIL
 STA. 114+00 TO 116+37, RT
 STA. 114+00 TO 117+00, LT

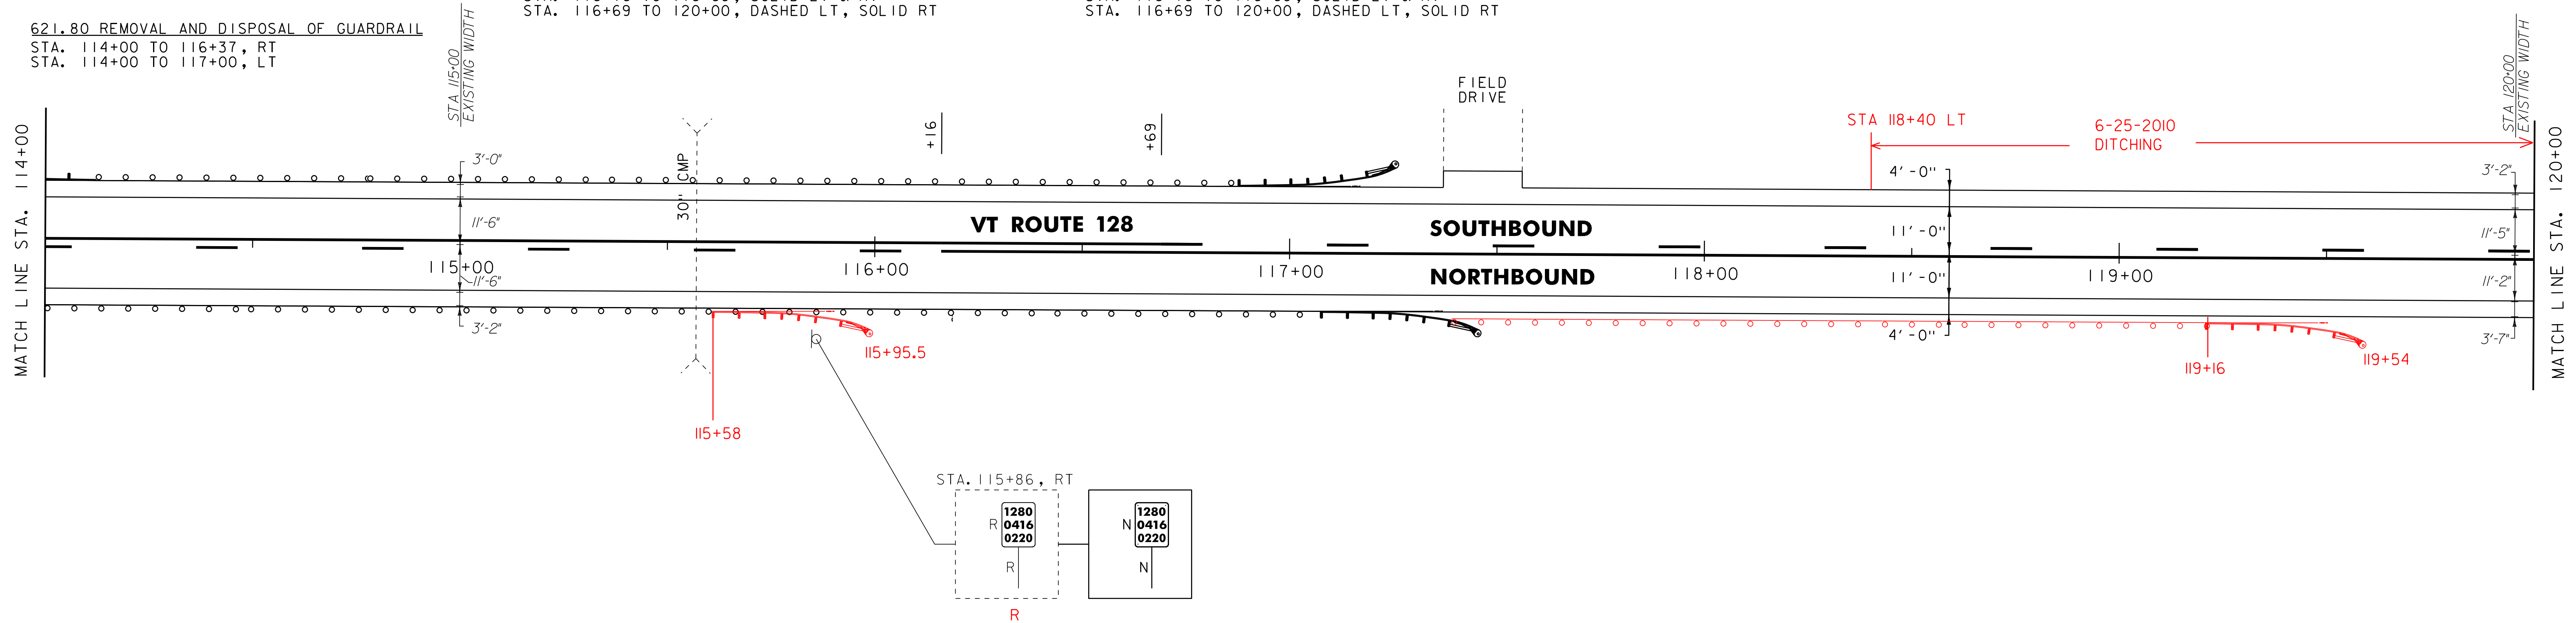


646.402 DURABLE 4 INCH WHITE LINE, THERMOPLASTIC
 (ALL LINES WILL INCLUDE EDGE LINE BREAKS
 AND RADII FOR SIDE ROADS)
 STA. 120+00 TO 126+00, SOLID LT & RT

646.602 TEMPORARY 4 INCH WHITE LINE, PAINT
 (ALL LINES WILL INCLUDE EDGE LINE BREAKS
 AND RADII FOR SIDE ROADS)
 STA. 120+00 TO 126+00, SOLID LT & RT

646.412 DURABLE 4 INCH YELLOW LINE, THERMOPLASTIC
 (ALL LINES WILL INCLUDE C BREAKS FOR SIDE ROADS)
 STA. 120+00 TO 124+08, DASHED LT, SOLID RT
 STA. 124+08 TO 124+61, SOLID LT & RT
 STA. 124+61 TO 126+00, SOLID LT, DASHED RT

646.612 TEMPORARY 4 INCH YELLOW LINE, PAINT
 (ALL LINES WILL INCLUDE C BREAKS FOR SIDE ROADS)
 STA. 120+00 TO 124+08, DASHED LT, SOLID RT
 STA. 124+08 TO 124+61, SOLID LT & RT
 STA. 124+61 TO 126+00, SOLID LT, DASHED RT

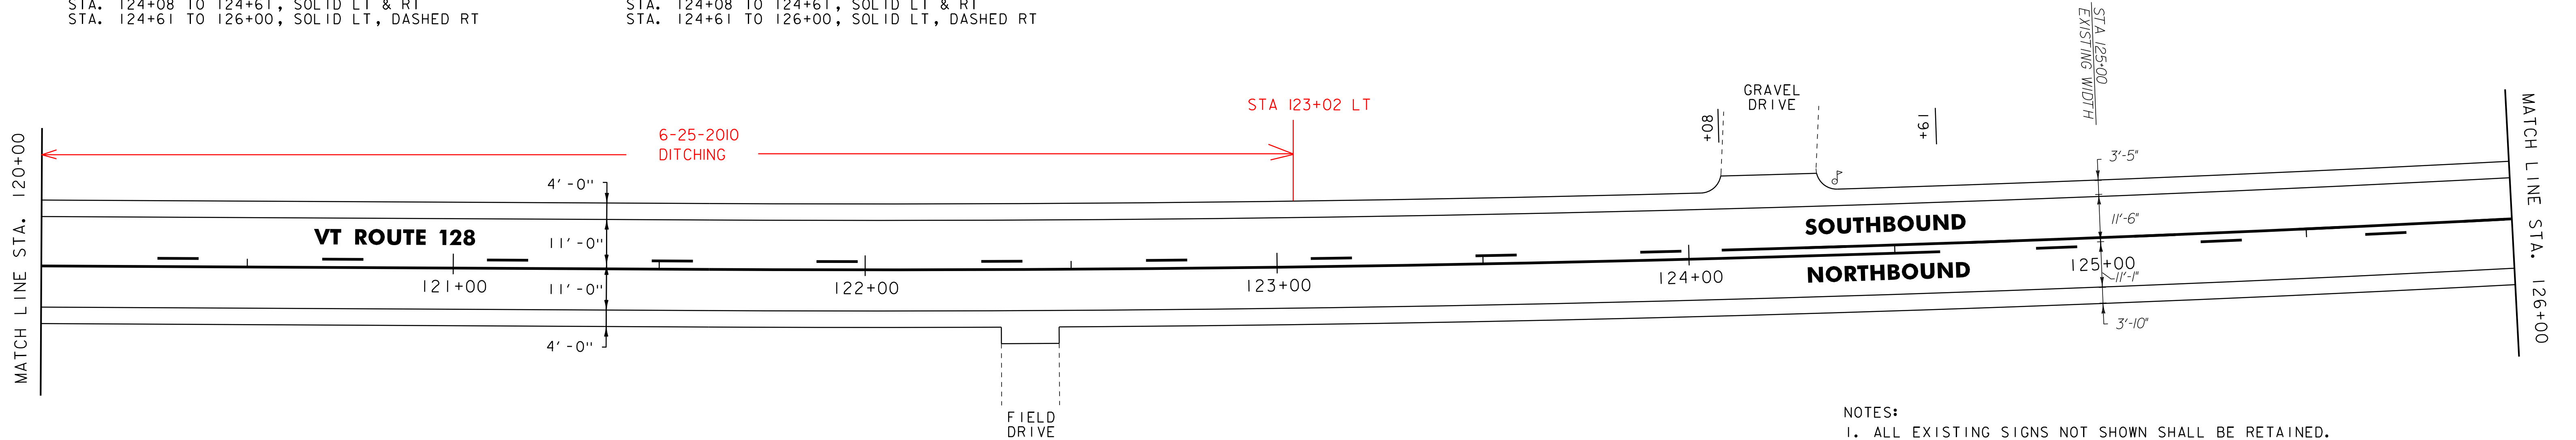

NOTES:
 1. ALL EXISTING SIGNS NOT SHOWN SHALL BE RETAINED.
 2. FOR LEGENDS, SEE LAYOUT SHEET #1.
 NOT TO SCALE

PROJECT LAYOUT SHEET #6

PROJECT NAME: WESTFORD - FAIRFAX
 PROJECT NUMBER: STP 2804(1)

FILE NAME: p08c212.dgn
 PROJECT LEADER: JLL
 DESIGNED BY: STANTEC
 IPARM FILE: p08c212106.i

PLOT DATE: 31-OCT-2012 13:57
 DRAWN BY: STANTEC
 CHECKED BY: JLL
 SHEET 22 OF 79



R=I