


646.402 DURABLE 4 INCH WHITE LINE, THERMOPLASTIC  
 (ALL LINES WILL INCLUDE EDGE LINE BREAKS  
 AND RADII FOR SIDE ROADS)  
 STA. 126+00 TO 132+00, SOLID LT & RT

646.412 DURABLE 4 INCH YELLOW LINE, THERMOPLASTIC  
 (ALL LINES WILL INCLUDE C BREAKS FOR SIDE ROADS)  
 STA. 126+00 TO 130+68, SOLID LT, DASHED RT  
 STA. 130+68 TO 132+00, SOLID LT & RT

646.602 TEMPORARY 4 INCH WHITE LINE, PAINT  
 (ALL LINES WILL INCLUDE EDGE LINE BREAKS  
 AND RADII FOR SIDE ROADS)  
 STA. 126+00 TO 132+00, SOLID LT & RT

646.612 TEMPORARY 4 INCH YELLOW LINE, PAINT  
 (ALL LINES WILL INCLUDE C BREAKS FOR SIDE ROADS)  
 STA. 126+00 TO 130+68, SOLID LT, DASHED RT  
 STA. 130+68 TO 132+00, SOLID LT & RT

675.50 REMOVING SIGNS  
 AS SHOWN - I

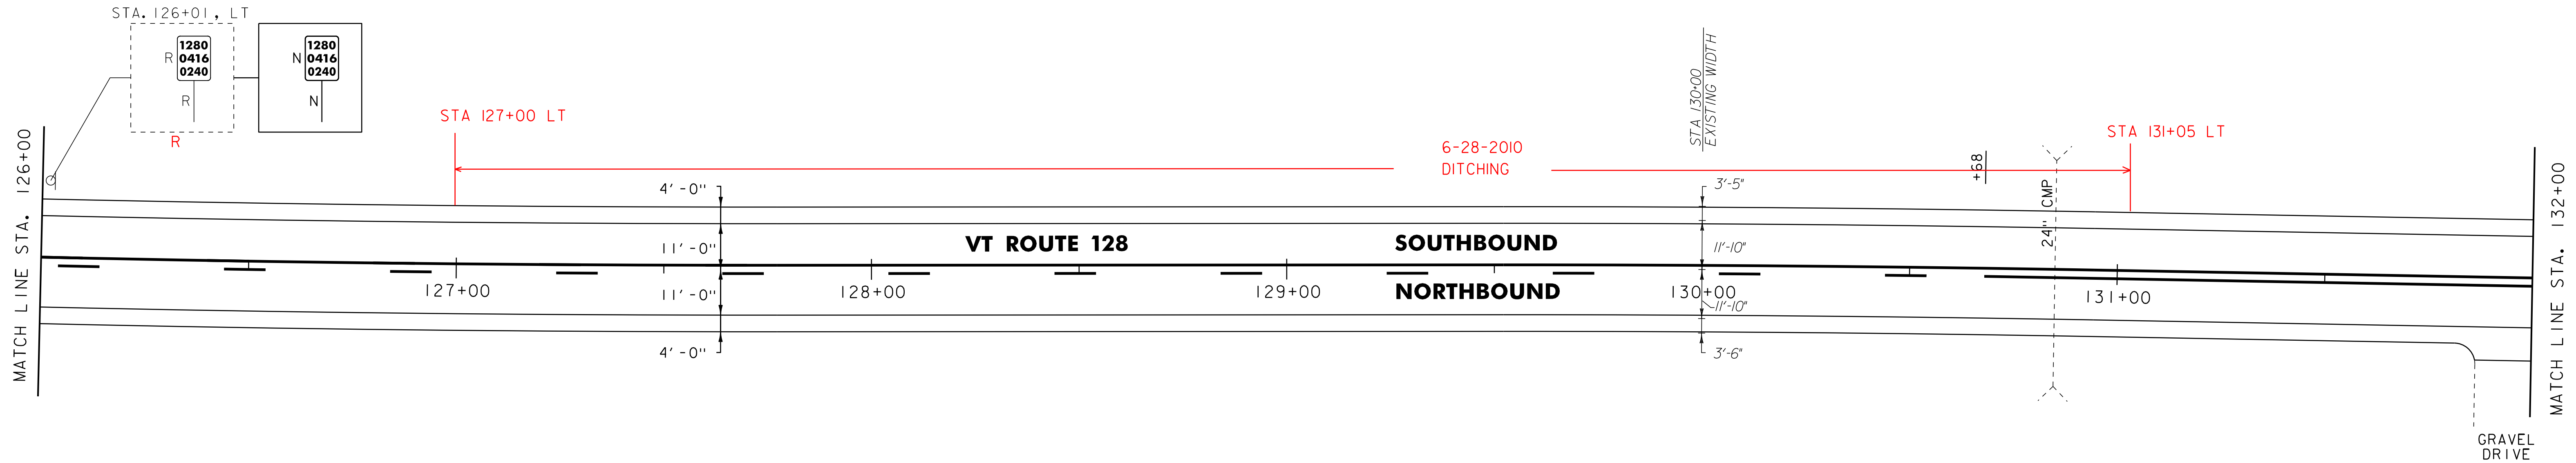


646.402 DURABLE 4 INCH WHITE LINE, THERMOPLASTIC  
 (ALL LINES WILL INCLUDE EDGE LINE BREAKS  
 AND RADII FOR SIDE ROADS)  
 STA. 132+00 TO 138+00, SOLID LT & RT

646.602 TEMPORARY 4 INCH WHITE LINE, PAINT  
 (ALL LINES WILL INCLUDE EDGE LINE BREAKS  
 AND RADII FOR SIDE ROADS)  
 STA. 132+00 TO 138+00, SOLID LT & RT

675.50 REMOVING SIGNS  
 AS SHOWN - I

646.412 DURABLE 4 INCH YELLOW LINE, THERMOPLASTIC  
 (ALL LINES WILL INCLUDE C BREAKS FOR SIDE ROADS)  
 STA. 132+00 TO 137+54, DASHED LT, SOLID RT  
 STA. 137+54 TO 138+00, SOLID LT, DASHED RT

646.612 TEMPORARY 4 INCH YELLOW LINE, PAINT  
 (ALL LINES WILL INCLUDE C BREAKS FOR SIDE ROADS)  
 STA. 132+00 TO 137+54, DASHED LT, SOLID RT  
 STA. 137+54 TO 138+00, SOLID LT, DASHED RT

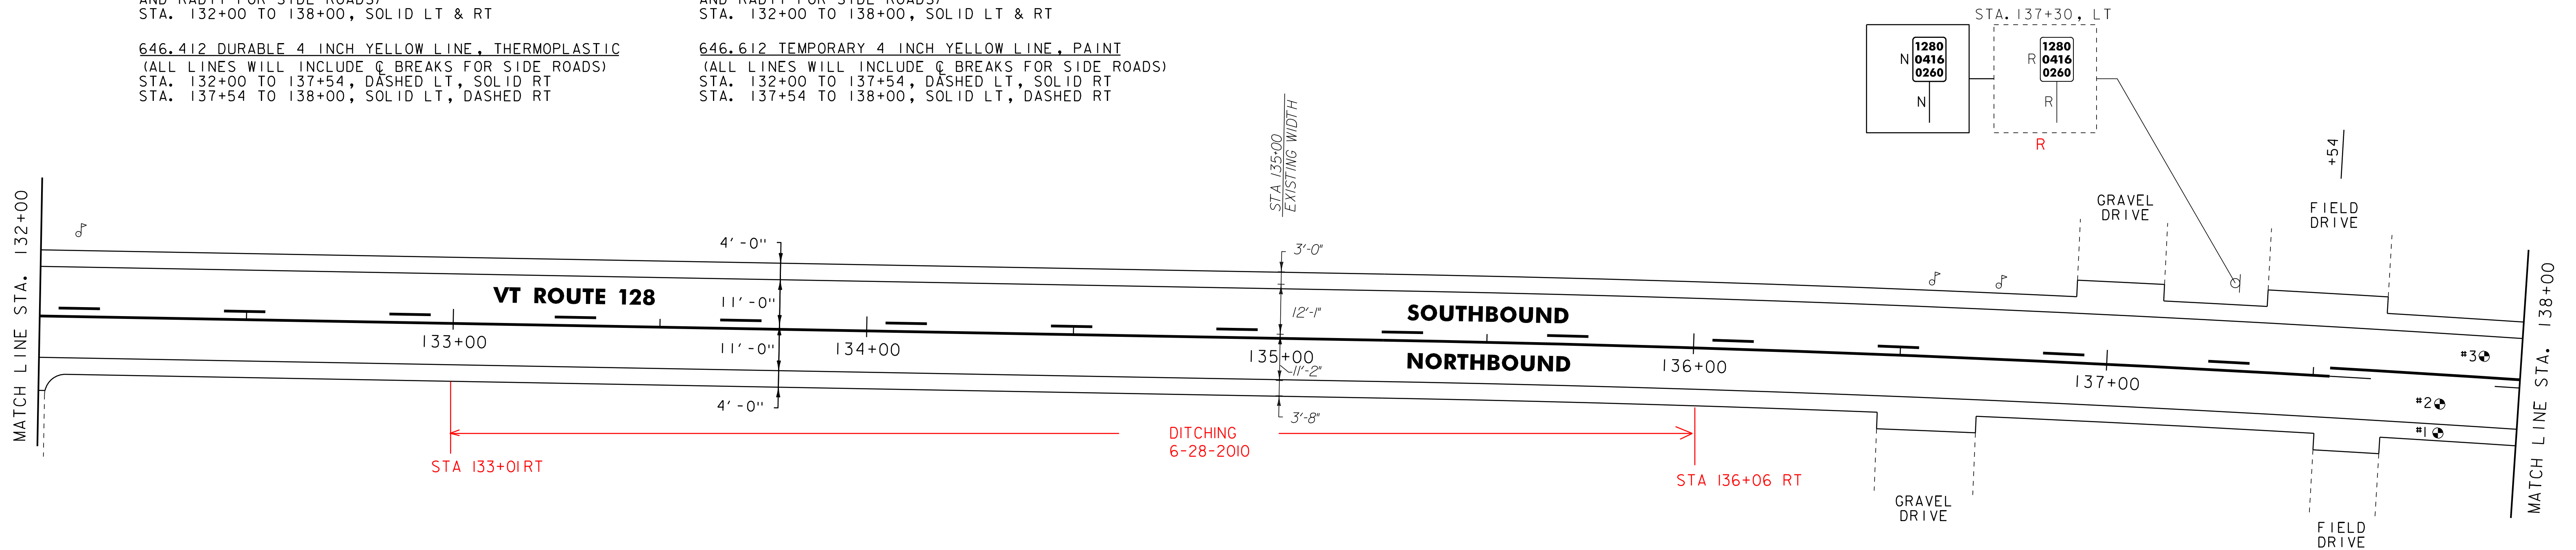

- NOTES:  
 1. ALL EXISTING SIGNS NOT SHOWN SHALL BE RETAINED.  
 2. FOR LEGENDS, SEE LAYOUT SHEET #1.  
**NOT TO SCALE**

PAVEMENT CORE DATA			
CORE #	DEPTH (IN.)	PCC	COMMENTS
1	3 1/4"	NO	
2	5"	NO	
3	3 1/4"	NO	

R=I



**PROJECT LAYOUT SHEET #7**

PROJECT NAME: WESTFORD - FAIRFAX  
 PROJECT NUMBER: STP 2804(1)

FILE NAME: p08c212.dgn  
 PROJECT LEADER: JLL  
 DESIGNED BY: STANTEC  
 IPARM FILE: p08c212107.i

PLOT DATE: 31-OCT-2012 13:57  
 DRAWN BY: STANTEC  
 CHECKED BY: JLL  
 SHEET 23 OF 79