


646.402 DURABLE 4 INCH WHITE LINE, THERMOPLASTIC
 (ALL LINES WILL INCLUDE EDGE LINE BREAKS
 AND RADII FOR SIDE ROADS)
 STA. 162+00 TO 168+00, SOLID LT & RT

646.412 DURABLE 4 INCH YELLOW LINE, THERMOPLASTIC
 (ALL LINES WILL INCLUDE C BREAKS FOR SIDE ROADS)
 STA. 162+00 TO 162+10, SOLID LT & RT
 STA. 162+10 TO 168+00, SOLID LT, DASHED RT

646.602 TEMPORARY 4 INCH WHITE LINE, PAINT
 (ALL LINES WILL INCLUDE EDGE LINE BREAKS
 AND RADII FOR SIDE ROADS)
 STA. 162+00 TO 168+00, SOLID LT & RT

646.612 TEMPORARY 4 INCH YELLOW LINE, PAINT
 (ALL LINES WILL INCLUDE C BREAKS FOR SIDE ROADS)
 STA. 162+00 TO 162+10, SOLID LT & RT
 STA. 162+10 TO 168+00, SOLID LT, DASHED RT

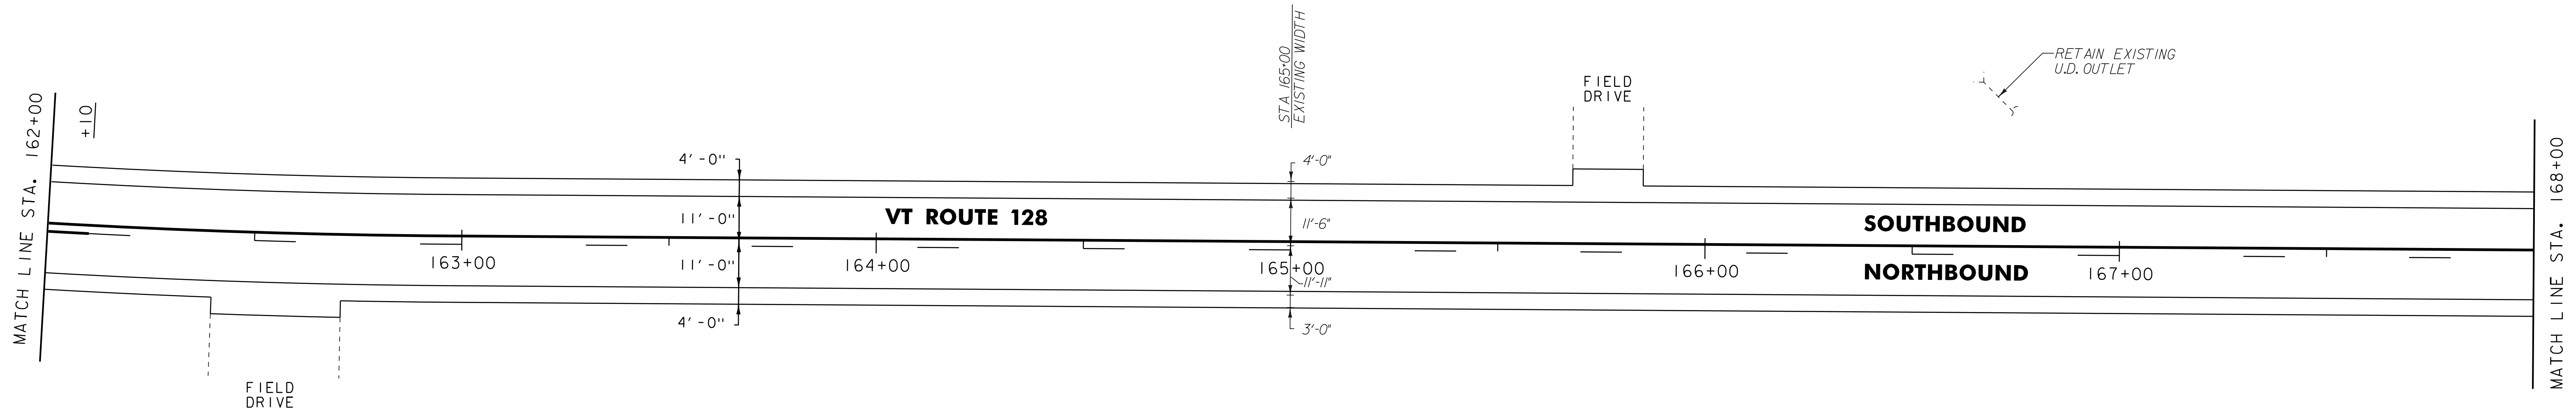


646.402 DURABLE 4 INCH WHITE LINE, THERMOPLASTIC
 (ALL LINES WILL INCLUDE EDGE LINE BREAKS
 AND RADII FOR SIDE ROADS)
 STA. 168+00 TO 174+00, SOLID LT & RT

646.412 DURABLE 4 INCH YELLOW LINE, THERMOPLASTIC
 (ALL LINES WILL INCLUDE C BREAKS FOR SIDE ROADS)
 STA. 168+00 TO 169+49, SOLID LT, DASHED RT
 STA. 169+49 TO 171+60, DASHED C
 STA. 171+60 TO 174+00, DASHED LT, SOLID RT

646.602 TEMPORARY 4 INCH WHITE LINE, PAINT
 (ALL LINES WILL INCLUDE EDGE LINE BREAKS
 AND RADII FOR SIDE ROADS)
 STA. 168+00 TO 174+00, SOLID LT & RT

646.612 TEMPORARY 4 INCH YELLOW LINE, PAINT
 (ALL LINES WILL INCLUDE C BREAKS FOR SIDE ROADS)
 STA. 168+00 TO 169+49, SOLID LT, DASHED RT
 STA. 169+49 TO 171+60, DASHED C
 STA. 171+60 TO 174+00, DASHED LT, SOLID RT

675.50 REMOVING SIGNS
 AS SHOWN - 1

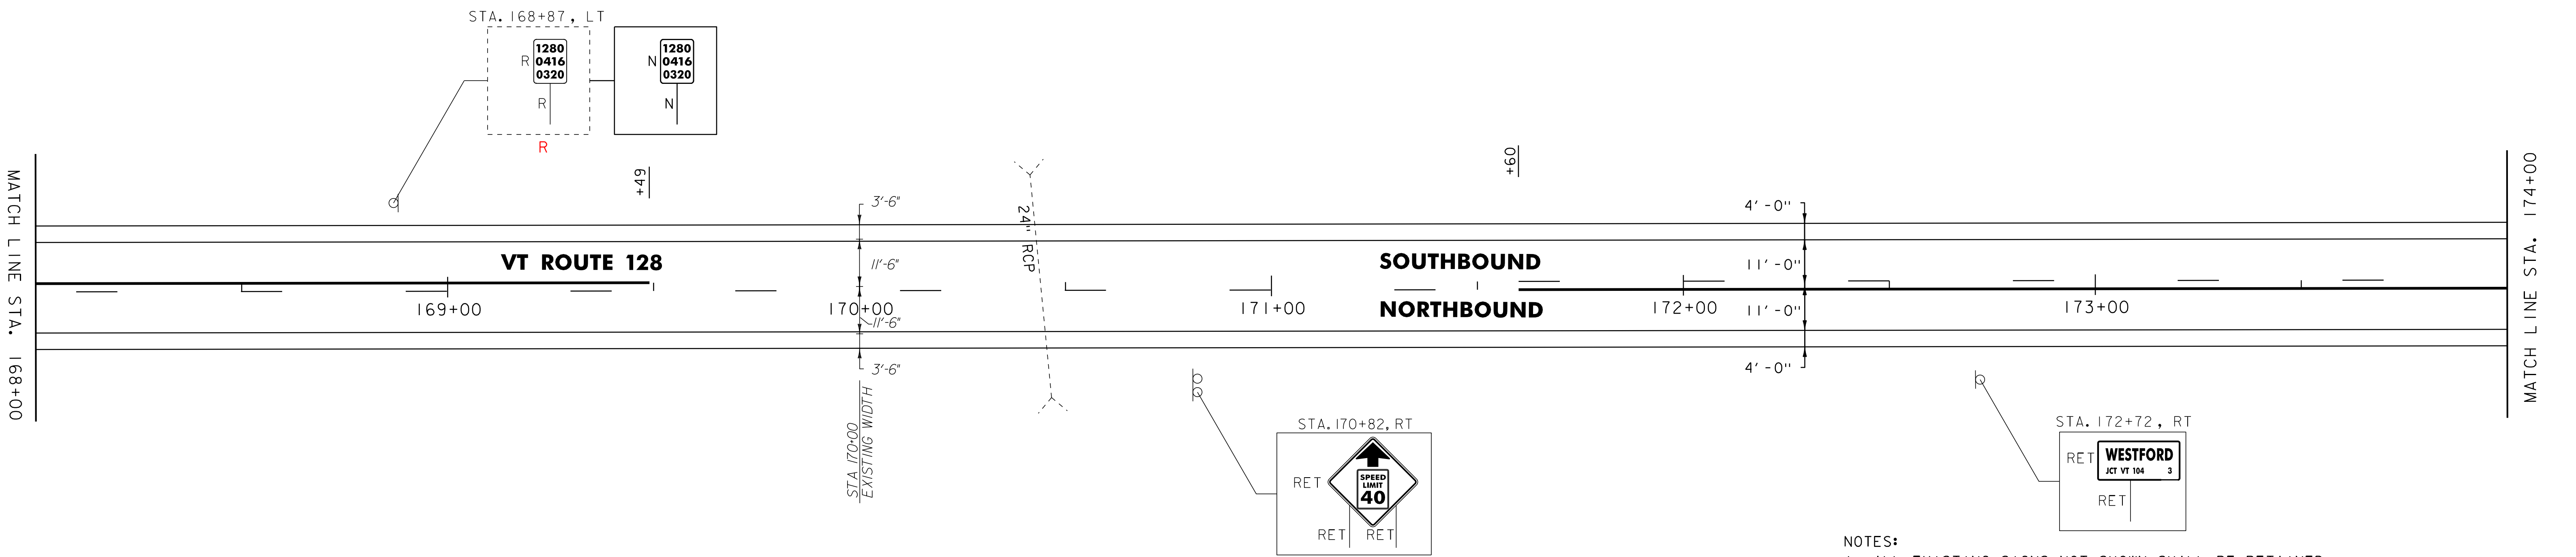

NOTES:
 1. ALL EXISTING SIGNS NOT SHOWN SHALL BE RETAINED.
 2. FOR LEGENDS, SEE LAYOUT SHEET #1.
 NOT TO SCALE

PROJECT LAYOUT SHEET #10	PROJECT NAME: WESTFORD - FAIRFAX
	PROJECT NUMBER: STP 2804(1)
	FILE NAME: p08c212.dgn
	PLOT DATE: 31-OCT-2012 13:57
PROJECT LEADER: JLL	DRAWN BY: STANTEC
DESIGNED BY: STANTEC	CHECKED BY: JLL
IPARM FILE: p08c212110.i	SHEET 26 OF 79



R=1