

646.402 DURABLE 4 INCH WHITE LINE, THERMOPLASTIC  
 (ALL LINES WILL INCLUDE EDGE LINE BREAKS AND RADII FOR SIDE ROADS)  
 STA. 174+00 TO 180+00, SOLID LT & RT  
 STA. 177+27, SOLID RT (TH 19 EDGELINES)

646.412 DURABLE 4 INCH YELLOW LINE, THERMOPLASTIC  
 (ALL LINES WILL INCLUDE C BREAKS FOR SIDE ROADS)  
 STA. 174+00 TO 176+77, DASHED LT, SOLID RT  
 STA. 176+77 TO 180+00, SOLID LT & RT  
 STA. 177+27, DOUBLE SOLID RT (TH 19)

646.602 TEMPORARY 4 INCH WHITE LINE, PAINT  
 (ALL LINES WILL INCLUDE EDGE LINE BREAKS AND RADII FOR SIDE ROADS)  
 STA. 174+00 TO 180+00, SOLID LT & RT  
 STA. 177+27, SOLID RT (TH 19 EDGELINES)

646.612 TEMPORARY 4 INCH YELLOW LINE, PAINT  
 (ALL LINES WILL INCLUDE C BREAKS FOR SIDE ROADS)  
 STA. 174+00 TO 176+77, DASHED LT, SOLID RT  
 STA. 176+77 TO 180+00, SOLID LT & RT  
 STA. 177+27, DOUBLE SOLID RT (TH 19)

646.482 DURABLE 24 INCH STOP BAR, THERMOPLASTIC  
 STA. 177+27, RT (TH 19)


646.492 DURABLE LETTER OR SYMBOL, THERMOPLASTIC  
 STA. 177+27, RT - "STOP"

646.682 TEMPORARY 24 INCH STOP BAR, PAINT  
 STA. 177+27, RT (TH 19)

646.692 TEMPORARY LETTER OR SYMBOL, PAINT  
 STA. 177+27, RT - "STOP"

675.50 REMOVING SIGNS  
 AS SHOWN - 5

675.60 ERECTING SALVAGED SIGNS  
 AS SHOWN - 1

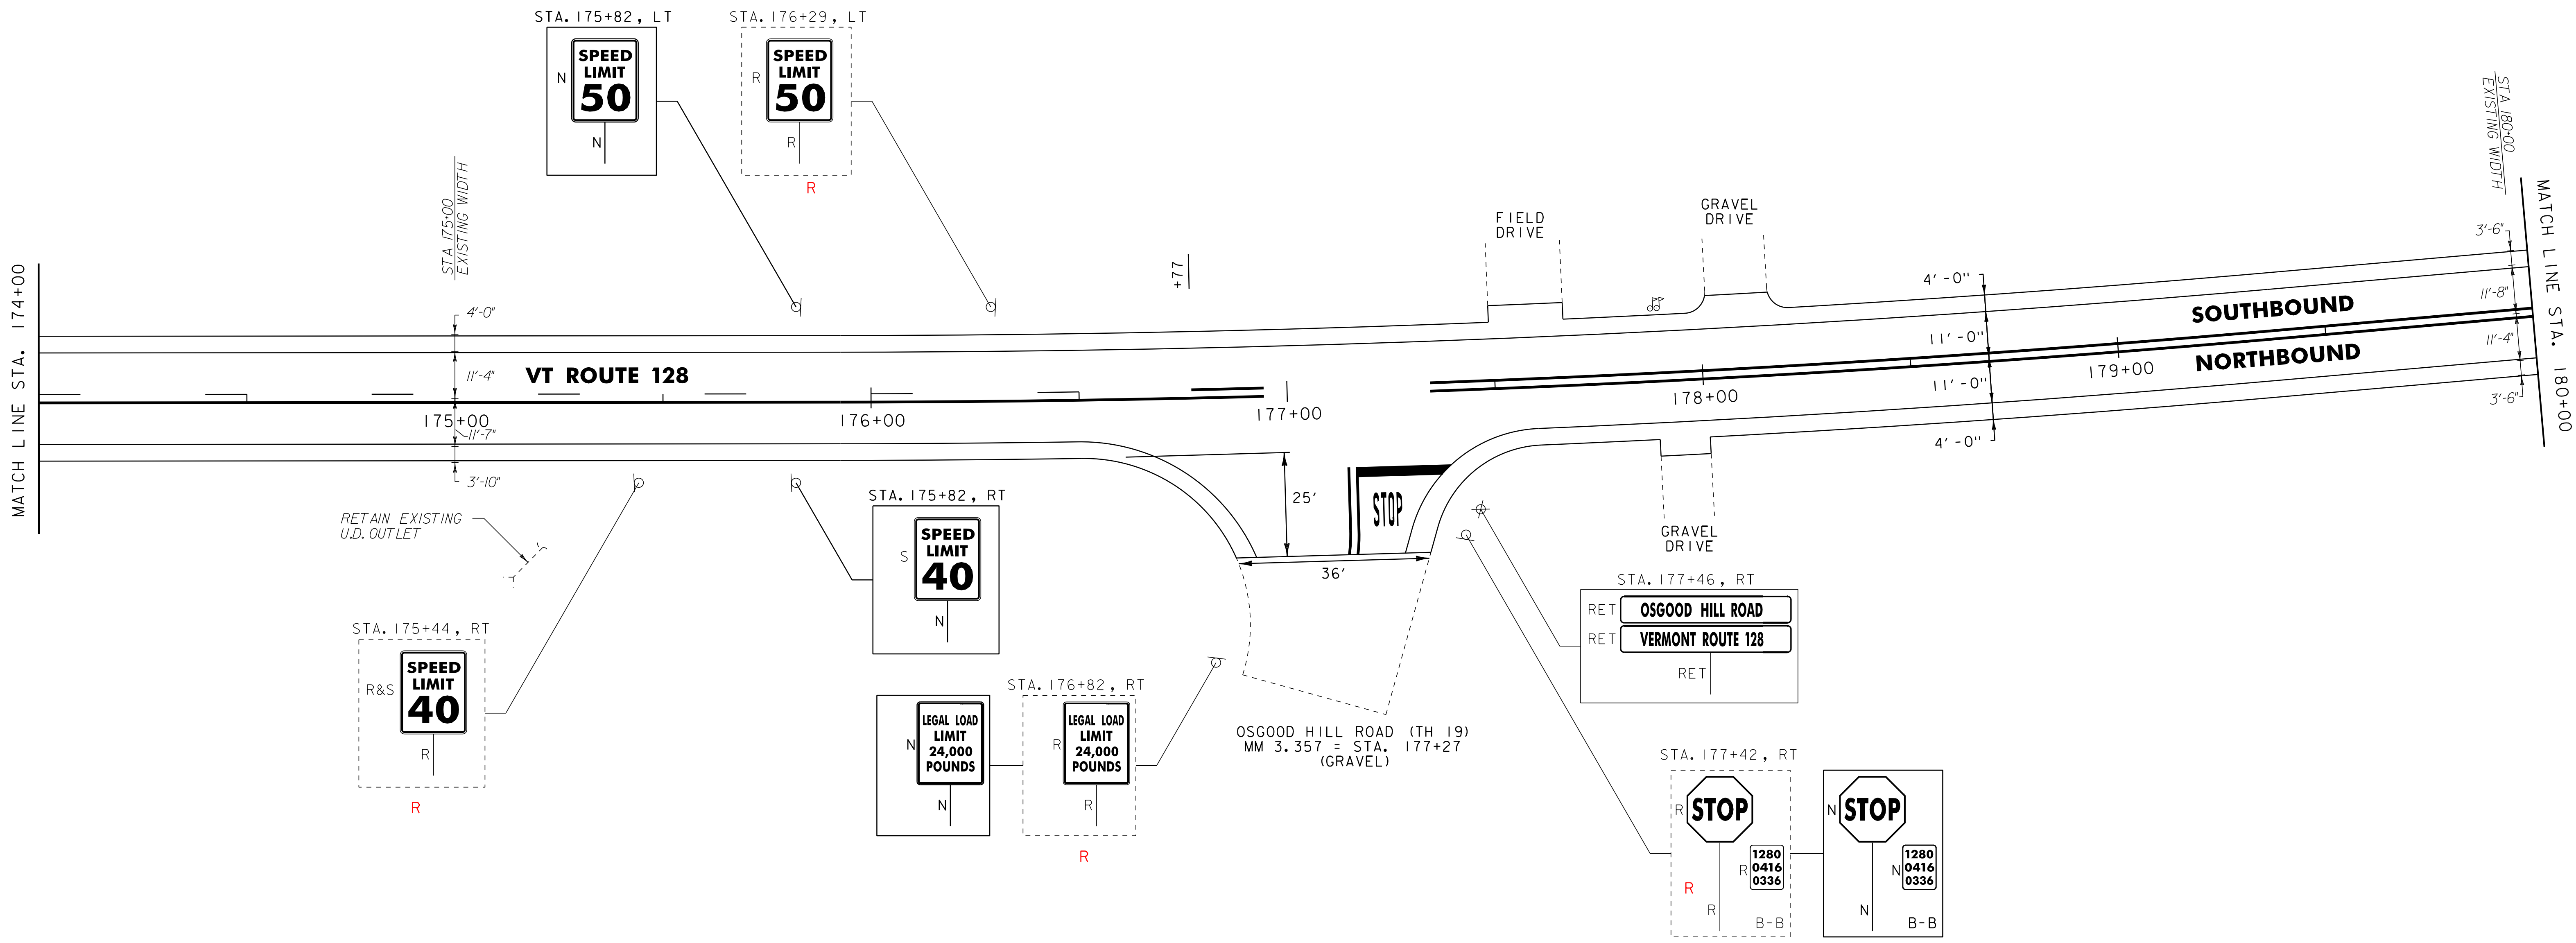

NOTES:  
 1. ALL EXISTING SIGNS NOT SHOWN SHALL BE RETAINED.  
 2. FOR LEGENDS, SEE LAYOUT SHEET #1.  
**NOT TO SCALE**

<b>PROJECT LAYOUT SHEET #11</b>	PROJECT NAME: WESTFORD - FAIRFAX
	PROJECT NUMBER: STP 2804(1)
	FILE NAME: p08c212.dgn
	PLOT DATE: 31-OCT-2012 13:57
	PROJECT LEADER: JLL
	DRAWN BY: STANTEC
	DESIGNED BY: STANTEC
	CHECKED BY: JLL
	IPARM FILE: p08c212111.i
	SHEET 27 OF 79



R=4