

604.412 REHAB. DI'S, CB'S OR MH'S, CLASS I
STA. 193+85, RT

616.35 TREATED TIMBER CURB
STA. 193+83 TO 194+12, RT

616.47 BITUMINOUS CONCRETE GUTTERS AND TRAFFIC ISLANDS
STA. 193+85 TO 194+12, RT
(SEE DETAIL ON MISCELLANEOUS DETAIL SHEET)

621.20 STEEL BEAM GUARDRAIL, GALVANIZED

193+25 STA. +92+74.5 TO 193+87, RT
193+00 STA. +93+68.25 TO 193+80.75, LT
194+87 STA. +95+11 TO +96+11, LT 194+99
195+11 STA. +95+17.25 TO +95+54.75, RT 195+42

621.21 HD STEEL BEAM GUARDRAIL, GALVANIZED
193+87 STA. +93+80.75 TO 194+12, LT
STA. 193+87 TO 194+12, RT
STA. 194+86.7 TO +95+11, LT 194+99
STA. 194+86 TO 195+17.25, RT

621.60 ANCHOR FOR STEEL BEAM RAIL
STA. 192+74.5, RT
STA. 193+68.25, LT
STA. 195+54.75, RT
STA. 196+11, LT

621.80 REMOVAL AND DISPOSAL OF GUARDRAIL

STA. 193+17 TO 194+12, RT
STA. 193+70 TO 194+12, LT
STA. 194+86 TO 195+45, RT
STA. 194+86 TO 195+78, LT

646.402 DURABLE 4 INCH WHITE LINE, THERMOPLASTIC
(ALL LINES WILL INCLUDE EDGE LINE BREAKS AND RADII FOR SIDE ROADS)
STA. 192+00 TO 198+00, SOLID LT & RT


646.412 DURABLE 4 INCH YELLOW LINE, THERMOPLASTIC
(ALL LINES WILL INCLUDE C BREAKS FOR SIDE ROADS)
STA. 192+00 TO 198+00, SOLID LT & RT

646.602 TEMPORARY 4 INCH WHITE LINE, PAINT
(ALL LINES WILL INCLUDE EDGE LINE BREAKS AND RADII FOR SIDE ROADS)
STA. 192+00 TO 198+00, SOLID LT & RT

646.612 TEMPORARY 4 INCH YELLOW LINE, PAINT
(ALL LINES WILL INCLUDE C BREAKS FOR SIDE ROADS)
STA. 192+00 TO 198+00, SOLID LT & RT

675.50 REMOVING SIGNS
AS SHOWN - 6

675.60 ERECTING SALVAGED SIGNS
AS SHOWN - 6

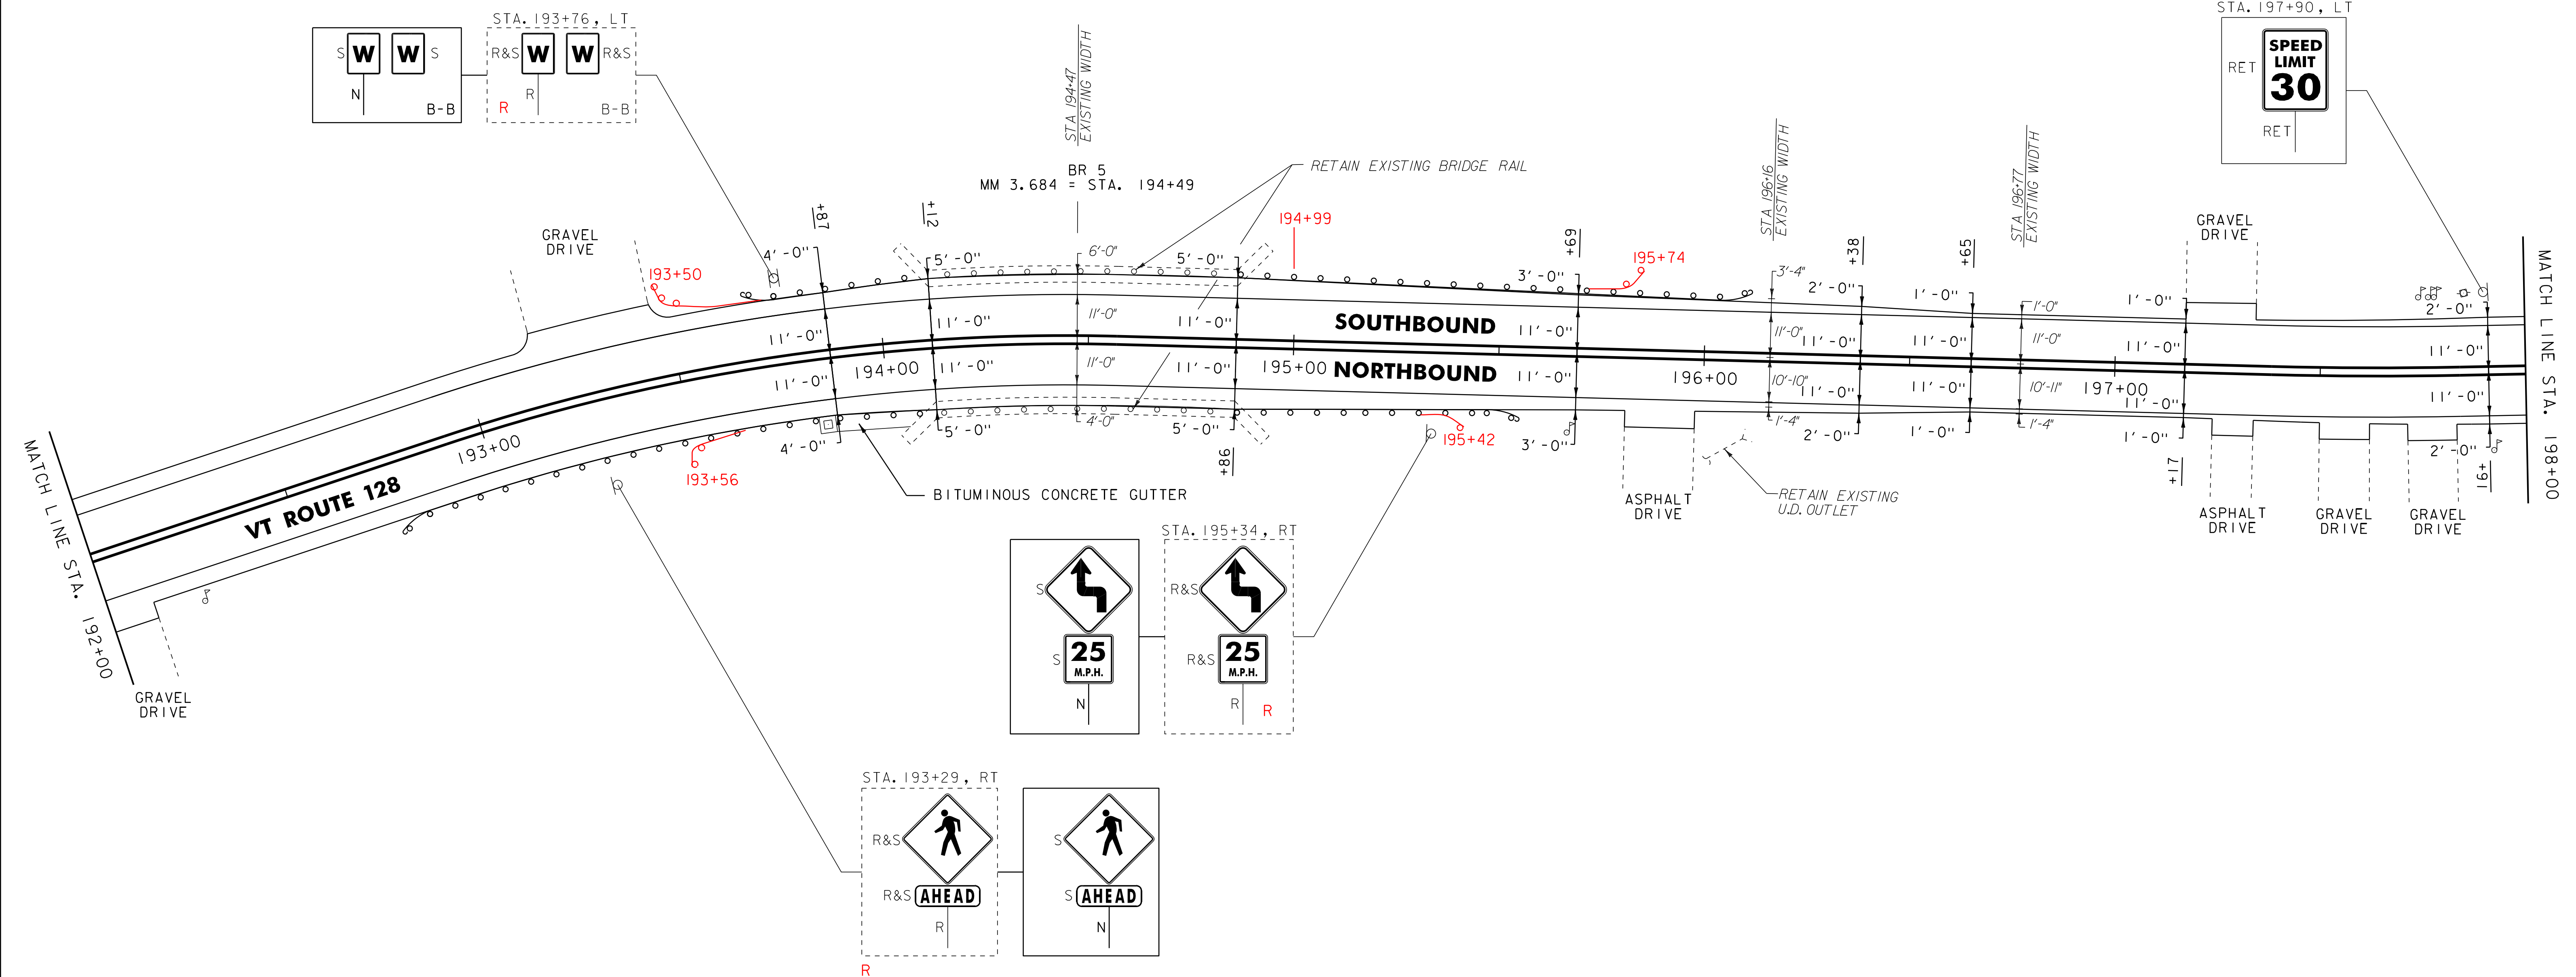

NOTES:
1. ALL EXISTING SIGNS NOT SHOWN SHALL BE RETAINED.
2. FOR LEGENDS, SEE LAYOUT SHEET #1.
NOT TO SCALE

PROJECT LAYOUT SHEET #13	PROJECT NAME: WESTFORD - FAIRFAX
	PROJECT NUMBER: STP 2804(1)
	FILE NAME: p08c212.dgn
	PLOT DATE: 31-OCT-2012 13:57
PROJECT LEADER: JLL	DRAWN BY: STANTEC
DESIGNED BY: STANTEC	CHECKED BY: JLL
IPARM FILE: p08c212113.i	SHEET 29 OF 79



R=3