


646.402 DURABLE 4 INCH WHITE LINE, THERMOPLASTIC  
 (ALL LINES WILL INCLUDE EDGE LINE BREAKS  
 AND RADII FOR SIDE ROADS)  
 STA. 203+00 TO 207+50, SOLID LT & RT

646.602 TEMPORARY 4 INCH WHITE LINE, PAINT  
 (ALL LINES WILL INCLUDE EDGE LINE BREAKS  
 AND RADII FOR SIDE ROADS)  
 STA. 203+00 TO 207+50, SOLID LT & RT

675.50 REMOVING SIGNS  
 AS SHOWN - 2

646.412 DURABLE 4 INCH YELLOW LINE, THERMOPLASTIC  
 (ALL LINES WILL INCLUDE C BREAKS FOR SIDE ROADS)  
 STA. 203+00 TO 207+50, SOLID LT & RT

646.612 TEMPORARY 4 INCH YELLOW LINE, PAINT  
 (ALL LINES WILL INCLUDE C BREAKS FOR SIDE ROADS)  
 STA. 203+00 TO 207+50, SOLID LT & RT

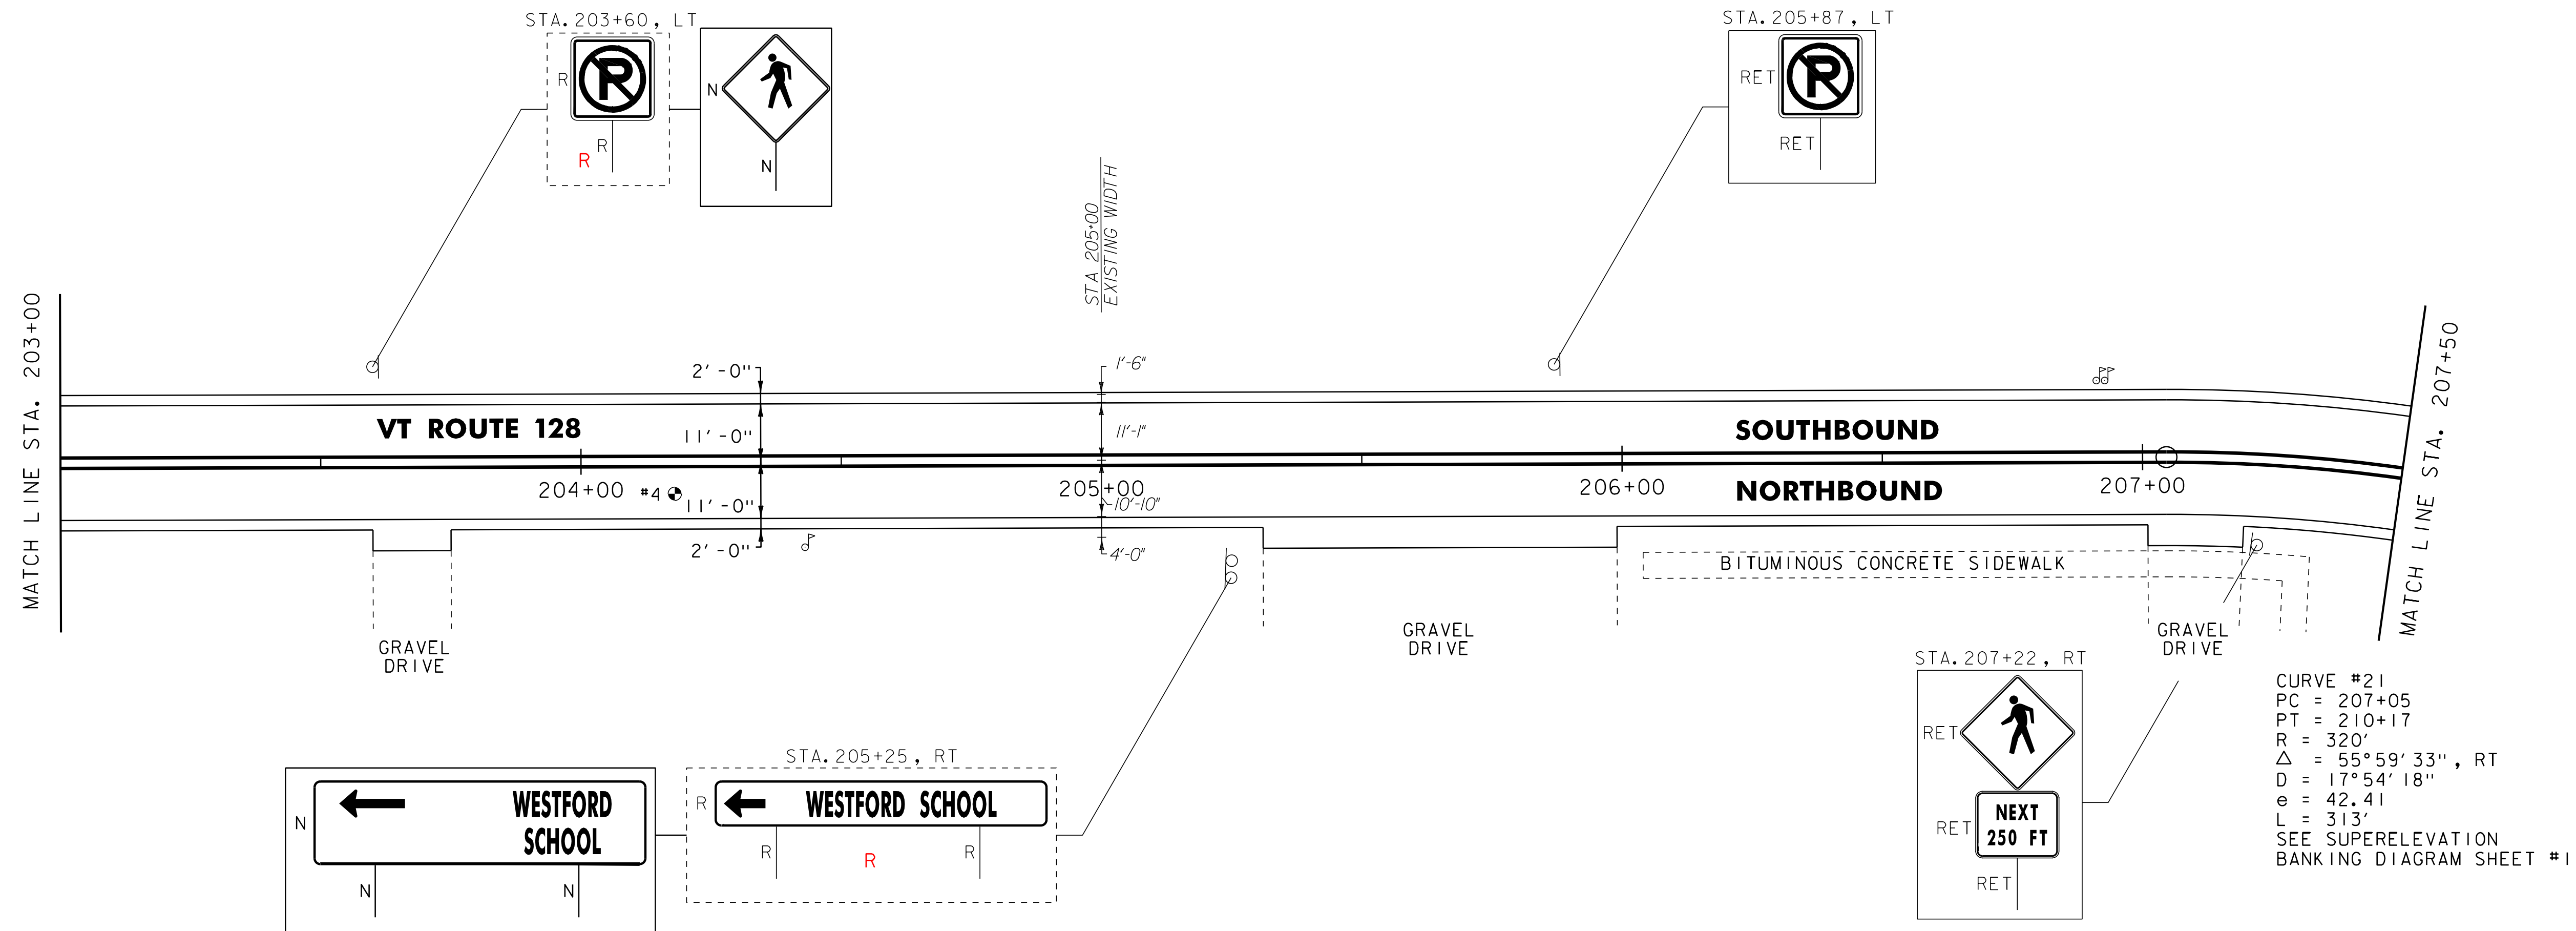

- NOTES:  
 1. ALL EXISTING SIGNS NOT SHOWN SHALL BE RETAINED.  
 2. FOR LEGENDS, SEE LAYOUT SHEET #1.  
**NOT TO SCALE**

PAVEMENT CORE DATA			
CORE #	DEPTH (IN.)	PCC	COMMENTS
4	11"	NO	

R=2



**PROJECT LAYOUT SHEET #15**

PROJECT NAME: WESTFORD - FAIRFAX  
 PROJECT NUMBER: STP 2804(1)

FILE NAME: p08c212.dgn  
 PROJECT LEADER: JLL  
 DESIGNED BY: STANTEC  
 IPARM FILE: p08c212115.i

PLOT DATE: 31-OCT-2012 13:57  
 DRAWN BY: STANTEC  
 CHECKED BY: JLL  
 SHEET 31 OF 79