

617.10 RELOCATE MAILBOX, SINGLE SUPPORT
 STA. 211+60, RT
 STA. 211+62, RT

646.402 DURABLE 4 INCH WHITE LINE, THERMOPLASTIC
 (ALL LINES WILL INCLUDE EDGE LINE BREAKS AND RADIUS FOR SIDE ROADS)
 STA. 207+50 TO 213+00, SOLID LT & RT
 STA. 208+28, SOLID LT (TH I EDGELINES)

646.412 DURABLE 4 INCH YELLOW LINE, THERMOPLASTIC
 (ALL LINES WILL INCLUDE C BREAKS FOR SIDE ROADS)
 STA. 207+50 TO 213+00, SOLID LT & RT
 STA. 208+28, DOUBLE SOLID LT (TH I)

646.482 DURABLE 24 INCH STOP BAR, THERMOPLASTIC
 STA. 208+28, LT (TH I)

646.492 DURABLE LETTER OR SYMBOL, THERMOPLASTIC
 STA. 208+28, LT - "STOP"


646.602 TEMPORARY 4 INCH WHITE LINE, PAINT
 (ALL LINES WILL INCLUDE EDGE LINE BREAKS AND RADIUS FOR SIDE ROADS)
 STA. 207+50 TO 213+00, SOLID LT & RT
 STA. 208+28, SOLID LT (TH I EDGELINES)

646.612 TEMPORARY 4 INCH YELLOW LINE, PAINT
 (ALL LINES WILL INCLUDE C BREAKS FOR SIDE ROADS)
 STA. 207+50 TO 213+00, SOLID LT & RT
 STA. 208+28, DOUBLE SOLID LT (TH I)

646.682 TEMPORARY 24 INCH STOP BAR, PAINT
 STA. 208+28, LT (TH I)

646.692 TEMPORARY LETTER OR SYMBOL, PAINT
 STA. 208+28, LT - "STOP"

675.50 REMOVING SIGNS
 AS SHOWN - 4

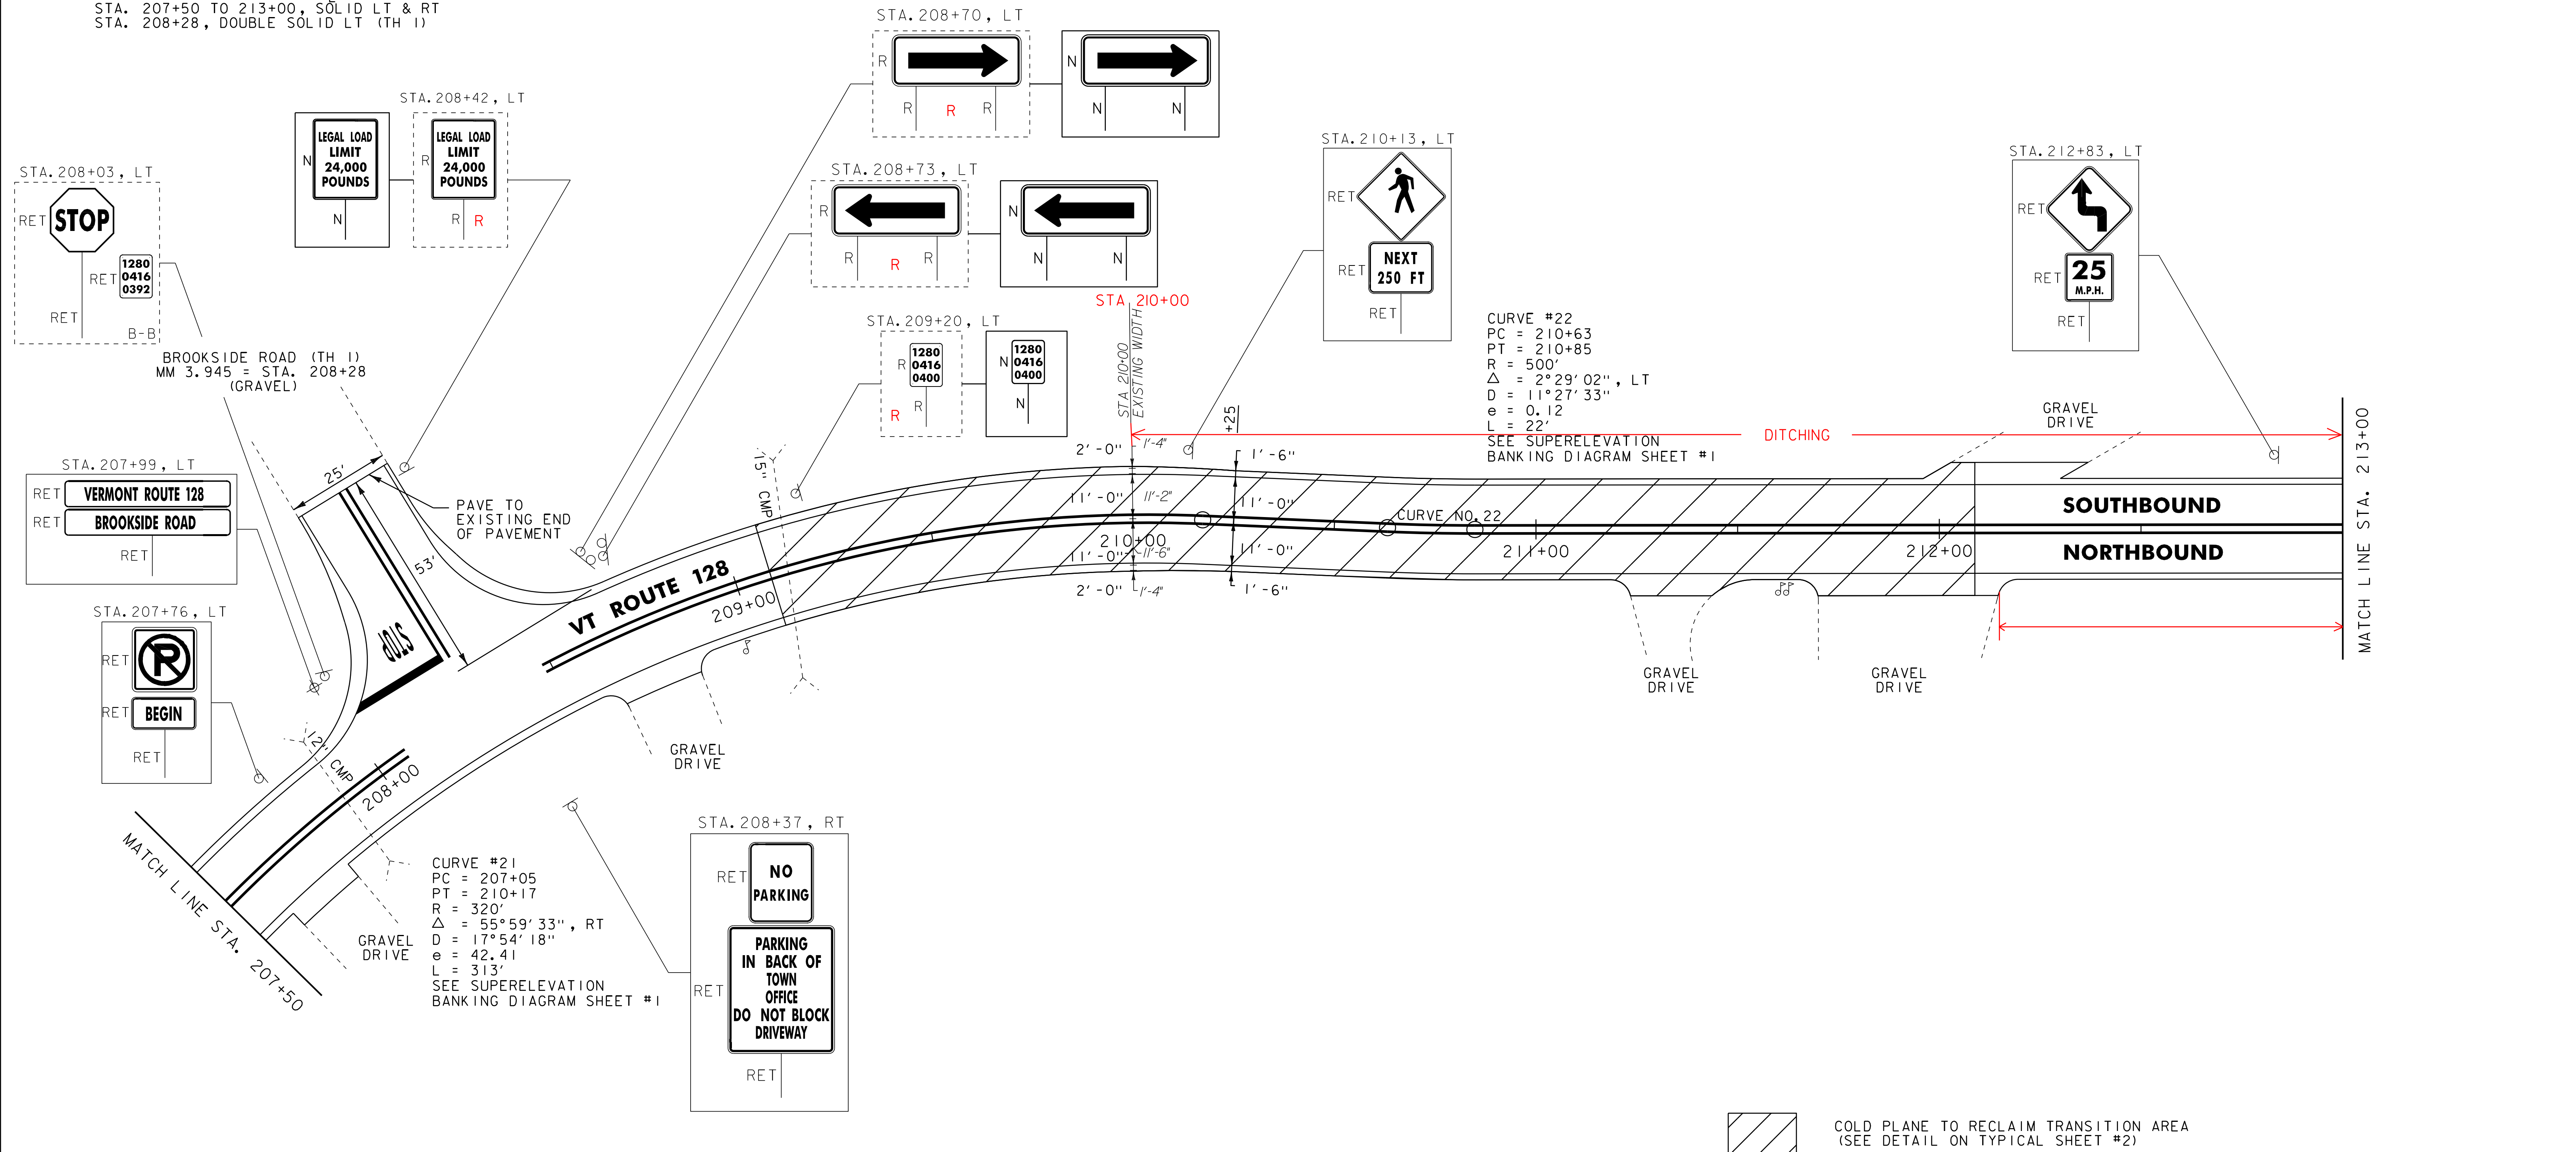

NOTES:
 1. ALL EXISTING SIGNS NOT SHOWN SHALL BE RETAINED.
 2. FOR LEGENDS, SEE LAYOUT SHEET #1.
NOT TO SCALE

PROJECT LAYOUT SHEET #16	PROJECT NAME: WESTFORD - FAIRFAX
	PROJECT NUMBER: STP 2804(1)
	FILE NAME: p08c212.dgn
	PLOT DATE: 31-OCT-2012 13:57
	PROJECT LEADER: JLL
	DRAWN BY: STANTEC
	DESIGNED BY: STANTEC
	CHECKED BY: JLL
	IPARM FILE: p08c212116.i
	SHEET 32 OF 79

