

616.35 TREATED TIMBER CURB
STA. 229+00 TO 229+60, RT

621.80 REMOVAL AND DISPOSAL OF GUARDRAIL
STA. 228+28 TO 230+08, RT

646.412 DURABLE 4 INCH YELLOW LINE, THERMOPLASTIC
(ALL LINES WILL INCLUDE C BREAKS FOR SIDE ROADS)
STA. 225+00 TO 231+00, SOLID LT & RT

646.602 TEMPORARY 4 INCH WHITE LINE, PAINT
(ALL LINES WILL INCLUDE EDGE LINE BREAKS AND RADII FOR SIDE ROADS)
STA. 225+00 TO 231+00, SOLID LT & RT


646.612 TEMPORARY 4 INCH YELLOW LINE, PAINT
(ALL LINES WILL INCLUDE C BREAKS FOR SIDE ROADS)
STA. 225+00 TO 231+00, SOLID LT & RT

617.10 RELOCATE MAILBOX, SINGLE SUPPORT
STA. 225+04, RT
STA. 225+06, RT

646.402 DURABLE 4 INCH WHITE LINE, THERMOPLASTIC
(ALL LINES WILL INCLUDE EDGE LINE BREAKS AND RADII FOR SIDE ROADS)
STA. 225+00 TO 231+00, SOLID LT & RT

621.20 STEEL BEAM GUARDRAIL, GALVANIZED
STA. 226+70.5 TO 230+08, RT
228+33

621.60 ANCHOR FOR STEEL BEAM RAIL
STA. 226+70.5, RT 228+33 RT
STA. 230+08, RT

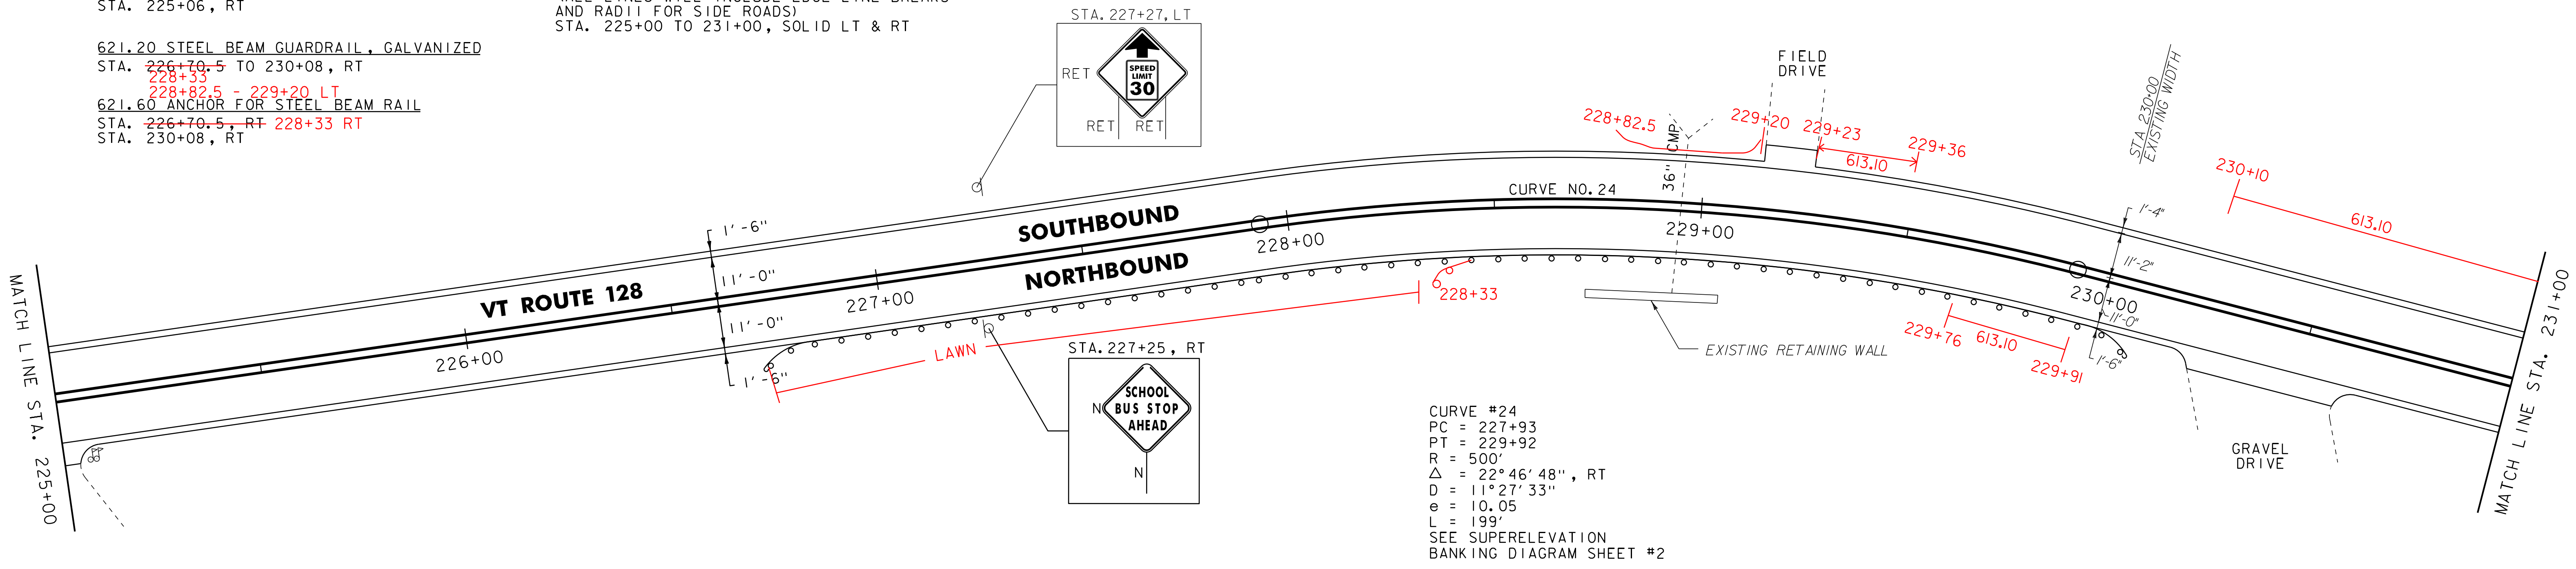


646.402 DURABLE 4 INCH WHITE LINE, THERMOPLASTIC
(ALL LINES WILL INCLUDE EDGE LINE BREAKS AND RADII FOR SIDE ROADS)
STA. 231+00 TO 237+00, SOLID LT & RT

646.412 DURABLE 4 INCH YELLOW LINE, THERMOPLASTIC
(ALL LINES WILL INCLUDE C BREAKS FOR SIDE ROADS)
STA. 231+00 TO 237+00, SOLID LT & RT

646.602 TEMPORARY 4 INCH WHITE LINE, PAINT
(ALL LINES WILL INCLUDE EDGE LINE BREAKS AND RADII FOR SIDE ROADS)
STA. 231+00 TO 237+00, SOLID LT & RT

646.612 TEMPORARY 4 INCH YELLOW LINE, PAINT
(ALL LINES WILL INCLUDE C BREAKS FOR SIDE ROADS)
STA. 231+00 TO 237+00, SOLID LT & RT

675.50 REMOVING SIGNS
AS SHOWN - 4

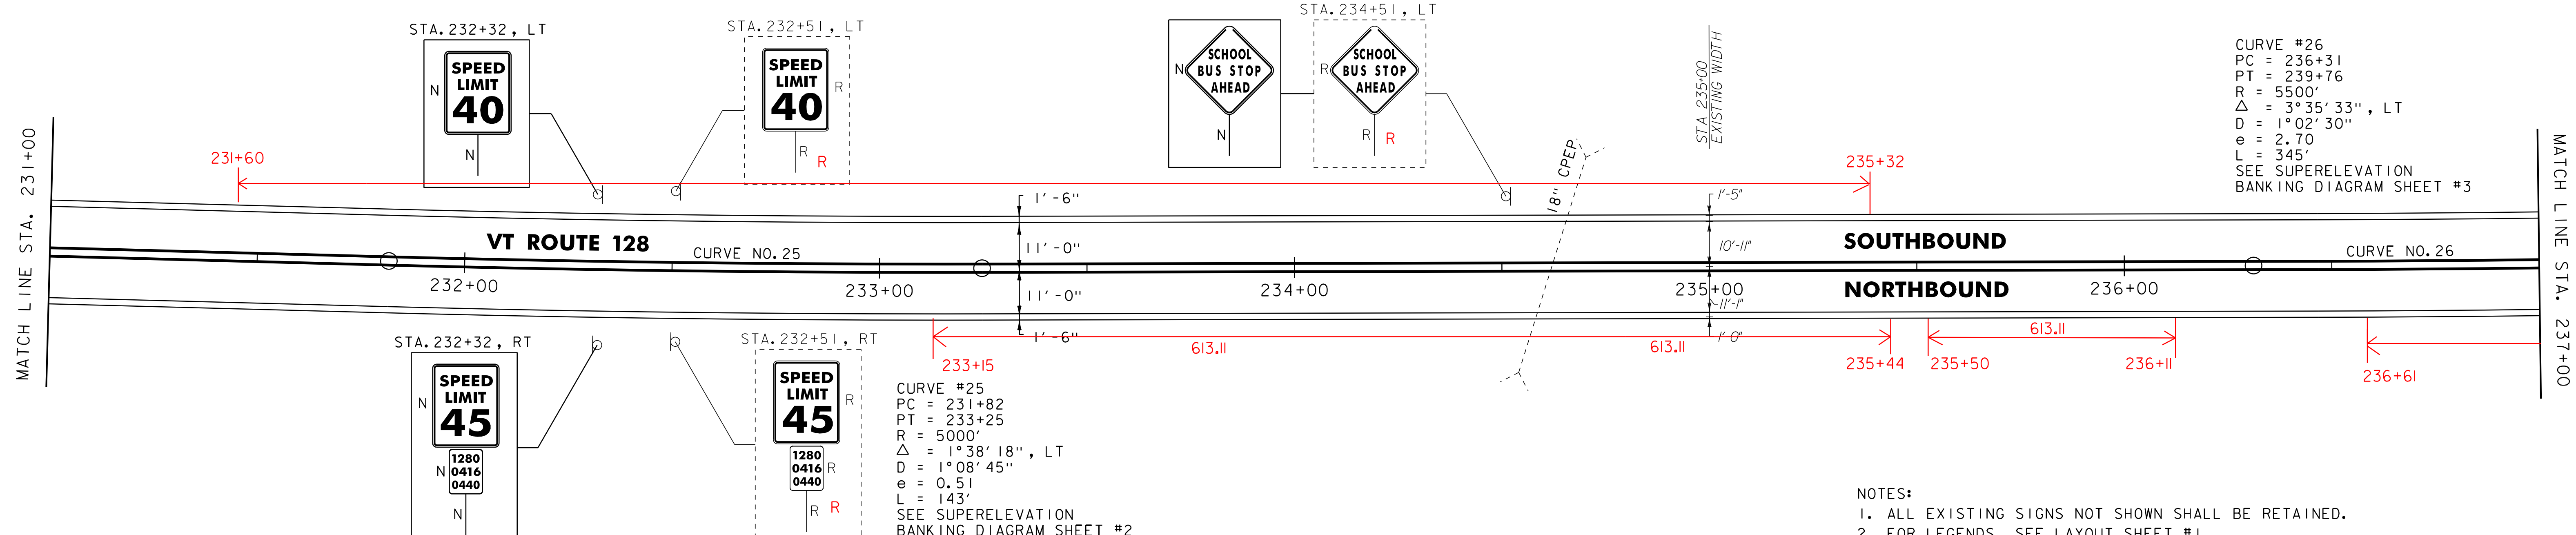

NOTES:
1. ALL EXISTING SIGNS NOT SHOWN SHALL BE RETAINED.
2. FOR LEGENDS, SEE LAYOUT SHEET #1.
NOT TO SCALE

PROJECT LAYOUT SHEET #18

PROJECT NAME: WESTFORD - FAIRFAX	FILE NAME: p08c212.dgn	PLOT DATE: 31-OCT-2012 13:57
PROJECT NUMBER: STP 2804(1)	PROJECT LEADER: JLL	DRAWN BY: STANTEC
	DESIGNED BY: STANTEC	CHECKED BY: JLL
	IPARM FILE: p08c212118.i	SHEET 34 OF 79



R=3