


617.10 RELOCATE MAILBOX, SINGLE SUPPORT
 STA. 238+59, RT
 STA. 238+61, RT
 STA. 238+63, RT

646.402 DURABLE 4 INCH WHITE LINE, THERMOPLASTIC
 (ALL LINES WILL INCLUDE EDGE LINE BREAKS
 AND RADII FOR SIDE ROADS)
 STA. 237+00 TO 243+00, SOLID LT & RT

646.412 DURABLE 4 INCH YELLOW LINE, THERMOPLASTIC
 (ALL LINES WILL INCLUDE C BREAKS FOR SIDE ROADS)
 STA. 237+00 TO 243+00, SOLID LT & RT

646.602 TEMPORARY 4 INCH WHITE LINE, PAINT
 (ALL LINES WILL INCLUDE EDGE LINE BREAKS
 AND RADII FOR SIDE ROADS)
 STA. 237+00 TO 243+00, SOLID LT & RT

646.612 TEMPORARY 4 INCH YELLOW LINE, PAINT
 (ALL LINES WILL INCLUDE C BREAKS FOR SIDE ROADS)
 STA. 237+00 TO 243+00, SOLID LT & RT

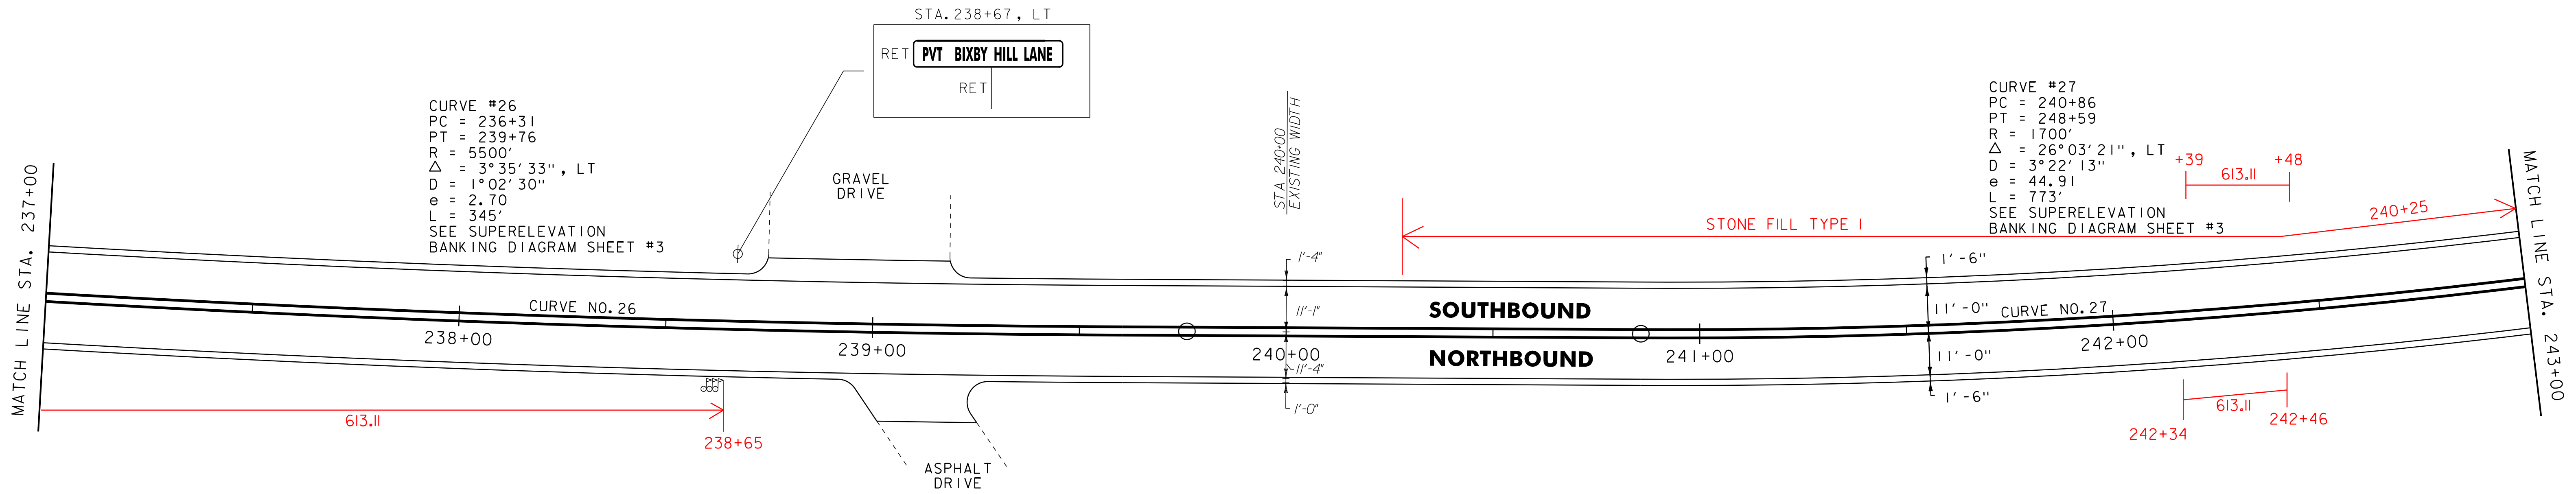

621.20 STEEL BEAM GUARDRAIL, GALVANIZED
 STA. 244+85 TO 249+00, LT 246+04 TO 247+42 LT
 STA. 245+79 TO 246+29, RT
 STA. 246+79 TO 248+29, RT (BURIED END)

621.80 REMOVAL AND DISPOSAL OF GUARDRAIL
 STA. 245+86 TO 247+99, RT
 STA. 246+06 TO 247+42, LT

646.412 DURABLE 4 INCH YELLOW LINE, THERMOPLASTIC
 (ALL LINES WILL INCLUDE C BREAKS FOR SIDE ROADS)
 STA. 243+00 TO 249+00, SOLID LT & RT

646.602 TEMPORARY 4 INCH WHITE LINE, PAINT
 (ALL LINES WILL INCLUDE EDGE LINE BREAKS
 AND RADII FOR SIDE ROADS)
 STA. 243+00 TO 249+00, SOLID LT & RT

675.50 REMOVING SIGNS
 AS SHOWN - 5


621.205 STEEL BEAM GUARDRAIL, GALVANIZED W/8 FEET POSTS
 STA. 246+29 TO 246+79, RT

646.402 DURABLE 4 INCH WHITE LINE, THERMOPLASTIC
 (ALL LINES WILL INCLUDE EDGE LINE BREAKS
 AND RADII FOR SIDE ROADS)
 STA. 243+00 TO 249+00, SOLID LT & RT

646.612 TEMPORARY 4 INCH YELLOW LINE, PAINT
 (ALL LINES WILL INCLUDE C BREAKS FOR SIDE ROADS)
 STA. 243+00 TO 249+00, SOLID LT & RT

621.60 ANCHOR FOR STEEL BEAM RAIL
 STA. 244+85, LT 246+04 LT
 STA. 245+79, RT
 STA. 248+29, RT
 STA. 247+42 LT

CURVE #27
 PC = 240+86
 PT = 248+59
 R = 1700'
 Δ = 26°03'21", LT
 D = 3°22'13"
 e = 44.91
 L = 773'
 SEE SUPERELEVATION
 BANKING DIAGRAM SHEET #3

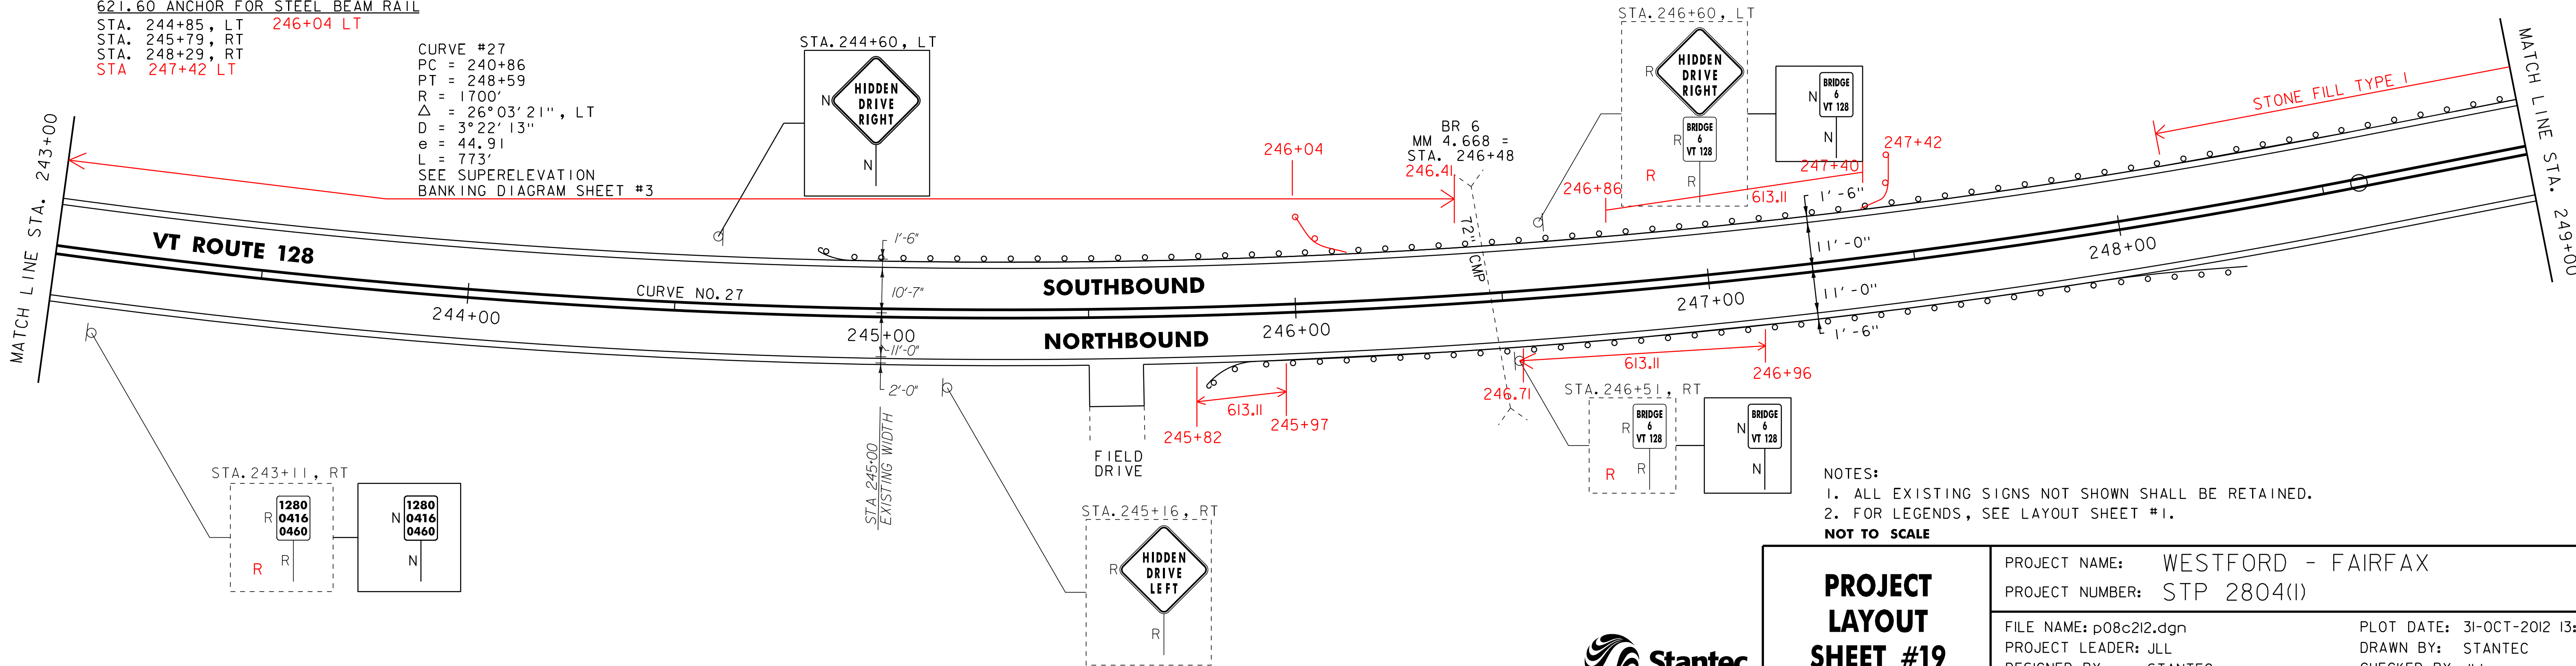

NOTES:
 1. ALL EXISTING SIGNS NOT SHOWN SHALL BE RETAINED.
 2. FOR LEGENDS, SEE LAYOUT SHEET #1.
 NOT TO SCALE

PROJECT LAYOUT SHEET #19	PROJECT NAME: WESTFORD - FAIRFAX	FILE NAME: p08c212.dgn	PLOT DATE: 31-OCT-2012 13:57
	PROJECT NUMBER: STP 2804(1)	PROJECT LEADER: JLL	DRAWN BY: STANTEC
	DESIGNED BY: STANTEC	CHECKED BY: JLL	
	IPARM FILE: p08c212119.i		SHEET 35 OF 79

