


617.10 RELOCATE MAILBOX, SINGLE SUPPORT
 STA. 249+96, RT
 STA. 250+53, RT
 STA. 250+55, RT
 STA. 251+75, RT
 STA. 253+46, RT

621.20 STEEL BEAM GUARDRAIL, GALVANIZED
 STA. 249+00 TO 249+22.5, LT
 621.60 ANCHOR FOR STEEL BEAM RAIL
 STA. 249+22.5, LT

646.402 DURABLE 4 INCH WHITE LINE, THERMOPLASTIC
 (ALL LINES WILL INCLUDE EDGE LINE BREAKS AND RADII FOR SIDE ROADS)
 STA. 249+00 TO 255+00, SOLID LT & RT
 646.412 DURABLE 4 INCH YELLOW LINE, THERMOPLASTIC
 (ALL LINES WILL INCLUDE C BREAKS FOR SIDE ROADS)
 STA. 249+00 TO 255+00, SOLID LT & RT

646.602 TEMPORARY 4 INCH WHITE LINE, PAINT
 (ALL LINES WILL INCLUDE EDGE LINE BREAKS AND RADII FOR SIDE ROADS)
 STA. 249+00 TO 255+00, SOLID LT & RT
 646.612 TEMPORARY 4 INCH YELLOW LINE, PAINT
 (ALL LINES WILL INCLUDE C BREAKS FOR SIDE ROADS)
 STA. 249+00 TO 255+00, SOLID LT & RT

CURVE #28
 PC = 252+73
 PT = 255+61
 R = 800'
 $\Delta = 20^\circ 39' 23''$, LT
 D = $7^\circ 09' 43''$
 e = 13.18
 L = 288'
 SEE SUPERELEVATION BANKING DIAGRAM SHEET #4

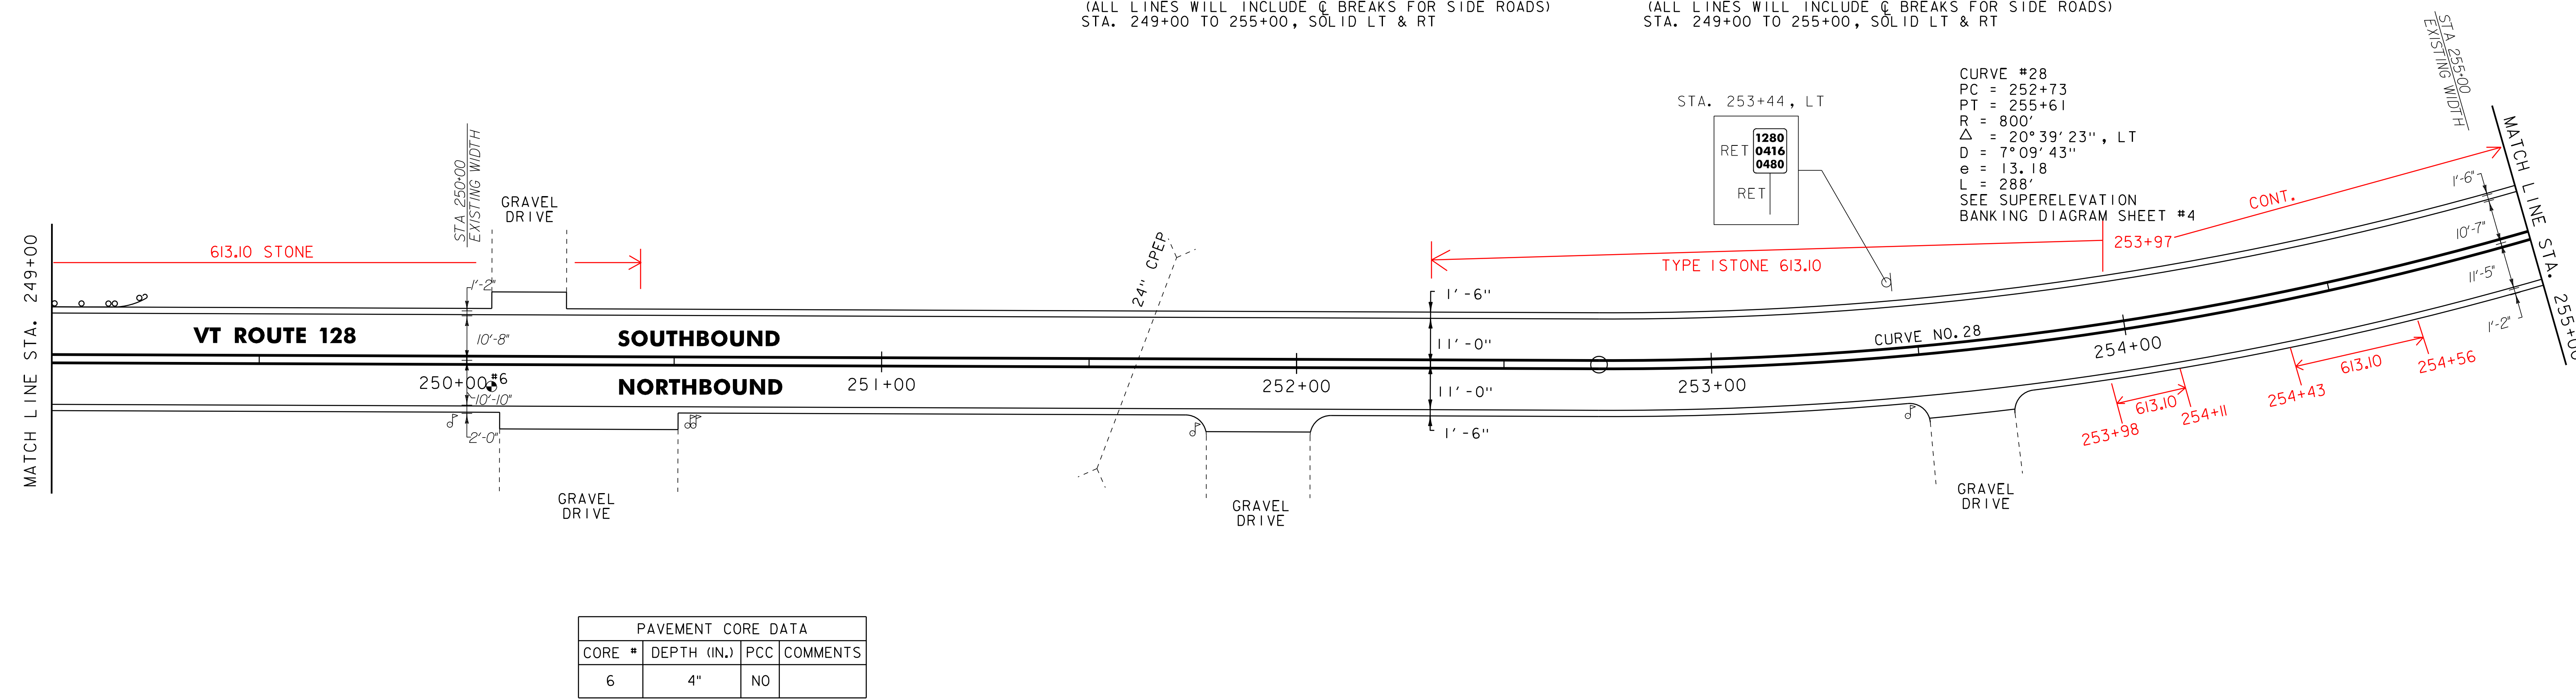


617.10 RELOCATE MAILBOX, SINGLE SUPPORT
 STA. 257+18, RT
 STA. 260+27, RT

646.402 DURABLE 4 INCH WHITE LINE, THERMOPLASTIC
 (ALL LINES WILL INCLUDE EDGE LINE BREAKS AND RADII FOR SIDE ROADS)
 STA. 255+00 TO 261+00, SOLID LT & RT
 646.412 DURABLE 4 INCH YELLOW LINE, THERMOPLASTIC
 (ALL LINES WILL INCLUDE C BREAKS FOR SIDE ROADS)
 STA. 255+00 TO 261+00, SOLID LT & RT

646.602 TEMPORARY 4 INCH WHITE LINE, PAINT
 (ALL LINES WILL INCLUDE EDGE LINE BREAKS AND RADII FOR SIDE ROADS)
 STA. 255+00 TO 261+00, SOLID LT & RT

646.612 TEMPORARY 4 INCH YELLOW LINE, PAINT
 (ALL LINES WILL INCLUDE C BREAKS FOR SIDE ROADS)
 STA. 255+00 TO 261+00, SOLID LT & RT

675.50 REMOVING SIGNS
 AS SHOWN - 3

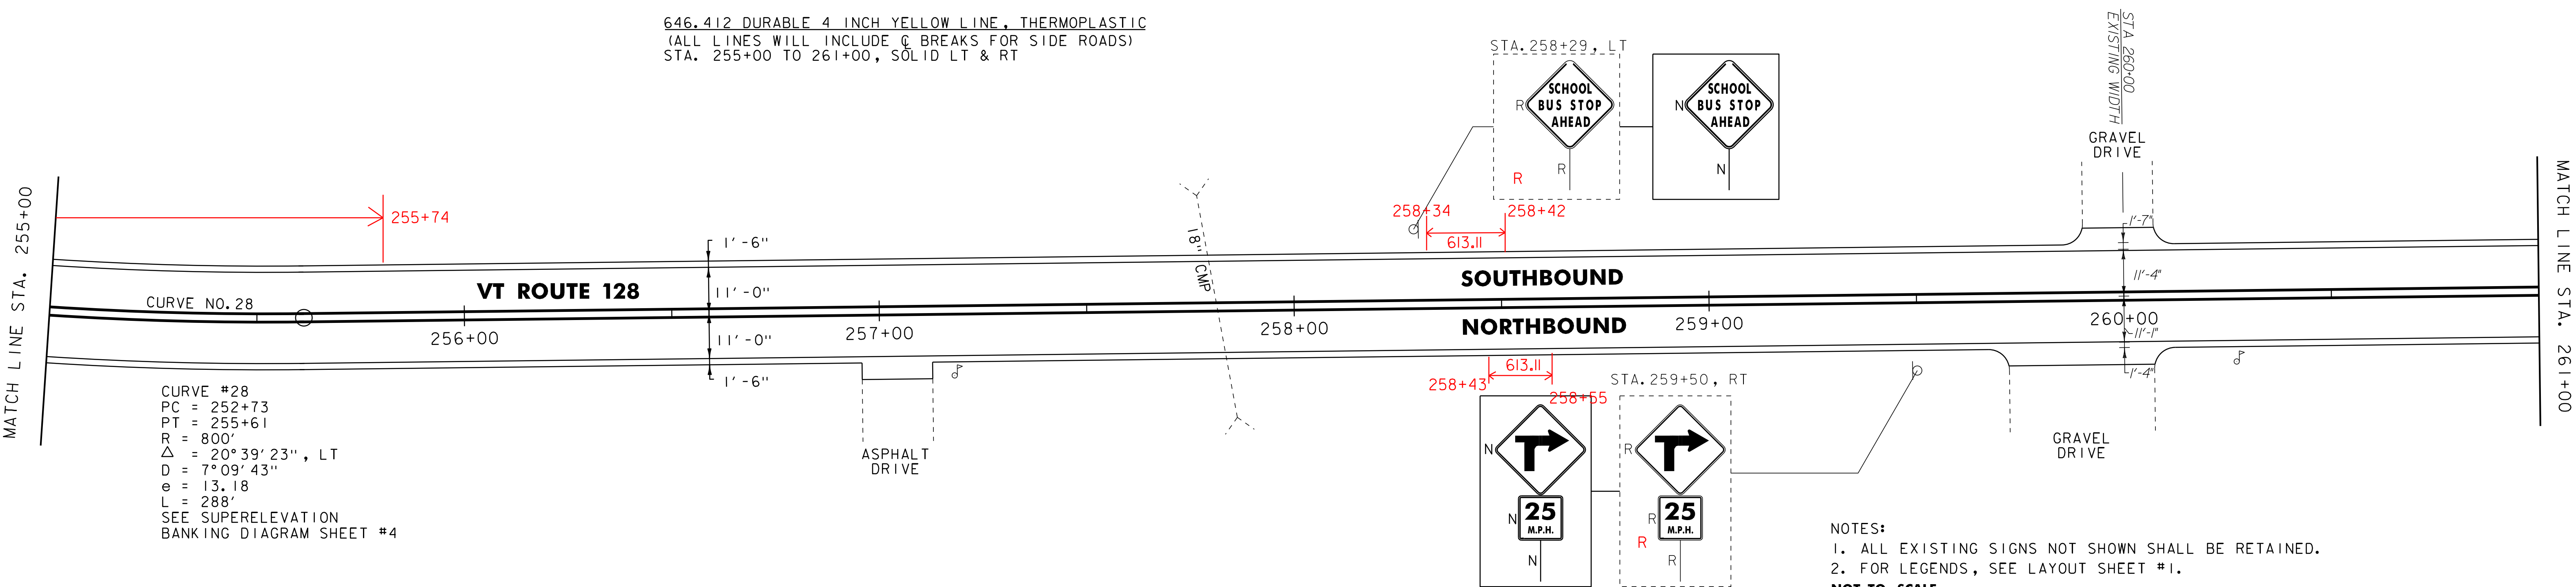

PROJECT LAYOUT SHEET #20	PROJECT NAME: WESTFORD - FAIRFAX
	PROJECT NUMBER: STP 2804(1)
	FILE NAME: p08c212.dgn
	PLOT DATE: 31-OCT-2012 13:57
	PROJECT LEADER: JLL
	DRAWN BY: STANTEC
	DESIGNED BY: STANTEC
	CHECKED BY: JLL
	IPARM FILE: p08c212120.i
	SHEET 36 OF 79

R=2