

621.20 STEEL BEAM GUARDRAIL, GALVANIZED
 STA. 264+31 TO 265+31, LT

621.60 ANCHOR FOR STEEL BEAM RAIL
 STA. 264+31, LT
 STA. 265+31, LT

646.402 DURABLE 4 INCH WHITE LINE, THERMOPLASTIC
 (ALL LINES WILL INCLUDE EDGE LINE BREAKS
 AND RADIUS FOR SIDE ROADS)
 STA. 261+00 TO 267+00, SOLID LT & RT
 STA. 264+68, SOLID LT (TH 7 EDGELINES)

646.412 DURABLE 4 INCH YELLOW LINE, THERMOPLASTIC
 (ALL LINES WILL INCLUDE C BREAKS FOR SIDE ROADS)
 STA. 261+00 TO 267+00, SOLID LT & RT
 STA. 264+68, DOUBLE SOLID LT (TH 7)

646.602 TEMPORARY 4 INCH WHITE LINE, PAINT
 (ALL LINES WILL INCLUDE EDGE LINE BREAKS
 AND RADIUS FOR SIDE ROADS)
 STA. 261+00 TO 267+00, SOLID LT & RT
 STA. 264+68, SOLID LT (TH 7 EDGELINES)

646.612 TEMPORARY 4 INCH YELLOW LINE, PAINT
 (ALL LINES WILL INCLUDE C BREAKS FOR SIDE ROADS)
 STA. 261+00 TO 267+00, SOLID LT & RT
 STA. 264+68, DOUBLE SOLID LT (TH 7)


646.482 DURABLE 24 INCH STOP BAR, THERMOPLASTIC
 STA. 264+88, LT (TH 4)

646.492 DURABLE LETTER OR SYMBOL, THERMOPLASTIC
 STA. 264+88, LT - "STOP"

646.682 TEMPORARY 24 INCH STOP BAR, PAINT
 STA. 264+88, LT (TH 4)

646.692 TEMPORARY LETTER OR SYMBOL, PAINT
 STA. 264+88, LT - "STOP"

675.50 REMOVING SIGNS
 AS SHOWN - 4

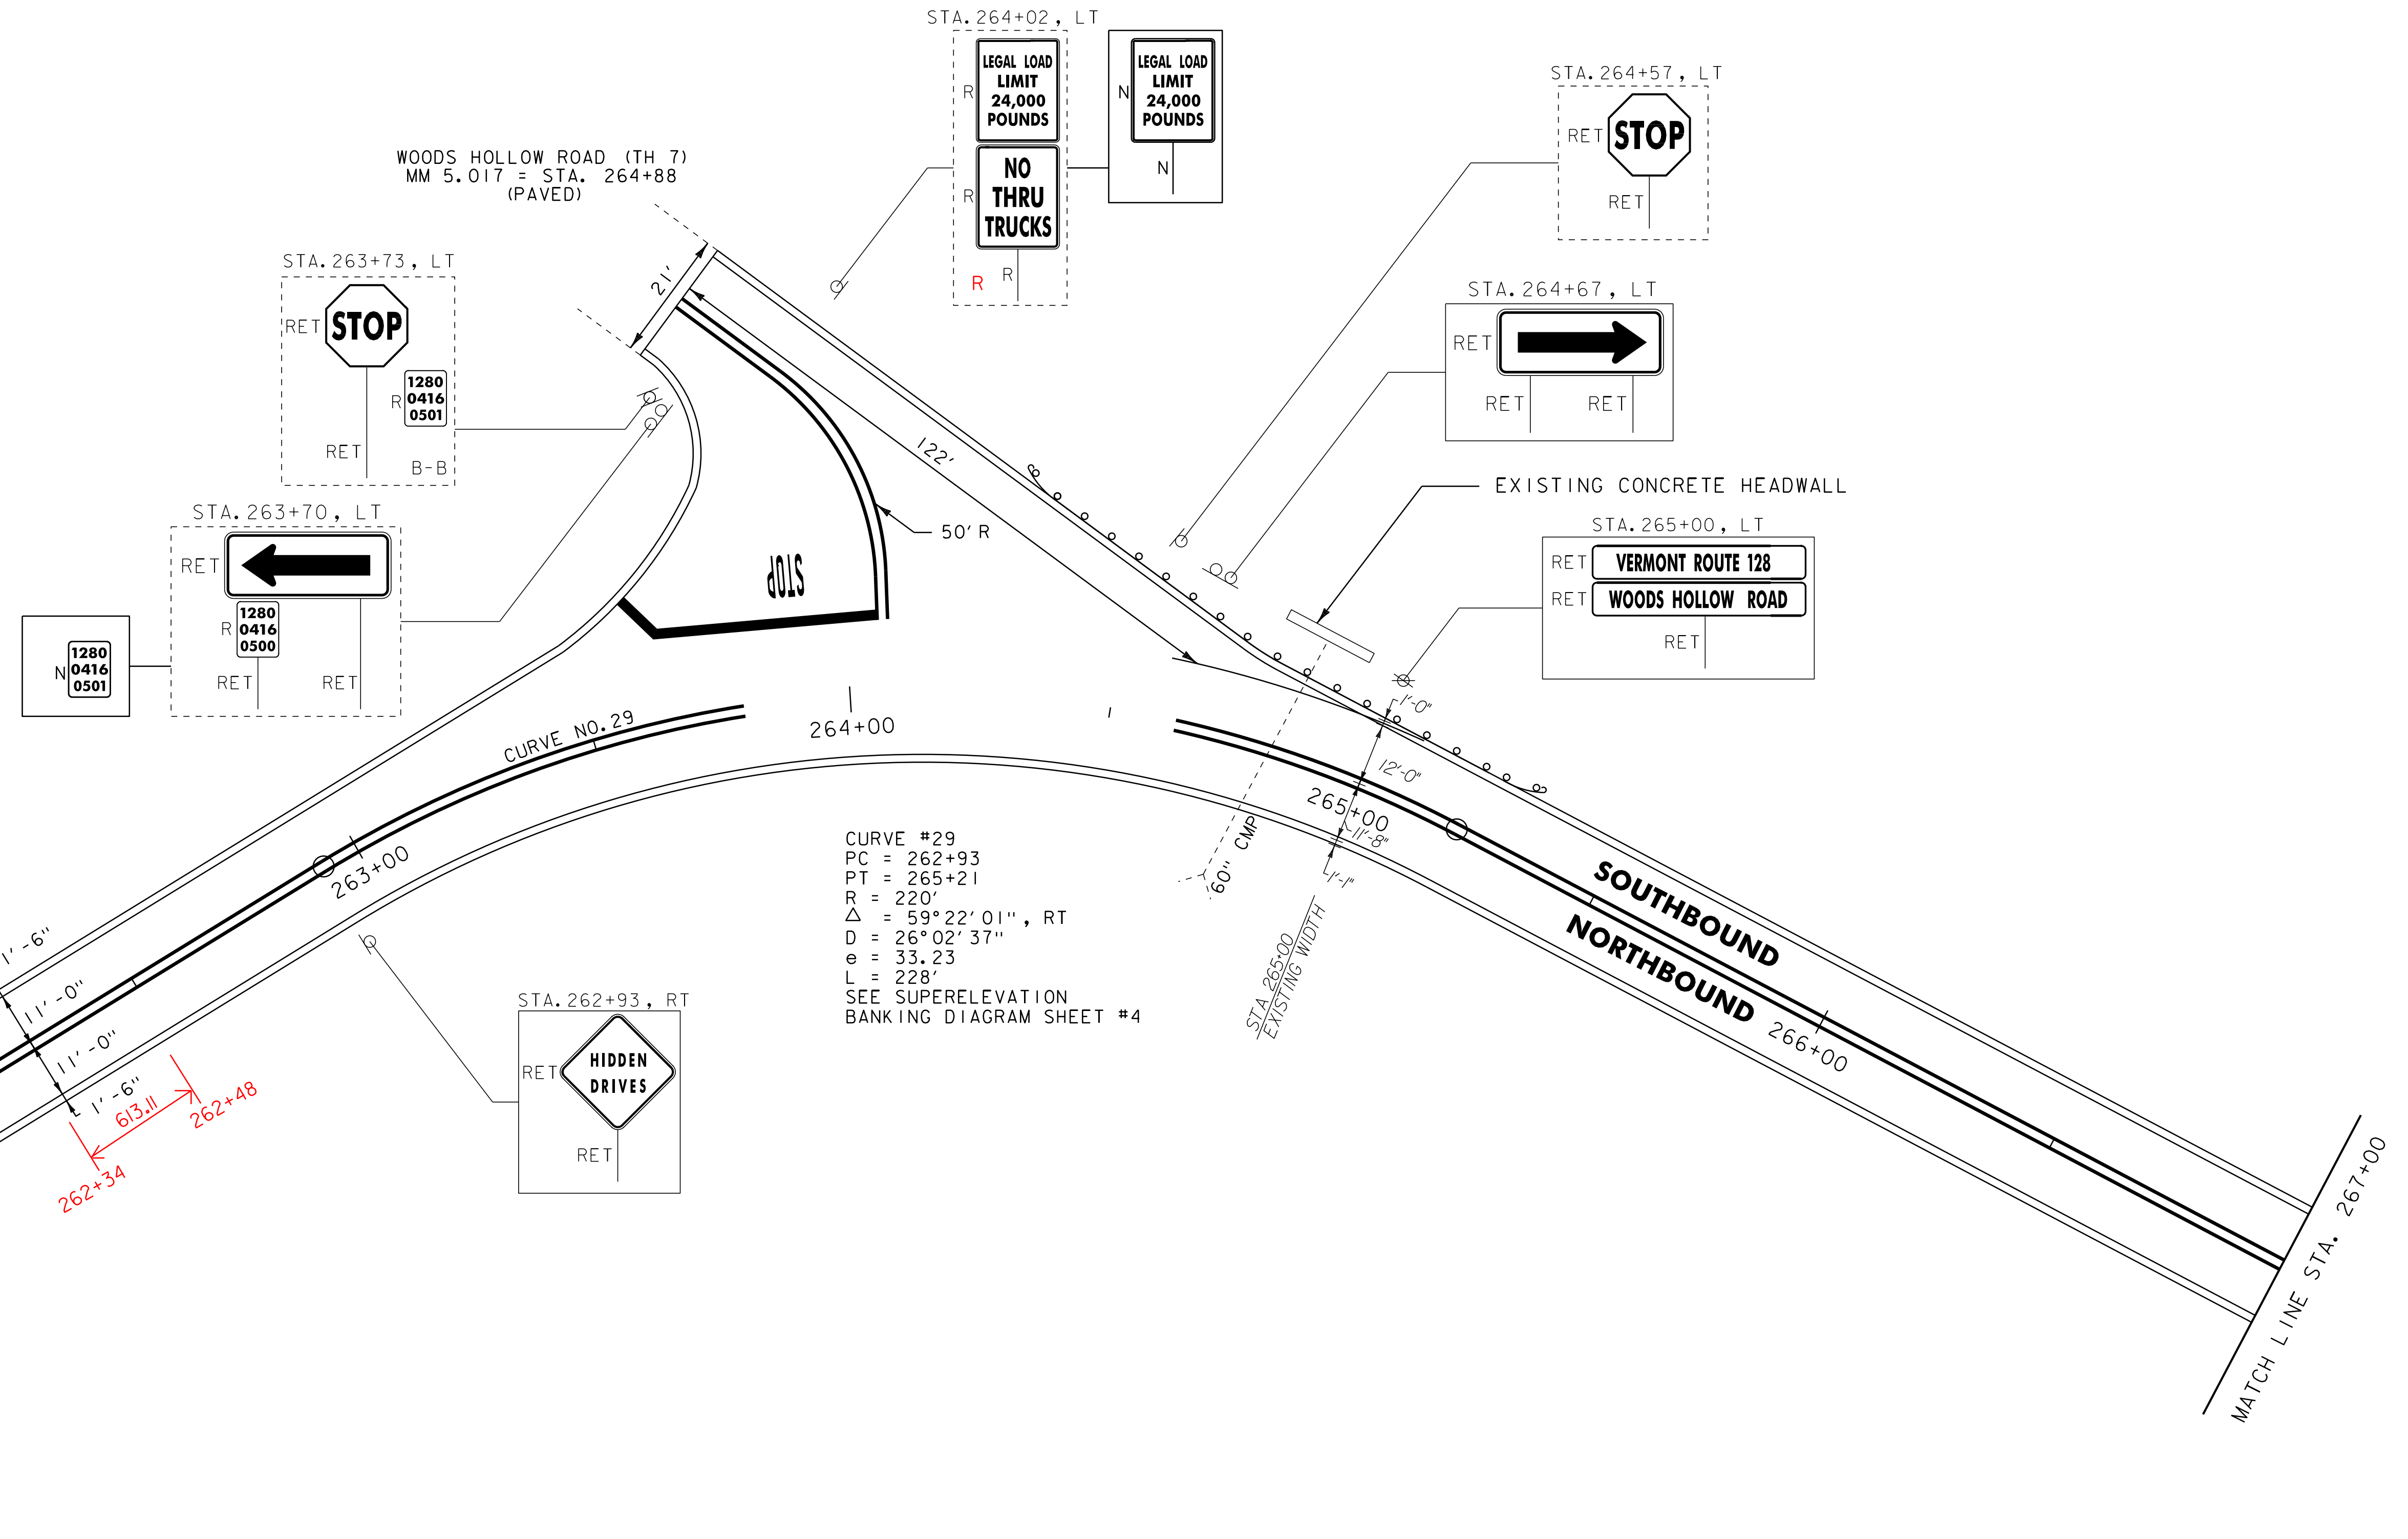

NOTES:
 1. ALL EXISTING SIGNS NOT SHOWN SHALL BE RETAINED.
 2. FOR LEGENDS, SEE LAYOUT SHEET #1.
 NOT TO SCALE

PROJECT LAYOUT SHEET #21	PROJECT NAME: WESTFORD - FAIRFAX
	PROJECT NUMBER: STP 2804(I)
	FILE NAME: p08c212.dgn
	PLOT DATE: 31-OCT-2012 13:57
DESIGNED BY: STANTEC	DRAWN BY: STANTEC
IPARM FILE: p08c2121.i	CHECKED BY: JLL
	SHEET 37 OF 79



R=1