

617.10 RELOCATE MAILBOX, SINGLE SUPPORT
 STA. 279+55, LT
 STA. 282+05, LT

617.12 RELOCATE MAILBOX, MULTIPLE SUPPORT
 STA. 281+40, LT

621.20 STEEL BEAM GUARDRAIL, GALVANIZED
 STA. 279+00 TO 279+06.5, LT (BURIED END)
 (SEE GUARDRAIL DETAIL SHEET)


621.60 ANCHOR FOR STEEL BEAM RAIL
 STA. 279+06.5, LT

646.402 DURABLE 4 INCH WHITE LINE, THERMOPLASTIC
 (ALL LINES WILL INCLUDE EDGE LINE BREAKS
 AND RADII FOR SIDE ROADS)
 STA. 279+00 TO 285+00, SOLID LT & RT

646.412 DURABLE 4 INCH YELLOW LINE, THERMOPLASTIC
 (ALL LINES WILL INCLUDE C BREAKS FOR SIDE ROADS)
 STA. 279+00 TO 285+00, SOLID LT & RT

646.602 TEMPORARY 4 INCH WHITE LINE, PAINT
 (ALL LINES WILL INCLUDE EDGE LINE BREAKS
 AND RADII FOR SIDE ROADS)
 STA. 279+00 TO 285+00, SOLID LT & RT

646.612 TEMPORARY 4 INCH YELLOW LINE, PAINT
 (ALL LINES WILL INCLUDE C BREAKS FOR SIDE ROADS)
 STA. 279+00 TO 285+00, SOLID LT & RT

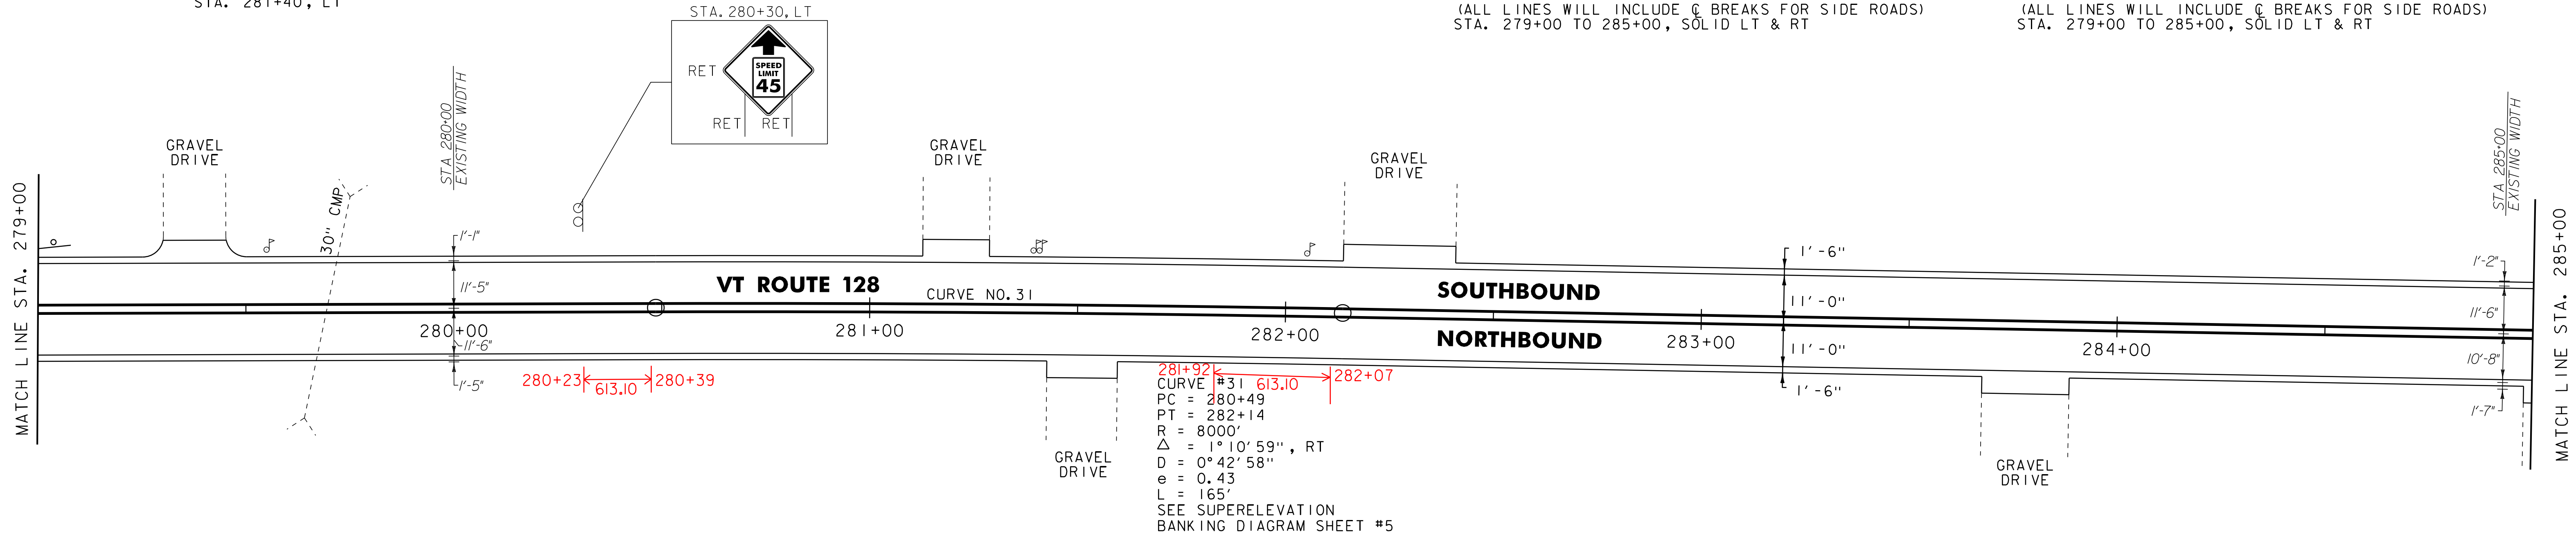


617.10 RELOCATE MAILBOX, SINGLE SUPPORT
 STA. 285+20, RT
 STA. 288+25, LT

646.402 DURABLE 4 INCH WHITE LINE, THERMOPLASTIC
 (ALL LINES WILL INCLUDE EDGE LINE BREAKS
 AND RADII FOR SIDE ROADS)
 STA. 285+00 TO 291+00, SOLID LT & RT

646.412 DURABLE 4 INCH YELLOW LINE, THERMOPLASTIC
 (ALL LINES WILL INCLUDE C BREAKS FOR SIDE ROADS)
 STA. 285+00 TO 291+00, SOLID LT & RT

646.612 TEMPORARY 4 INCH YELLOW LINE, PAINT
 (ALL LINES WILL INCLUDE C BREAKS FOR SIDE ROADS)
 STA. 285+00 TO 291+00, SOLID LT & RT

675.50 REMOVING SIGNS
 AS SHOWN - 3

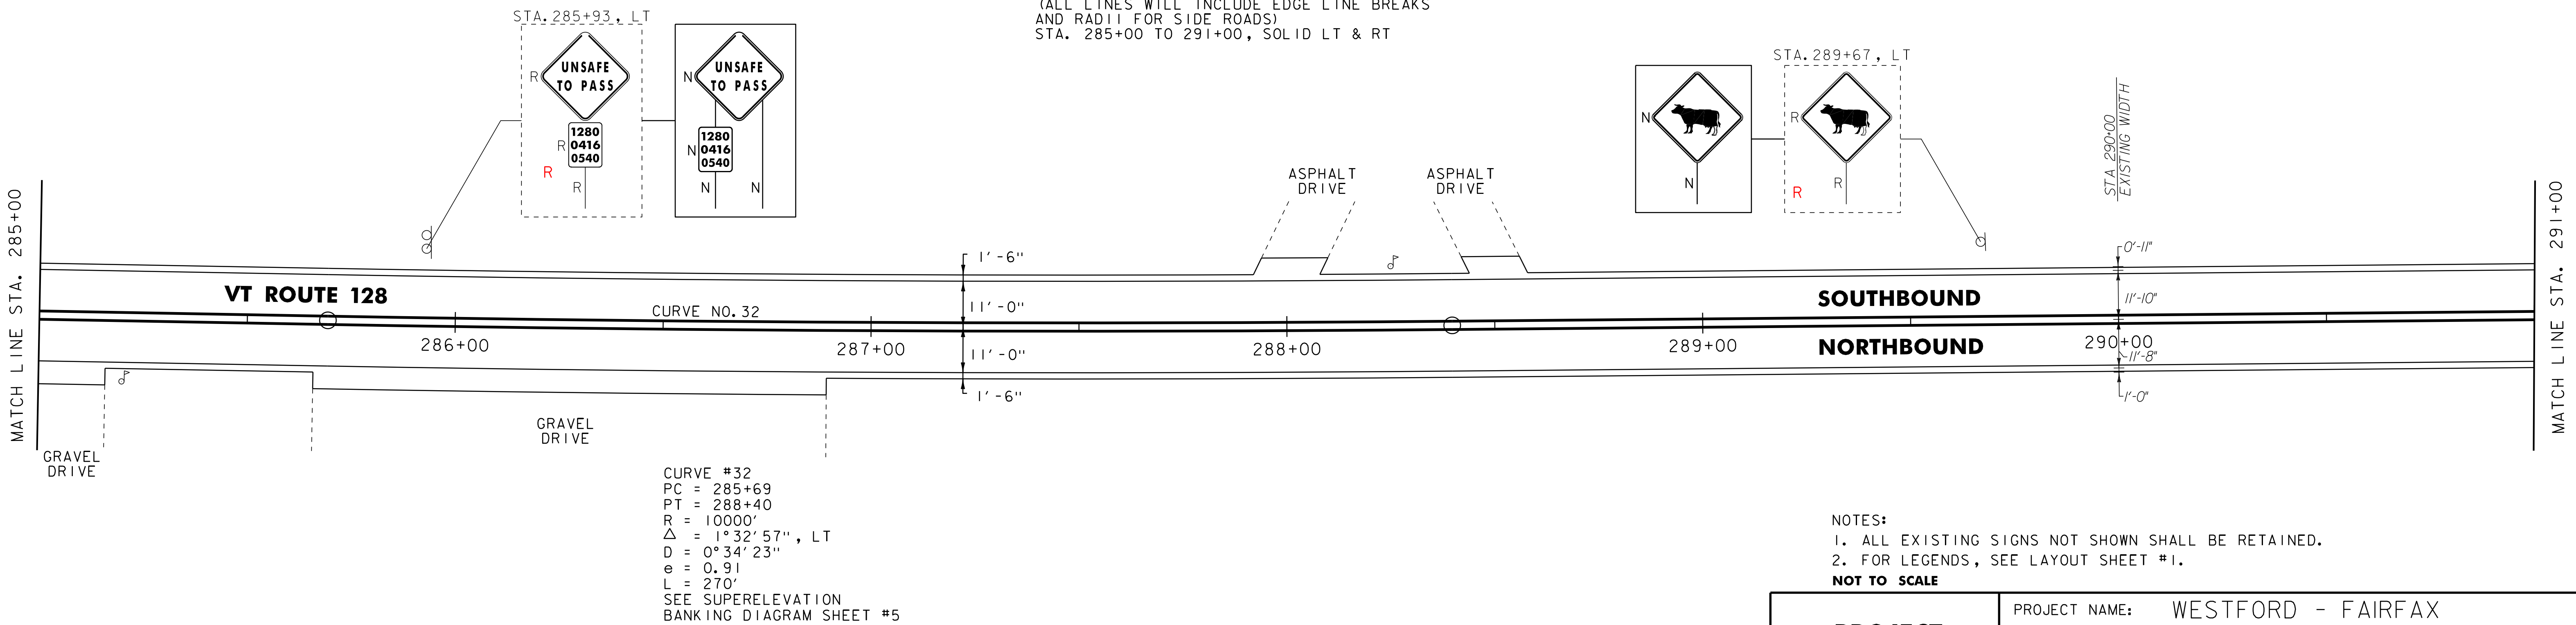

NOTES:
 1. ALL EXISTING SIGNS NOT SHOWN SHALL BE RETAINED.
 2. FOR LEGENDS, SEE LAYOUT SHEET #1.
 NOT TO SCALE

PROJECT LAYOUT SHEET #23

PROJECT NAME: WESTFORD - FAIRFAX
 PROJECT NUMBER: STP 2804(1)

FILE NAME: p08c212.dgn
 PROJECT LEADER: JLL
 DESIGNED BY: STANTEC
 IPARM FILE: p08c212123.i

PLOT DATE: 31-OCT-2012 13:58
 DRAWN BY: STANTEC
 CHECKED BY: JLL
 SHEET 39 OF 79

