

616.35 TREATED TIMBER CURB
STA. 303+00 TO 303+89, RT

621.80 REMOVAL AND DISPOSAL OF GUARDRAIL
STA. 302+95 TO 303+93, RT

617.10 RELOCATE MAILBOX, SINGLE SUPPORT
STA. 304+17, RT
STA. 304+27, RT

646.402 DURABLE 4 INCH WHITE LINE, THERMOPLASTIC
(ALL LINES WILL INCLUDE EDGE LINE BREAKS AND RADII FOR SIDE ROADS)
STA. 302+50 TO 308+50, SOLID LT & RT
STA. 303+24, SOLID LT (TH 2 EDGELINES)

621.20 STEEL BEAM GUARDRAIL, GALVANIZED
STA. 302+93 TO 303+93, RT

646.412 DURABLE 4 INCH YELLOW LINE, THERMOPLASTIC
(ALL LINES WILL INCLUDE C BREAKS FOR SIDE ROADS)
STA. 302+50 TO 308+50, SOLID LT & RT
STA. 303+24, DOUBLE SOLID LT (TH 2)

621.60 ANCHOR FOR STEEL BEAM RAIL
STA. 302+93, RT
STA. 303+93, RT

646.482 DURABLE 24 INCH STOP BAR, THERMOPLASTIC
STA. 303+24, LT (TH 2)

646.492 DURABLE LETTER OR SYMBOL, THERMOPLASTIC
STA. 303+24, LT - "STOP"

CURVE #34
PC = 305+28
PT = 308+86
R = 1800'
 $\Delta = 11^{\circ}23'25"$, RT
D = $3^{\circ}10'59"$
e = 8.93
L = 358'
SEE SUPERELEVATION BANKING DIAGRAM SHEET #6

646.602 TEMPORARY 4 INCH WHITE LINE, PAINT
(ALL LINES WILL INCLUDE EDGE LINE BREAKS AND RADII FOR SIDE ROADS)
STA. 302+50 TO 308+50, SOLID LT & RT
STA. 303+24, SOLID LT (TH 2 EDGELINES)


646.612 TEMPORARY 4 INCH YELLOW LINE, PAINT
(ALL LINES WILL INCLUDE C BREAKS FOR SIDE ROADS)
STA. 302+50 TO 308+50, SOLID LT & RT
STA. 303+24, DOUBLE SOLID LT (TH 2)

675.50 REMOVING SIGNS
AS SHOWN - 2

675.60 ERECTING SALVAGED SIGNS
AS SHOWN - 1

646.682 TEMPORARY 24 INCH STOP BAR, PAINT
STA. 303+24, LT (TH 2)

646.692 TEMPORARY LETTER OR SYMBOL, PAINT
STA. 303+24, LT - "STOP"

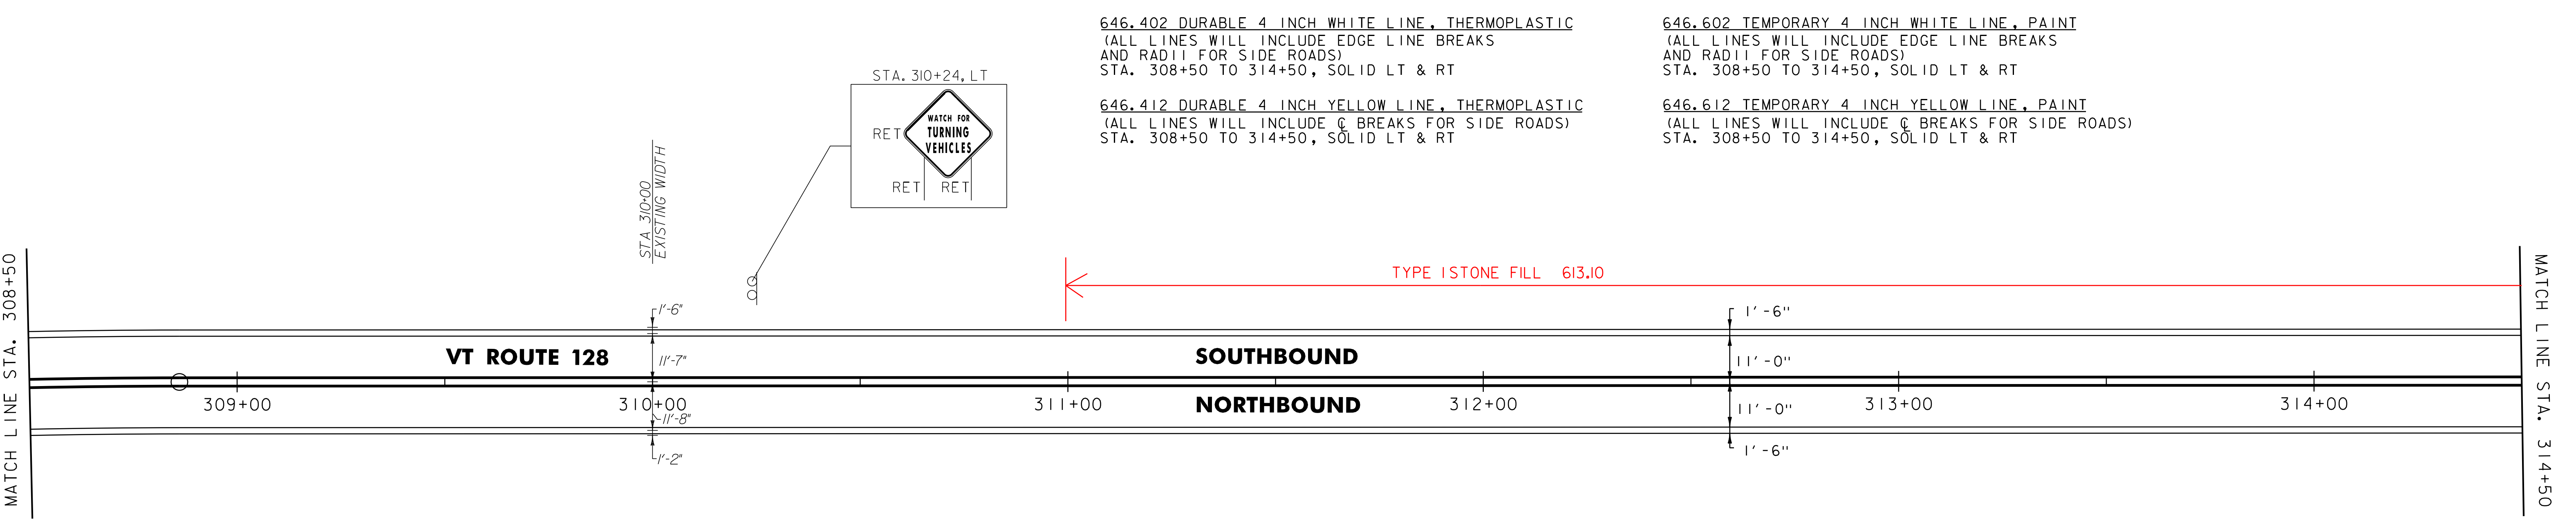

646.402 DURABLE 4 INCH WHITE LINE, THERMOPLASTIC
(ALL LINES WILL INCLUDE EDGE LINE BREAKS AND RADII FOR SIDE ROADS)
STA. 308+50 TO 314+50, SOLID LT & RT

646.602 TEMPORARY 4 INCH WHITE LINE, PAINT
(ALL LINES WILL INCLUDE EDGE LINE BREAKS AND RADII FOR SIDE ROADS)
STA. 308+50 TO 314+50, SOLID LT & RT

646.412 DURABLE 4 INCH YELLOW LINE, THERMOPLASTIC
(ALL LINES WILL INCLUDE C BREAKS FOR SIDE ROADS)
STA. 308+50 TO 314+50, SOLID LT & RT

646.612 TEMPORARY 4 INCH YELLOW LINE, PAINT
(ALL LINES WILL INCLUDE C BREAKS FOR SIDE ROADS)
STA. 308+50 TO 314+50, SOLID LT & RT

NOTES:
1. ALL EXISTING SIGNS NOT SHOWN SHALL BE RETAINED.
2. FOR LEGENDS, SEE LAYOUT SHEET #1.
NOT TO SCALE

PROJECT LAYOUT SHEET #25	PROJECT NAME: WESTFORD - FAIRFAX
	PROJECT NUMBER: STP 2804(1)
	FILE NAME: p08c212.dgn
	PLOT DATE: 31-OCT-2012 13:58
PROJECT LEADER: JLL	DRAWN BY: STANTEC
DESIGNED BY: STANTEC	CHECKED BY: JLL
IPARM FILE: p08c212125.i	SHEET 41 OF 79

