


617.10 RELOCATE MAILBOX, SINGLE SUPPORT
STA. 318+30, LT

646.402 DURABLE 4 INCH WHITE LINE, THERMOPLASTIC
(ALL LINES WILL INCLUDE EDGE LINE BREAKS
AND RADII FOR SIDE ROADS)
STA. 314+50 TO 320+50, SOLID LT & RT

646.412 DURABLE 4 INCH YELLOW LINE, THERMOPLASTIC
(ALL LINES WILL INCLUDE C BREAKS FOR SIDE ROADS)
STA. 314+50 TO 316+80, SOLID LT & RT
STA. 316+80 TO 320+50, SOLID LT, DASHED RT

646.602 TEMPORARY 4 INCH WHITE LINE, PAINT
(ALL LINES WILL INCLUDE EDGE LINE BREAKS
AND RADII FOR SIDE ROADS)
STA. 314+50 TO 320+50, SOLID LT & RT

646.612 TEMPORARY 4 INCH YELLOW LINE, PAINT
(ALL LINES WILL INCLUDE C BREAKS FOR SIDE ROADS)
STA. 314+50 TO 316+80, SOLID LT & RT
STA. 316+80 TO 320+50, SOLID LT, DASHED RT

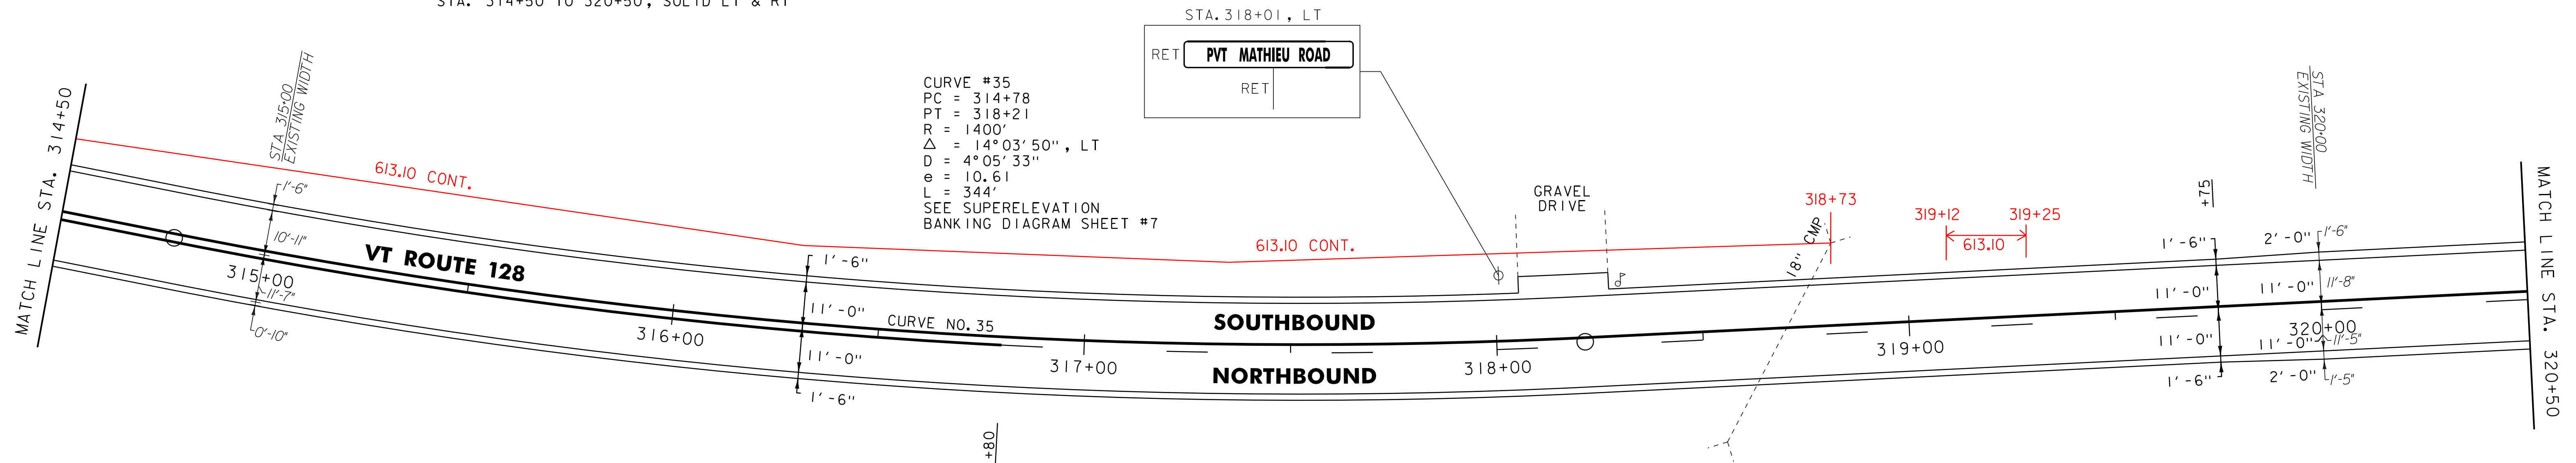


617.10 RELOCATE MAILBOX, SINGLE SUPPORT
STA. 322+24, RT

646.402 DURABLE 4 INCH WHITE LINE, THERMOPLASTIC
(ALL LINES WILL INCLUDE EDGE LINE BREAKS
AND RADII FOR SIDE ROADS)
STA. 320+50 TO 326+50, SOLID LT & RT

646.412 DURABLE 4 INCH YELLOW LINE, THERMOPLASTIC
(ALL LINES WILL INCLUDE C BREAKS FOR SIDE ROADS)
STA. 320+50 TO 324+72, SOLID LT, DASHED RT
STA. 324+72 TO 326+30, DASHED C
STA. 326+30 TO 326+50, DASHED LT, SOLID RT

646.602 TEMPORARY 4 INCH WHITE LINE, PAINT
(ALL LINES WILL INCLUDE EDGE LINE BREAKS
AND RADII FOR SIDE ROADS)
STA. 320+50 TO 326+50, SOLID LT & RT

646.612 TEMPORARY 4 INCH YELLOW LINE, PAINT
(ALL LINES WILL INCLUDE C BREAKS FOR SIDE ROADS)
STA. 320+50 TO 324+72, SOLID LT, DASHED RT
STA. 324+72 TO 326+30, DASHED C
STA. 326+30 TO 326+50, DASHED LT, SOLID RT

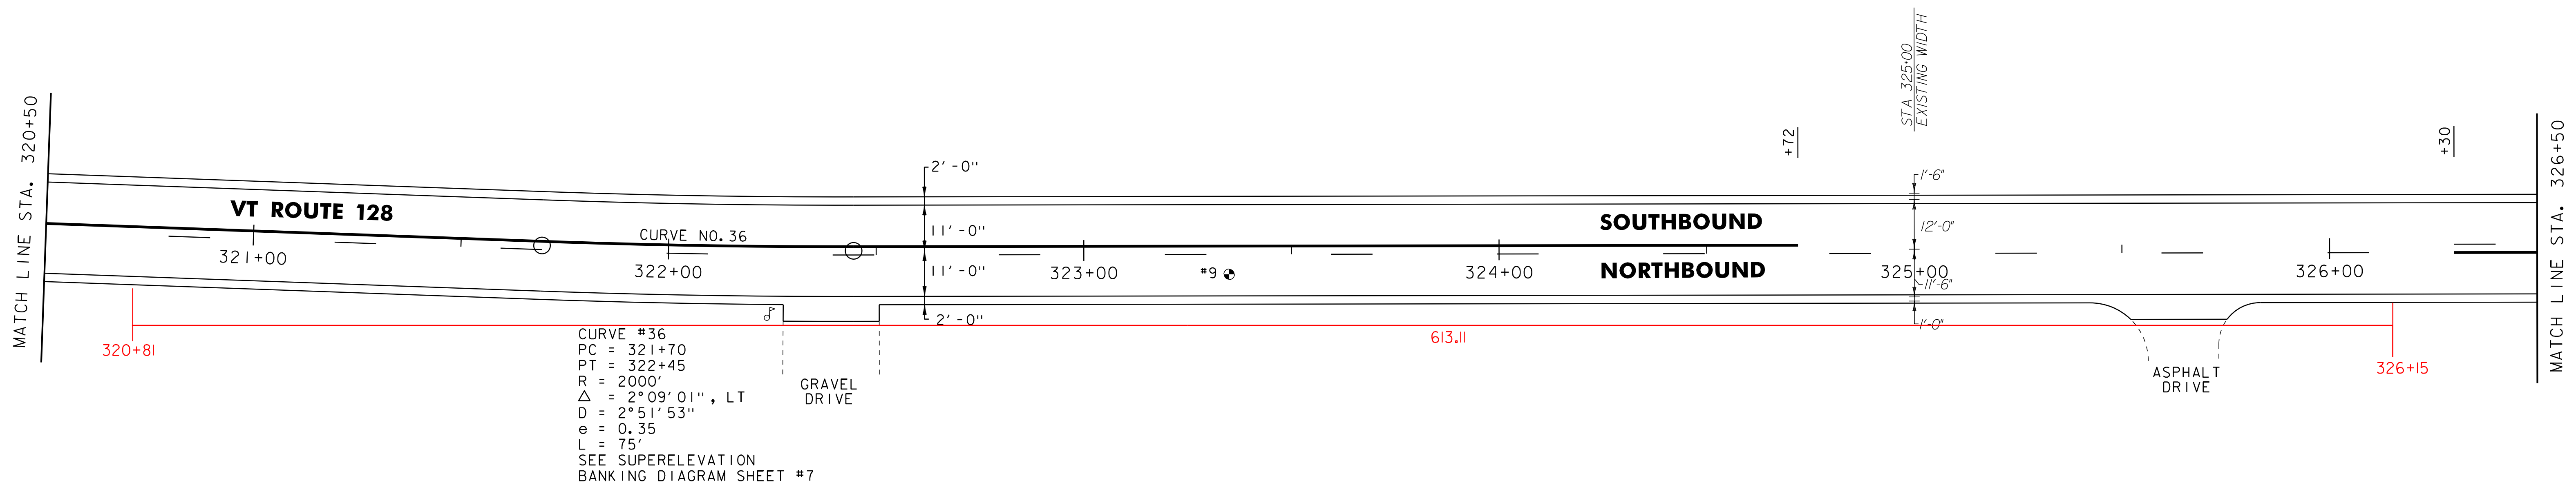

NOTES:
1. ALL EXISTING SIGNS NOT SHOWN SHALL BE RETAINED.
2. FOR LEGENDS, SEE LAYOUT SHEET #1.
NOT TO SCALE

PAVEMENT CORE DATA			
CORE #	DEPTH (IN.)	PCC	COMMENTS
9	4"	NO	



PROJECT LAYOUT SHEET #26

PROJECT NAME: WESTFORD - FAIRFAX
PROJECT NUMBER: STP 2804(1)

FILE NAME: p08c212.dgn
PROJECT LEADER: JLL
DESIGNED BY: STANTEC
IPARM FILE: p08c212126.i

PLOT DATE: 31-OCT-2012 13:58
DRAWN BY: STANTEC
CHECKED BY: JLL
SHEET 42 OF 79