

617.10 RELOCATE MAILBOX, SINGLE SUPPORT  
STA. 329+93, RT


646.412 DURABLE 4 INCH YELLOW LINE, THERMOPLASTIC  
(ALL LINES WILL INCLUDE C BREAKS FOR SIDE ROADS)  
STA. 326+50 TO 332+50, DASHED LT, SOLID RT

646.602 TEMPORARY 4 INCH WHITE LINE, PAINT  
(ALL LINES WILL INCLUDE EDGE LINE BREAKS AND RADII FOR SIDE ROADS)  
STA. 326+50 TO 332+50, SOLID LT & RT

646.612 TEMPORARY 4 INCH YELLOW LINE, PAINT  
(ALL LINES WILL INCLUDE C BREAKS FOR SIDE ROADS)  
STA. 326+50 TO 332+50, DASHED LT, SOLID RT

675.50 REMOVING SIGNS  
AS SHOWN - 1

646.402 DURABLE 4 INCH WHITE LINE, THERMOPLASTIC  
(ALL LINES WILL INCLUDE EDGE LINE BREAKS AND RADII FOR SIDE ROADS)  
STA. 326+50 TO 332+50, SOLID LT & RT

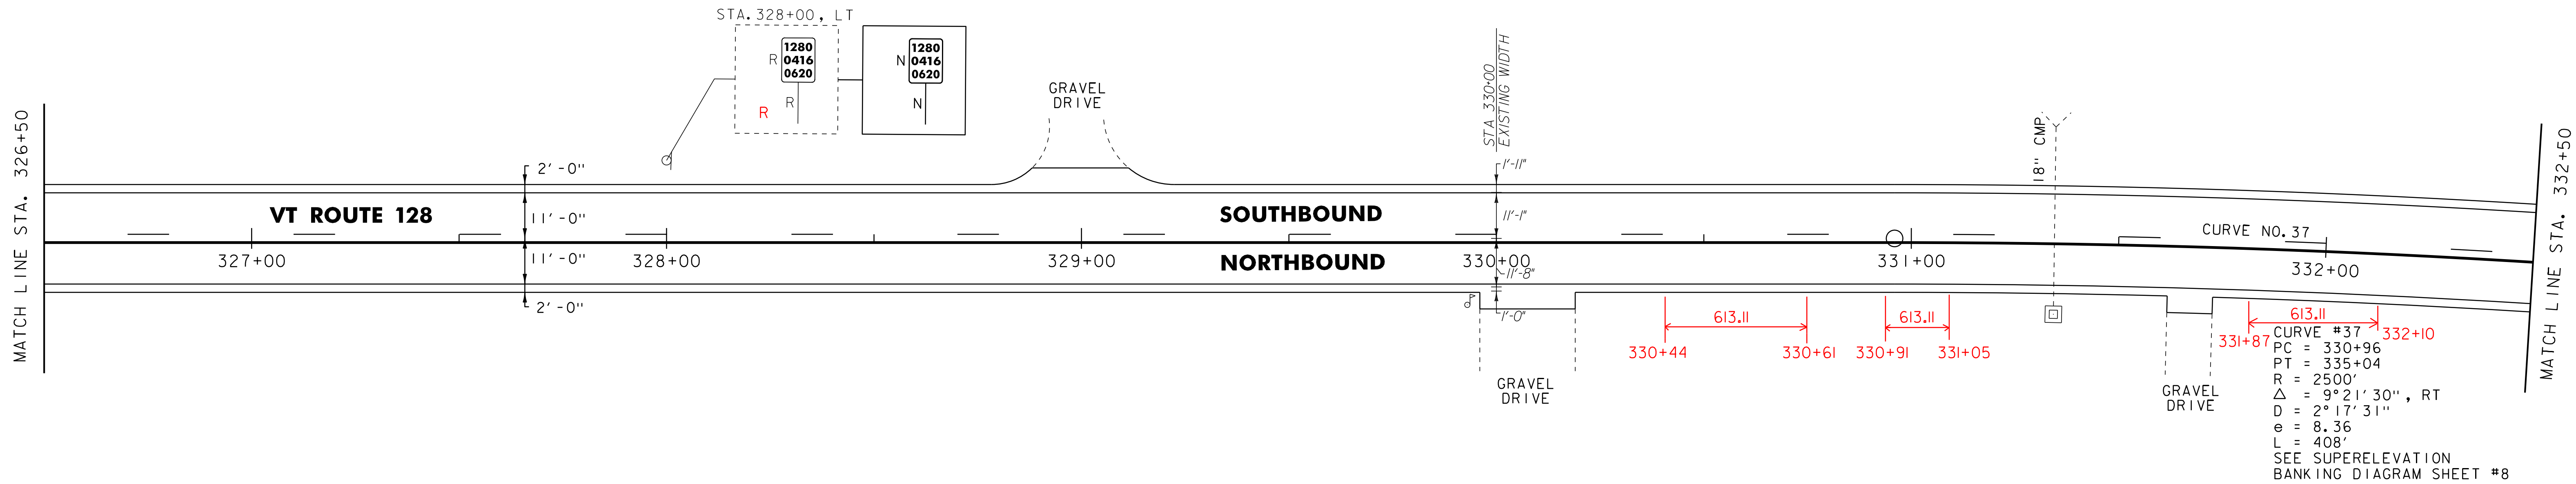


617.10 RELOCATE MAILBOX, SINGLE SUPPORT  
STA. 335+22, LT  
STA. 335+89, RT  
STA. 337+55, LT  
STA. 337+57, LT

646.402 DURABLE 4 INCH WHITE LINE, THERMOPLASTIC  
(ALL LINES WILL INCLUDE EDGE LINE BREAKS AND RADII FOR SIDE ROADS)  
STA. 332+50 TO 338+50, SOLID LT & RT

646.412 DURABLE 4 INCH YELLOW LINE, THERMOPLASTIC  
(ALL LINES WILL INCLUDE C BREAKS FOR SIDE ROADS)  
STA. 332+50 TO 334+22, DASHED LT, SOLID RT  
STA. 334+22 TO 338+50, SOLID LT, DASHED RT

646.602 TEMPORARY 4 INCH WHITE LINE, PAINT  
(ALL LINES WILL INCLUDE EDGE LINE BREAKS AND RADII FOR SIDE ROADS)  
STA. 332+50 TO 338+50, SOLID LT & RT

646.612 TEMPORARY 4 INCH YELLOW LINE, PAINT  
(ALL LINES WILL INCLUDE C BREAKS FOR SIDE ROADS)  
STA. 332+50 TO 334+22, DASHED LT, SOLID RT  
STA. 334+22 TO 338+50, SOLID LT, DASHED RT

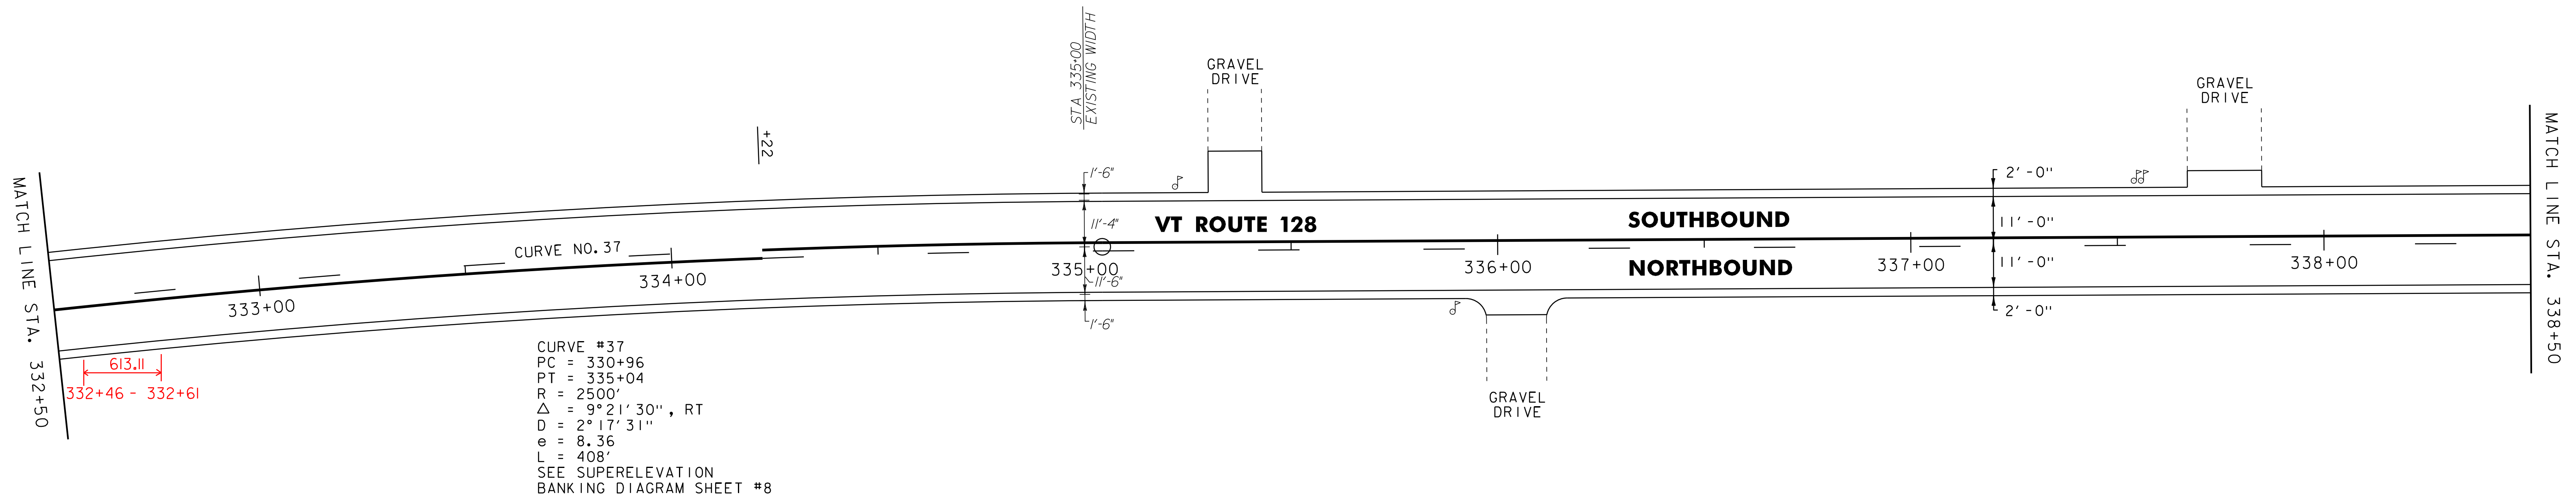

- NOTES:  
1. ALL EXISTING SIGNS NOT SHOWN SHALL BE RETAINED.  
2. FOR LEGENDS, SEE LAYOUT SHEET #1.  
**NOT TO SCALE**

**PROJECT LAYOUT SHEET #27**



PROJECT NAME: WESTFORD - FAIRFAX	FILE NAME: p08c212.dgn	PLOT DATE: 31-OCT-2012 13:58
PROJECT NUMBER: STP 2804(1)	PROJECT LEADER: JLL	DRAWN BY: STANTEC
	DESIGNED BY: STANTEC	CHECKED BY: JLL
	IPARM FILE: p08c212127.i	SHEET 43 OF 79

R=1