

617.10 RELOCATE MAILBOX, SINGLE SUPPORT
 STA. 341+76, RT
 STA. 342+21, LT

646.402 DURABLE 4 INCH WHITE LINE, THERMOPLASTIC
 (ALL LINES WILL INCLUDE EDGE LINE BREAKS
 AND RADII FOR SIDE ROADS)
 STA. 338+50 TO 344+50, SOLID LT & RT


646.412 DURABLE 4 INCH YELLOW LINE, THERMOPLASTIC
 (ALL LINES WILL INCLUDE C BREAKS FOR SIDE ROADS)
 STA. 338+50 TO 341+62, SOLID LT, DASHED RT
 STA. 341+62 TO 344+50, DASHED LT, SOLID RT

646.602 TEMPORARY 4 INCH WHITE LINE, PAINT
 (ALL LINES WILL INCLUDE EDGE LINE BREAKS
 AND RADII FOR SIDE ROADS)
 STA. 338+50 TO 344+50, SOLID LT & RT

646.612 TEMPORARY 4 INCH YELLOW LINE, PAINT
 (ALL LINES WILL INCLUDE C BREAKS FOR SIDE ROADS)
 STA. 338+50 TO 341+62, SOLID LT, DASHED RT
 STA. 341+62 TO 344+50, DASHED LT, SOLID RT

675.50 REMOVING SIGNS
 AS SHOWN - 1

CURVE #38
 PC = 343+98
 PT = 346+02
 R = 3000'
 $\Delta = 3^{\circ}52'53''$, LT
 D = $1^{\circ}54'35''$
 e = 1.72
 L = 203'
 SEE SUPERELEVATION
 BANKING DIAGRAM #9

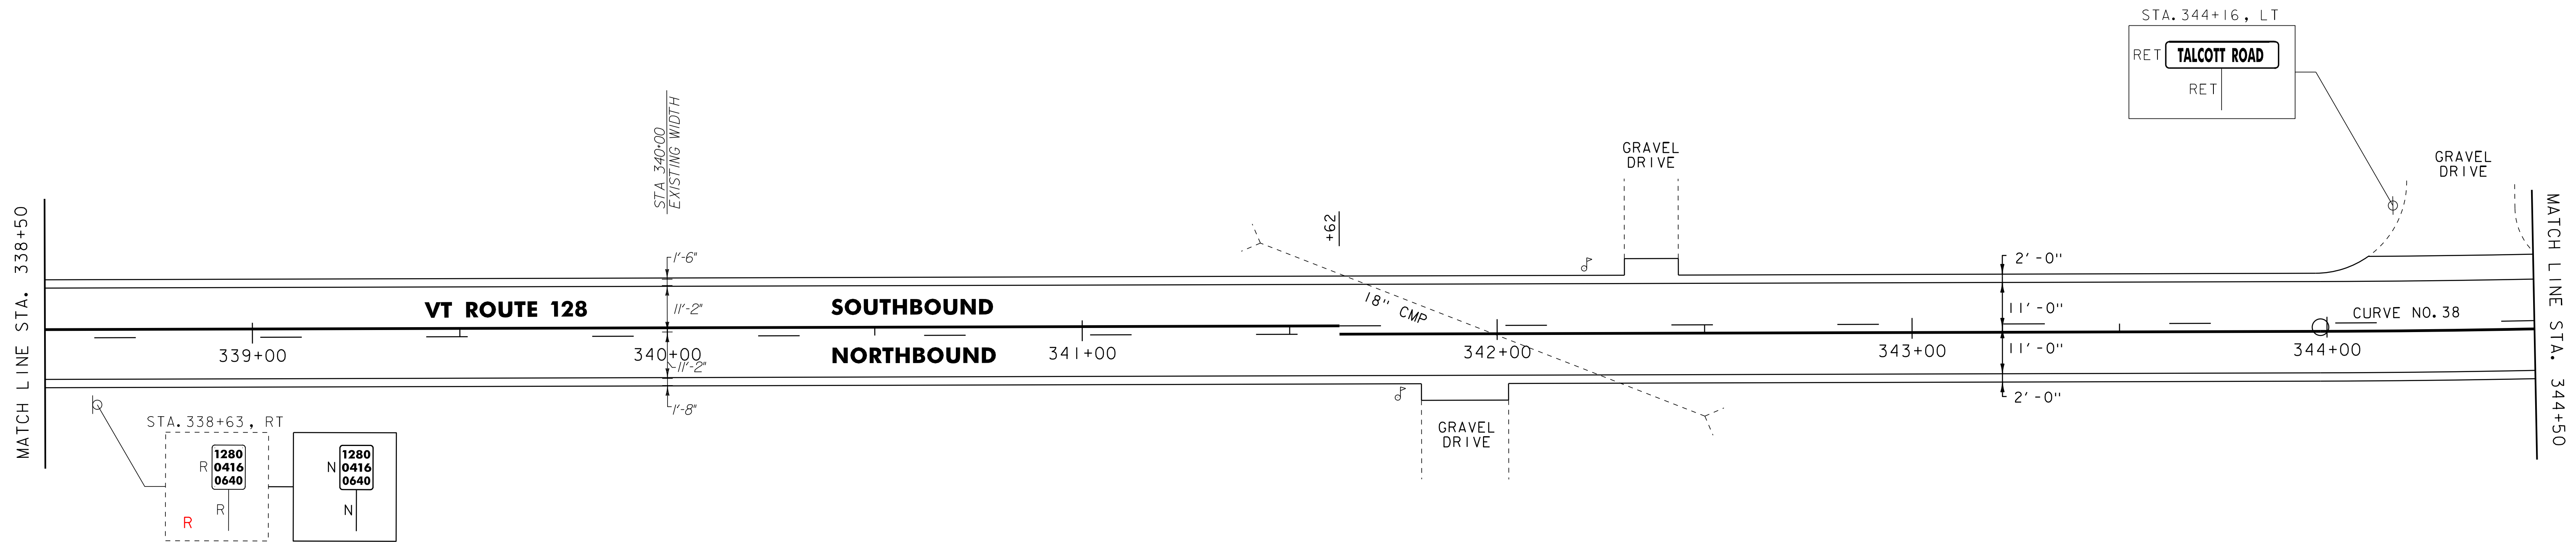

NOTES:
 1. ALL EXISTING SIGNS NOT SHOWN SHALL BE RETAINED.
 2. FOR LEGENDS, SEE LAYOUT SHEET #1.
NOT TO SCALE

PROJECT LAYOUT SHEET #28

PROJECT NAME: WESTFORD - FAIRFAX
 PROJECT NUMBER: STP 2804(1)

FILE NAME: p08c212.dgn
 PROJECT LEADER: JLL
 DESIGNED BY: STANTEC
 IPARM FILE: p08c212128.i

PLOT DATE: 31-OCT-2012 13:58
 DRAWN BY: STANTEC
 CHECKED BY: JLL
 SHEET 44 OF 79



R=1