

646.402 DURABLE 4 INCH WHITE LINE, THERMOPLASTIC
 (ALL LINES WILL INCLUDE EDGE LINE BREAKS
 AND RADII FOR SIDE ROADS)
 STA. 32+00 TO 33+05, SOLID LT & RT

646.412 DURABLE 4 INCH YELLOW LINE, THERMOPLASTIC
 (ALL LINES WILL INCLUDE \odot BREAKS FOR SIDE ROADS)
 STA. 32+00 TO 33+05, SOLID LT & RT

646.602 TEMPORARY 4 INCH WHITE LINE, PAINT
 (ALL LINES WILL INCLUDE EDGE LINE BREAKS
 AND RADII FOR SIDE ROADS)
 STA. 32+00 TO 33+05, SOLID LT & RT

646.612 TEMPORARY 4 INCH YELLOW LINE, PAINT
 (ALL LINES WILL INCLUDE \odot BREAKS FOR SIDE ROADS)
 STA. 32+00 TO 33+05, SOLID LT & RT

646.482 DURABLE 24 INCH STOP BAR, THERMOPLASTIC
 STA. 33+04, RT

646.492 DURABLE LETTER OR SYMBOL, THERMOPLASTIC
 STA. 32+95, RT - "STOP"


646.682 TEMPORARY 24 INCH STOP BAR, PAINT
 STA. 33+04, RT

646.692 TEMPORARY LETTER OR SYMBOL, PAINT
 STA. 32+95, RT - "STOP"

675.50 REMOVING SIGNS
 AS SHOWN - 5

675.60 ERECTING SALVAGED SIGNS
 AS SHOWN - 1

**END STP 2804(1) VT ROUTE 128
 FAIRFAX STA. 33+05.28 = MM 0.626**

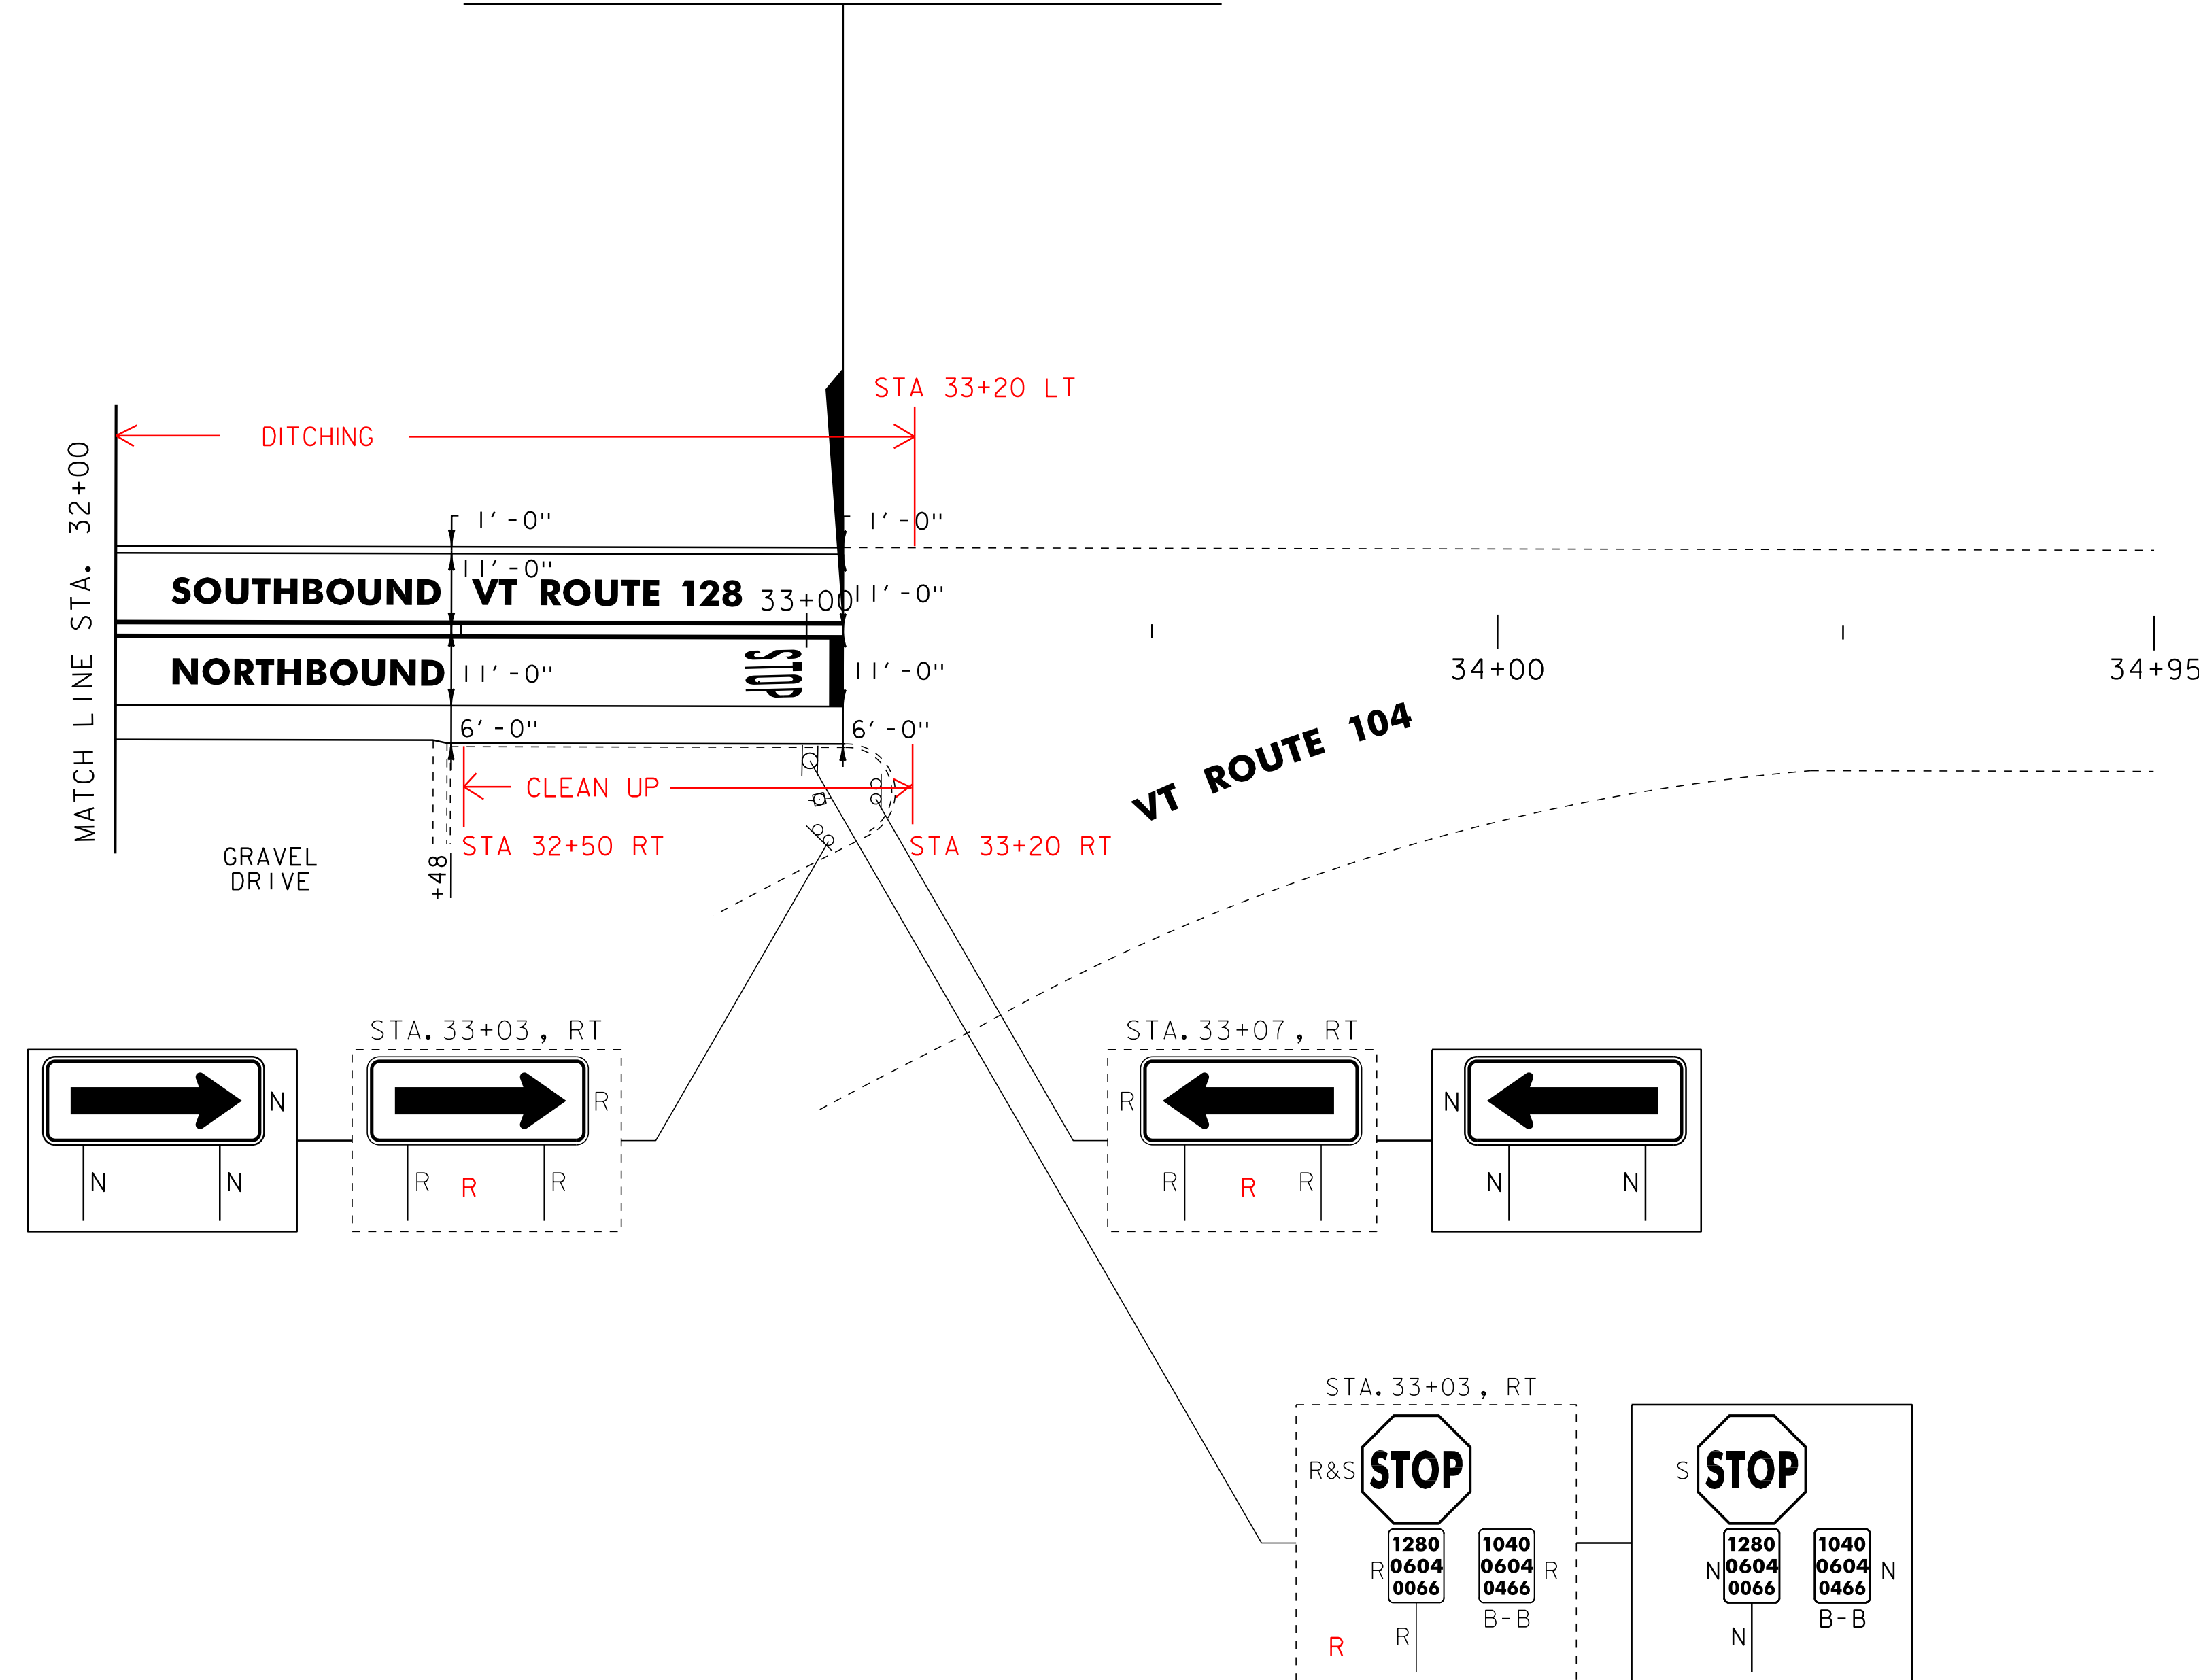

NOTES:

1. ALL EXISTING SIGNS NOT SHOWN SHALL BE RETAINED.
2. FOR LEGENDS, SEE LAYOUT SHEET #1.

NOT TO SCALE

**PROJECT
 LAYOUT
 SHEET #34**

PROJECT NAME: WESTFORD - FAIRFAX
 PROJECT NUMBER: STP 2804(1)

FILE NAME: p08c212.dgn
 PROJECT LEADER: JLL
 DESIGNED BY: STANTEC
 IPARM FILE: p08c212134.i

PLOT DATE: 31-OCT-2012 13:58
 DRAWN BY: STANTEC
 CHECKED BY: JLL
 SHEET 50 OF 79

