

646.402 DURABLE 4 INCH WHITE LINE, THERMOPLASTIC  
 (ALL LINES WILL INCLUDE EDGE LINE BREAKS  
 AND RADII FOR SIDE ROADS)  
 STA. 1+00 TO 5+08, SOLID LT & RT

646.412 DURABLE 4 INCH YELLOW LINE, THERMOPLASTIC  
 (ALL LINES WILL INCLUDE  $\phi$  BREAKS FOR SIDE ROADS)  
 STA. 1+00 TO 5+08, SOLID LT & RT

646.602 TEMPORARY 4 INCH WHITE LINE, PAINT  
 (ALL LINES WILL INCLUDE EDGE LINE BREAKS  
 AND RADII FOR SIDE ROADS)  
 STA. 1+00 TO 5+08, SOLID LT & RT

646.612 TEMPORARY 4 INCH YELLOW LINE, PAINT  
 (ALL LINES WILL INCLUDE  $\phi$  BREAKS FOR SIDE ROADS)  
 STA. 1+00 TO 5+08, SOLID LT & RT


646.482 DURABLE 24 INCH STOP BAR, THERMOPLASTIC  
 STA. 5+07, RT

646.492 DURABLE LETTER OR SYMBOL, THERMOPLASTIC  
 STA. 4+98, RT - "STOP"

646.682 TEMPORARY 24 INCH STOP BAR, PAINT  
 STA. 5+07, RT

646.692 TEMPORARY LETTER OR SYMBOL, PAINT  
 STA. 4+98, RT - "STOP"

675.50 REMOVING SIGNS  
 AS SHOWN - 8

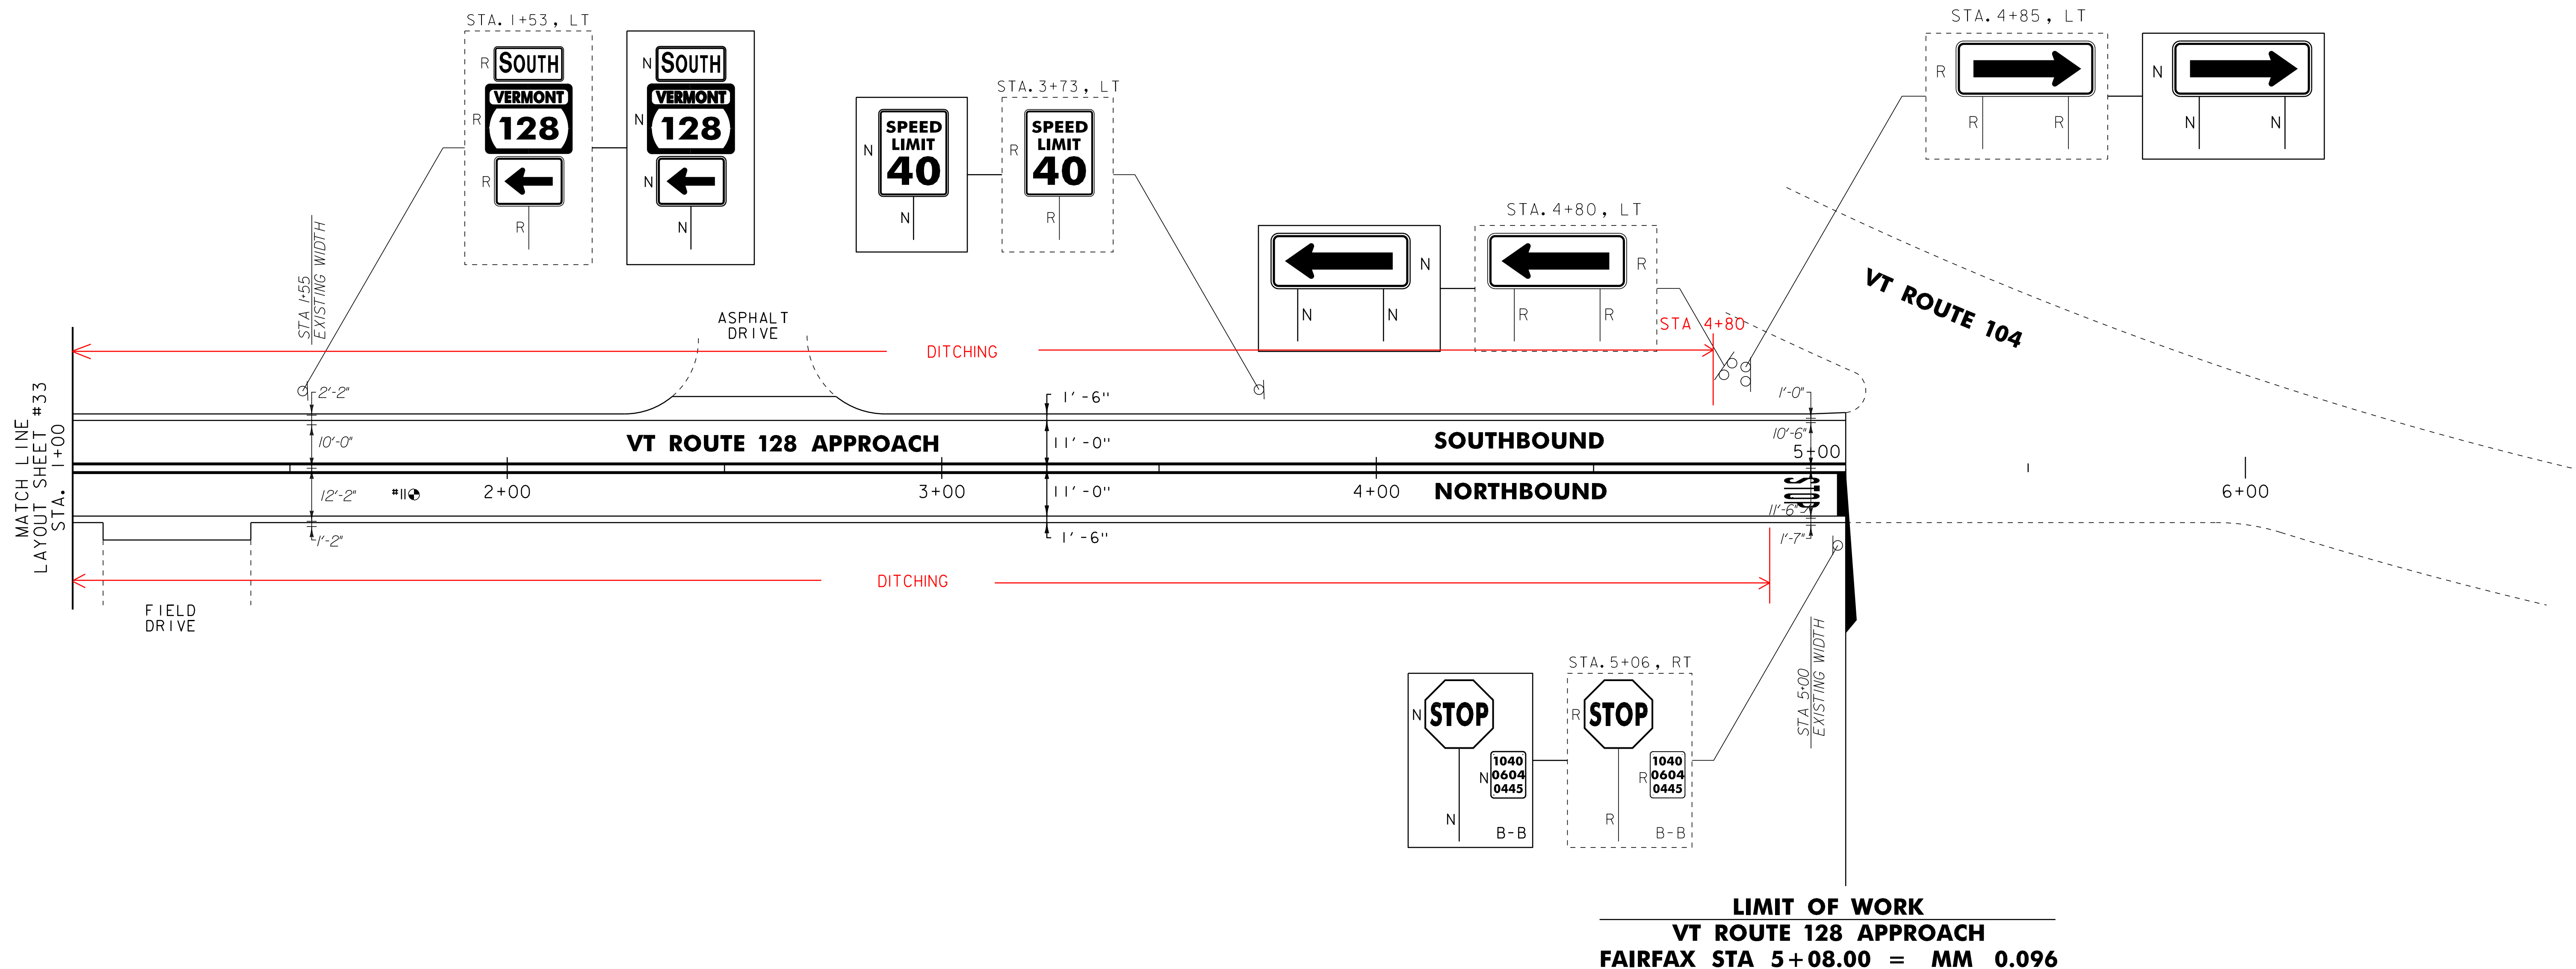

NOTES:  
 1. ALL EXISTING SIGNS NOT SHOWN SHALL BE RETAINED.  
 2. FOR LEGENDS, SEE LAYOUT SHEET #1.  
**NOT TO SCALE**

PAVEMENT CORE DATA			
CORE #	DEPTH (IN.)	PCC	COMMENTS
II	2 3/4"	NO	



**PROJECT LAYOUT SHEET #35**

PROJECT NAME: WESTFORD - FAIRFAX  
 PROJECT NUMBER: STP 2804(I)  
 FILE NAME: p08c212.dgn  
 PROJECT LEADER: JLL  
 DESIGNED BY: STANTEC  
 IPARM FILE: p08c212135.i  
 PLOT DATE: 31-OCT-2012 13:58  
 DRAWN BY: STANTEC  
 CHECKED BY: JLL  
 SHEET 51 OF 79