



STATE OF VERMONT AGENCY OF TRANSPORTATION

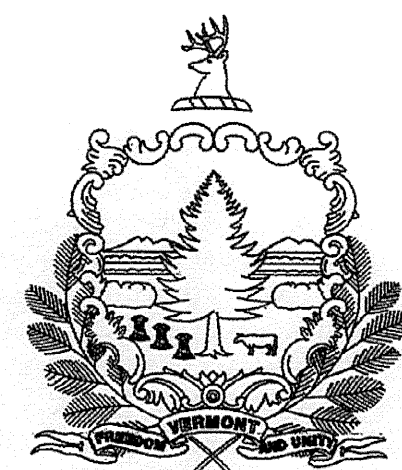

PROPOSED IMPROVEMENT BRIDGE PROJECT



TOWN OF MORETOWN
COUNTY OF WASHINGTON
ROUTE NO : VT 100B RURAL MAJOR COLLECTOR BRIDGE NO : 7
PROJECT LOCATION : 2.1 MILES SOUTH OF JUNCTION US 2

PROJECT DESCRIPTION : BRIDGE DECK REHABILITATION
LENGTH OF STRUCTURE : 364.88 FEET.
LENGTH OF ROADWAY : 100.00 FEET.
LENGTH OF PROJECT : 464.88 FEET.

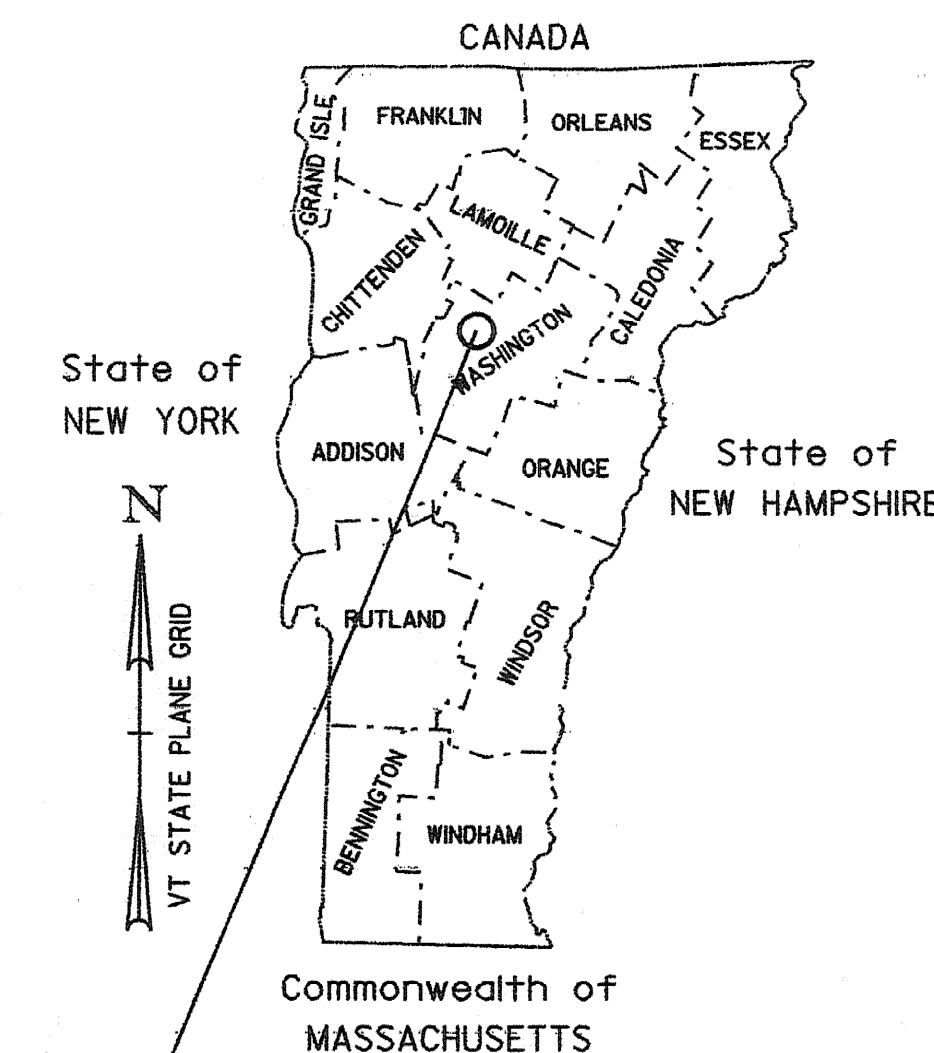

RECORD PLANS	
CONTRACTOR:	CCS CONTRACTORS, LLC - MORRISVILLE, VT
RESIDENT ENGINEER:	IAN JENIKE
CONSTRUCTION BEGAN:	JUNE 8, 2009
CONSTRUCTION COMPLETE:	OCTOBER 16, 2009
RECORD PLANS BY:	IAN JENIKE & N. GARBACIK
I HEREBY CERTIFY THAT ALL THE CONSTRUCTION REQUIRED BY THIS SET OF DRAWINGS HAS BEEN ACCOMPLISHED AS INDICATED HEREIN.	
BY:	<i>[Signature]</i> FOR IAN JENIKE RESIDENT ENGINEER
DATE:	2/17/2010
NOTE: Any further information concerning final quantities, amounts or other details relative to this project may be found at Central Files in the electronic archives.	

**PROJECT LOCATION
MORETOWN BRIDGE 7
STP DECK (37)**

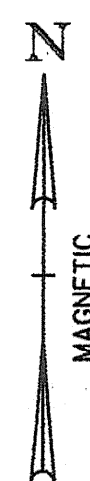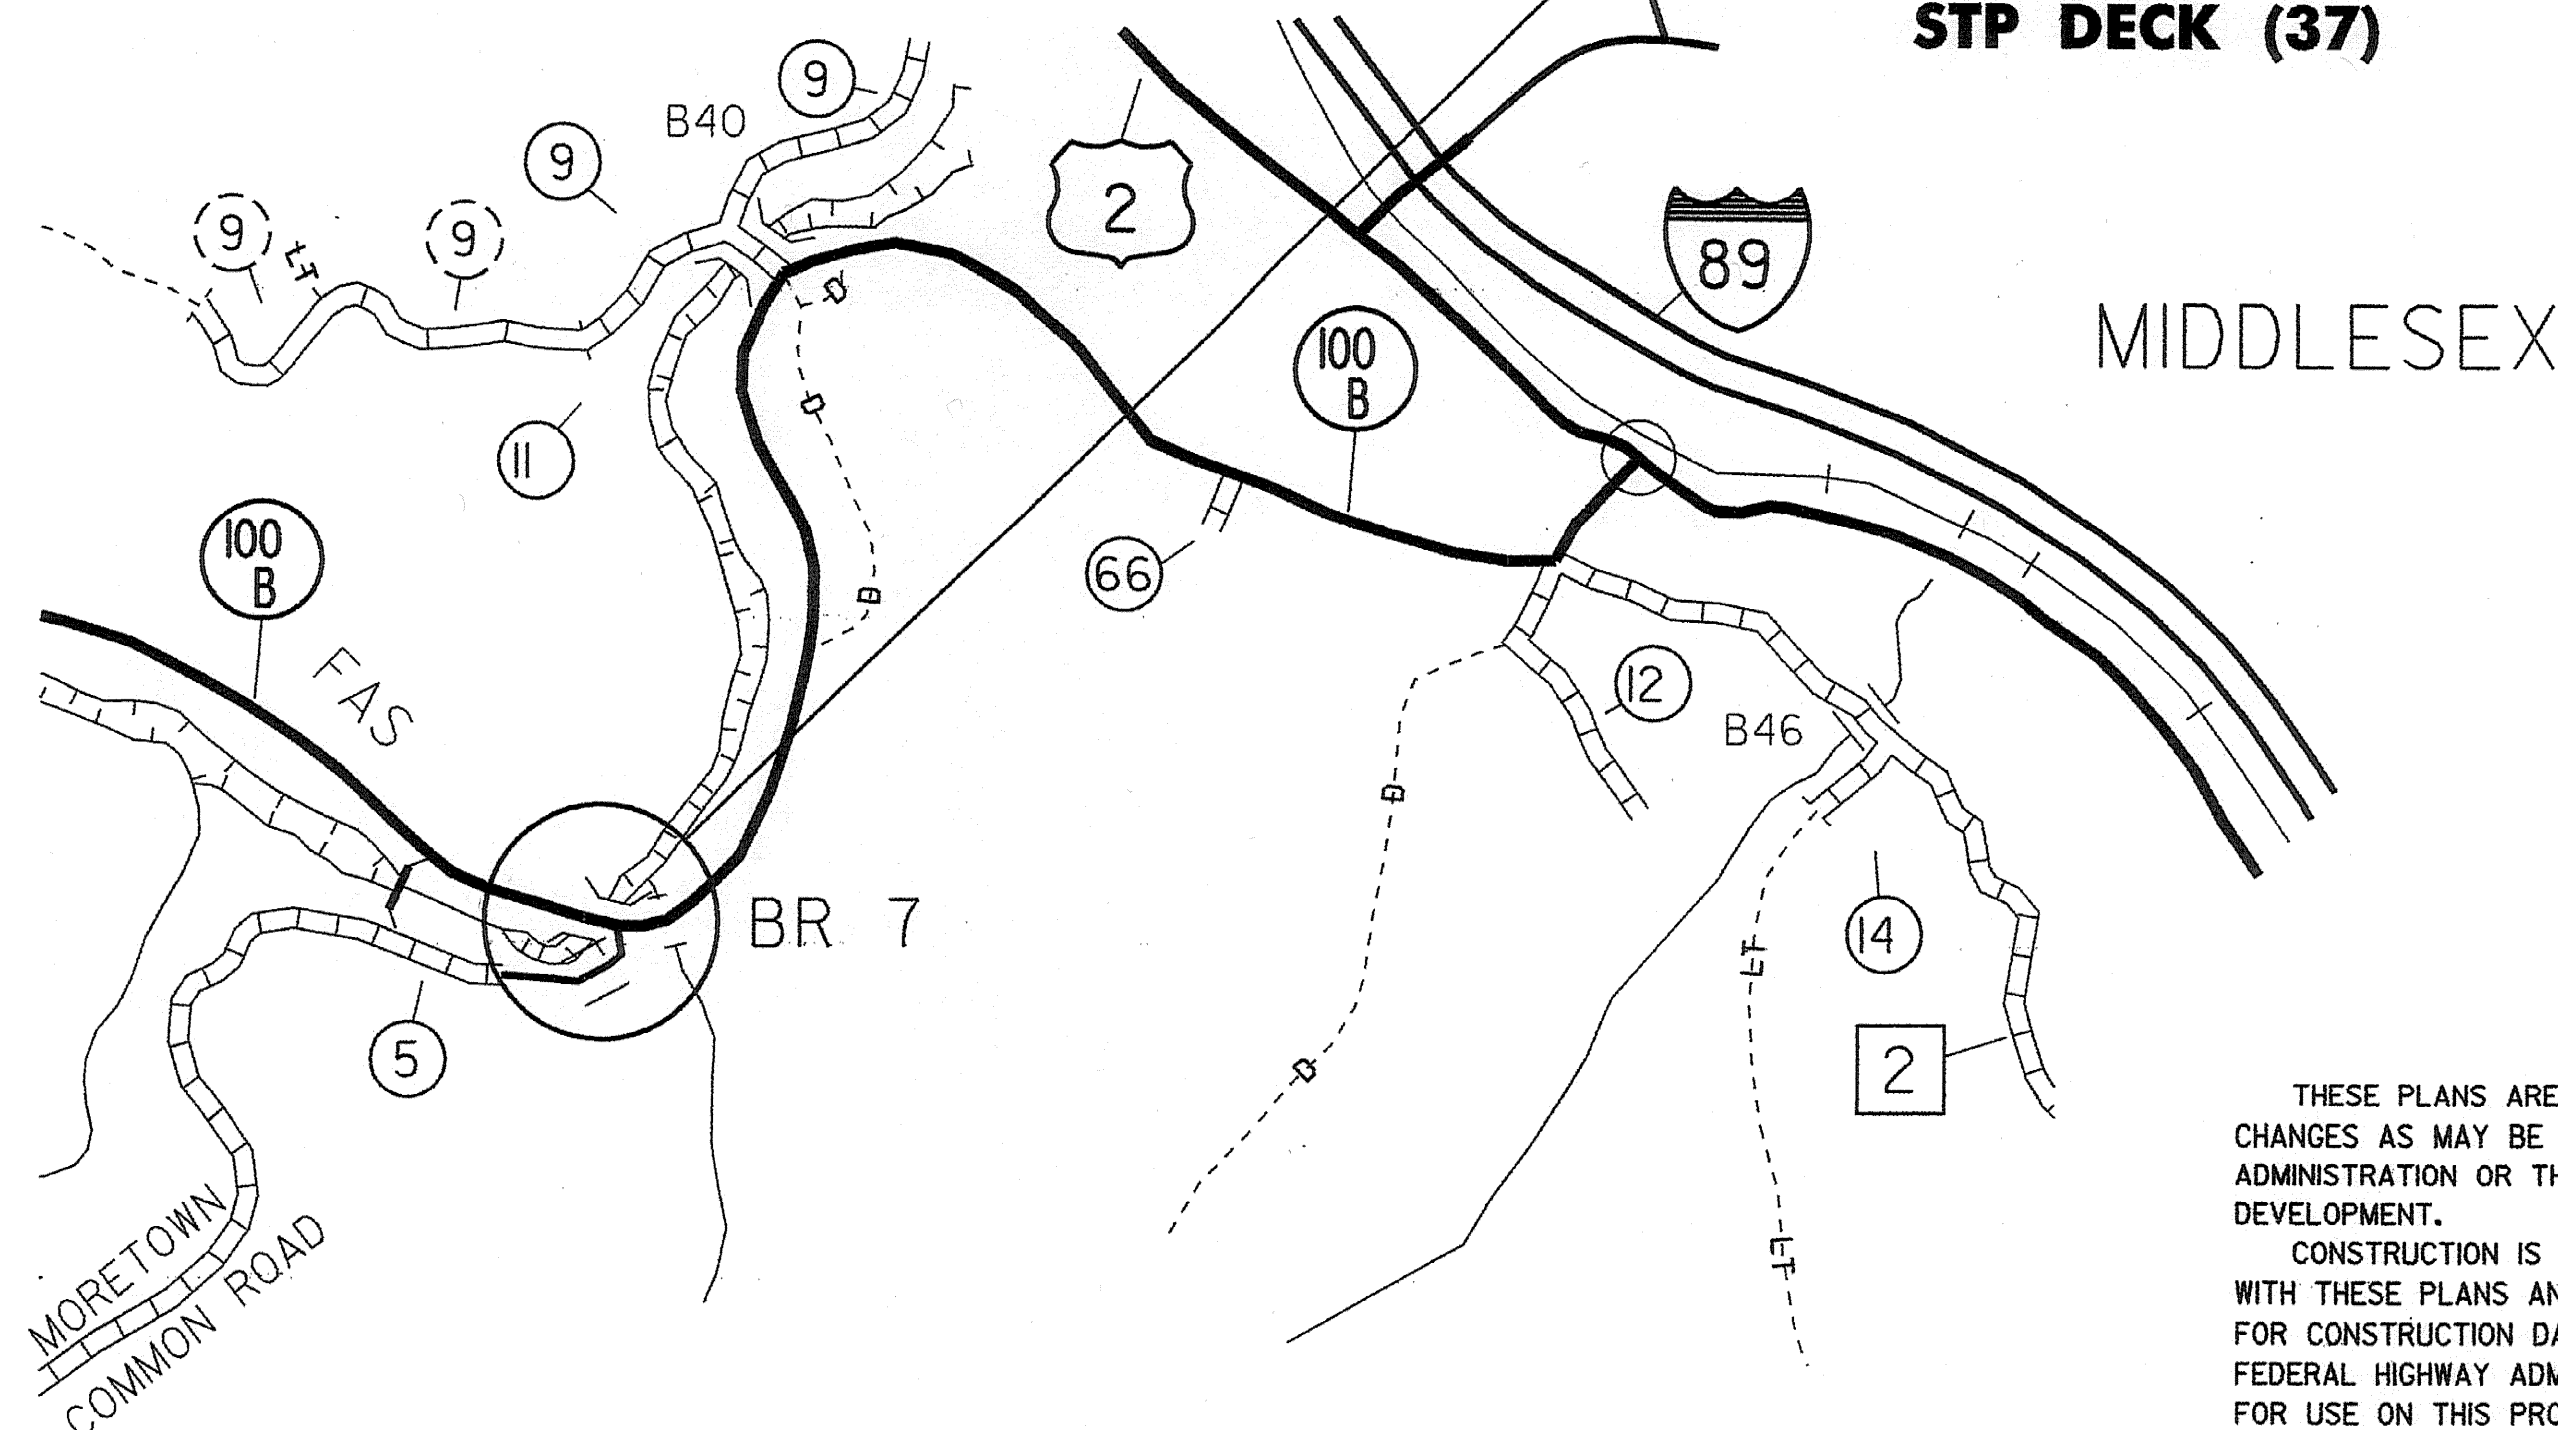

CONVENTIONAL SYMBOLS

COUNTY LINE	
TOWN LINE	
LIMITS OF ACCESS	
POINT OF ACCESS	
FENCE LINE	
STONE WALL	
TRAVELED WAY	
GUARD RAIL	
RAILROAD	
SURVEY LINE	
CULVERT	
POWER POLE	
TELEPHONE POLE	
TREES	
CONTROL OF ACCESS	
PROPERTY LINE	
R.O.W. TAKING LINE	
SLOPE RIGHTS	
TOP OF CUT	
TOE OF SLOPE	

SURVEYED BY :	N/A
SURVEYED DATE :	N/A
DATUM	
VERTICAL	N/A
HORIZONTAL	N/A

THESE PLANS ARE SUBJECT TO SUCH ENGINEERING CHANGES AS MAY BE REQUIRED BY THE FEDERAL HIGHWAY ADMINISTRATION OR THE DIRECTOR OF PROGRAM DEVELOPMENT.
CONSTRUCTION IS TO BE CARRIED ON IN ACCORDANCE WITH THESE PLANS AND THE STANDARD SPECIFICATIONS FOR CONSTRUCTION DATED 2006, AS APPROVED BY THE FEDERAL HIGHWAY ADMINISTRATION ON JUNE 15, 2006 FOR USE ON THIS PROJECT, INCLUDING ALL SUBSEQUENT REVISIONS AND SUCH REVISED SPECIFICATIONS AND SPECIAL PROVISIONS AS ARE INCORPORATED IN THESE PLANS.

DIRECTOR OF PROGRAM DEVELOPMENT	
APPROVED <i>[Signature]</i>	DATE <i>2/17/10</i>
PROJECT MANAGER : C.P. WILLIAMS	
PROJECT NAME : MORETOWN	
PROJECT NUMBER : STP DECK (37)	
PLOTTED 13-APR-2009	
SHEET 1 OF 25 SHEETS	