
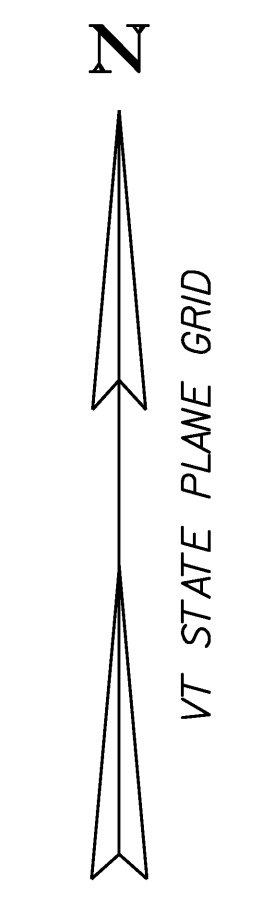


B	R	I	D	G	E		
C	L	O	S	E	D		
O	N		1	0	0	B	

PORTABLE CHANGEABLE SIGN - PHASE 1

M	M	/	D	D	/	Y	Y
T	O						
M	M	/	D	D	/	Y	Y

PORTABLE CHANGEABLE SIGN - PHASE 2

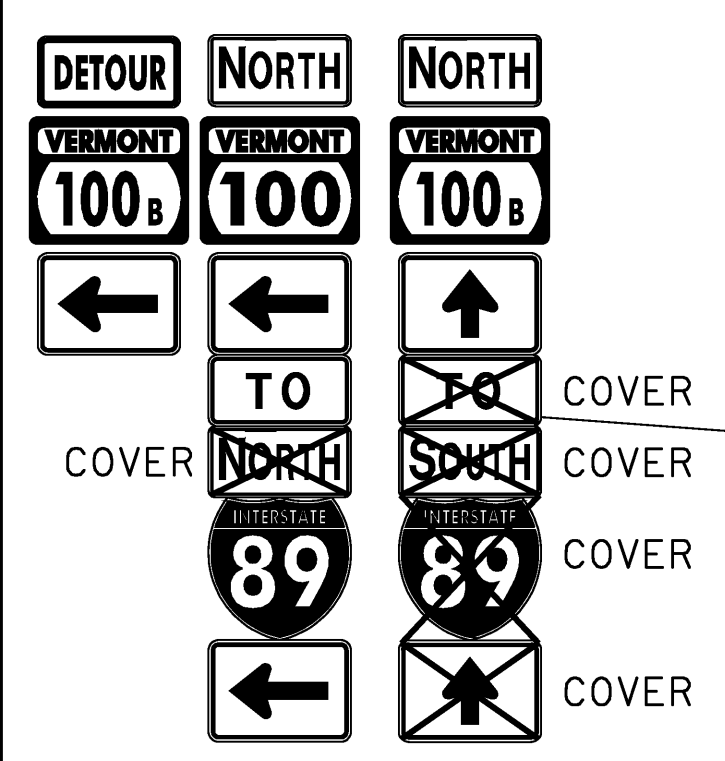

- LEGEND**
- TYPE III BARRICADE
 - ⊠ TYPE III (MOD) BARRICADE
 - I PORTABLE CHANGEABLE MESSAGE SIGN

PROJECT NAME: MORETOWN
 PROJECT NUMBER: STP DECK (37)
 FILE NAME: 08c218detour.dgn
 PROJECT LEADER: C.P.WILLIAMS
 DESIGNED BY: D.D. BEARD
 DETOUR SHEET

PLOT DATE: 15-APR-2009
 DRAWN BY: D.D.BEARD
 CHECKED BY: H.J. SALLS
 SHEET II OF 25