
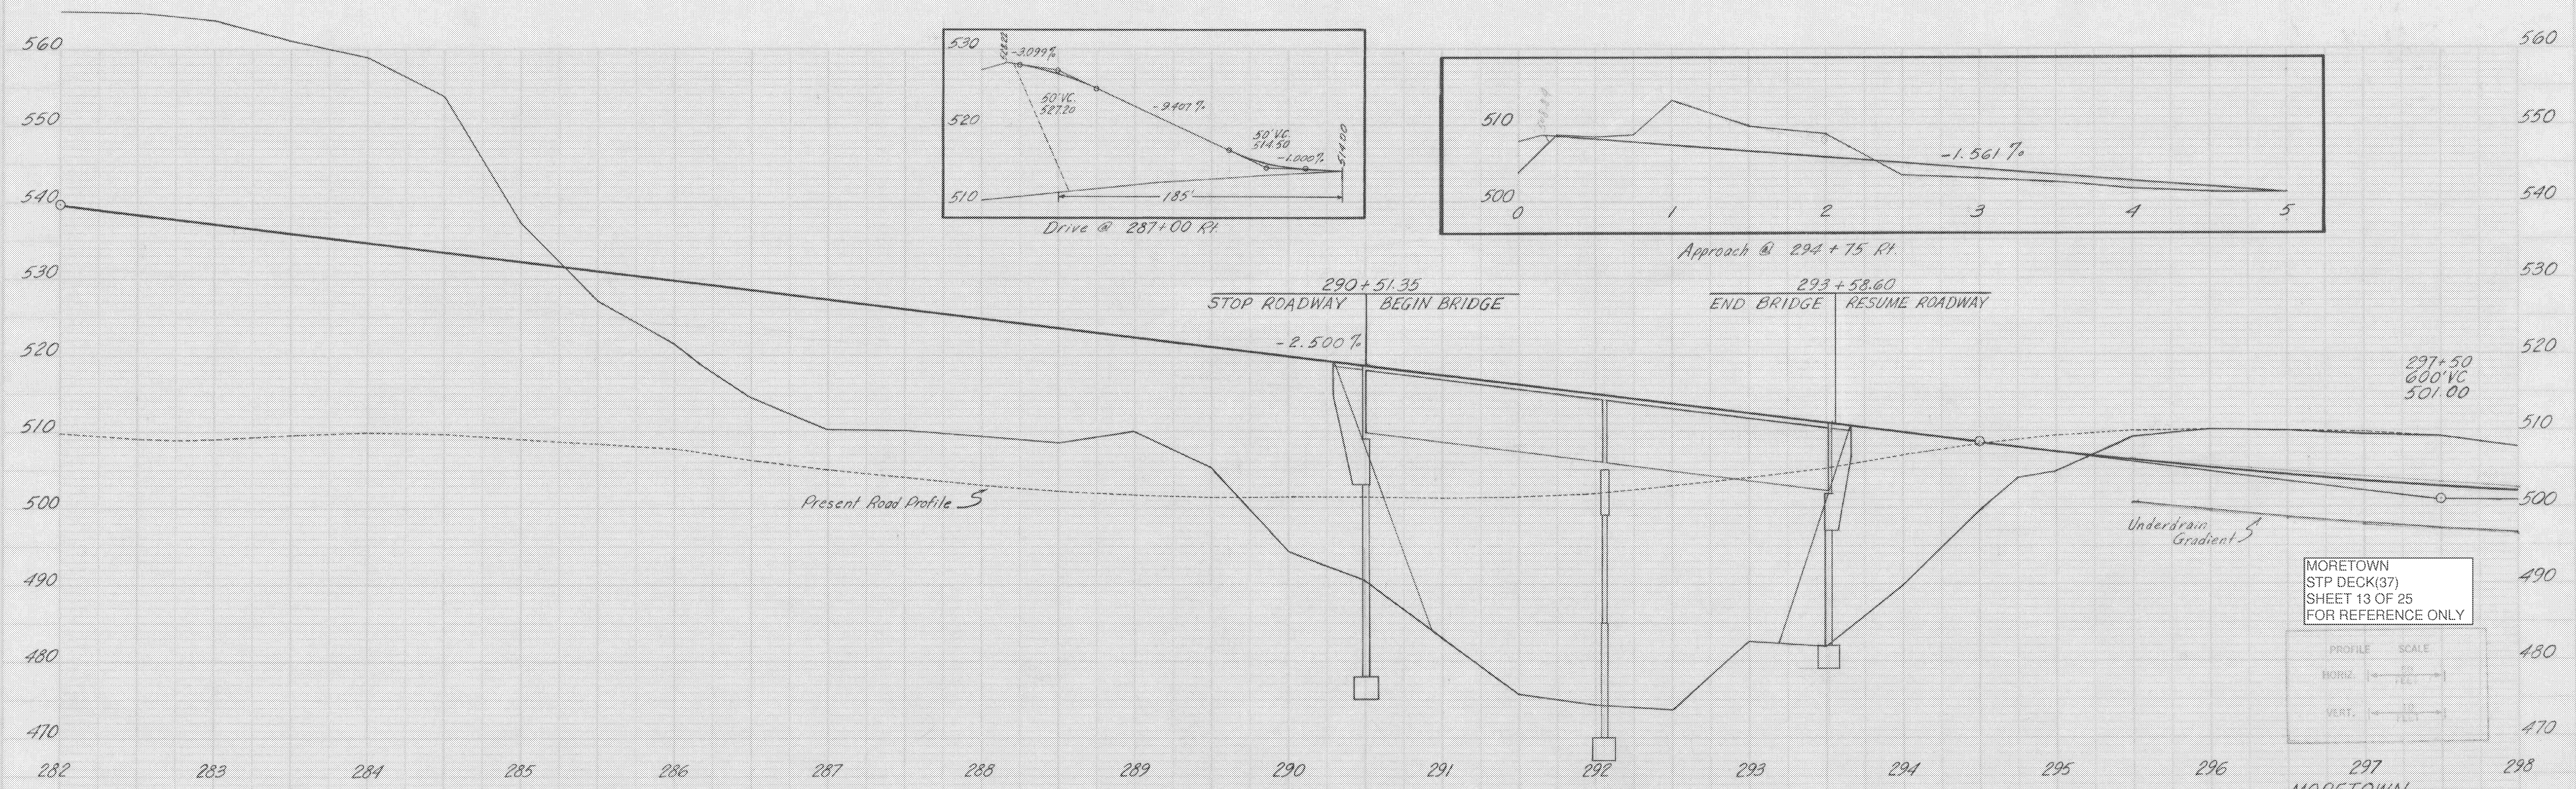
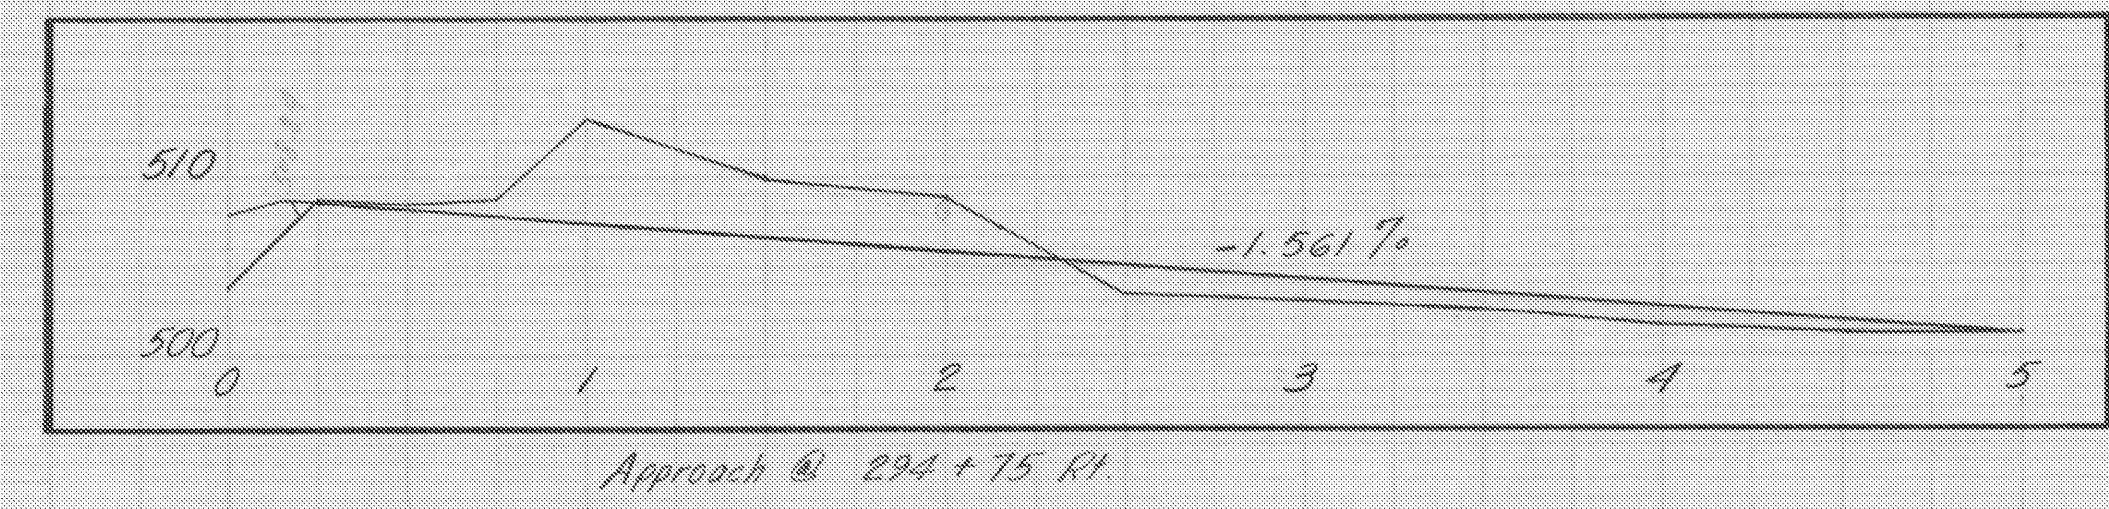
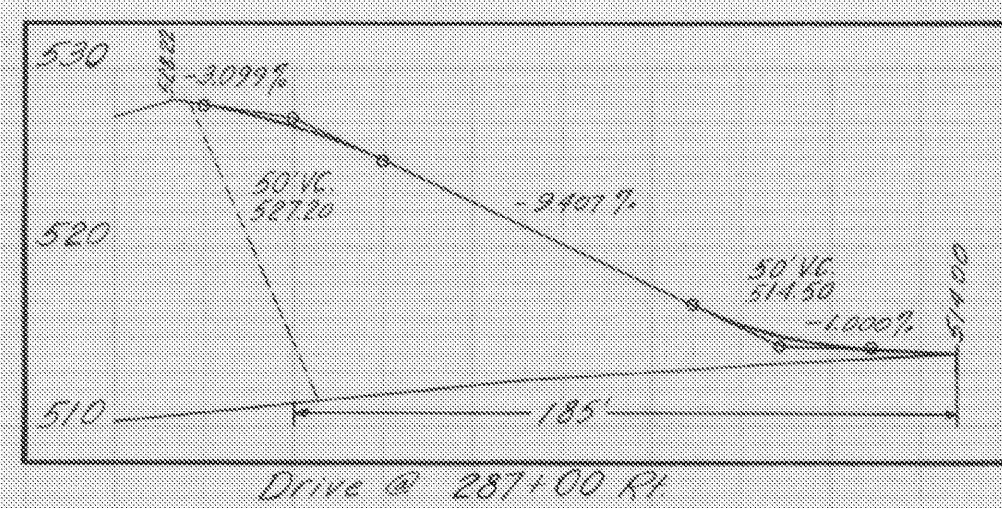


PLAN
 MORETOWN PROJECT
 SHEET 13 OF 25
 AUGUST 1963

Martin
 Cagnon
 Aug 63

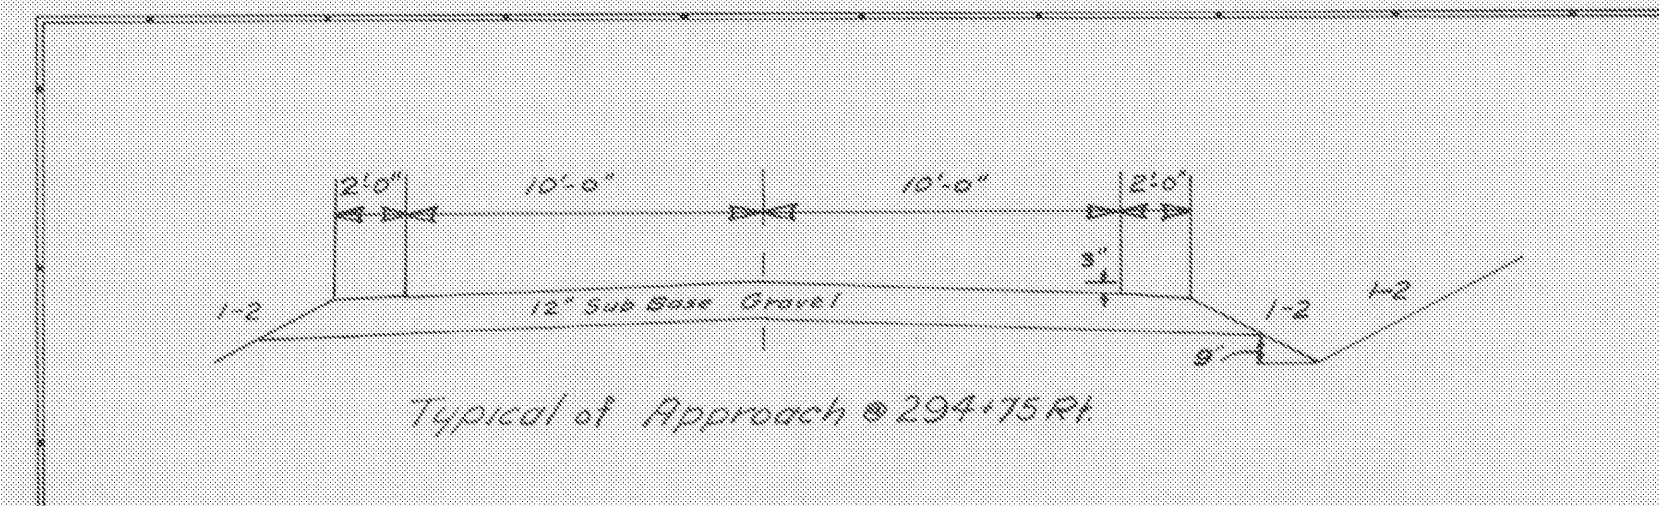

MORETOWN
 STP DECK(37)
 SHEET 13 OF 25
 FOR REFERENCE ONLY

PROFILE	SCALE
HORIZ.	1" = 100'
VERT.	1" = 10'

MORETOWN
 Project S N° 0167(3)
 Sheet 17 of 104

See Sheets BR100 Series for the above Structure