


- Notes**
1. For transverse stiffener spacing see Br. 105.
  2. For Superstructure Notes see Br. 104.
  3. All Girders are to be cambered as shown in the Camber Diagram below.

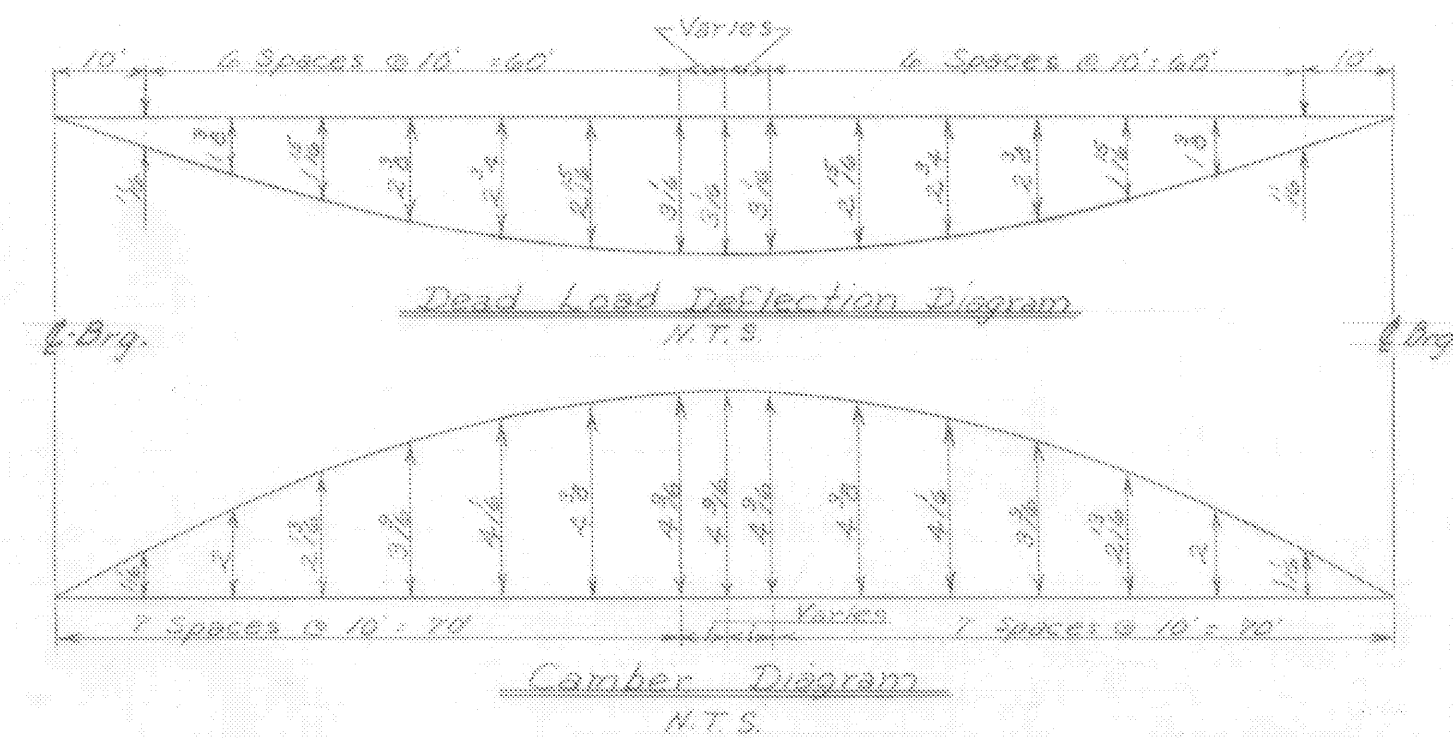

MORETOWN  
STP DECK(37)  
SHEET 17 OF 25  
FOR REFERENCE ONLY  
Br. 106 of 121

**STATE OF VERMONT**  
DEPARTMENT OF HIGHWAYS

TOWN OF Moretown  
ROUTE No. 100-B LOG STA 292+05  
Route 100-B over Mad River  
Girder Details  
SCALE As noted

SURVEYED BY \_\_\_\_\_  
DRAWN BY MD, WBT CHECKED BY RLO  
PROJECT No. S-0167(3)  
SHEET 52 OF 104