

**BEGIN STP 2801(1)S U.S. ROUTE 302
BARRE CITY STA 0+00=MM 0.000
BERLIN/BARRE TOWN LINE**


646.20 4 INCH WHITE LINE
STA. 0+00.0 TO 5+00.0, SOLID LT & RT
(INCLUDING EDGE LINE BREAKS OR RADII FOR TOWN HIGHWAYS)

646.21 4 INCH YELLOW LINE
STA. 0+00.0 TO 5+00.0, SOLID LT & RT
(INCLUDING CENTERLINE BREAKS FOR TOWN HIGHWAYS)

646.602 TEMPORARY 4 INCH WHITE LINE, PAINT
STA. 0+00.0 TO 5+00.0, SOLID LT & RT
(INCLUDING EDGE LINE BREAKS OR RADII FOR TOWN HIGHWAYS)

646.612 TEMPORARY 4 INCH YELLOW LINE, PAINT
STA. 0+00.0 TO 5+00.0, SOLID LT & RT
(INCLUDING CENTERLINE BREAKS FOR TOWN HIGHWAYS)

604.40 CHANGING ELEVATION OF DI, CB, OR MH
STA. 0+04.5, LT
STA. 3+00.7, LT

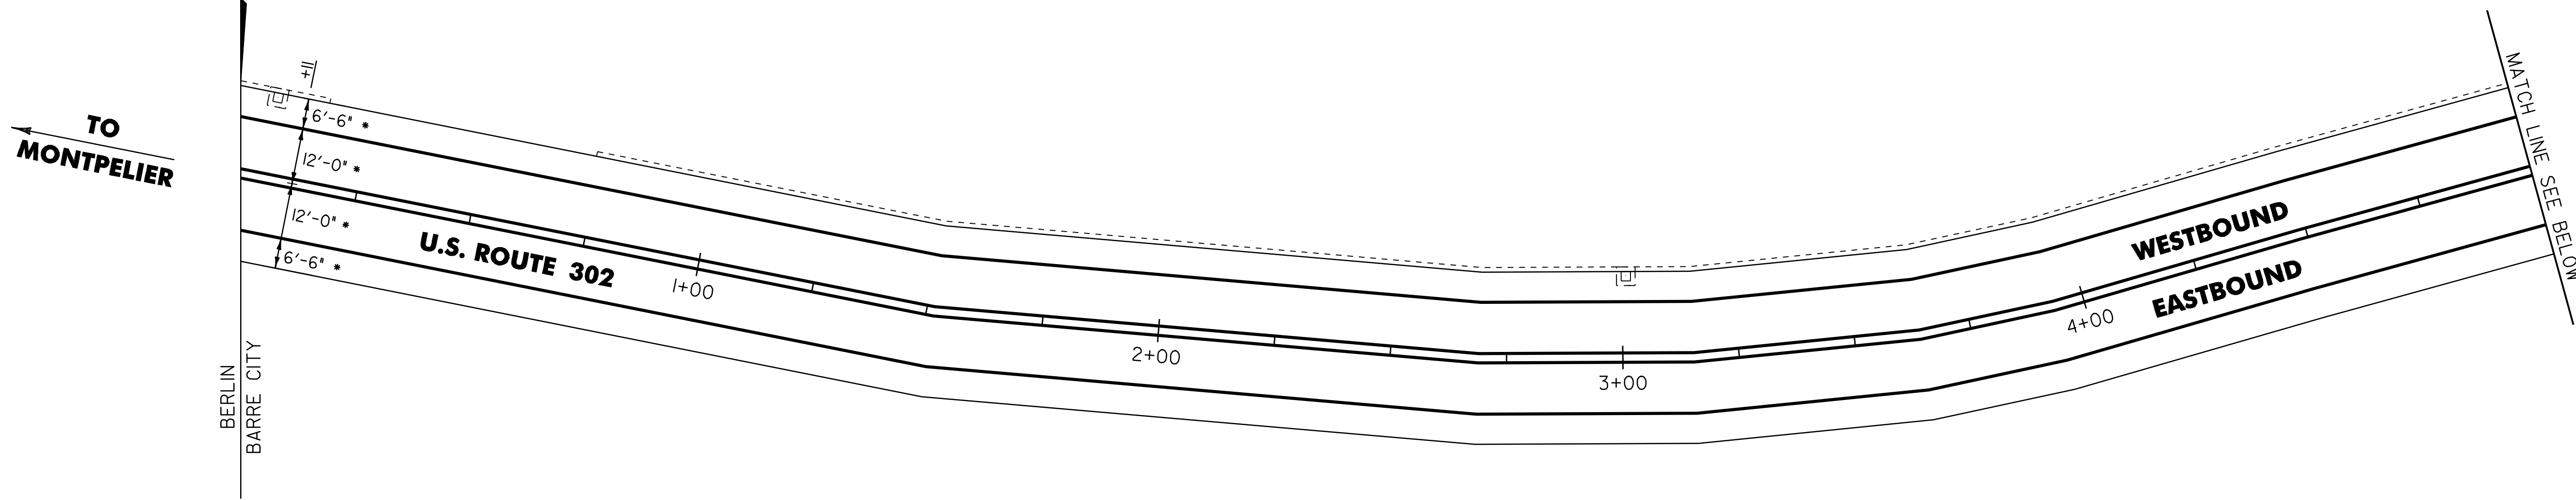

* MATCH EXISTING PAVEMENT MARKINGS


646.20 4 INCH WHITE LINE
STA. 5+00.0 TO 10+00.0, SOLID LT & RT
(INCLUDING EDGE LINE BREAKS OR RADII FOR TOWN HIGHWAYS)

646.21 4 INCH YELLOW LINE
STA. 5+00.0 TO 10+00.0, SOLID LT & RT
(INCLUDING CENTERLINE BREAKS FOR TOWN HIGHWAYS)

646.602 TEMPORARY 4 INCH WHITE LINE, PAINT
STA. 5+00.0 TO 10+00.0, SOLID LT & RT
(INCLUDING EDGE LINE BREAKS OR RADII FOR TOWN HIGHWAYS)

646.612 TEMPORARY 4 INCH YELLOW LINE, PAINT
STA. 5+00.0 TO 10+00.0, SOLID LT & RT
(INCLUDING CENTERLINE BREAKS FOR TOWN HIGHWAYS)

604.40 CHANGING ELEVATION OF DI, CB, OR MH
STA. 6+86.4, LT
~~STA. 8+77.3, LT~~

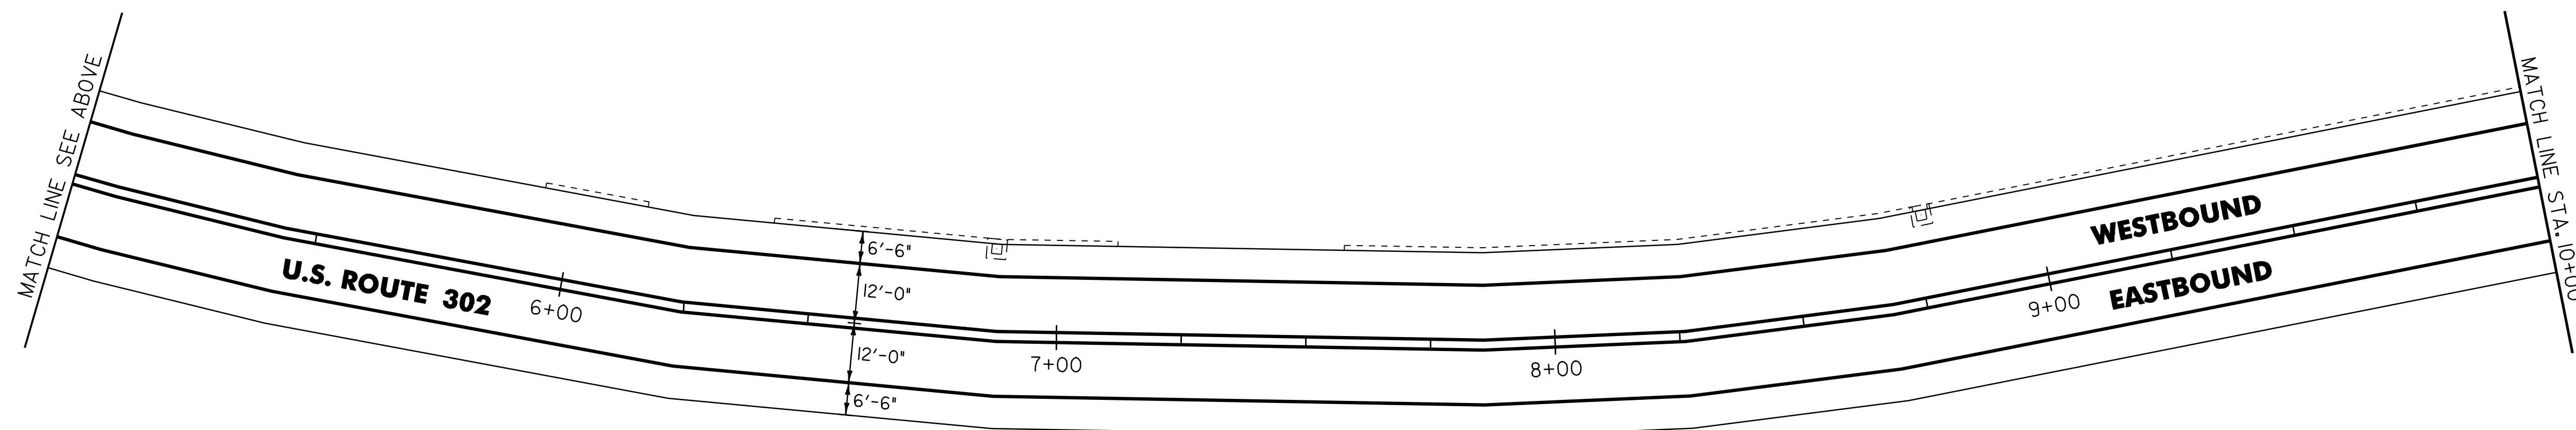

NOT TO SCALE



PROJECT LAYOUT SHEET #1	PROJECT NAME: BARRE CITY	PLOT DATE: 14-APR-2010
	PROJECT NUMBER: STP 2801(1)S	DRAWN BY: STANTEC
	FILE NAME: p08d022.dgn	CHECKED BY: JLL
	DESIGNED BY: STANTEC	SHEET 8 OF 19
	IPARM FILE: p08d022101.i	