


646.20 4 INCH WHITE LINE
 STA. 10+00.0 TO 15+00.0, SOLID LT & RT
 (INCLUDING EDGE LINE BREAKS OR RADII FOR TOWN HIGHWAYS)

646.21 4 INCH YELLOW LINE
 STA. 10+00.0 TO 15+00.0, SOLID LT & RT
 (INCLUDING CENTERLINE BREAKS FOR TOWN HIGHWAYS)

646.602 TEMPORARY 4 INCH WHITE LINE, PAINT
 STA. 10+00.0 TO 15+00.0, SOLID LT & RT
 (INCLUDING EDGE LINE BREAKS OR RADII FOR TOWN HIGHWAYS)

646.612 TEMPORARY 4 INCH YELLOW LINE, PAINT
 STA. 10+00.0 TO 15+00.0, SOLID LT & RT
 (INCLUDING CENTERLINE BREAKS FOR TOWN HIGHWAYS)

604.40 CHANGING ELEVATION OF DI, CB OR MH
 STA. 14+43.6, LT

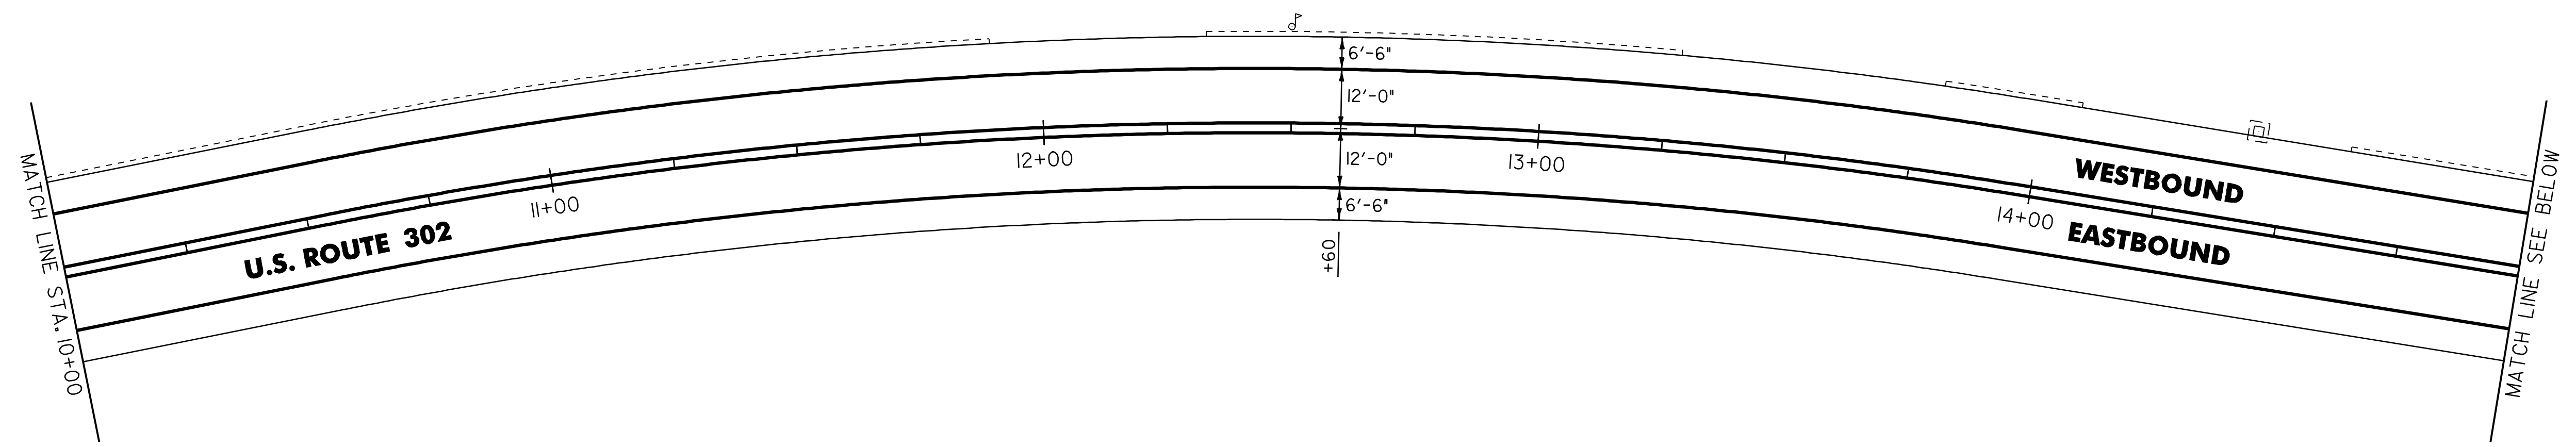

646.20 4 INCH WHITE LINE
 STA. 15+00.0 TO 20+00.0, SOLID LT & RT
 (INCLUDING EDGE LINE BREAKS OR RADII FOR TOWN HIGHWAYS)


646.21 4 INCH YELLOW LINE
 STA. 15+00.0 TO 20+00.0, SOLID LT & RT
 (INCLUDING CENTERLINE BREAKS FOR TOWN HIGHWAYS)

646.602 TEMPORARY 4 INCH WHITE LINE, PAINT
 STA. 15+00.0 TO 20+00.0, SOLID LT & RT
 (INCLUDING EDGE LINE BREAKS OR RADII FOR TOWN HIGHWAYS)

646.612 TEMPORARY 4 INCH YELLOW LINE, PAINT
 STA. 15+00.0 TO 20+00.0, SOLID LT & RT
 (INCLUDING CENTERLINE BREAKS FOR TOWN HIGHWAYS)

604.40 CHANGING ELEVATION OF DI, CB OR MH
 -STA. 15+90.3, LT
 STA. 17+39.6, LT
 -STA. 19+36.0, LT

604.47 C.I. GRATE W/ FRAME, TYPE D
 17+39.6 LT

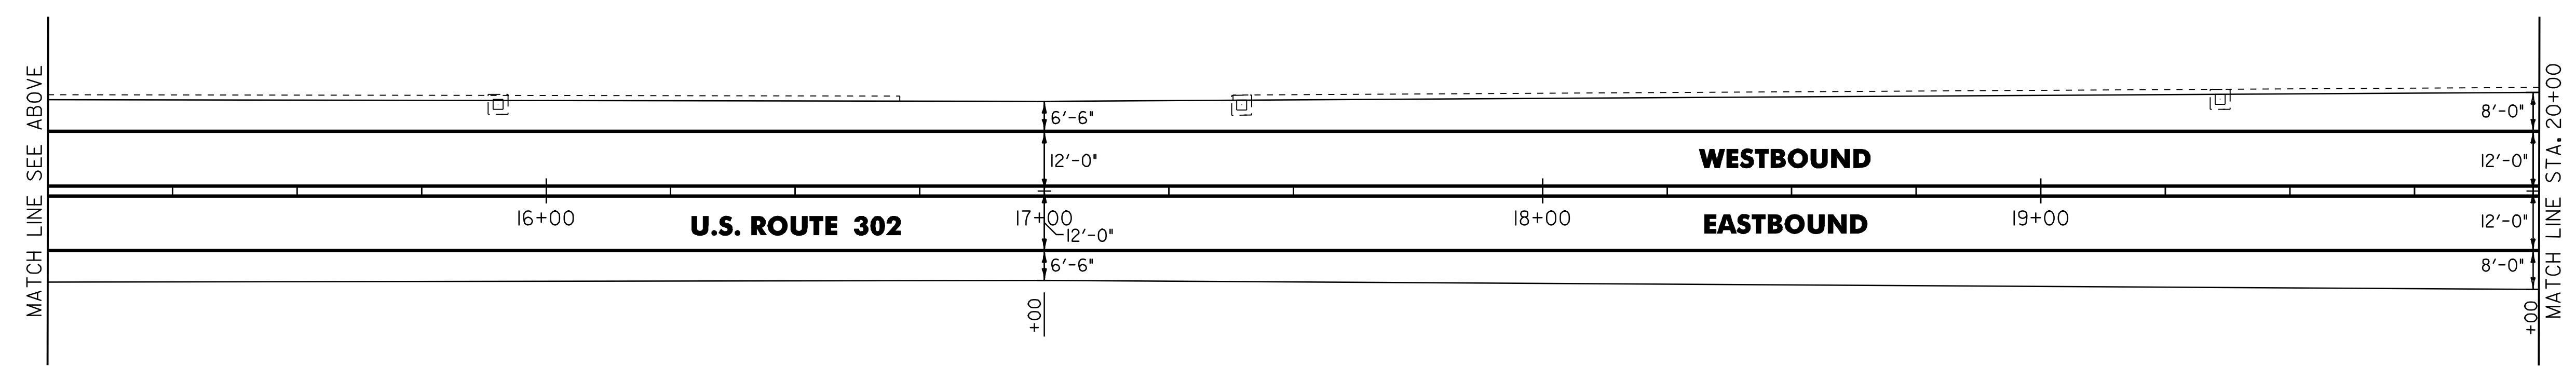

NOT TO SCALE



PROJECT LAYOUT SHEET #2

PROJECT NAME: BARRE CITY	PLOT DATE: 14-APR-2010
PROJECT NUMBER: STP 280(I)S	DRAWN BY: STANTEC
FILE NAME: p08d022.dgn	CHECKED BY: JLL
PROJECT LEADER: JLL	SHEET 9 OF 19
DESIGNED BY: STANTEC	
IPARM FILE: p08d022i02.i	