


646.20 4 INCH WHITE LINE
 STA. 20+00.0 TO 25+00.0, SOLID LT & RT
 (INCLUDING EDGE LINE BREAKS OR RADII FOR TOWN HIGHWAYS)

646.21 4 INCH YELLOW LINE
 STA. 20+00.0 TO 25+00.0, SOLID LT & RT
 (INCLUDING CENTERLINE BREAKS FOR TOWN HIGHWAYS)

646.602 TEMPORARY 4 INCH WHITE LINE, PAINT
 STA. 20+00.0 TO 25+00.0, SOLID LT & RT
 (INCLUDING EDGE LINE BREAKS OR RADII FOR TOWN HIGHWAYS)

646.612 TEMPORARY 4 INCH YELLOW LINE, PAINT
 STA. 20+00.0 TO 25+00.0, SOLID LT & RT
 (INCLUDING CENTERLINE BREAKS FOR TOWN HIGHWAYS)

604.40 CHANGING ELEVATION OF DI, CB OR MH
~~STA. 21+87.0, LT~~
~~STA. 24+08.9, LT~~

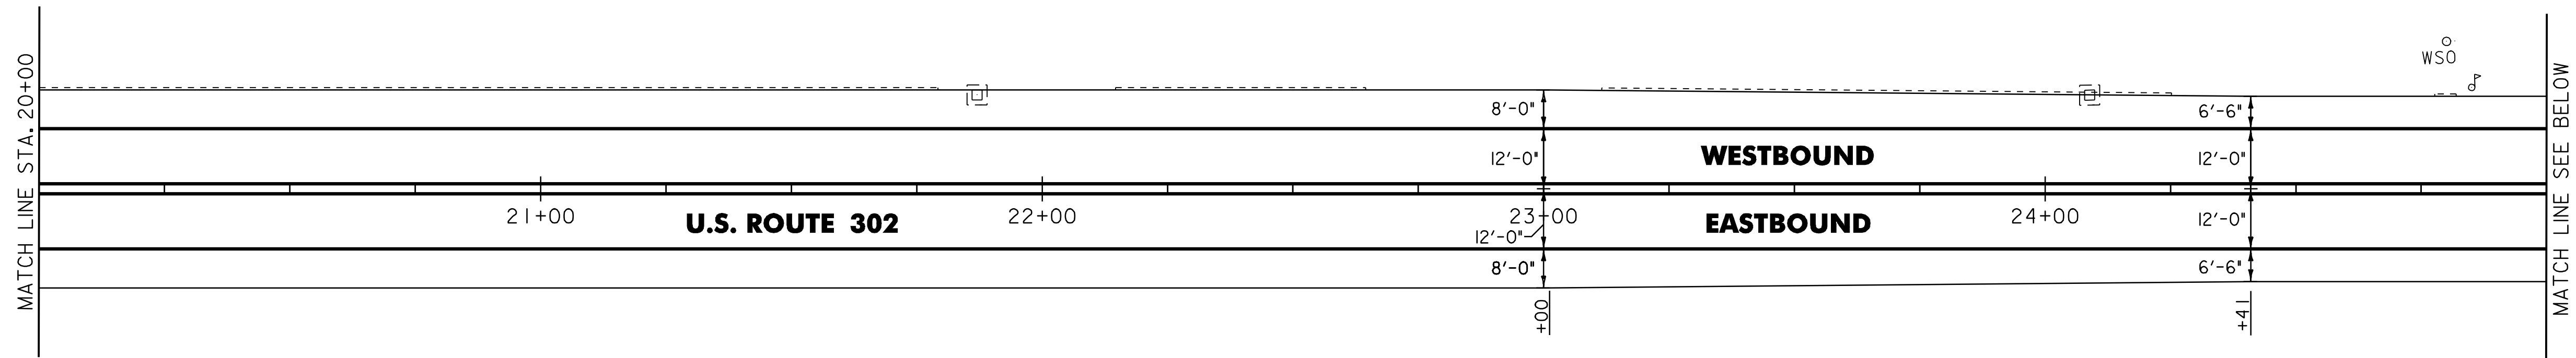

646.20 4 INCH WHITE LINE
 STA. 25+00.0 TO 30+00.0, SOLID LT & RT
 (INCLUDING EDGE LINE BREAKS OR RADII FOR TOWN HIGHWAYS)


646.21 4 INCH YELLOW LINE
 STA. 25+00.0 TO 30+00.0, SOLID LT & RT
 (INCLUDING CENTERLINE BREAKS FOR TOWN HIGHWAYS)

646.602 TEMPORARY 4 INCH WHITE LINE, PAINT
 STA. 25+00.0 TO 30+00.0, SOLID LT & RT
 (INCLUDING EDGE LINE BREAKS OR RADII FOR TOWN HIGHWAYS)

646.612 TEMPORARY 4 INCH YELLOW LINE, PAINT
 STA. 25+00.0 TO 30+00.0, SOLID LT & RT
 (INCLUDING CENTERLINE BREAKS FOR TOWN HIGHWAYS)

604.40 CHANGING ELEVATION OF DI, CB OR MH
 STA. 25+58.3, LT
~~STA. 26+57.2, LT~~
~~STA. 27+09.2, LT~~
~~STA. 28+08.5, LT~~
~~STA. 29+30.8, LT~~

604.47 C.I. GRATE W/ FRAME, TYPE D
 25+58.3 LT

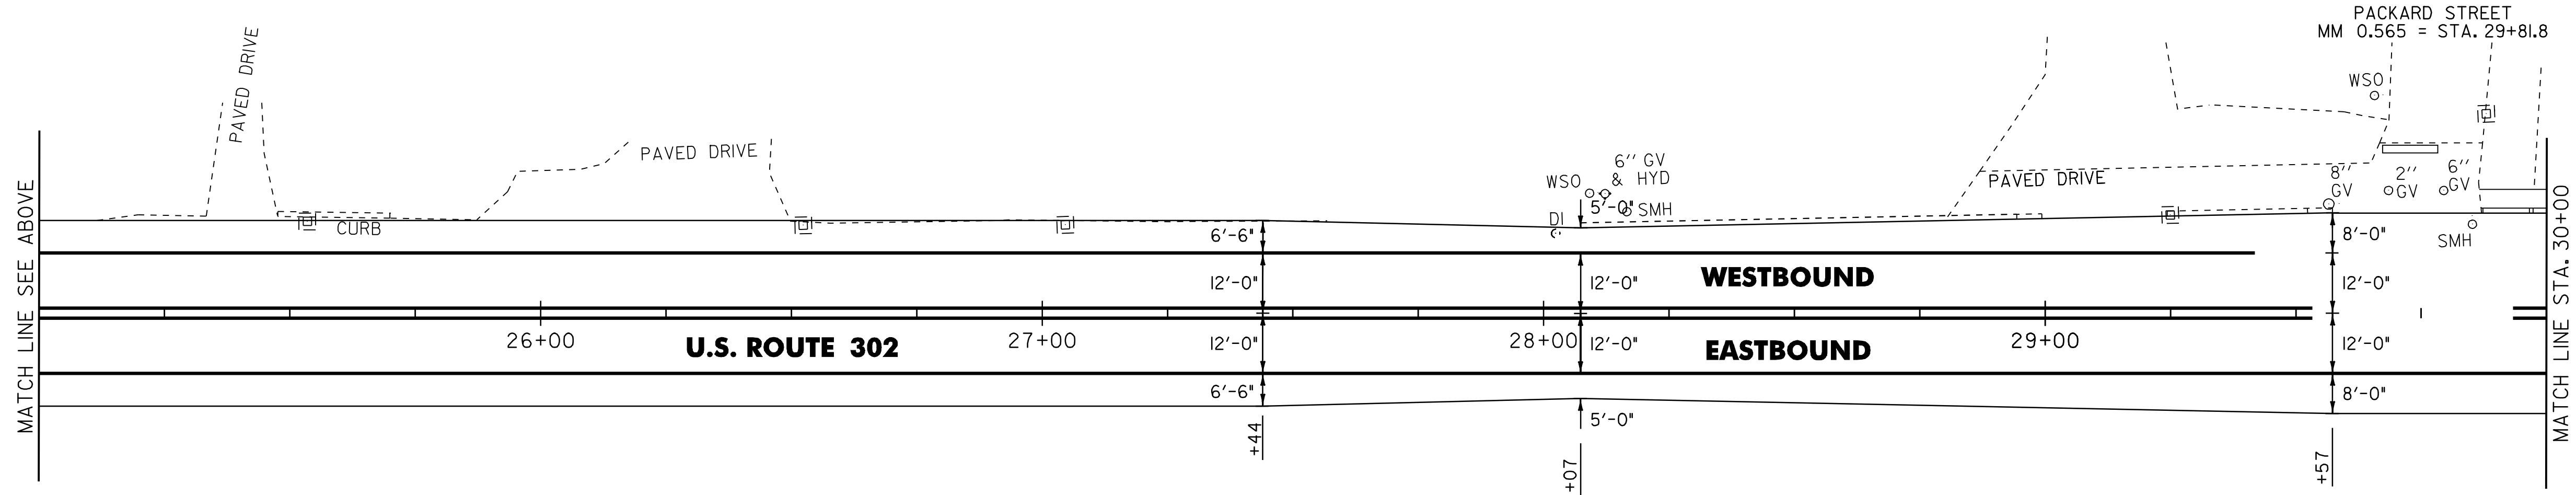

604.42 CHANGING ELEVATION OF SEWER MANHOLES
 STA. 29+91.5, LT



NOT TO SCALE

PROJECT LAYOUT SHEET #3

PROJECT NAME: BARRE CITY	FILE NAME: p08d022.dgn	PLOT DATE: 14-APR-2010
PROJECT NUMBER: STP 280(I)S	PROJECT LEADER: JLL	DRAWN BY: STANTEC
	DESIGNED BY: STANTEC	CHECKED BY: JLL
	IPARM FILE: p08d022i03.i	SHEET 10 OF 19