


646.20 4 INCH WHITE LINE
 STA. 30+00.0 TO 35+00.0, SOLID LT & RT
 (INCLUDING EDGE LINE BREAKS OR RADII FOR TOWN HIGHWAYS)

646.21 4 INCH YELLOW LINE
 STA. 30+00.0 TO 35+00.0, SOLID LT & RT
 (INCLUDING CENTERLINE BREAKS FOR TOWN HIGHWAYS)

646.602 TEMPORARY 4 INCH WHITE LINE, PAINT
 STA. 30+00.0 TO 35+00.0, SOLID LT & RT
 (INCLUDING EDGE LINE BREAKS OR RADII FOR TOWN HIGHWAYS)

646.612 TEMPORARY 4 INCH YELLOW LINE, PAINT
 STA. 30+00.0 TO 35+00.0, SOLID LT & RT
 (INCLUDING CENTERLINE BREAKS FOR TOWN HIGHWAYS)

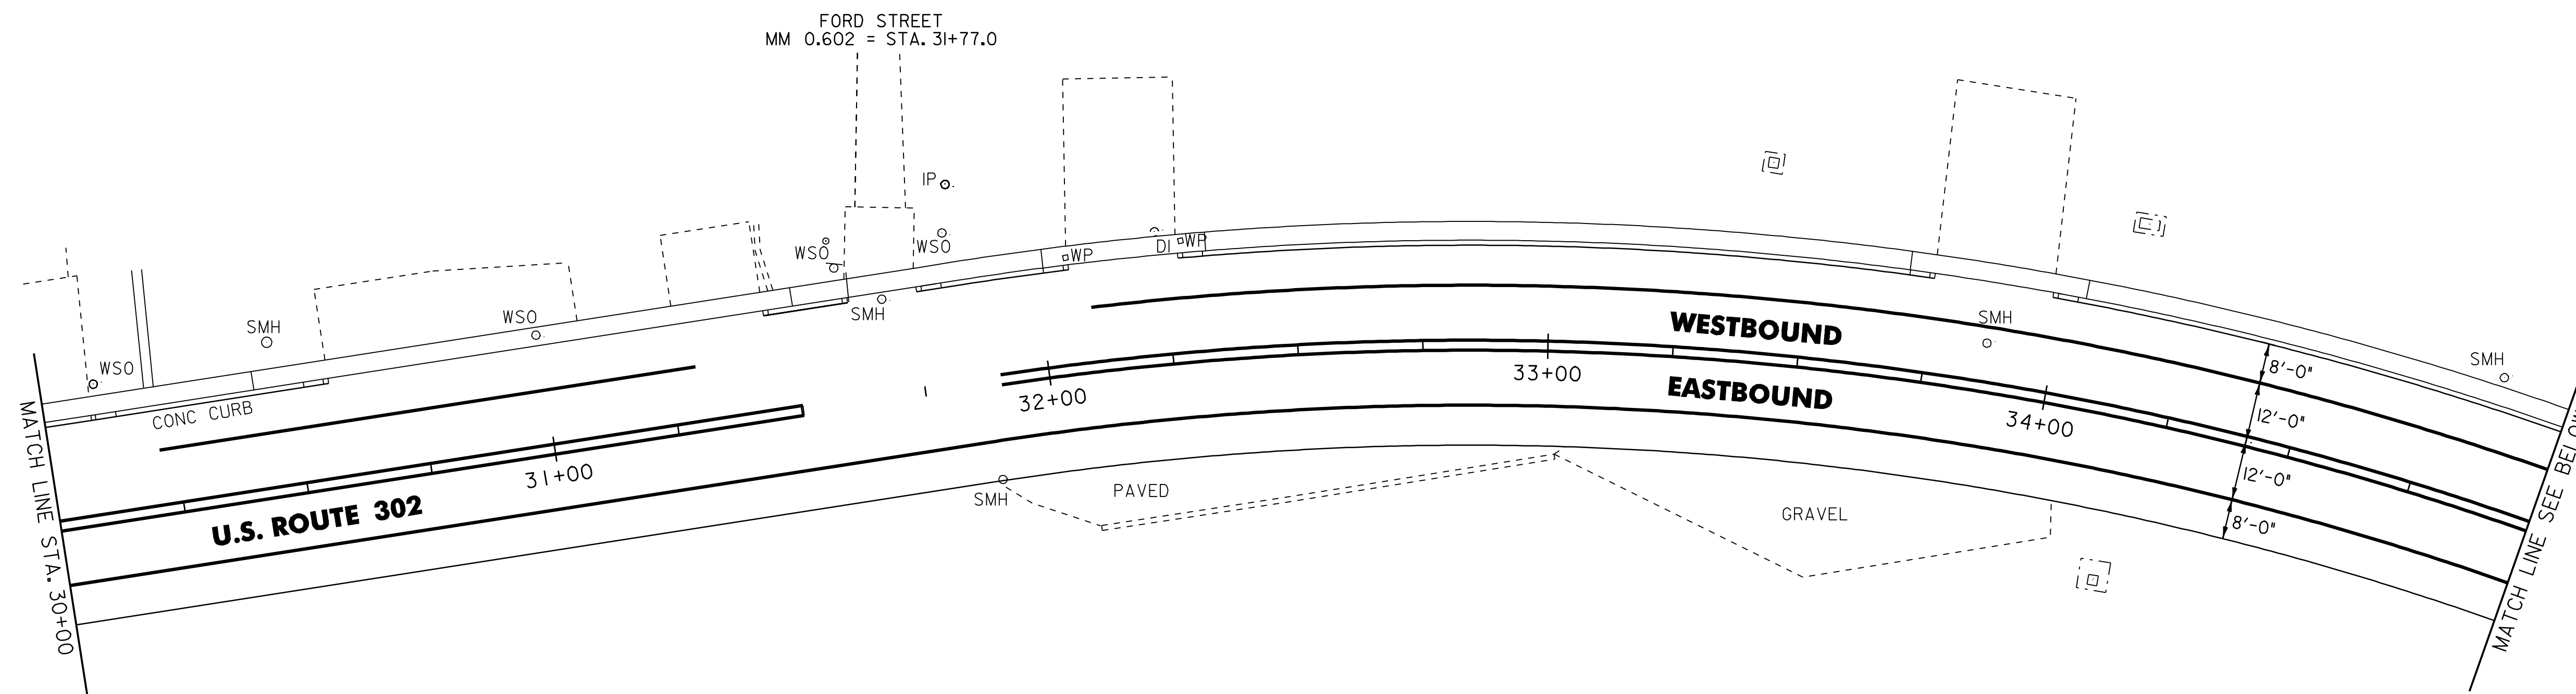

604.42 CHANGING ELEVATION OF SEWER MANHOLES
~~STA. 31+74.6, LT~~
~~STA. 31+95.5, RT~~
~~STA. 33+97.0, LT~~

646.20 4 INCH WHITE LINE
 STA. 35+00.0 TO 40+00.0, SOLID LT & RT
 (INCLUDING EDGE LINE BREAKS OR RADII FOR TOWN HIGHWAYS)

646.21 4 INCH YELLOW LINE
 STA. 35+00.0 TO 40+00.0, SOLID LT & RT
 STA. 35+05.0 TO 38+50.0, DOUBLE SOLID RT

646.23 8 INCH YELLOW LINE
 STA. 35+05.0 TO 38+50.0, SOLID DIAGONALS RT

646.602 TEMPORARY 4 INCH WHITE LINE, PAINT
 STA. 35+00.0 TO 40+00.0, SOLID LT & RT
 (INCLUDING EDGE LINE BREAKS OR RADII FOR TOWN HIGHWAYS)



646.612 TEMPORARY 4 INCH YELLOW LINE, PAINT
 STA. 35+00.0 TO 40+00.0, SOLID LT & RT
 STA. 35+05.0 TO 38+50.0, DOUBLE SOLID RT

646.652 TEMPORARY 8 INCH YELLOW LINE, PAINT
 STA. 35+05.0 TO 38+50.0, SOLID DIAGONALS RT

646.30 LETTER OR SYMBOL
 STA. 38+54.0, RT - ARROW
 STA. 39+08.3, RT - "ONLY"
 STA. 39+62.5, RT - ARROW

675.50 REMOVING SIGNS
 AS SHOWN - I

646.692 TEMPORARY LETTER OR SYMBOL, PAINT
 STA. 38+54.0, RT - ARROW
 STA. 39+62.5, RT - ARROW

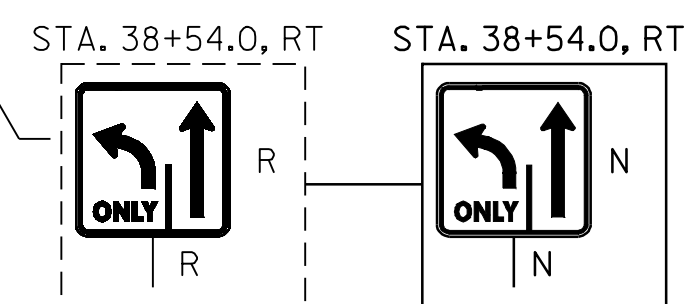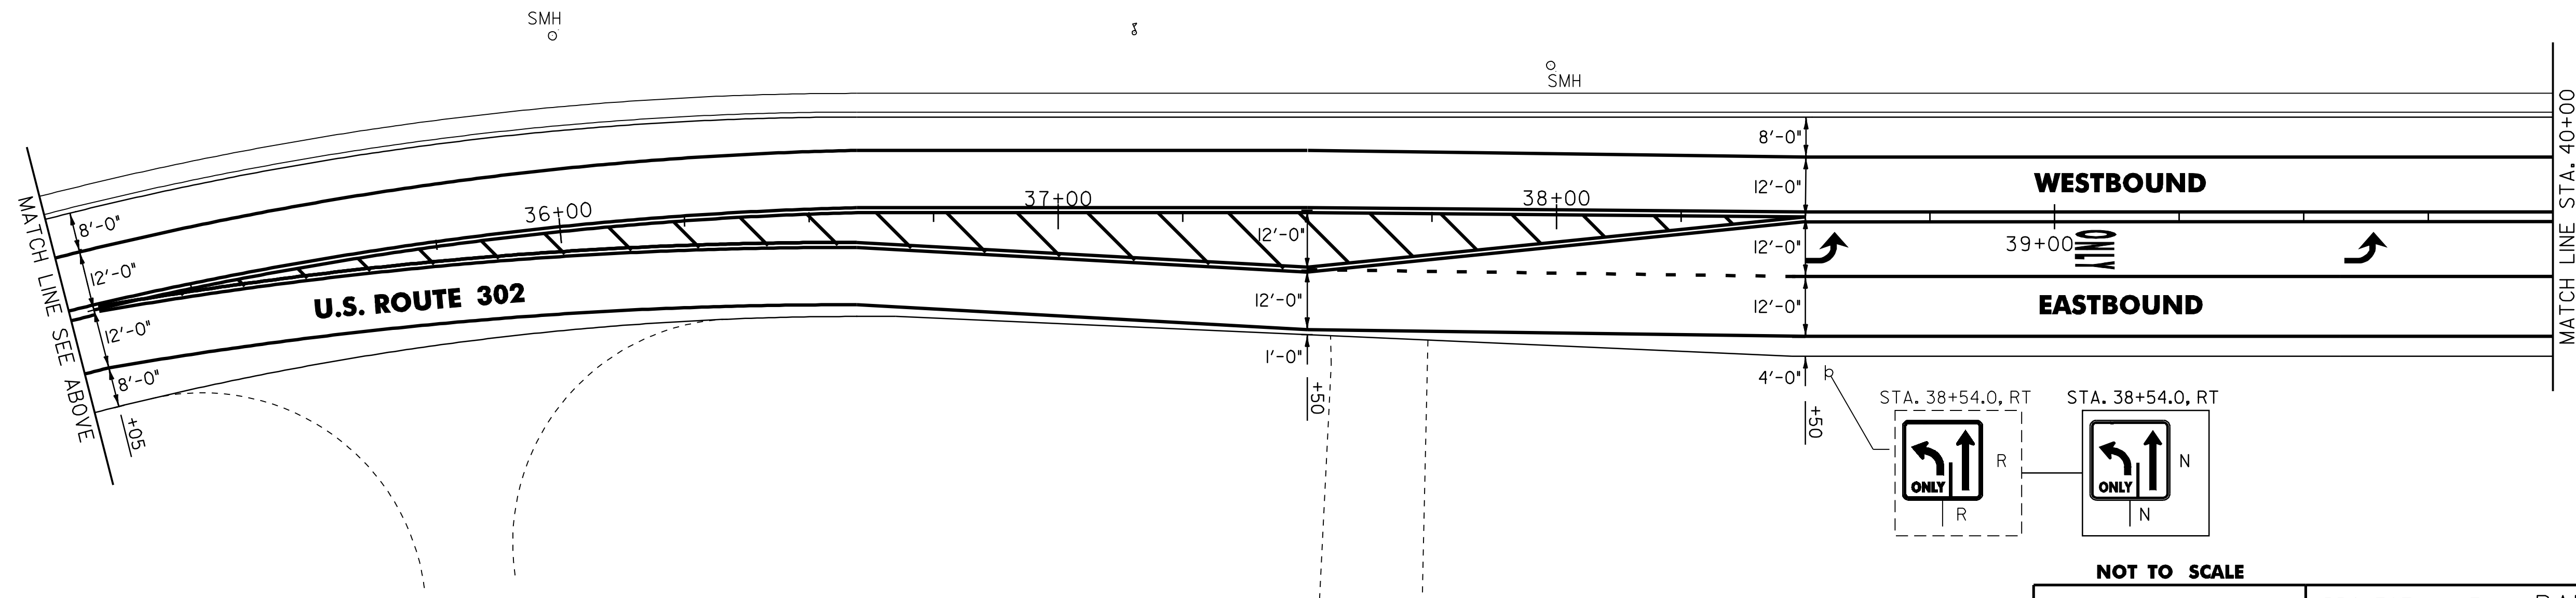

NOT TO SCALE



PROJECT LAYOUT SHEET #4

PROJECT NAME: BARRE CITY	PLOT DATE: 14-APR-2010
PROJECT NUMBER: STP 280(I)S	DRAWN BY: STANTEC
FILE NAME: p08d022.dgn	CHECKED BY: JLL
DESIGNED BY: STANTEC	SHEET 11 OF 19
IPARM FILE: p08d022104.I	