

**646.20 4 INCH WHITE LINE**  
 STA. 40+00.0 TO 45+00.0, SOLID LT & RT  
 (INCLUDING EDGE LINE BREAKS OR RADII FOR TOWN HIGHWAYS)  
 STA. 40+00.0 TO 40+96.6, SOLID RT (LANE LINE)

**646.21 4 INCH YELLOW LINE**  
 STA. 40+00.0 TO 45+00.0, SOLID LT & RT  
 (INCLUDING CENTERLINE BREAKS FOR TOWN HIGHWAYS)  
 STA. 41+37.5 TO 43+55.0, DOUBLE SOLID RT

**646.23 8 INCH YELLOW LINE**  
 STA. 41+37.5 TO 43+55.0, SOLID DIAGONALS RT

**646.602 TEMPORARY 4 INCH WHITE LINE, PAINT**  
 STA. 40+00.0 TO 45+00.0, SOLID LT & RT  
 (INCLUDING EDGE LINE BREAKS OR RADII FOR TOWN HIGHWAYS)  
 STA. 40+00.0 TO 40+96.6, SOLID RT (LANE LINE)

**646.612 TEMPORARY 4 INCH YELLOW LINE, PAINT**  
 STA. 40+00.0 TO 45+00.0, SOLID LT & RT  
 (INCLUDING CENTERLINE BREAKS FOR TOWN HIGHWAYS)  
 STA. 41+37.5 TO 43+55.0, DOUBLE SOLID RT

**646.652 TEMPORARY 8 INCH YELLOW LINE, PAINT**  
 STA. 41+37.5 TO 43+55.0, SOLID DIAGONALS RT

**646.30 LETTER OR SYMBOL**  
 STA. 40+16.8, RT - 'ONLY'  
 STA. 40+71.0, RT - ARROW

**646.692 TEMPORARY LETTER OR SYMBOL, PAINT**  
 STA. 40+71.0, RT - ARROW

**604.40 CHANGING ELEVATION OF DI, CB, OR MH**  
 STA. 41+50.5, LT  
~~STA. 42+92.0, LT~~  
~~STA. 44+05.5, LT~~

**604.47 CAST IRON GRATE WITH FRAME, TYPE D**  
 STA. 41+50.5, LT  
 STA. 42+92.0, LT  
 STA. 44+05.5, LT

**604.42 CHANGING ELEVATION OF SEWER MANHOLES**  
 STA. 41+17.6, LT  
 STA. 42+22.6, RT


**646.20 4 INCH WHITE LINE**  
 STA. 45+00.0 TO 50+00.0, SOLID LT & RT  
 (INCLUDING EDGE LINE BREAKS OR RADII FOR TOWN HIGHWAYS)

**646.602 TEMPORARY 4 INCH WHITE LINE, PAINT**  
 STA. 45+00.0 TO 50+00.0, SOLID LT & RT  
 (INCLUDING EDGE LINE BREAKS OR RADII FOR TOWN HIGHWAYS)

**646.21 4 INCH YELLOW LINE**  
 STA. 45+00.0 TO 50+00.0, SOLID LT & RT  
 (INCLUDING CENTERLINE BREAKS FOR TOWN HIGHWAYS)

**646.612 TEMPORARY 4 INCH YELLOW LINE, PAINT**  
 STA. 45+00.0 TO 50+00.0, SOLID LT & RT  
 (INCLUDING CENTERLINE BREAKS FOR TOWN HIGHWAYS)

**604.42 CE SMH**  
**47+03 LT**

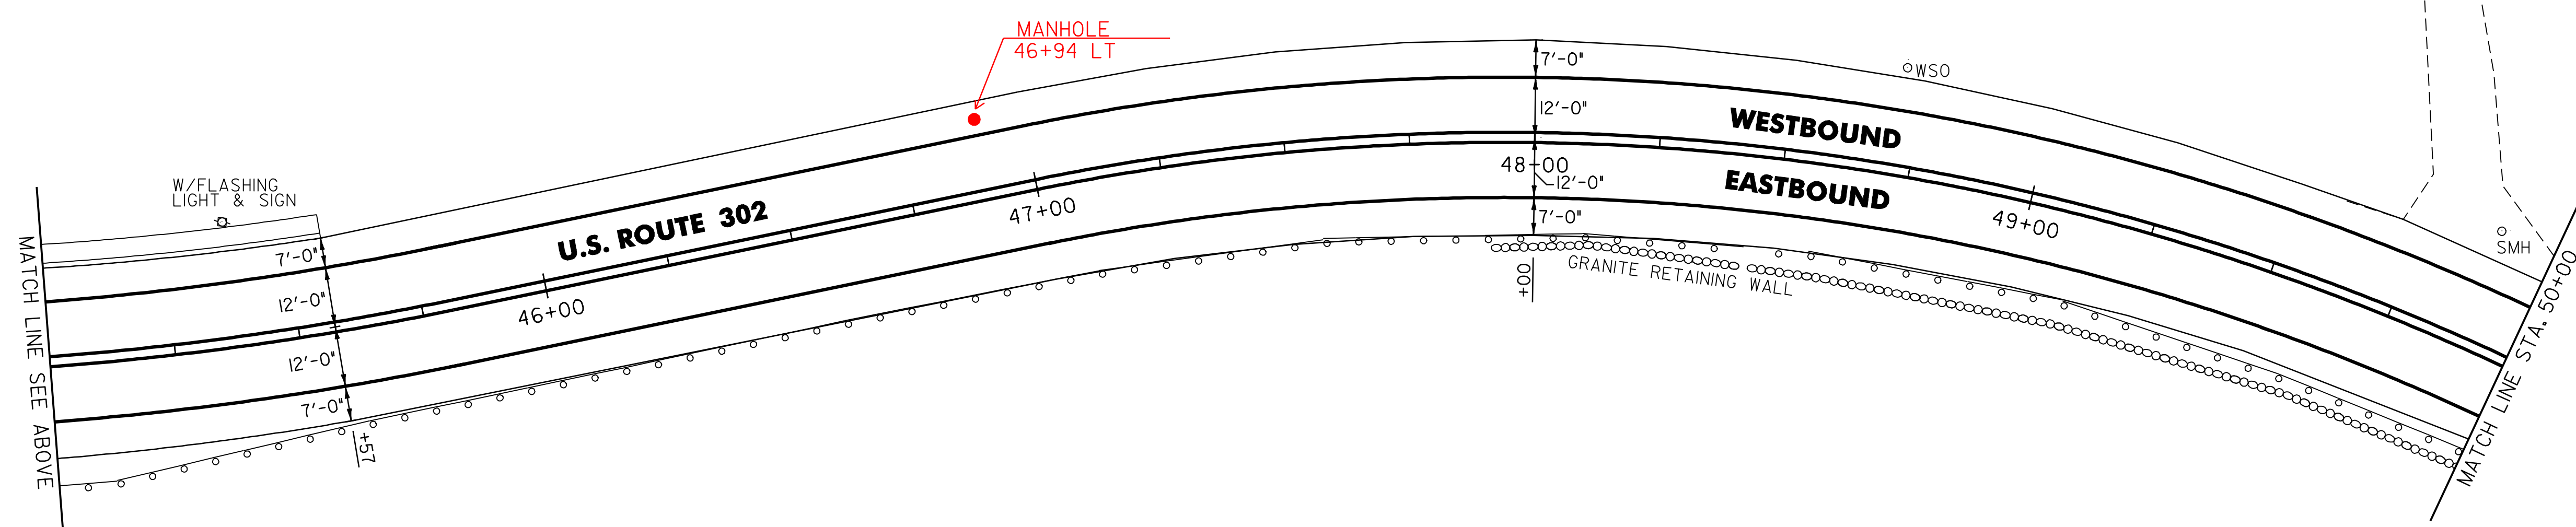

NOT TO SCALE

<b>PROJECT LAYOUT SHEET #5</b>	PROJECT NAME: BARRE CITY	PLOT DATE: 14-APR-2010
	PROJECT NUMBER: STP 280(I)S	DRAWN BY: STANTEC
	FILE NAME: p08d022.dgn	CHECKED BY: JLL
	DESIGNED BY: STANTEC	SHEET 12 OF 19
	IPARM FILE: p08d022105.dgn	