

646.20 4 INCH WHITE LINE
 STA. 60+00.0 TO 65+00.0, SOLID LT & RT
 (INCLUDING EDGE LINE BREAKS OR RADII FOR TOWN HIGHWAYS)


646.602 TEMPORARY 4 INCH WHITE LINE, PAINT
 STA. 60+00.0 TO 65+00.0, SOLID LT & RT
 (INCLUDING EDGE LINE BREAKS OR RADII FOR TOWN HIGHWAYS)

604.40 CHANGING ELEVATION OF DI, CB, OR MH
~~STA. 60+02.3, RT~~
~~STA. 60+52.4, LT~~
~~STA. 60+76.0, LT~~
~~STA. 61+00.0, RT~~
~~STA. 61+73.1, LT~~
~~STA. 61+99.5, RT~~
~~STA. 63+24.4, RT~~
~~STA. 64+22.5, RT (2)~~
~~STA. 64+33.0, LT~~
 60+72 LT




604.42 CHANGING ELEVATION OF SEWER MANHOLES
 STA. 60+02.3, RT
 STA. 62+93.0, RT
 61+73 LT
 60+64 RT
 62+83 RT
 63+24 RT
 64+24 RT

646.21 4 INCH YELLOW LINE
 STA. 60+00.0 TO 65+00.0, SOLID LT & RT
 (INCLUDING CENTERLINE BREAKS FOR TOWN HIGHWAYS)

646.612 TEMPORARY 4 INCH YELLOW LINE, PAINT
 STA. 60+00.0 TO 65+00.0, SOLID LT & RT
 (INCLUDING CENTERLINE BREAKS FOR TOWN HIGHWAYS)

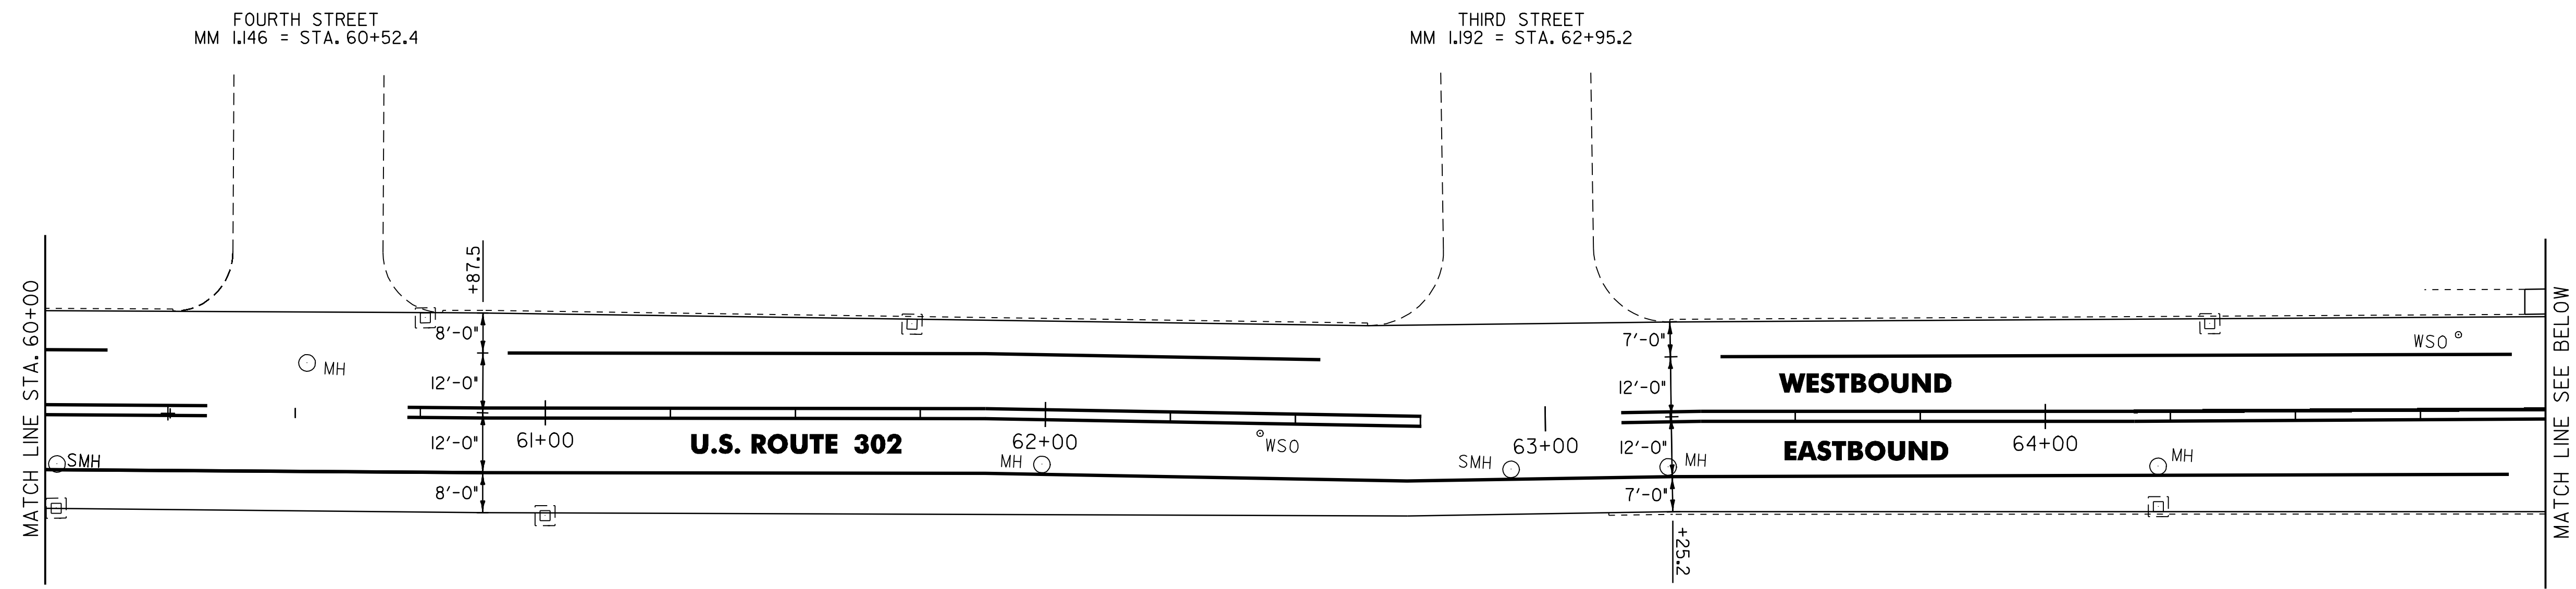





629.20 ADJUST ELEVATION OF VALVE BOX
 STA. 62+43.0, RT
 STA. 64+82.7, LT

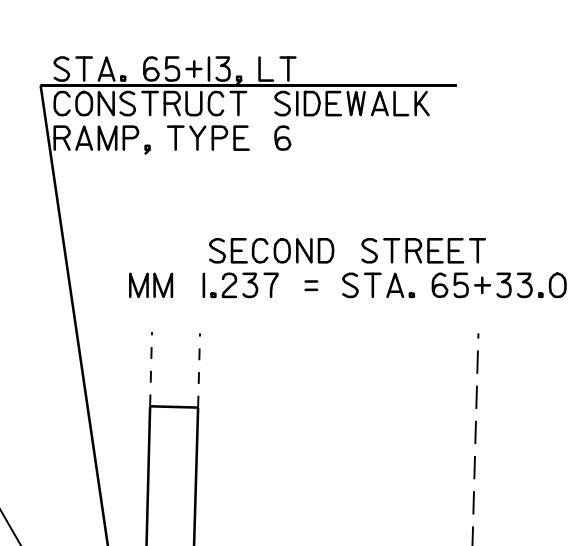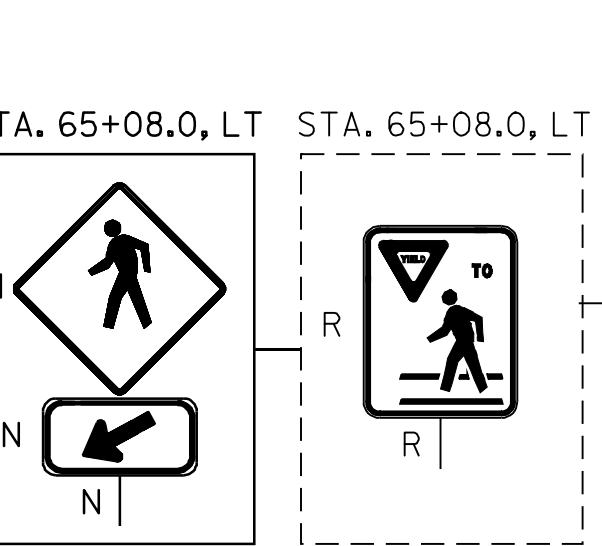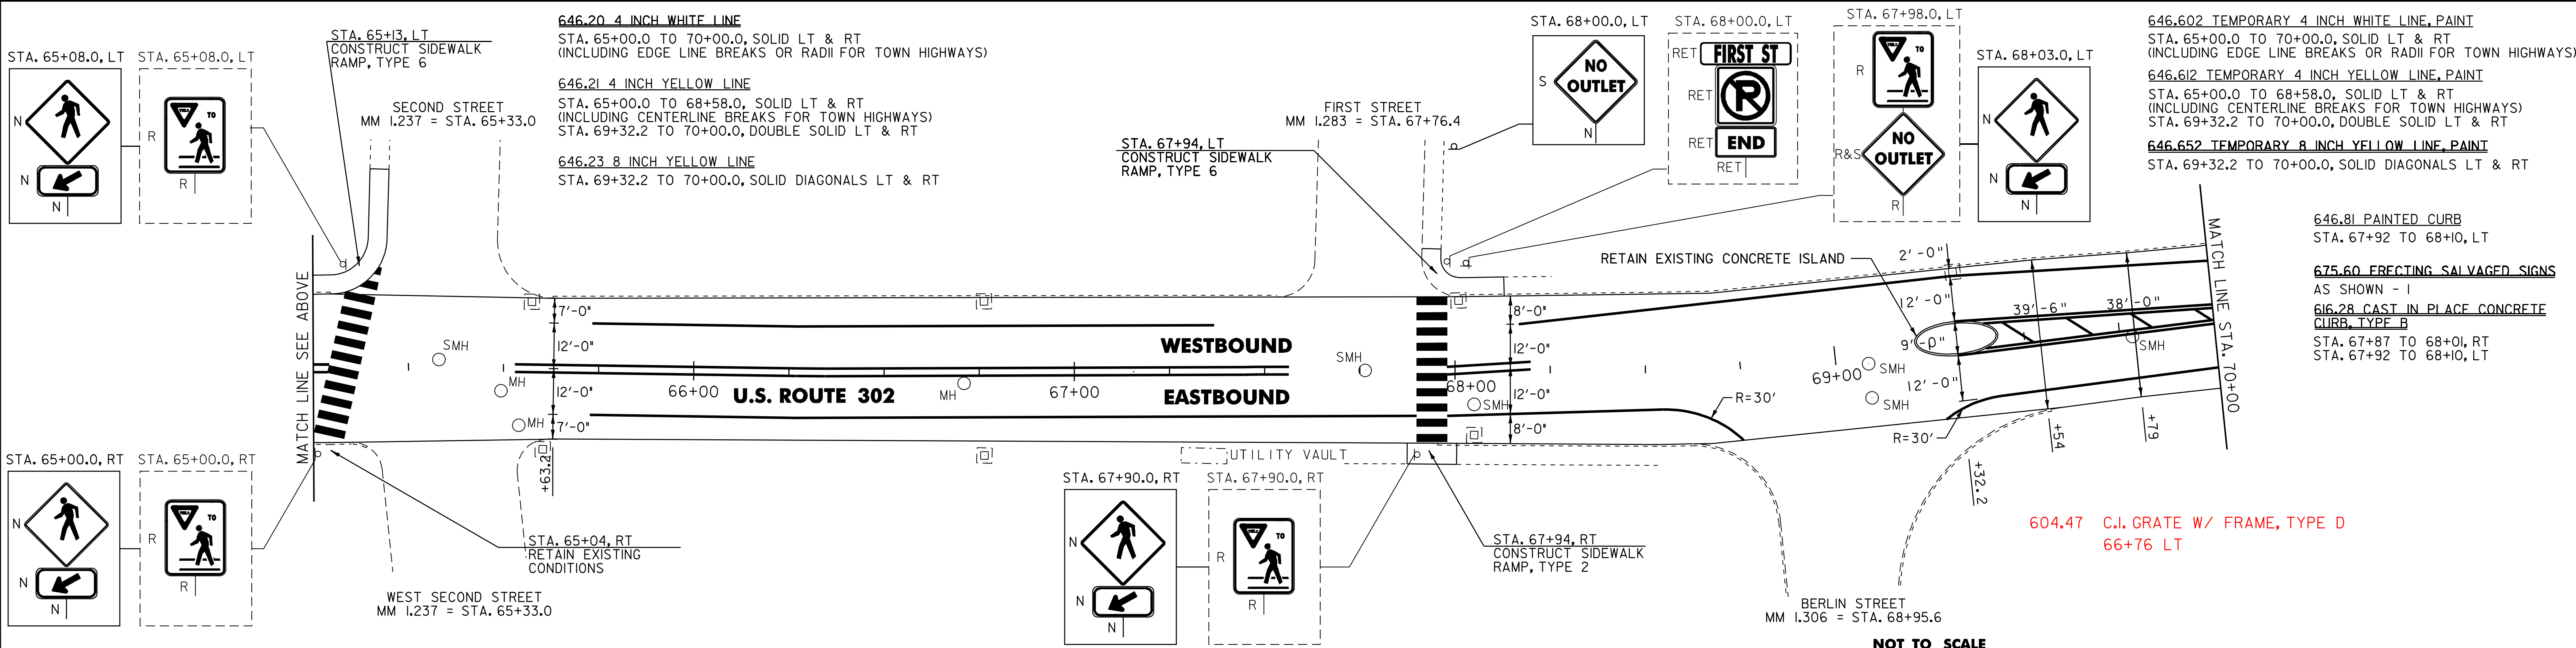

646.20 4 INCH WHITE LINE
 STA. 65+00.0 TO 70+00.0, SOLID LT & RT
 (INCLUDING EDGE LINE BREAKS OR RADII FOR TOWN HIGHWAYS)

646.21 4 INCH YELLOW LINE
 STA. 65+00.0 TO 68+58.0, SOLID LT & RT
 (INCLUDING CENTERLINE BREAKS FOR TOWN HIGHWAYS)

646.23 8 INCH YELLOW LINE
 STA. 69+32.2 TO 70+00.0, SOLID DIAGONALS LT & RT

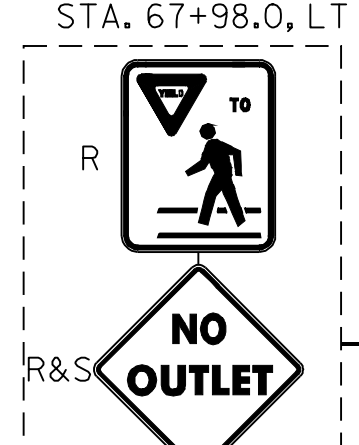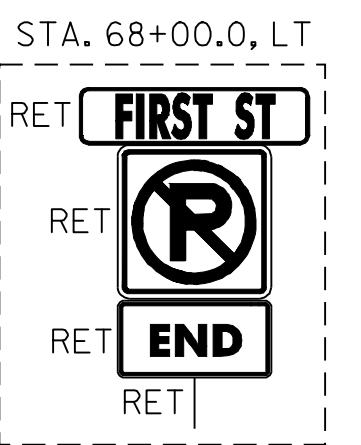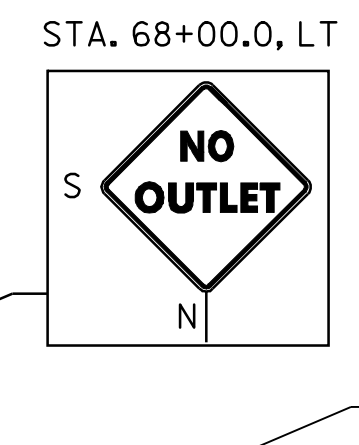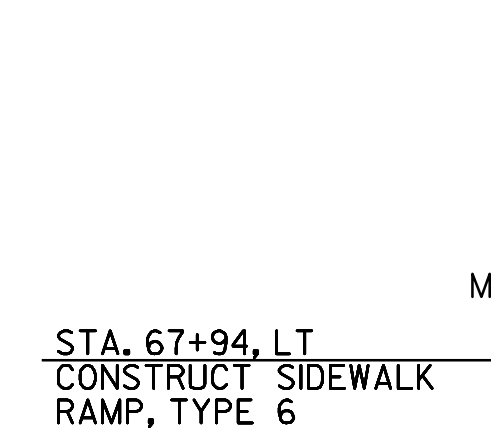

646.602 TEMPORARY 4 INCH WHITE LINE, PAINT
 STA. 65+00.0 TO 70+00.0, SOLID LT & RT
 (INCLUDING EDGE LINE BREAKS OR RADII FOR TOWN HIGHWAYS)






646.612 TEMPORARY 4 INCH YELLOW LINE, PAINT
 STA. 65+00.0 TO 68+58.0, SOLID LT & RT
 (INCLUDING CENTERLINE BREAKS FOR TOWN HIGHWAYS)

646.652 TEMPORARY 8 INCH YELLOW LINE, PAINT
 STA. 69+32.2 TO 70+00.0, SOLID DIAGONALS LT & RT

646.81 PAINTED CURB
 STA. 67+92 TO 68+10, LT

675.60 ERECTING SALVAGED SIGNS
 AS SHOWN - 1

616.28 CAST IN PLACE CONCRETE CURB, TYPE B
 STA. 67+87 TO 68+01, RT
 STA. 67+92 TO 68+10, LT

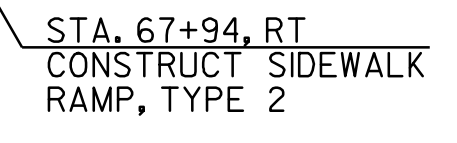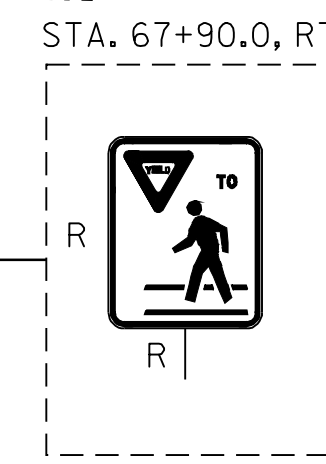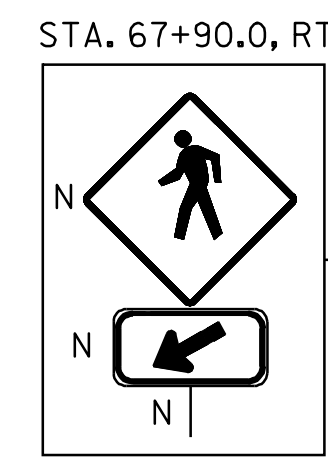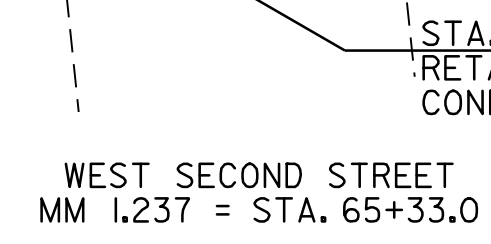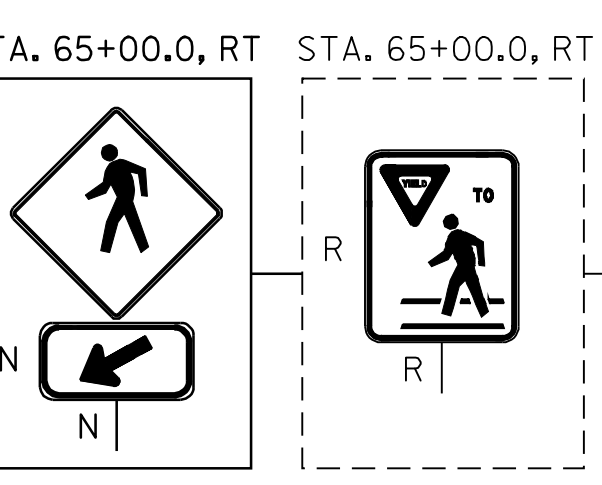

646.31 CROSSWALK MARKING
 STA. 65+04.0, RT TO 65+13.0, LT
 STA. 67+93.8, LT/RT

675.50 REMOVING SIGNS
 AS SHOWN - 5

604.40 CHANGING ELEVATION OF DI, CB, OR MH
~~STA. 65+49.4, RT~~
~~STA. 65+54.2, RT~~
~~STA. 65+57.2, LT~~
~~STA. 66+71.0, RT~~
~~STA. 66+76.3, LT~~
~~STA. 68+01.0, LT~~
~~STA. 68+05.0, RT~~
~~STA. 69+33.0, LT~~

604.42 CHANGING ELEVATION OF SEWER MANHOLES
~~STA. 65+33.0, LT~~
~~STA. 67+76.4, C~~
~~STA. 68+05.0, RT~~
~~STA. 69+08.6, RT (2)~~
~~STA. 69+78.3, RT~~
 65+54 RT
 65+49 RT
 66+71 CL

604.47 C.I. GRATE W/ FRAME, TYPE D
 66+76 LT

NOT TO SCALE



PROJECT LAYOUT SHEET #7

PROJECT NAME: BARRE CITY	PLOT DATE: 14-APR-2010
PROJECT NUMBER: STP 280(I)S	DRAWN BY: STANTEC
FILE NAME: p08d022.dgn	CHECKED BY: JLL
PROJECT LEADER: JLL	SHEET 14 OF 19
DESIGNED BY: STANTEC	
IPARM FILE: p08d022107.I	