

STA. 71+13.0, LT
 S N MAIN ST
 STOP
 BECKLEY ST
 3020 1201 0136
 6004 1201 0000
 B-B

STA. 71+13.0, LT
 R&S 3020 1201 0136
 R&S 6004 1201 0000
 R STOP
 B-B

STA. 71+14.0, LT
 R&S BECKLEY ST
 R N MAIN ST
 R
 R
 R
 R

STA. 71+14.0, LT
 N
 N
 N

STA. 71+14.0, LT
 N
 N

STA. 71+13.0, LT
 STA. 70+00.0 TO 75+00.0, SOLID LT & RT
 (INCLUDING EDGE LINE BREAKS OR RADII FOR TOWN HIGHWAYS)
 STA. 74+40.0 TO 75+00.0, DOTTED RT (LANE LINE)

646.20 4 INCH WHITE LINE
 STA. 70+00.0 TO 75+00.0, SOLID LT & RT
 (INCLUDING EDGE LINE BREAKS OR RADII FOR TOWN HIGHWAYS)
 STA. 74+40.0 TO 75+00.0, DOTTED RT (LANE LINE)

646.21 4 INCH YELLOW LINE
 STA. 70+00.0 TO 70+90.0, DOUBLE SOLID LT & RT
 STA. 70+90.0 TO 72+26.0, SOLID LT & RT
 (INCLUDING CENTERLINE BREAKS FOR TOWN HIGHWAYS)
 STA. 72+26.0 TO 75+00.0, DOUBLE SOLID LT & RT

646.23 8 INCH YELLOW LINE
 STA. 70+00.0 TO 70+90.0, SOLID DIAGONALS LT & RT
 STA. 72+26.0 TO 75+00.0, SOLID DIAGONALS LT & RT

646.602 TEMPORARY 4 INCH WHITE LINE, PAINT
 STA. 70+00.0 TO 75+00.0, SOLID LT & RT
 (INCLUDING EDGE LINE BREAKS OR RADII FOR TOWN HIGHWAYS)
 STA. 74+40.0 TO 75+00.0, DOTTED RT (LANE LINE)

646.612 TEMPORARY 4 INCH YELLOW LINE, PAINT
 STA. 70+00.0 TO 70+90.0, DOUBLE SOLID LT & RT
 STA. 70+90.0 TO 72+26.0, SOLID LT & RT
 (INCLUDING CENTERLINE BREAKS FOR TOWN HIGHWAYS)
 STA. 72+26.0 TO 75+00.0, DOUBLE SOLID LT & RT

646.652 TEMPORARY 8 INCH YELLOW LINE, PAINT
 STA. 70+00.0 TO 70+90.0, SOLID DIAGONALS LT & RT
 STA. 72+26.0 TO 75+00.0, SOLID DIAGONALS LT & RT

646.31 CROSSWALK MARKING
 STA. 71+12.0, LT/RT


646.702 TEMPORARY CROSSWALK MARKING, PAINT
 STA. 71+12.0, LT/RT

604.40 CHANGING ELEVATION OF DI, CB, OR MH
~~STA. 70+35.5, LT~~
~~STA. 71+42.0, LT~~
~~STA. 71+48.0, RT~~
~~STA. 72+46.6, LT~~
~~STA. 73+63.2, LT~~
~~STA. 73+67.6, C~~
~~STA. 74+79.0, LT~~
~~STA. 74+79.0, RT~~
 71+08 CL
 74+49 RT

604.42 CHANGING ELEVATION OF SEWER MANHOLES
~~STA. 70+15.8, RT~~

675.50 REMOVING SIGNS
 AS SHOWN - II

675.60 ERECTING SALVAGED SIGNS
 AS SHOWN - 4

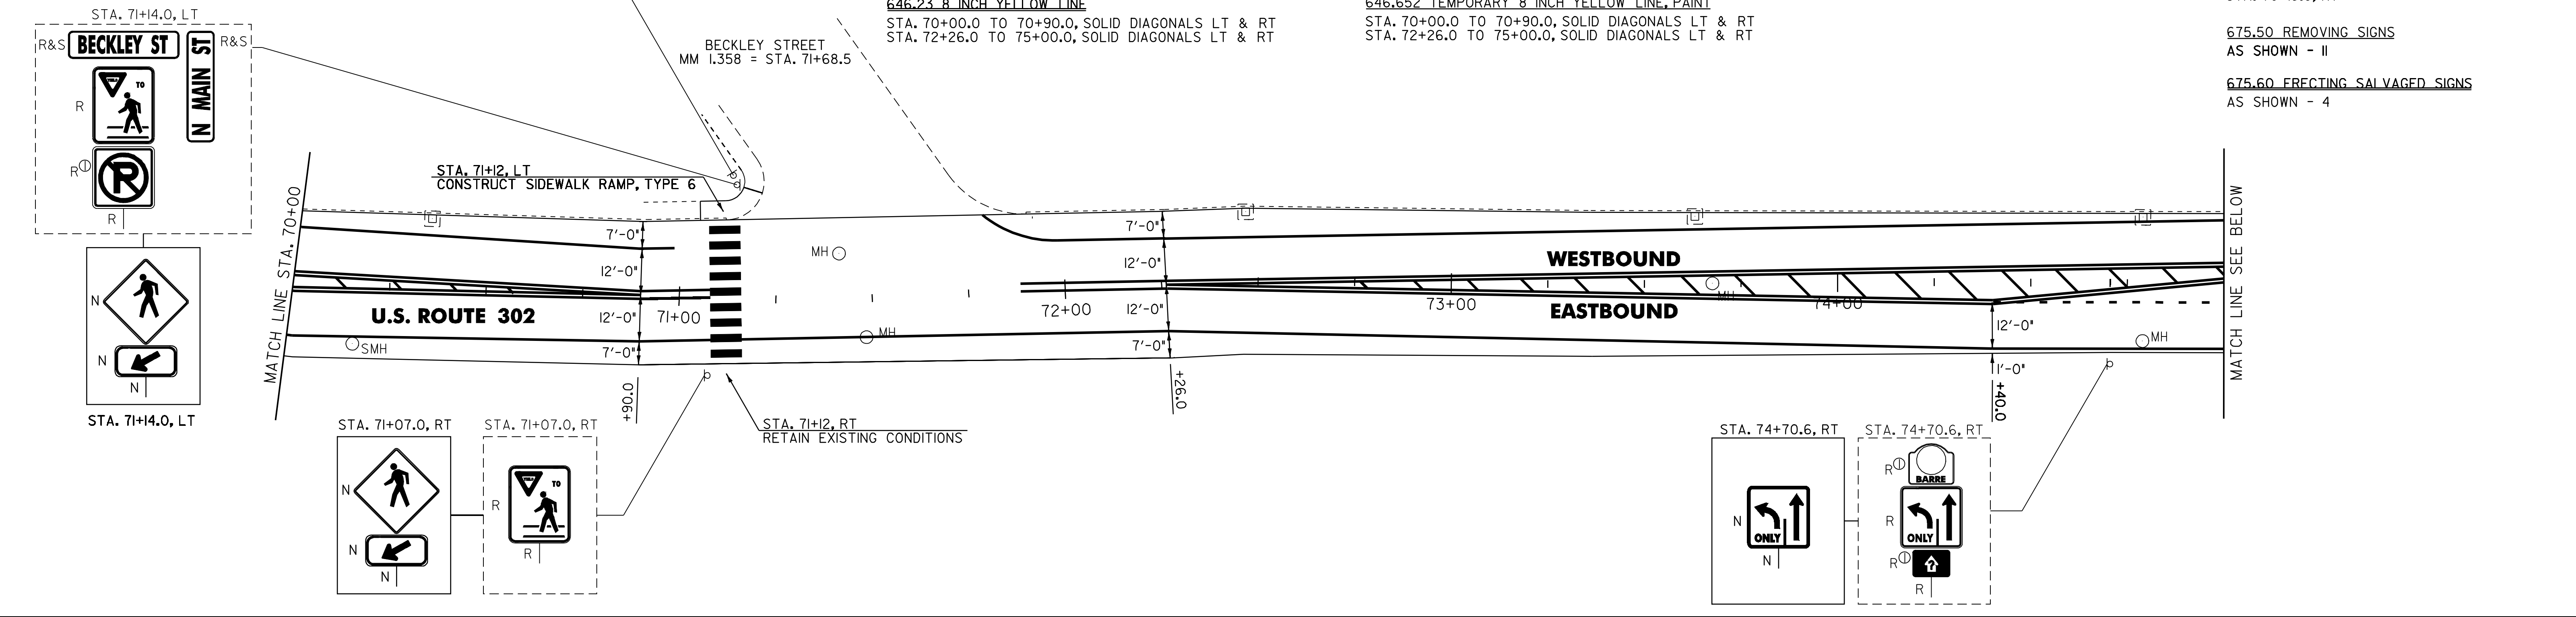

646.20 4 INCH WHITE LINE
 STA. 75+00.0 TO 80+00.0, SOLID LT & RT
 (INCLUDING EDGE LINE BREAKS OR RADII FOR TOWN HIGHWAYS)

646.21 4 INCH YELLOW LINE
 STA. 75+00.0 TO 75+40.0, DOUBLE SOLID LT & RT
 STA. 75+40.0 TO 76+00.0, DOUBLE SOLID LT
 (INCLUDING CENTERLINE BREAKS FOR TOWN HIGHWAYS)
 STA. 76+71.0 TO 78+22.0, DOUBLE SOLID LT & RT
 STA. 78+22.0 TO 80+00.0, SOLID LT & RT

646.602 TEMPORARY 4 INCH WHITE LINE, PAINT
 STA. 75+00.0 TO 80+00.0, SOLID LT & RT
 (INCLUDING EDGE LINE BREAKS OR RADII FOR TOWN HIGHWAYS)

646.612 TEMPORARY 4 INCH YELLOW LINE, PAINT
 STA. 75+00.0 TO 75+40.0, DOUBLE SOLID LT & RT
 STA. 75+40.0 TO 76+00.0, DOUBLE SOLID LT
 (INCLUDING CENTERLINE BREAKS FOR TOWN HIGHWAYS)
 STA. 76+71.0 TO 78+22.0, DOUBLE SOLID LT & RT
 STA. 78+22.0 TO 80+00.0, SOLID LT & RT

646.23 8 INCH YELLOW LINE
 STA. 75+00.0 TO 75+40.0, SOLID DIAGONALS LT & RT
 STA. 76+71.0 TO 78+22.0, SOLID DIAGONALS LT & RT


646.652 TEMPORARY 8 INCH YELLOW LINE, PAINT
 STA. 75+00.0 TO 75+40.0, SOLID DIAGONALS LT & RT
 STA. 76+71.0 TO 78+22.0, SOLID DIAGONALS LT & RT

646.30 LETTER OR SYMBOL
 STA. 75+44.0, C - 'ONLY'
 STA. 75+96.0, C - ARROW

646.692 TEMPORARY LETTER OR SYMBOL, PAINT
 STA. 75+96.0, C - ARROW

604.40 CHANGING ELEVATION OF DI, CB, OR MH
 STA. 75+61.2, LT
 STA. 76+08.0, RT
~~STA. 77+18.7, LT~~
~~STA. 77+18.7, RT~~
 STA. 79+08.4, RT
~~STA. 79+25.0, LT~~
 77+48 LT

N. SEMINARY STREET
 MM 1.446 = STA. 76+35.0

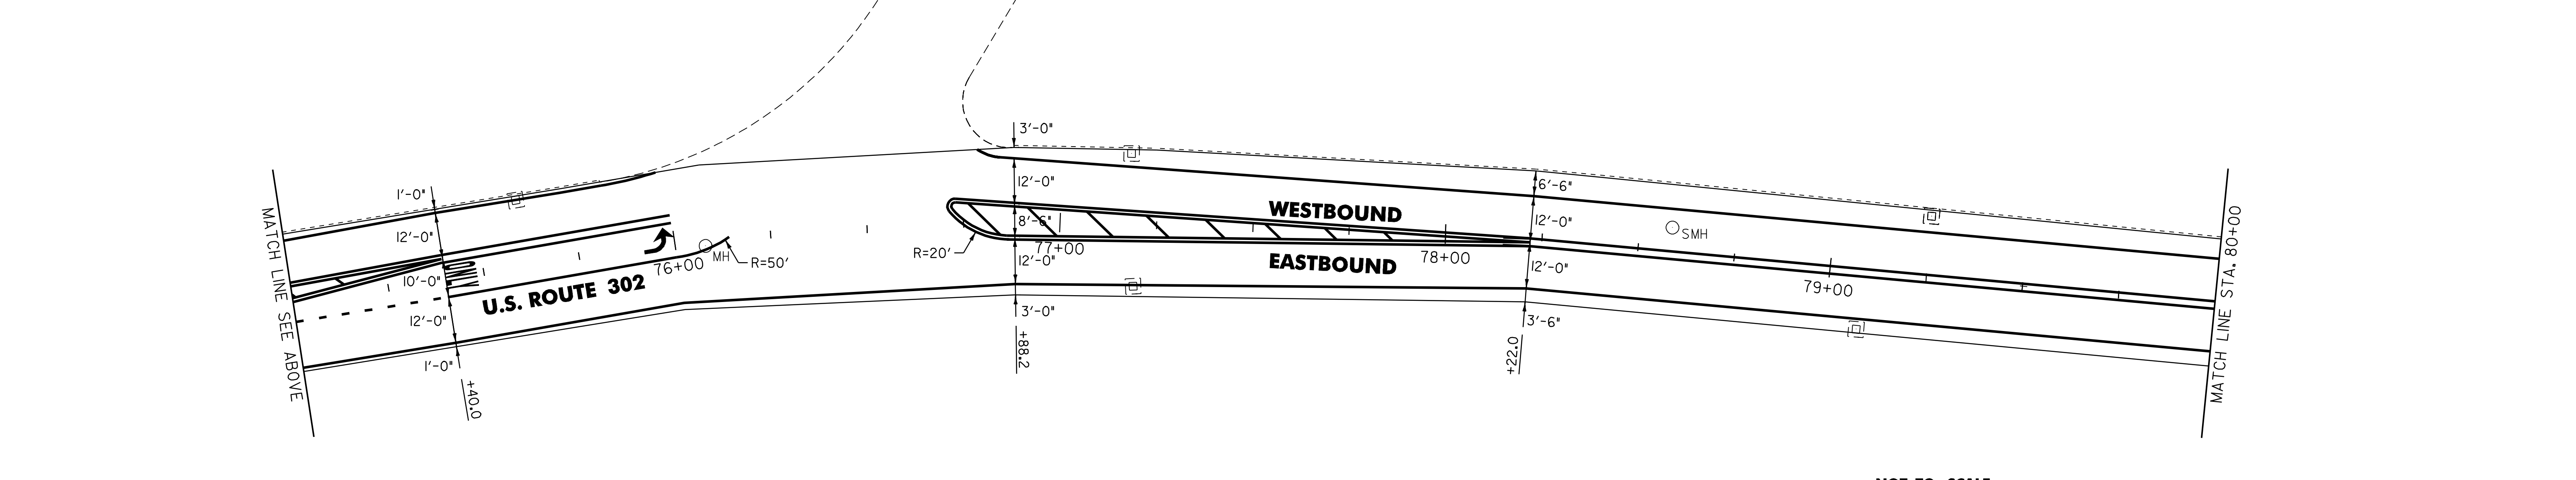

604.42 CHANGING ELEVATION OF SEWER MANHOLES
 STA. 78+58.3, LT



NOT TO SCALE

PROJECT LAYOUT SHEET #8

PROJECT NAME: BARRE CITY
 PROJECT NUMBER: STP 280(I)S

FILE NAME: p08d022.dgn
 PROJECT LEADER: JLL
 DESIGNED BY: STANTEC
 IPARM FILE: p08d022i08.i

PLOT DATE: 14-APR-2010
 DRAWN BY: STANTEC
 CHECKED BY: JLL
 SHEET 15 OF 19