

646.20 4 INCH WHITE LINE
 STA. 80+00.0 TO 85+00.0, SOLID LT & RT
 (INCLUDING EDGE LINE BREAKS OR RADII FOR TOWN HIGHWAYS)

646.21 4 INCH YELLOW LINE
 STA. 80+00.0 TO 85+00.0, SOLID LT & RT
 (INCLUDING CENTERLINE BREAKS FOR TOWN HIGHWAYS)

646.81 PAINTED CURB
 STA. 84+86.0 TO 85+00.0, RT

646.602 TEMPORARY 4 INCH WHITE LINE, PAINT
 STA. 80+00.0 TO 85+00.0, SOLID LT & RT
 (INCLUDING EDGE LINE BREAKS OR RADII FOR TOWN HIGHWAYS)

646.612 TEMPORARY 4 INCH YELLOW LINE, PAINT
 STA. 80+00.0 TO 85+00.0, SOLID LT & RT
 (INCLUDING CENTERLINE BREAKS FOR TOWN HIGHWAYS)

675.50 REMOVING SIGNS
 AS SHOWN - 1

646.31 CROSSWALK MARKING
 STA. 84+74.1, LT (BROOK ST.)
 STA. 84+90.0, LT TO 84+96.0, RT


646.702 TEMPORARY CROSSWALK MARKING, PAINT
 STA. 84+74.1, LT (BROOK ST.)
 STA. 84+90.0, LT TO 84+96.0, RT

646.26 24 INCH STOP BAR
 STA. 84+74.1, LT (BROOK ST. - ON EXIST. PAVEMENT)

646.682 TEMPORARY 24 INCH STOP BAR, PAINT
 STA. 84+74.1, LT (BROOK ST. - ON EXIST. PAVEMENT)

604.40 CHANGING ELEVATION OF DI, CB, OR MH
~~STA. 80+06.9, LT~~
~~STA. 80+06.9, RT~~
~~STA. 80+43.5, LT~~
~~STA. 83+10.2, RT~~
~~STA. 83+14.3, LT~~
~~STA. 83+36.6, LT~~
~~STA. 83+36.6, RT~~
~~STA. 84+14.4, LT~~
~~STA. 84+38.0, LT~~
~~STA. 84+90.6, LT~~

604.47 CAST IRON GRATE WITH FRAME, TYPE D
 STA. 83+95.0, RT
 83+36 LT
 83+45 LT

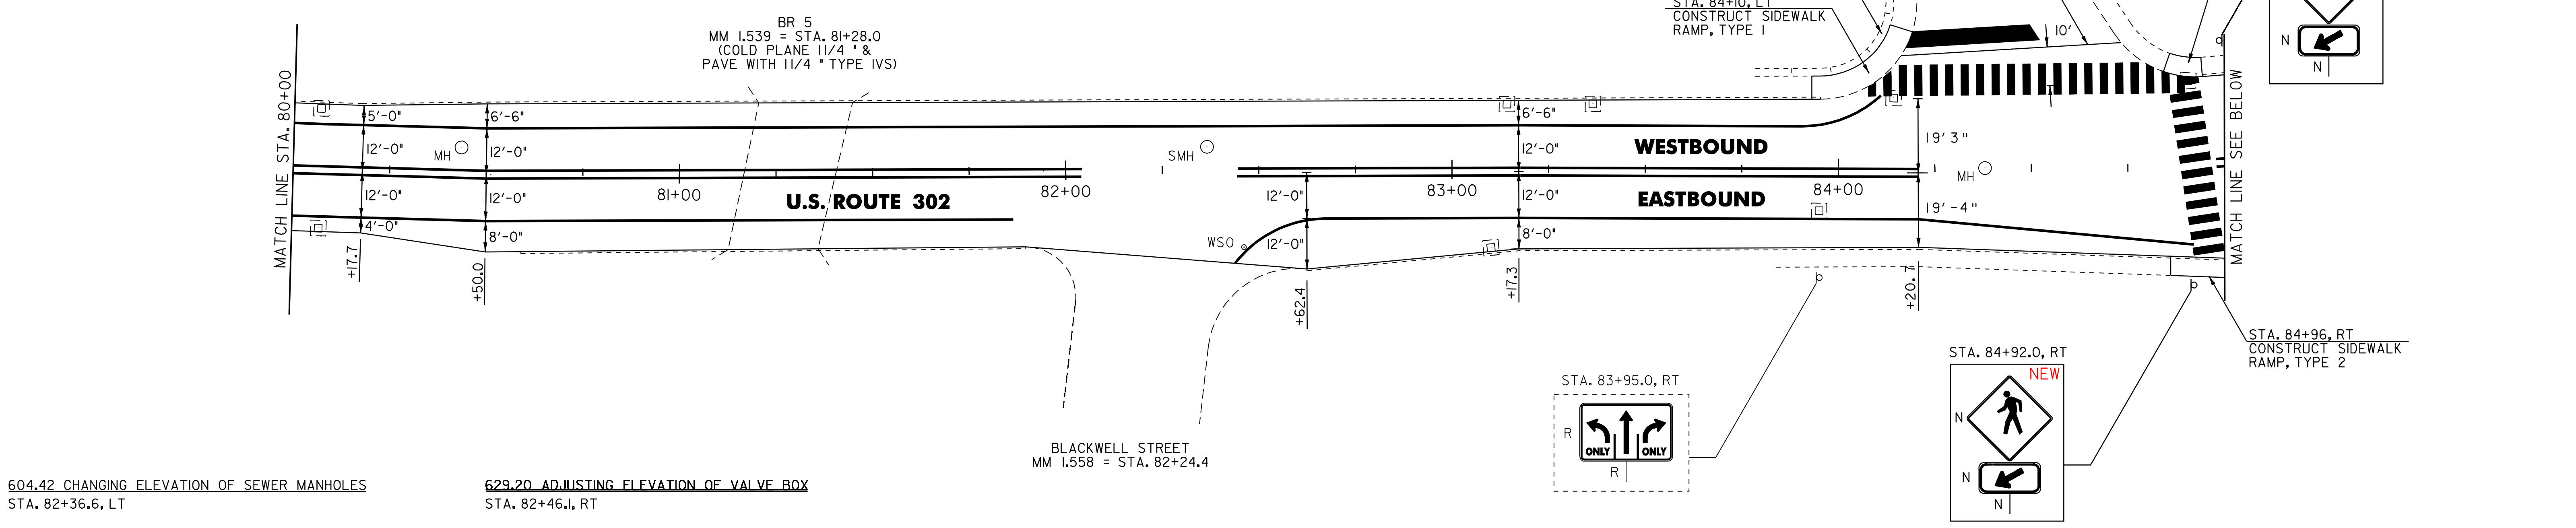

646.20 4 INCH WHITE LINE
 STA. 85+00.0 TO 86+91.0, SOLID LT & RT
 STA. 85+00.0 TO 86+20.0, DOTTED RT (LANE LINE)
 STA. 85+00.0 TO 86+91.0, SOLID RT (LANE LINE)
 STA. 86+20.0 TO 86+91.0, SOLID RT (LANE LINE)
 STA. 88+17.5 TO 89+43.5, SOLID LT & RT
 STA. 88+17.5 TO 89+43.5, SOLID LT (LANE LINE)
 STA. 88+17.5 TO 89+43.5, SOLID LT (LANE LINE)

(INCLUDING EDGE LINE BREAKS OR RADII FOR TOWN HIGHWAYS AND CROSSWALKS)

646.21 4 INCH YELLOW LINE
 STA. 85+00.0 TO 86+91.0, DOUBLE SOLID LT
 STA. 88+17.5 TO 89+43.5, DOUBLE SOLID RT
 (INCLUDING CENTERLINE BREAKS FOR TOWN HIGHWAYS AND CROSSWALKS)

646.81 PAINTED CURB
 STA. 85+00.0, TO 85+06.0, RT
 STA. 86+90.0, TO 87+10.0, RT

646.602 TEMPORARY 4 INCH WHITE LINE, PAINT
 STA. 85+00.0 TO 86+91.0, SOLID LT & RT
 STA. 85+00.0 TO 86+20.0, DOTTED RT (LANE LINE)
 STA. 85+00.0 TO 86+91.0, SOLID RT (LANE LINE)
 STA. 86+20.0 TO 86+91.0, SOLID RT (LANE LINE)
 STA. 88+17.5 TO 89+43.5, SOLID LT & RT
 STA. 88+17.5 TO 89+43.5, SOLID LT (LANE LINE)
 STA. 88+17.5 TO 89+43.5, SOLID LT (LANE LINE)

(INCLUDING EDGE LINE BREAKS OR RADII FOR TOWN HIGHWAYS AND CROSSWALKS)

646.612 TEMPORARY 4 INCH YELLOW LINE, PAINT
 STA. 85+00.0 TO 86+91.0, DOUBLE SOLID LT
 STA. 88+17.5 TO 89+43.5, DOUBLE SOLID RT
 (INCLUDING CENTERLINE BREAKS FOR TOWN HIGHWAYS AND CROSSWALKS)

675.50 REMOVING SIGNS
 AS SHOWN - 2

646.30 LETTER OR SYMBOL
 STA. 86+82.0, C - ARROW
 STA. 86+82.0, RT - ARROW
 STA. 88+26.5, LT - ARROW
 STA. 88+26.5, C - ARROW


646.692 TEMPORARY LETTER OR SYMBOL, PAINT
 STA. 86+82.0, C - ARROW
 STA. 86+82.0, RT - ARROW
 STA. 88+26.5, LT - ARROW
 STA. 88+26.5, C - ARROW

646.31 CROSSWALK MARKING
 STA. 87+00.0, RT TO 87+11.0, LT
 STA. 87+51.0, RT (VT 62)
 STA. 87+57.4, LT (VT 14-ON EXISTING PAVEMENT)
 STA. 88+07.0, LT/RT

646.702 TEMPORARY CROSSWALK MARKING, PAINT
 STA. 87+00.0, RT TO 87+11.0, LT
 STA. 87+51.0, RT (VT 62)
 STA. 87+57.4, LT (VT 14-ON EXISTING PAVEMENT)
 STA. 88+07.0, LT/RT

604.47 CAST IRON GRATE WITH FRAME, TYPE D
 STA. 85+82.2, LT
 STA. 88+39.5, LT
 STA. 88+39.5, RT
 STA. 89+25.0, RT
 STA. 89+41.0, LT
 89+30 RT
 85+26 RT

604.40 CHANGING ELEVATION OF DI, CB, OR MH
 STA. 85+26.0, RT
 STA. 85+82.2, LT
 STA. 87+95.0, LT
 STA. 88+39.5, LT
 STA. 88+39.5, RT
 STA. 89+25.0, RT
 STA. 89+30.0, RT
 STA. 89+41.0, LT

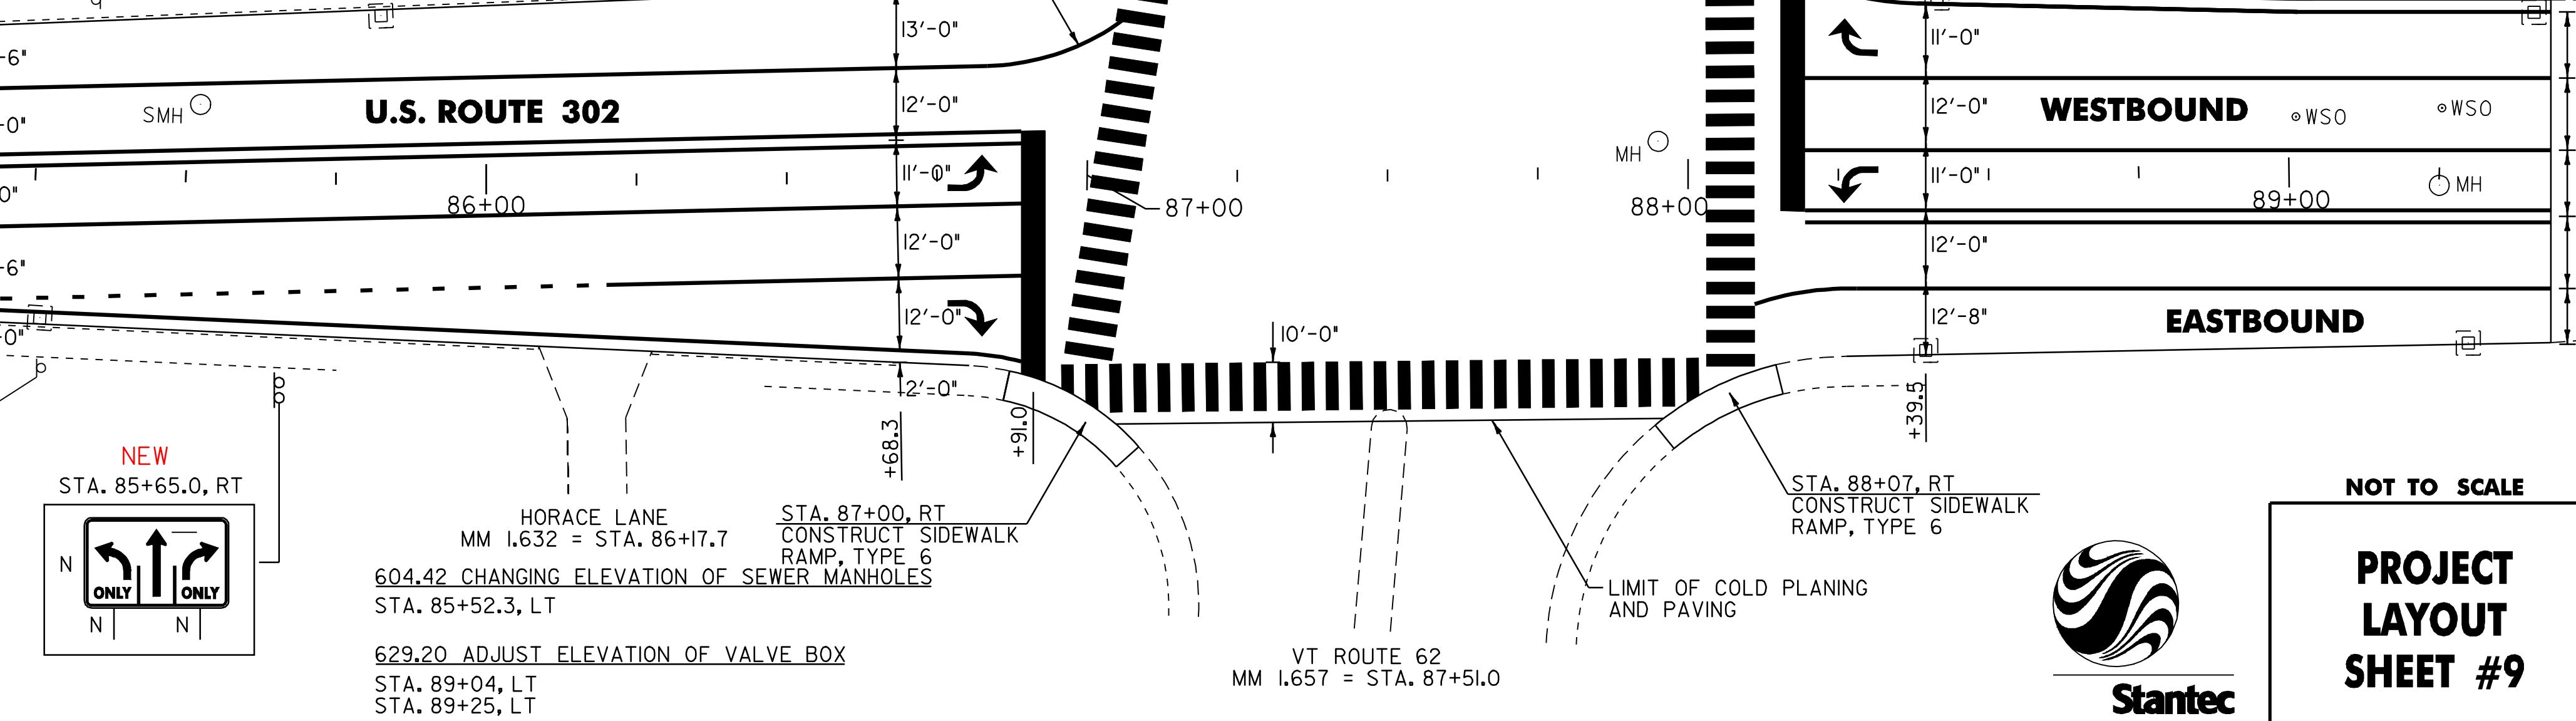

646.26 24 INCH STOP BAR
 STA. 86+91.0, LT/RT
 STA. 88+17.5, LT/RT

646.682 TEMPORARY 24 INCH STOP BAR, PAINT
 STA. 86+91.0, LT/RT
 STA. 88+17.5, LT/RT

616.28 CAST IN PLACE CONCRETE CURB, TYPE B
 STA. 85+00 TO 85+06, RT
 STA. 86+90 TO 87+10, RT

END STP 2801(1)S U.S. ROUTE 302
BARRE CITY STA 89+43.5=MM 1.694
MATCH THE CITY'S PROJECT

TO WEBSTERVILLE

* MATCH EXISTING PAVEMENT MARKINGS

NOT TO SCALE

PROJECT LAYOUT SHEET #9

PROJECT NAME: BARRE CITY
 PROJECT NUMBER: STP 2801(1)S
 FILE NAME: p08d022.dgn
 PROJECT LEADER: JLL
 DESIGNED BY: STANTEC
 IPARM FILE: p08d022109.1

PLOT DATE: 14-APR-2010
 DRAWN BY: STANTEC
 CHECKED BY: JLL
 SHEET 16 OF 19

