


- PLAN -

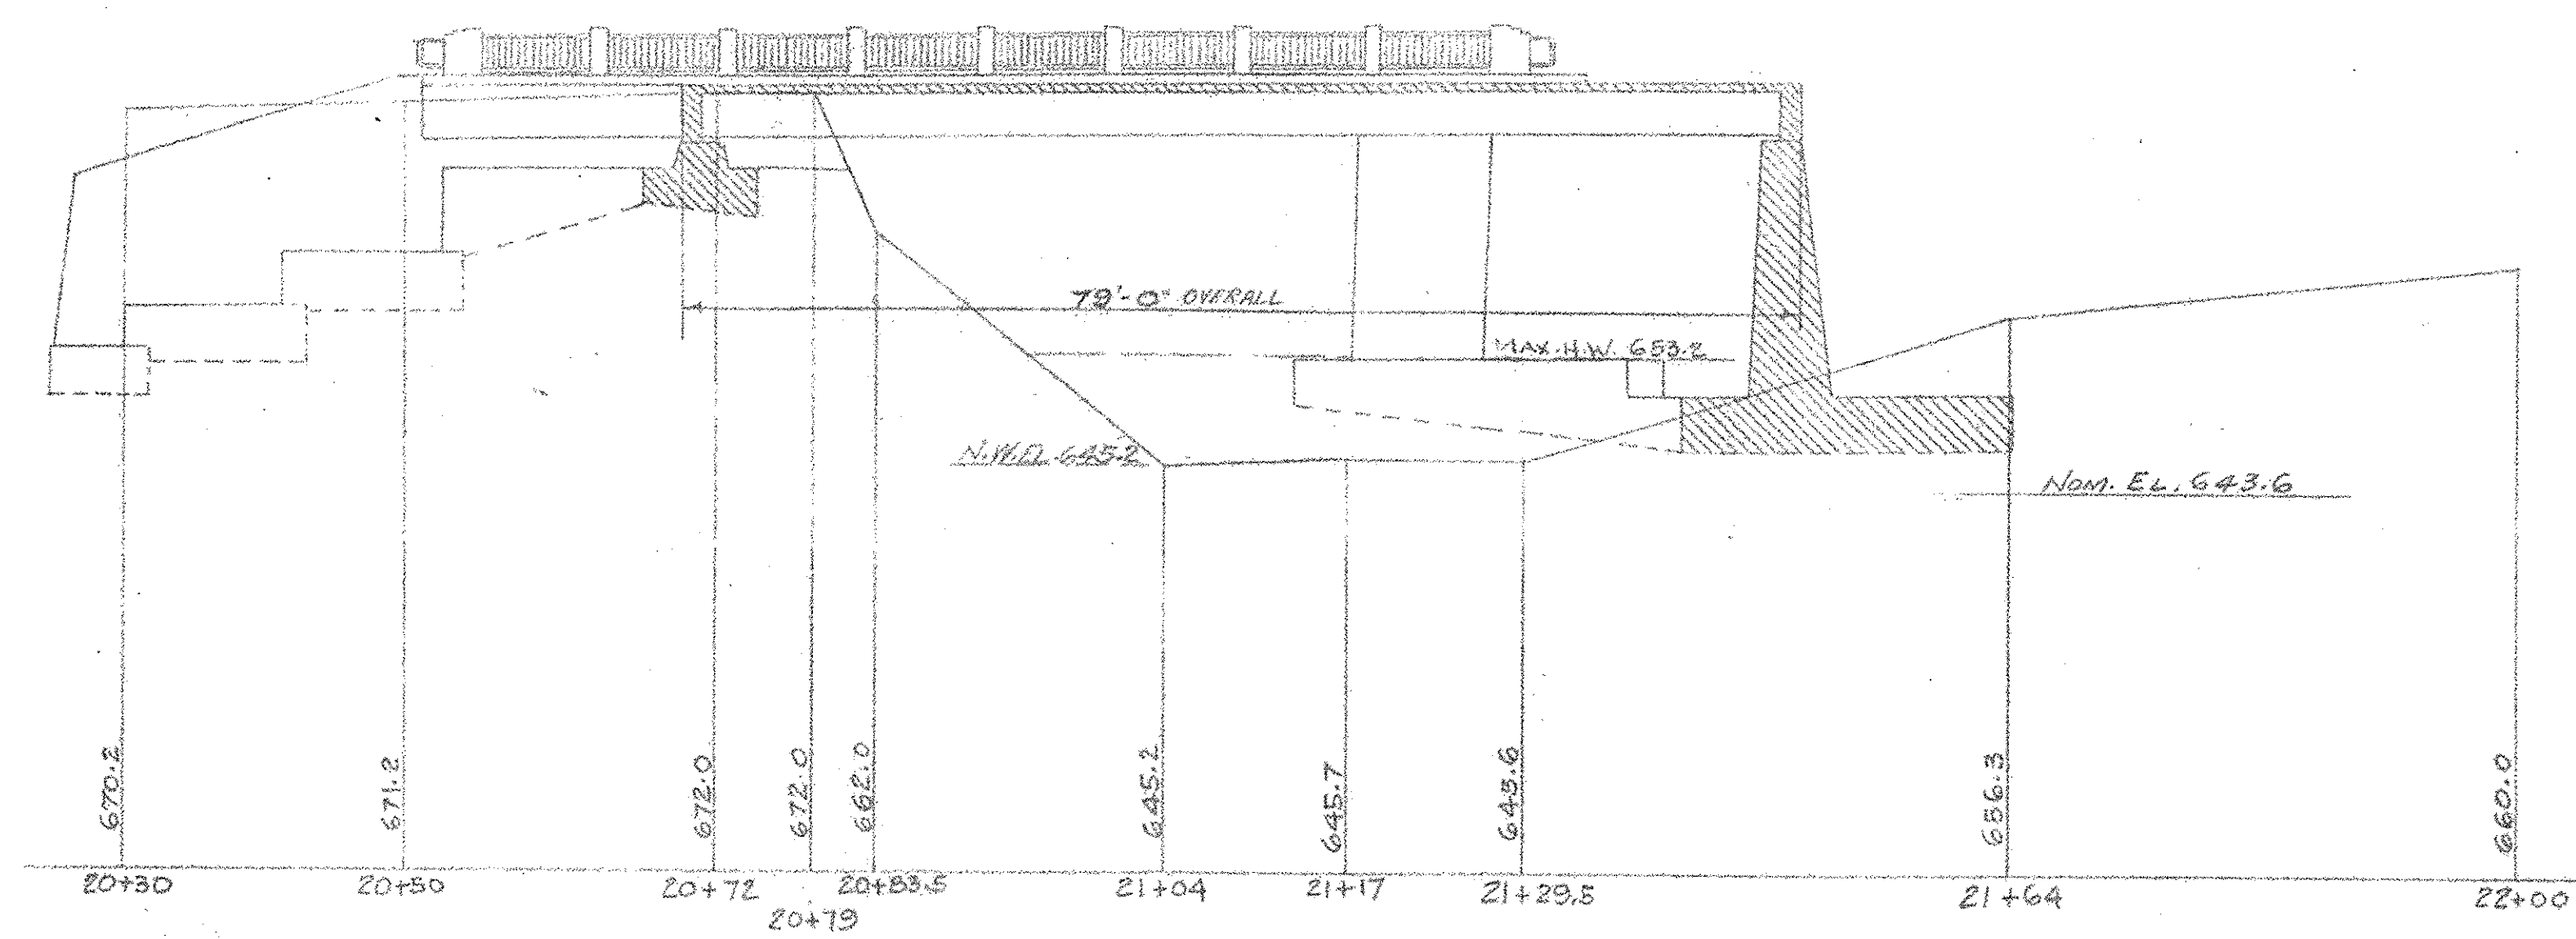

PROFILE ALONG C. OF BRIDGE

BRIDGE 25
FOR REFERENCE ONLY
SHEET 15 OF 16

BRIDGE PLAN & ELEVATION
THETFORD (POST MILLS)
ROUTE-113A
STA. 20+70-21+49 (Log. Sta. 392+32)

Surveyed by
Designed by
Drawn by *H.R.D. 7/50*
Traced by
Checked by *J.L.H.*
Series *5* No. *72(1)* Filed
Sheet *11* of *44* Sheets