









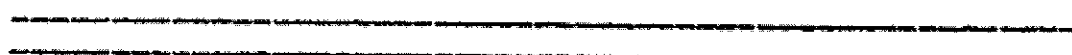








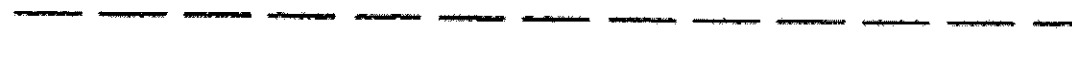


EAST OF THE JUNCTION OF VT ROUTE 100 AND U.S. ROUTE 4, IN THE TOWN OF BRIDGEWATER. BRIDGE 16 IS LOCATED ON VT ROUTE 103 OVER THE WILLIAMS RIVER, IN THE TOWN OF CHESTER, SOUTH OF THE JUNCTION OF VT ROUTE 10 AND VT ROUTE 103, IN THE TOWN OF BRIDGEWATER. BRIDGE 25 IS LOCATED ON VT ROUTE 113 OVER THE OMPOMPANOOSUC RIVER, IN THE TOWN OF BRIDGEWATER, SOUTH OF THE JUNCTION OF VT ROUTE 244 AND VT ROUTE 113, IN THE TOWN OF BRIDGEWATER.


PROJECT DESCRIPTION: THIS PROJECT INVOLVES CLEANING AND REPAINTING THE EXISTING BRIDGE AND ASSOCIATED WORK.

CONVENTIONAL SYMBOLS

COUNTY LINE	 COUNTY LINE
TOWN LINE	 TOWN LINE
LIMITS OF ACCESS	
POINT OF ACCESS	
FENCE LINE	
STONE WALL	
TRAVELED WAY	
GUARD RAIL	
RAILROAD	
SURVEY LINE	
CULVERT	
POWER POLE	
TELEPHONE POLE	
TREES	
CONTROL OF ACCESS	
PROPERTY LINE	
R.O.W. TAKING LINE	
SLOPE RIGHTS	
TOP OF CUT	
TOE OF SLOPE	

SURVEYED BY : N/A
 SURVEYED DATE : N/A

DATUM
 VERTICAL N/A
 HORIZONTAL N/A

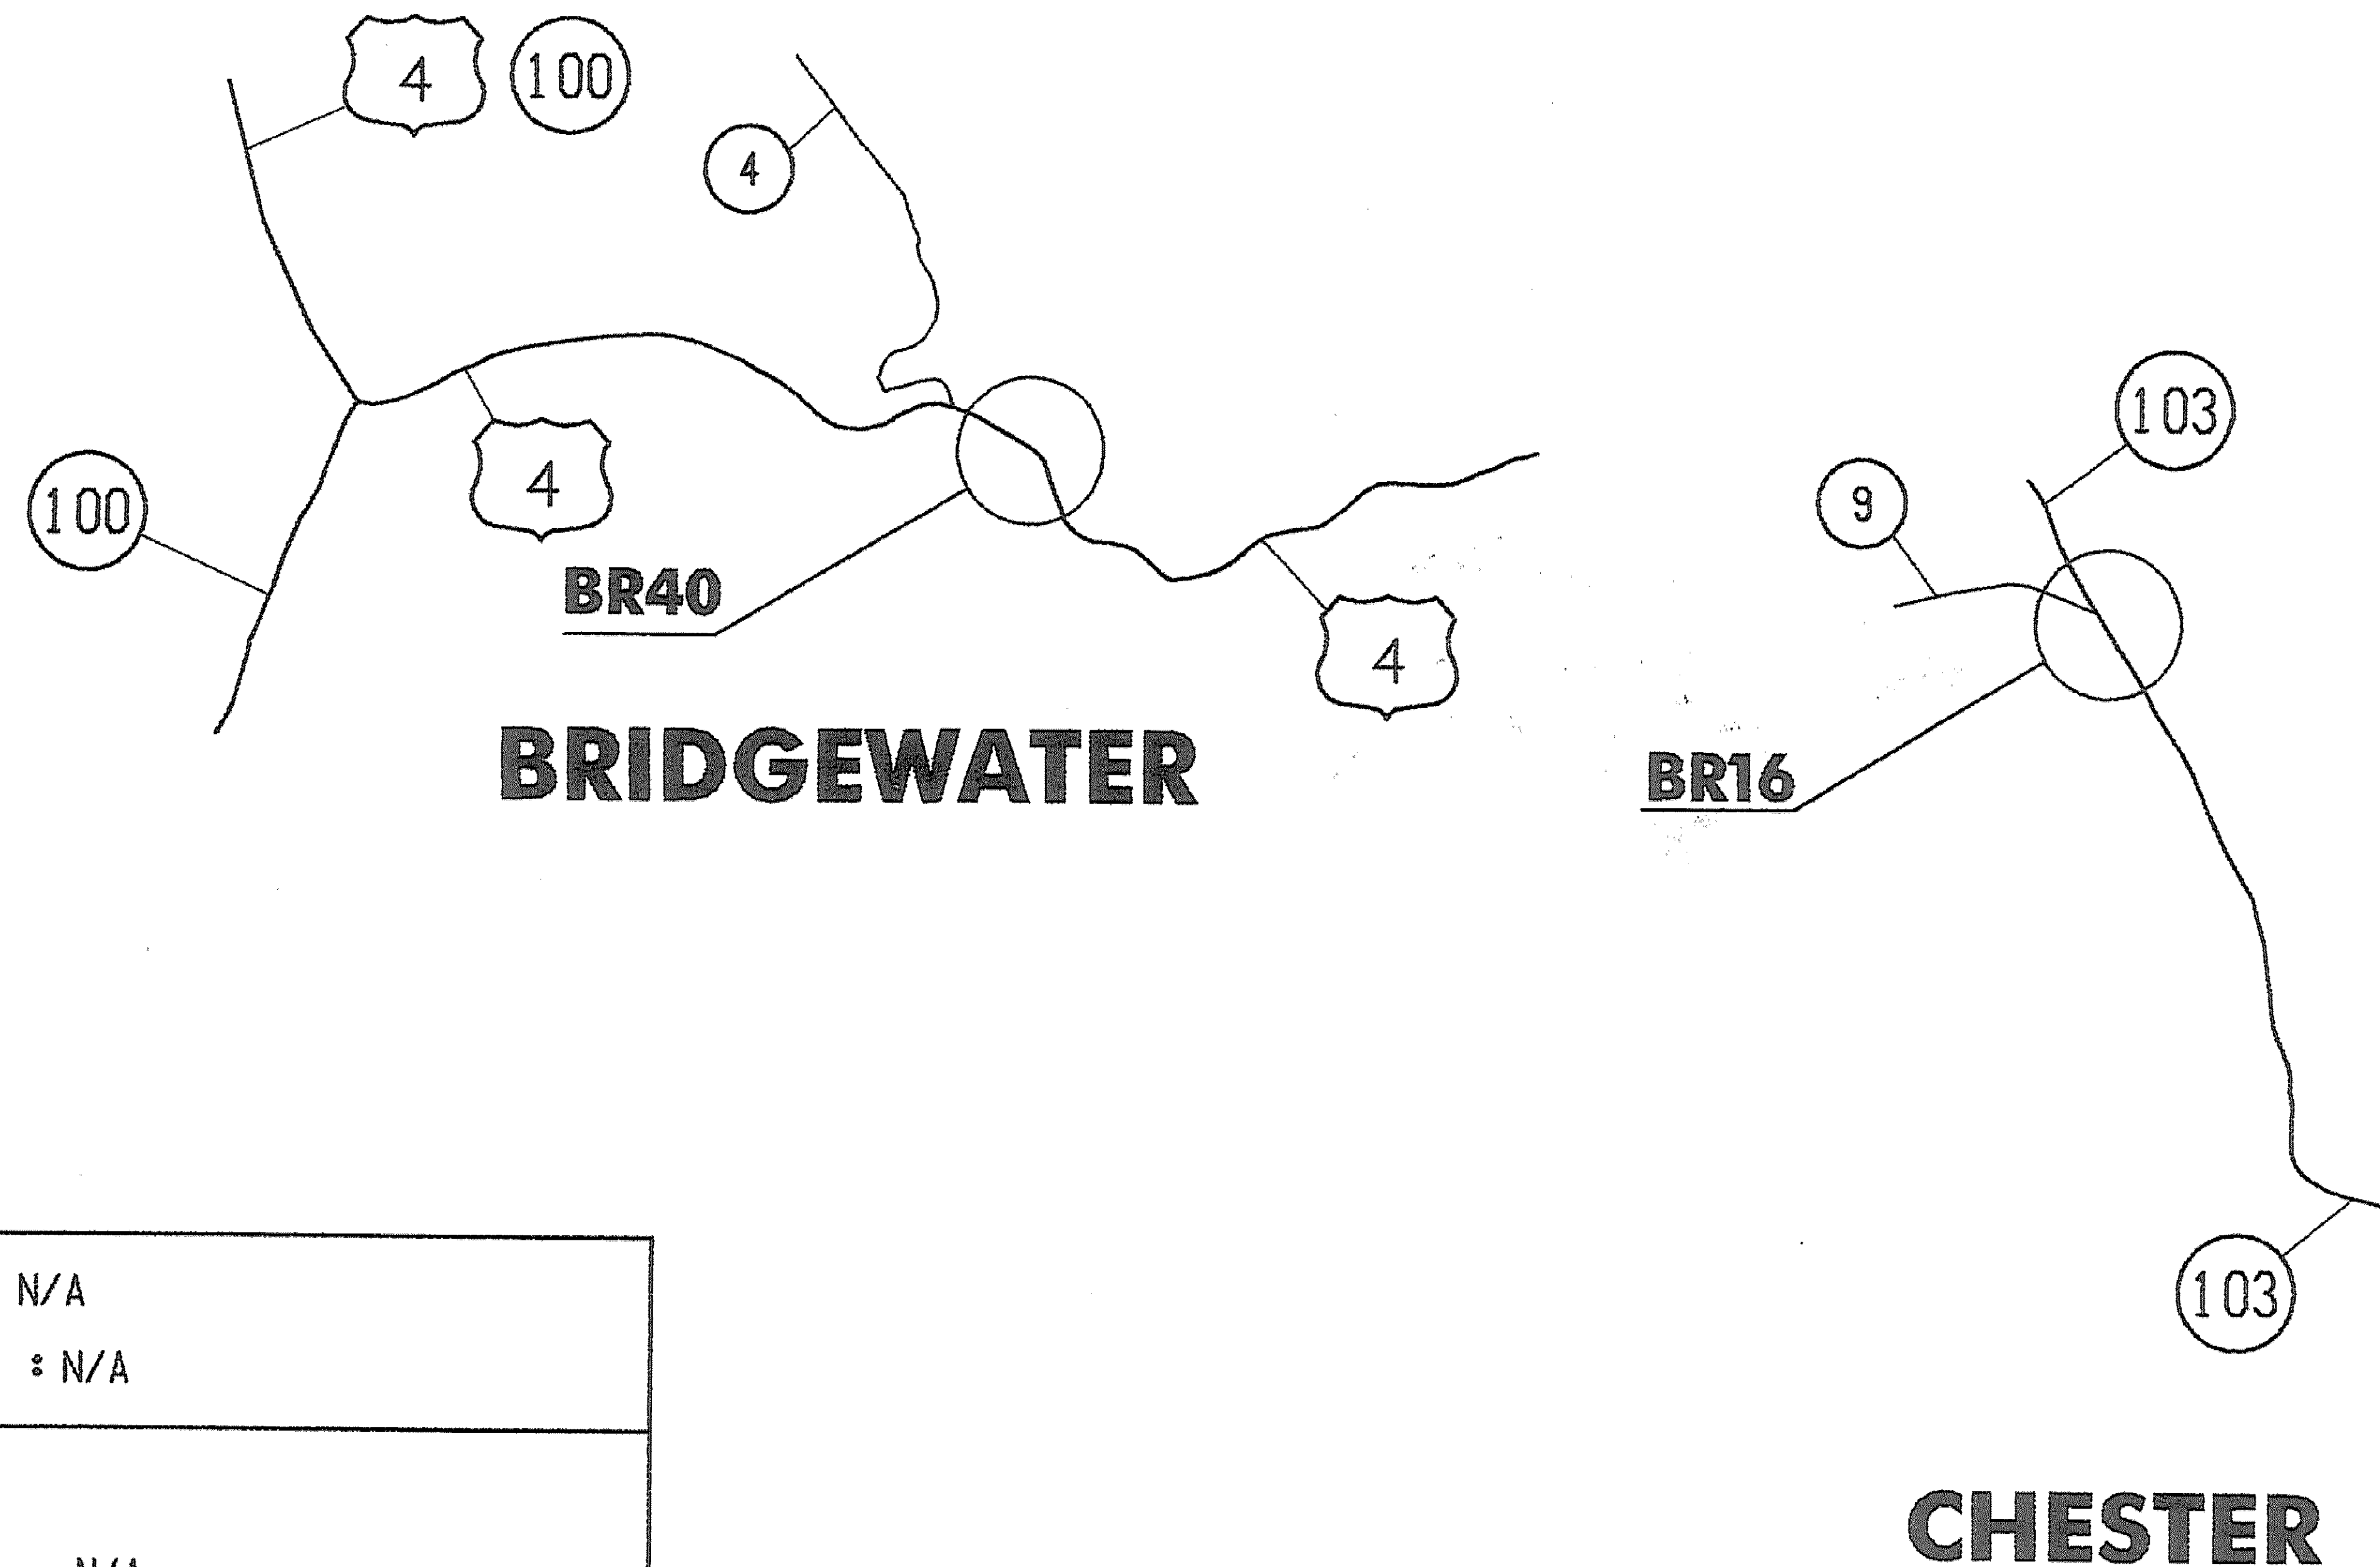

QUANTITY SHEET 1

SUMMARY OF ESTIMATED QUANTITIES										TOTALS		DESCRIPTIONS				DETAILED SUMMARY OF QUANTITIES		
							VT 103-BR. NO. 16	U.S. 4-BR. NO. 40	VT 113-BR. NO. 25	GRAND TOTAL	FINAL	UNIT	ITEMS	ITEM NUMBER	ROUND	QUANTITIES	UNIT	ITEMS
								1		1		LS	STRUCTURAL PAINTING, FIELD APPLIED (U.S. 4-BRIDGE NO. 40) (85 TONS)	513.30				
							1			1		LS	STRUCTURAL PAINTING, FIELD APPLIED (VT 103-BRIDGE NO. 16) (97 TONS)	513.30				
									1	1		LS	STRUCTURAL PAINTING, FIELD APPLIED (VT 113-BRIDGE NO. 25) (95 TONS)	513.30				
								1		1		LS	CONTAINMENT & ENVIRONMENTAL PROTECTION, FIELD (U.S. 4-BRIDGE NO. 40)	513.38				
							1			1		LS	CONTAINMENT & ENVIRONMENTAL PROTECTION, FIELD (VT 103-BRIDGE NO. 16)	513.38				
									1	1		LS	CONTAINMENT & ENVIRONMENTAL PROTECTION, FIELD (VT 113-BRIDGE NO. 25)	513.38				
								1		1		LS	SURFACE PREPARATION, FIELD (U.S. 4-BRIDGE NO. 40) (85 TONS)	513.41				
							1			1		LS	SURFACE PREPARATION, FIELD (VT 103-BRIDGE NO. 16) (97 TONS)	513.41				
									1	1		LS	SURFACE PREPARATION, FIELD (VT 113-BRIDGE NO. 25) (95 TONS)	513.41				
							400	400	240	1040		HR	FLAGGERS	630.16				
							0.34	0.33	0.33	1		LS	TESTING EQUIPMENT, PROTECTIVE COATINGS	631.18				
							0.87	0.37	0.28	1		LS	MOBILIZATION/DEMobilIZATION	635.11				
								1		1		LS	TRAFFIC CONTROL (U.S. 4-BRIDGE NO. 40)	641.10				
							1			1		LS	TRAFFIC CONTROL (VT 103-BRIDGE NO. 16)	641.10				
									1	1		LS	TRAFFIC CONTROL (VT 113-BRIDGE NO. 25)	641.10				
							2	2	2	8		EACH	PORTABLE CHANGEABLE MESSAGE SIGN	641.15				
									5	5		EACH	SPECIAL PROVISION (REMOVE AND REPLACE EXISTING BRIDGE RAILING SPINDLES)	900.820				
													TIE COAT APPLIED BETWEEN OLD PAINT AND NEW PAINT. THIS ITEM ADDED PER CHANGE ORDER.					



PROJECT NAME: BRIDGEWATER-CHESTER-THETFORD
 PROJECT NUMBER: ST BPNT(2)
 FILE NAME: ...Qty sheet.dgn
 PROJECT LEADER: C. BOGUE
 DESIGNED BY: S. BURBANK
 QUANTITY SHEET

PLOT DATE: 7/3/2008
 DRAWN BY: J. SOTER
 CHECKED BY: M. CHENETTE
 SHEET 2 OF 16

PROJECT NOTES

GENERAL


1. ALL MATERIALS AND CONSTRUCTION SHALL CONFORM TO STATE OF VERMONT, AGENCY OF TRANSPORTATION, 2006 STANDARD SPECIFICATIONS FOR CONSTRUCTION, AND ITS LATEST REVISIONS, AND THE AASHTO STANDARD SPECIFICATIONS FOR HIGHWAY BRIDGES, DATED 2002, AND ITS LATEST REVISIONS.
2. ALL WORK AND ANY ASSOCIATED ACTIVITY ON THIS PROJECT SHALL BE PERFORMED WITHIN THE EXISTING RIGHT-OF-WAY LIMITS. UNLESS SHOWN OTHERWISE ON REFERENCE PLANS, THE RIGHT-OF-WAY LIMIT SHALL BE ASSUMED TO BE 3 RODS.
3. CLEANING AND PAINTING ON BRIDGE 25 SHALL INCLUDE THE METAL BRIDGE RAILING ON BOTH SIDES OF THE BRIDGE. THE EXISTING PAINT SHALL BE REMOVED IN ITS ENTIRETY AND REPLACED WITH THE SAME PAINT SYSTEM USED ON THE SUPERSTRUCTURE STEEL.
4. PRIOR TO PAINTING THE METAL RAILING ON BRIDGE 25 THE EXISTING SPINDLES THAT ARE BENT OR CORRODED THROUGH SHALL BE REPLACED. REFER TO REFERENCE SHEET 14 OF 16 FOR EXISTING DETAILS. THE EXISTING SPINDLES SHALL BE REPLACED WITH $\frac{1}{2}$ " NOMINAL DIAMETER SCHEDULE 40 PIPE (ASTM A53 GRADE B). THE NEW SPINDLES SHALL BE FIELD WELDED TO THE EXISTING RAIL USING A $\frac{1}{4}$ " FILLET WELD AND THEN GROUND SMOOTH. REMOVAL AND REPLACEMENT OF BRIDGE RAILING SPINDLES WILL BE PAID FOR UNDER ITEM 900.620, "SPECIAL PROVISION (REMOVE AND REPLACE EXISTING BRIDGE RAILING SPINDLES)".

PROTECTIVE COATINGS

5. THE SURFACE PREPARATION OF THE EXISTING STEEL ON BRIDGES 16, 25 AND 40 SHALL INCLUDE PARTIAL REMOVAL OF THE EXISTING PAINT SYSTEM, SEE DETAIL THIS SHEET.
6. THE COLOR OF THE FINAL COAT OF PAINT SHALL BE GREEN CONFORMING TO SUBSECTION 708.03.
7. THE ENDS OF THE BEAMS AT THE PIERS ON BRIDGE NO. 16 (CHESTER) SHALL BE GREASE COATED IN ACCORDANCE WITH SUBSECTION 513.06(d)(1) OF THE SPECIFICATIONS.
8. CLEANING AND PAINTING OF ANY DOWNSPOUTS AND/OR ANY STEEL CONNECTORS FOR DRAIN TROUGHS SHALL BE INCLUDED AS PART OF THE WORK.

TRAFFIC CONTROL

9. UNLESS COVERED UNDER INDIVIDUAL PAY ITEMS, ALL COSTS FOR TEMPORARY TRAFFIC CONTROL DEVICES INCLUDING RETROREFLECTIVE DRUMS, SIGNS, AND SIGN POSTS WILL BE CONSIDERED TO BE INCLUDED IN THE CONTRACT LUMP SUM PRICE FOR TRAFFIC CONTROL, ITEM 641.00.

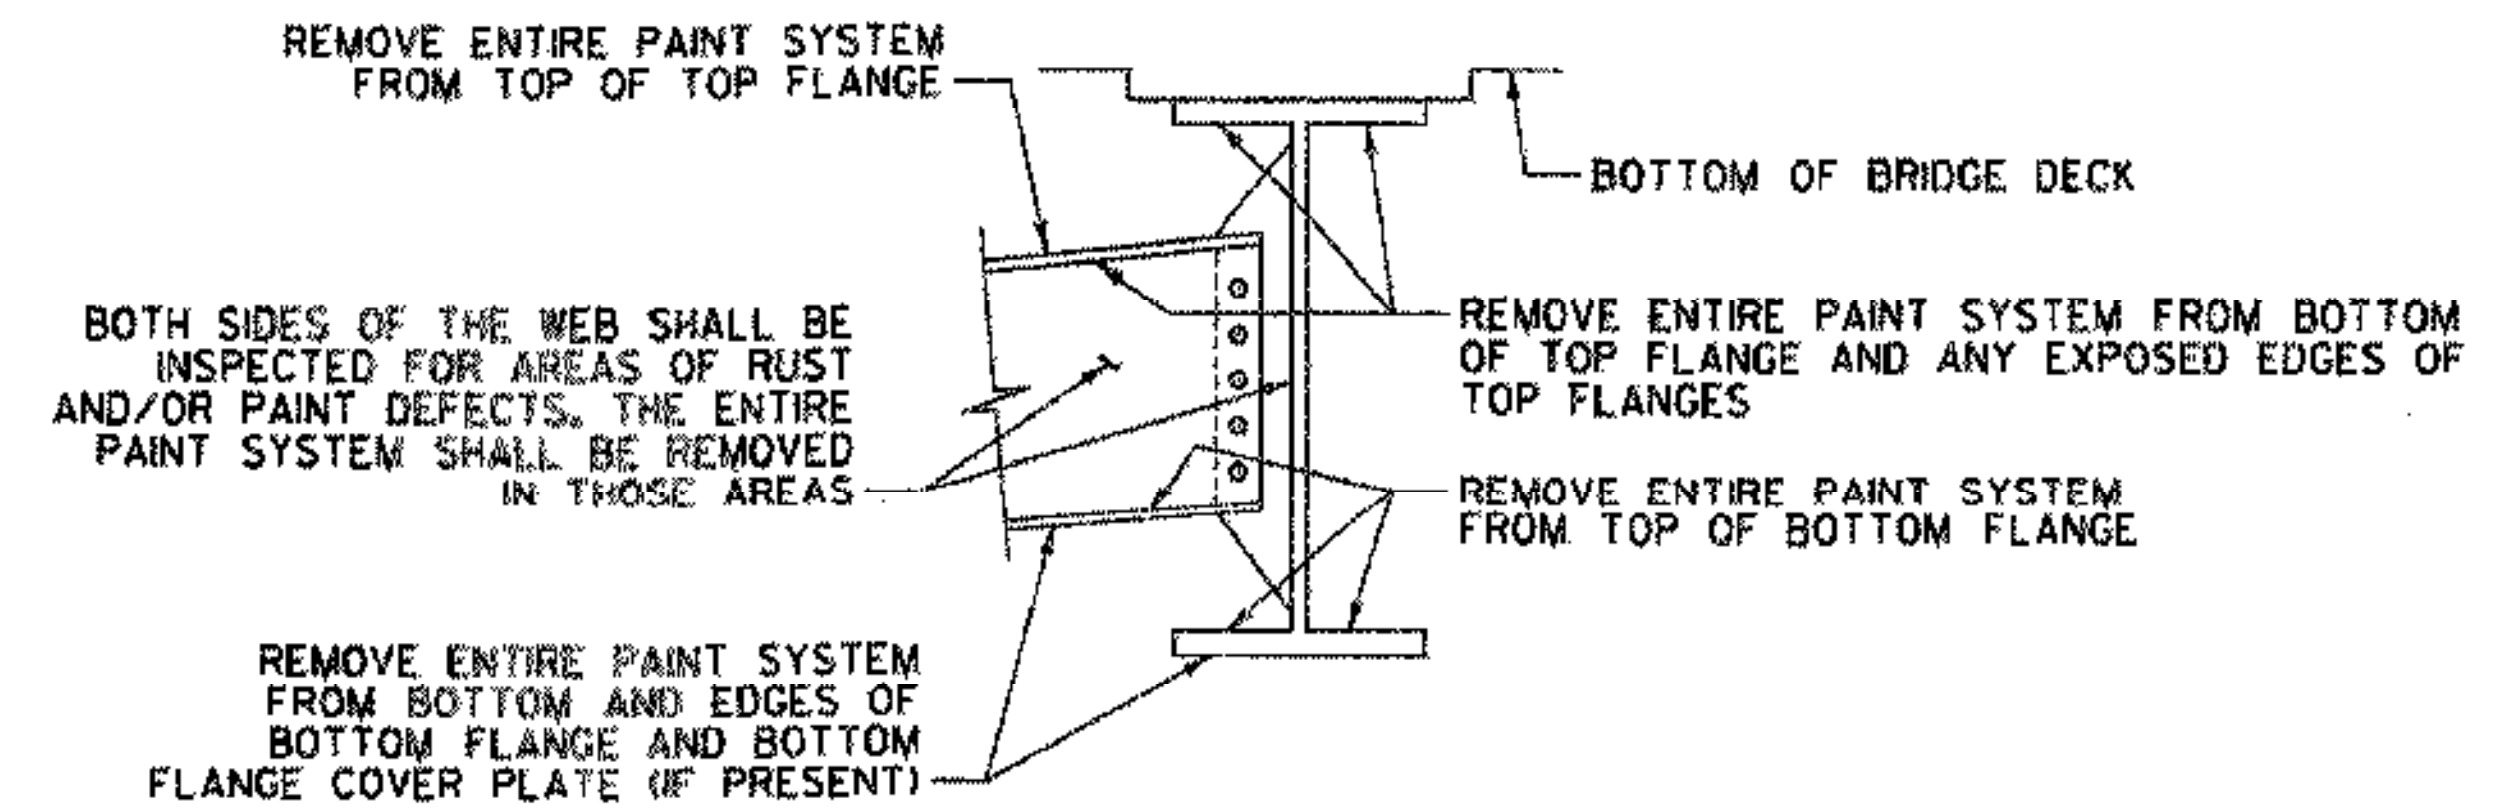

NOTE: AREAS WHERE THE PAINT SYSTEM HAS BEEN COMPLETELY REMOVED SHALL RECEIVE A PRIMER AND INTERMEDIATE COAT OF PAINT. THE FINAL COAT OF PAINT SHALL BE PLACED ON ALL OF THE STEEL SURFACES.


AREAS OF PAINT REMOVAL FOR BRIDGES 16, 25 & 40

NOT TO SCALE

TIE COAT APPLIED BETWEEN OLD PAINT AND NEW PAINT. THIS ITEM ADDED PER CHANGE ORDER.



PROJECT NAME:	BRIDGEWATER-CHESTER-THETFORD
PROJECT NUMBER:	ST BPNT(2)
FILE NAME:	\\Bridge.Chest.The\Notes.dgn
DATE:	7/3/2008
PROJECT LEADER:	G. BOGUE
DRAWN BY:	J. SOTER
DESIGNED BY:	S. BURBANK
CHECKED BY:	M. CHENETTE
PROJECT NOTES AND DETAILS	SHEET 4 OF 16

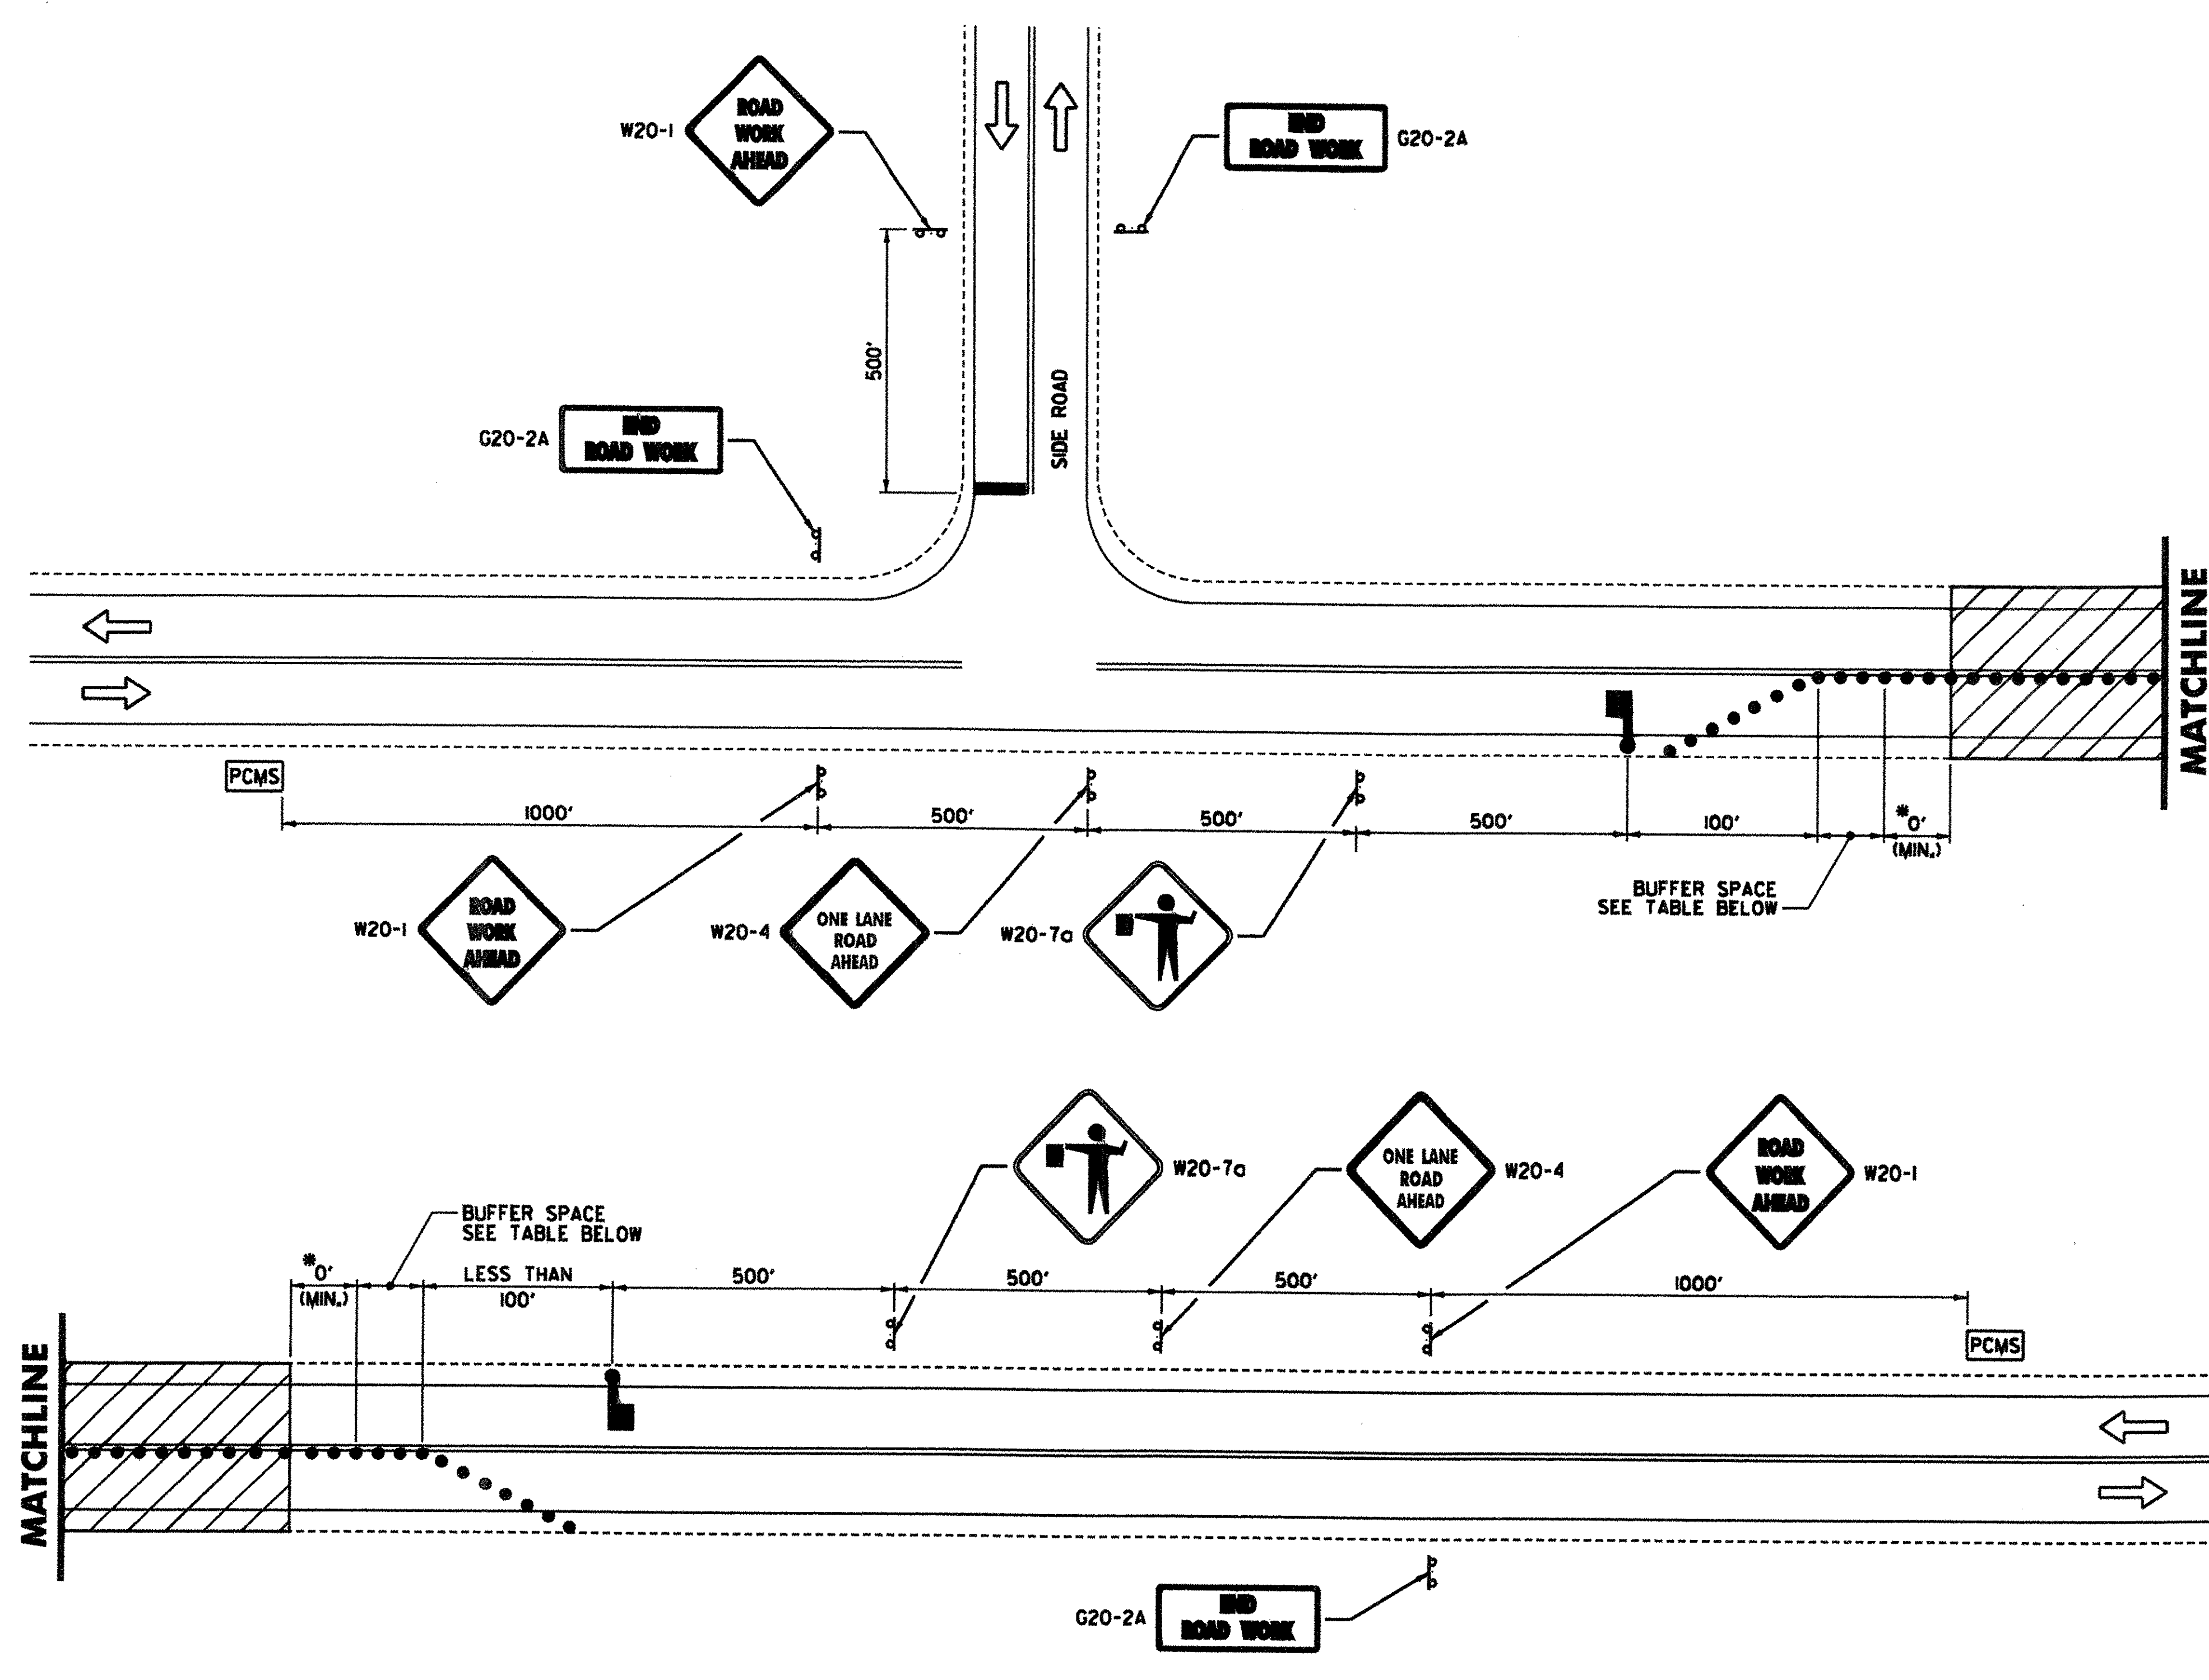

* - ACTUAL DIMENSION TO BE DETERMINED BY INDIVIDUAL BRIDGE SITE CONDITIONS AND TO BE SHOWN ON TRAFFIC CONTROL PLANS SUBMITTED BY THE CONTRACTOR.

TRAFFIC CONTROL PLAN
NOT TO SCALE

BUFFER SPACE TABLE

POSTED SPEED (MPH)	MINIMUM BUFFER SPACE LENGTH (FT)
35	250
40	305
45	360
50	425

LEGEND

- FLOW OF TRAFFIC
- RETROREFLECTIVE PLASTIC DRUM
- WORK AREA
- FLAGGER
- PORTABLE CHANGEABLE MESSAGE SIGN

GENERAL NOTES:

1. THE TRAFFIC CONTROL PLAN SHOWN IS A SCHEMATIC ONLY AND SHOULD BE USED AS A REFERENCE. THE CONTRACTOR SHALL SUBMIT A SITE SPECIFIC TRAFFIC CONTROL PLAN FOR EACH BRIDGE TO VTRANS FOR APPROVAL. PAYMENT FOR PREPARING AND SUBMITTING THE TRAFFIC CONTROL PLAN, AND MAKING ANY NECESSARY REVISIONS TO THE PLAN, WILL BE INCLUDED IN THE UNIT PRICE BID FOR CONTRACT ITEM 641.0. THE CONTRACTOR SHALL ALLOW TWO WEEKS FOR APPROVAL OF THE TRAFFIC CONTROL PLAN. NO WORK SHALL COMMENCE UNTIL THE CONTRACTOR HAS AN APPROVED TRAFFIC CONTROL PLAN.
2. ANY PARKING AREAS OR DRIVES WITH AN ENTRANCE/EXIT BETWEEN THE FLAGGER AND THE WORK ZONE SHALL HAVE THAT ENTRANCE/EXIT CLOSED WITH CONES OR DRUMS. PROVIDED ADDITIONAL ENTRANCES/EXITS EXIST IN THE AREA APPROACHING THE FLAGGER.
3. ANY PUBLIC HIGHWAYS BETWEEN THE FLAGGER AND THE WORK ZONE WILL REQUIRE AN ADDITIONAL FLAGGER TO MAINTAIN TRAFFIC CONTROL FOR THE PUBLIC HIGHWAY.
4. SIGNS SHALL BE INSTALLED SO AS NOT TO OBSTRUCT EXISTING SIGNS OR CORNER SIGHT DISTANCE FROM TOWN HIGHWAYS OR DRIVES.
5. ALL SIGNS SHALL BE IN ACCORDANCE WITH THE CURRENT EDITIONS OF THE "MANUAL ON UNIFORM TRAFFIC CONTROL DEVICES" (MUTCD) AND THE "STANDARD HIGHWAY SIGNS" BOOK (SHS) PUBLISHED BY THE FEDERAL HIGHWAY ADMINISTRATION (FHWA).
6. SOLID SUBSTRATE CONSTRUCTION SIGNS SHALL HAVE RETROREFLECTIVE SHEETING EQUAL TO OR EXCEEDING "AMERICAN SOCIETY FOR TESTING AND MATERIALS" (ASTM) TYPE VII, VIII OR IX REQUIREMENTS, UNLESS OTHERWISE NOTED.
7. ROLL UP SIGNS SHALL HAVE RETROREFLECTIVE SHEETING EQUAL TO OR EXCEEDING ASTM TYPE VI.
8. SIGNS SHALL BE ERECTED BEFORE THE START OF ANY WORK AND SHALL BE COVERED UNTIL WORK COMMENCES, DURING PERIODS OF INACTIVITY OR UPON COMPLETION OF THE WORK. EACH SIGN SHALL BE ERECTED IN A NEAT AND WORKMANLIKE MANNER. SIGNS SHALL BE REMOVED UPON COMPLETION OF THE WORK AT THE DISCRETION OF THE ENGINEER.
9. FIXED SIGNS SHALL BE SET SECURELY IN THE GROUND. THE BOTTOM OF A SIGN SHALL BE AT LEAST SEVEN FEET ABOVE THE EDGE OF PAVEMENT. THE NEAREST EDGE OF A SIGN SHALL BE AT LEAST SIX FEET OUTSIDE THE SHOULDER POINT OR FOUR FEET OUTSIDE GUARDRAIL.
10. PORTABLE SIGNS SHALL BE PLACED ON THE EDGE OF ROADWAY AND A ONE FOOT MINIMUM ABOVE TRAVELED WAY. ALL VEGETATION THAT INTERFERES WITH VISIBILITY OF THE SIGNS SHALL BE REMOVED. WHEN PLACED BEHIND GUARDRAIL, THE BOTTOM OF THE SIGN FACE SHALL BE ABOVE THE TOP OF THE GUARDRAIL.
11. WHERE SIGN INSTALLATIONS ARE NOT PROTECTED BY GUARDRAIL OR OTHER APPROVED TRAFFIC BARRIERS, ALL SIGN STANDS AND POST INSTALLATIONS SHALL BE "NATIONAL COOPERATIVE HIGHWAY RESEARCH PROGRAM" (NCHRP) REPORT 350 COMPLIANT. NO SIGN POSTS SHALL EXTEND OVER THE TOP OF THE SIGN INSTALLED ON SAID POST(S). WHEN ANCHORS ARE INSTALLED STUB SHALL NOT BE GREATER THAN FOUR INCHES ABOVE EXISTING GROUND.
12. THE NUMBER OF CHANNELIZING DEVICES SHOWN ARE FOR ILLUSTRATIVE PURPOSES ONLY. THE ACTUAL NUMBER REQUIRED ARE TO BE DETERMINED BY THE CONTRACTOR AND SHOWN ON THE TRAFFIC CONTROL PLAN SUBMITTED BY THE CONTRACTOR. WARNING LIGHTS SHALL NOT BE USED ON CHANNELIZING DEVICES.
13. THE PORTABLE CHANGEABLE MESSAGE SIGNS (PCMS'S) SHALL BE USED AT THE DISCRETION OF THE ENGINEER. THE PCMS SHALL BE USED IN ACCORDANCE WITH SECTION 6F.55 OF THE MUTCD. THE PCMS'S SHALL READ "ONE WAY TRAFFIC AHEAD BE PREPARED TO STOP".
14. THE CONTRACTOR MAY REDUCE TRAFFIC TO ONE LANE DURING WORKING HOURS IN ACCORDANCE WITH AN APPROVED TRAFFIC CONTROL PLAN. ALL EQUIPMENT SHALL BE MOVED TO A LOCATION OFF PAVED SHOULDERS DURING NON-WORK PERIODS, AND PROTECTED BY BARRELS OR CONES. NORMAL TRAFFIC LANES SHALL BE RESTORED DURING NON-WORK PERIODS AND TEMPORARY TRAFFIC SIGNS REMOVED OR COVERED. PAYMENT FOR THIS WORK WILL BE INCLUDED IN THE UNIT PRICE BID FOR CONTRACT ITEM 641.0.





PROJECT NAME: BRIDGEWATER-CHESTER-THETFORD
 PROJECT NUMBER: ST BPNT(2)
 FILE NAME: ...Bridge_Chest_The_TCP_Ldgn.PLOT DATE: 7/3/2008
 PROJECT LEADER: G. BOGUE DRAWN BY: J. SOTER
 DESIGNED BY: S. BURBANK CHECKED BY: M. CHENETTE
 TRAFFIC CONTROL PLAN SHEET 3 OF 16

INDEX OF SHEETS

SHEET NO	TITLE PAGE
1	TYPICAL CROSS-SECTION OF IMPROVEMENT 3" BITUMINOUS CONCRETE PAVEMENT, ITEM 361-D. MOD.
2	QUANTITY SHEET (ITEMS)
3	QUANTITY SHEET (DRAINAGE)
4	EARTHWORK SHEETS
5-7	PLAN AND PROFILE SHEETS
8-24	DETAILS OF 76" C.G.M.R.P. (STA. 238+07.5)
25	A-61 DRILLING AND BLASTING OF SOLID ROCK SUBGRADE
26	B-1 BANKING TABLES
27	B-5 TYPICAL SLOPE GRADING
28	B-12 SIDE ROAD INTERSECTION
29	B-13 DRIVES
30	D-1 PRECAST R.C.P. DROP INLETS
31	D-2 CEMENT RUBBLE MASONRY
32	D-4 FLUSHING BASINS
33	E-1 BARRICADES, SIGNS AND LIGHTS
34	E-9 FEDERAL AID CONSTRUCTION IDENTIFICATION SIGNS
35	G-3 THREE CABLE GUARD RAIL WITH STEEL POSTS
36	G-4 MARKER POSTS-PLANK GUARD RAIL
37	J-1 PROJECT AND BOUNDARY MARKERS
38	PRELIMINARY INFORMATION SHEET (BRIDGE AT STA. 223+60.5)
39	GENERAL PLAN ELEVATION, PROFILE & SECTIONS
40	BORING LOGS, FRAMING PLAN AND SECTION
41	DETAILS OF ABUTMENT NO. 1
42	DETAILS OF ABUTMENT NO. 2
43	DETAILS OF ABUTMENT NO. 2
44	APPROACH SLAB
45	REINFORCING STEEL SCHEDULE
46	PRELIMINARY INFORMATION SHEET (BRIDGE AT STA. 255+50)
47	GENERAL PLAN ELEVATION, PROFILE AND SECTIONS
48	BORING LOGS, FRAMING PLAN AND SECTION
49	DETAILS OF ABUTMENT NO. 1
50	DETAILS OF ABUTMENT NO. 2
51	DETAILS OF PIER
52	APPROACH SLAB
53	REINFORCING STEEL SCHEDULE
54	SCB-30-58 (SHEET 1) SUPERSTRUCTURE
55	SCB-30-58 (SHEET 2) SUPERSTRUCTURE
55A	SB-5G-57 (SHEET 1) BRIDGE RAILING
56	SB-5G-57 (SHEET 2) BRIDGE RAILING
56A	SB-20-56 BEARINGS AND DIAPHRAGM
57	SB-AS-57 (15° SKEW) APPROACH SLAB
58	SB-AS-57 (45° SKEW MOD.) APPROACH SLAB
59	SB-22-58 EXPANSION JOINT DETAILS
60	CROSS SECTIONS
61-125	CHANNEL SECTIONS (STA. 223+44.2)
126-134	CHANNEL SECTIONS (STA. 255+06.4)
135-141	CHANNEL SECTIONS (STA. 255+06.4)

STATE OF VERMONT
DEPARTMENT OF HIGHWAYS
Proposed Improvement
FEDERAL AID PROJECT
TOWN OF BRIDGEWATER
COUNTY OF WINDSOR
U.S. ROUTE 4
RUTLAND-WHITE RIVER JCT. ROAD

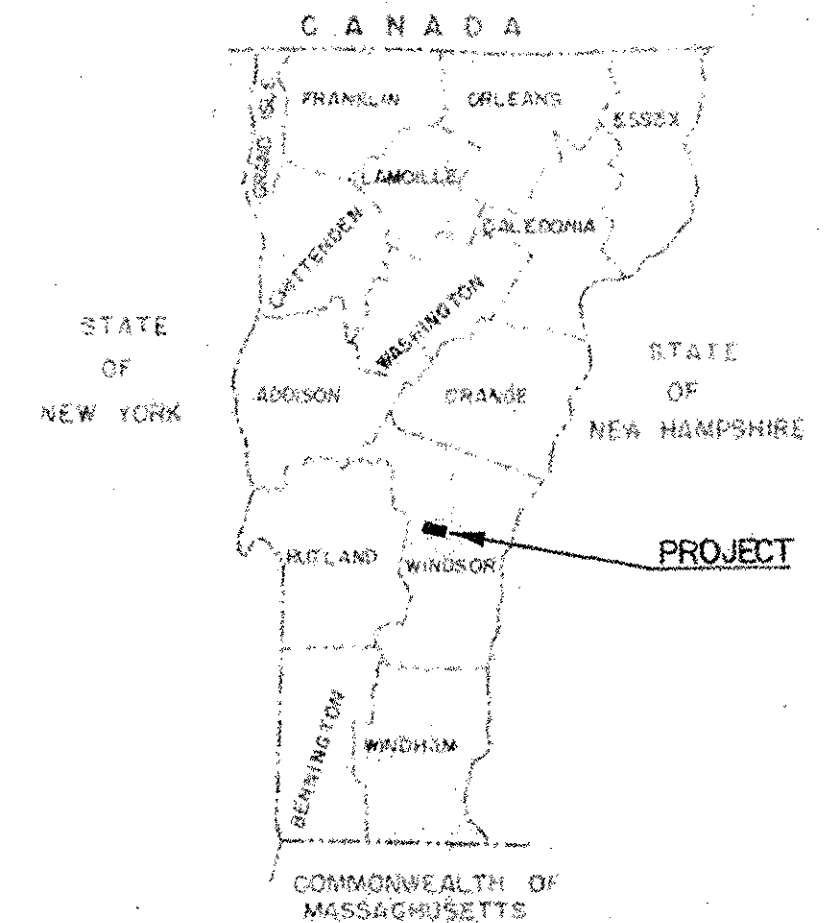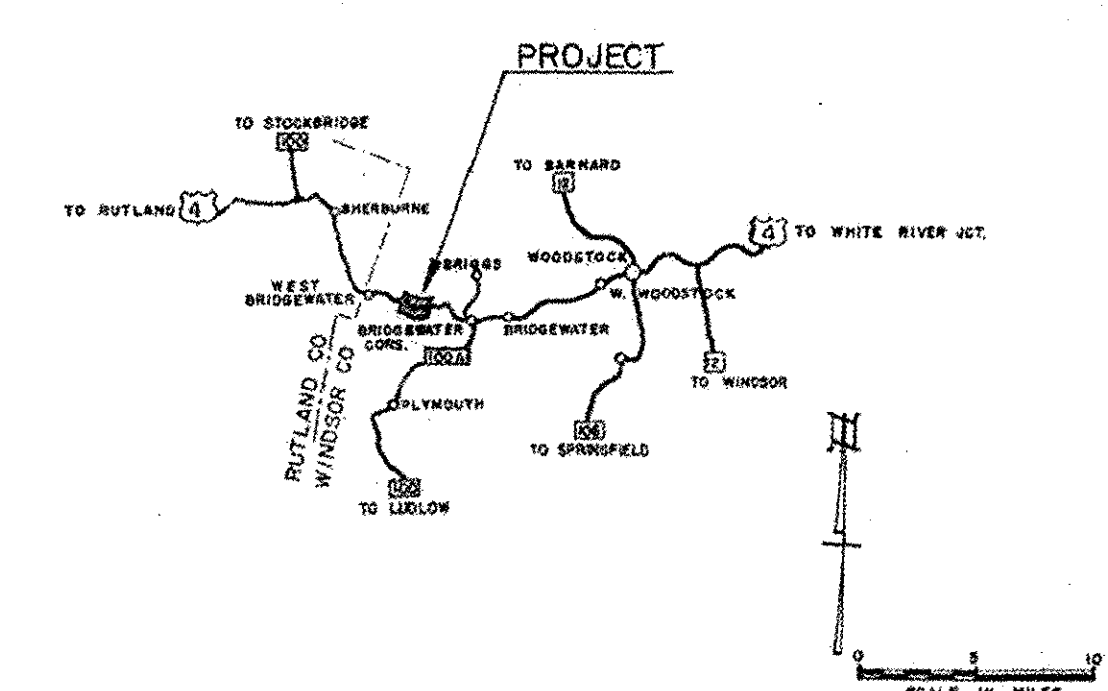


BEGINNING AT A POINT 11,231.1 FEET EASTERLY OF THE
SHERBURNE-BRIDGEWATER TOWN LINE AND EXTENDING
EASTERLY 11,121.3 FEET.

LENGTH OF ROADWAY 10,854.3 FEET = 2.056 MILES
LENGTH OF BRIDGES 267.0 FEET = 0.050 MILE
LENGTH OF PROJECT 11,121.3 FEET = 2.106 MILES

ADT 1960	1300
ADT 1980	2550
DHV 1980	360
D	58%
T	10%
V	50 MPH

PROJECT NAME & NUMBER	TYPE	PAVEMENT	AREA
BRIDGEWATER F 020-2(5)	BIT. CONC. PAVM'T.		32,536 S.Y.
RECORD PLANS			
MATERIALS			
GRANULAR BORROW- ERNEST ADAMS - BRIDGEWATER, VERMONT.			
SUB-BASE OF GRAVEL & SUB-BASE OF SAND-EDGAR PIT-SHERBURNE, VT.			
SUB-BASE OF CRUSHED ROCK & PENETRATION MACADAM CRUSHED STONE			
BASE COURSE- FARMERS LIME CO.-BRIDGEWATER, VERMONT.			
REFINED TAR & CUTBACK ASPHALT-ALLSTATES ASPHALT CO.-SUNDERLAND, MASS.			
TAR EMULSION-KOPPERS CO.- EVERETT, MASS.			
ASPHALT GEMENT- ALL STATES ASPHALT CO.- SUNDERLAND, MASS.			
BITUMINOUS CONCRETE-L.M. PIKE & SON INC. (WLEBANON PLANT) LACONIA, N.H.			
REINFORCING & STRUCTURAL STEEL-BETHLEHEM STEEL CO.-BETHLEHEM, PA.			
& STEEL PILING			
REINFORCED CONCRETE PIPE-AMERICAN MARIETTA CO.-WINDSOR, VT.			
ASPH. LTD. CORR. GALV. METAL PIPE-NEW ENGLAND METAL CULVERT			
CO.- WHITE RIVER JUNCTION, VERMONT.			
THREE CABLE GUARD RAIL, STEEL GUIDE & MARKER POSTS-			
-S.T. GRISWOLD & CO. INC.- ESSEX JUNCTION, VT.			
BRIDGE RAILING- WARD-WELLER CO. INC.-NEWTON LOWER FALLS,			
MASS.			
GRANITE BRIDGE CURB-BARRETTO GRANITE-MILFORD, N.H.			
CONTRACTOR-S.V. ROSSI CONST. CO. INC. TORRINGTON, CONN.			
RESIDENT ENGINEER- PAUL J. JETTE.			
INSPECTORS-A. DAVIS, C. HARPAN, E. NEWTON & T. BIRT.			
RECORD PLANS- PAUL J. JETTE.			
CONTRACT : DATED- APRIL 18, 1961.			
STARTED- MAY 3, 1961.			
COMPLETED- OCTOBER 31, 1962.			
ACCEPTED- OCTOBER 31, 1962.			

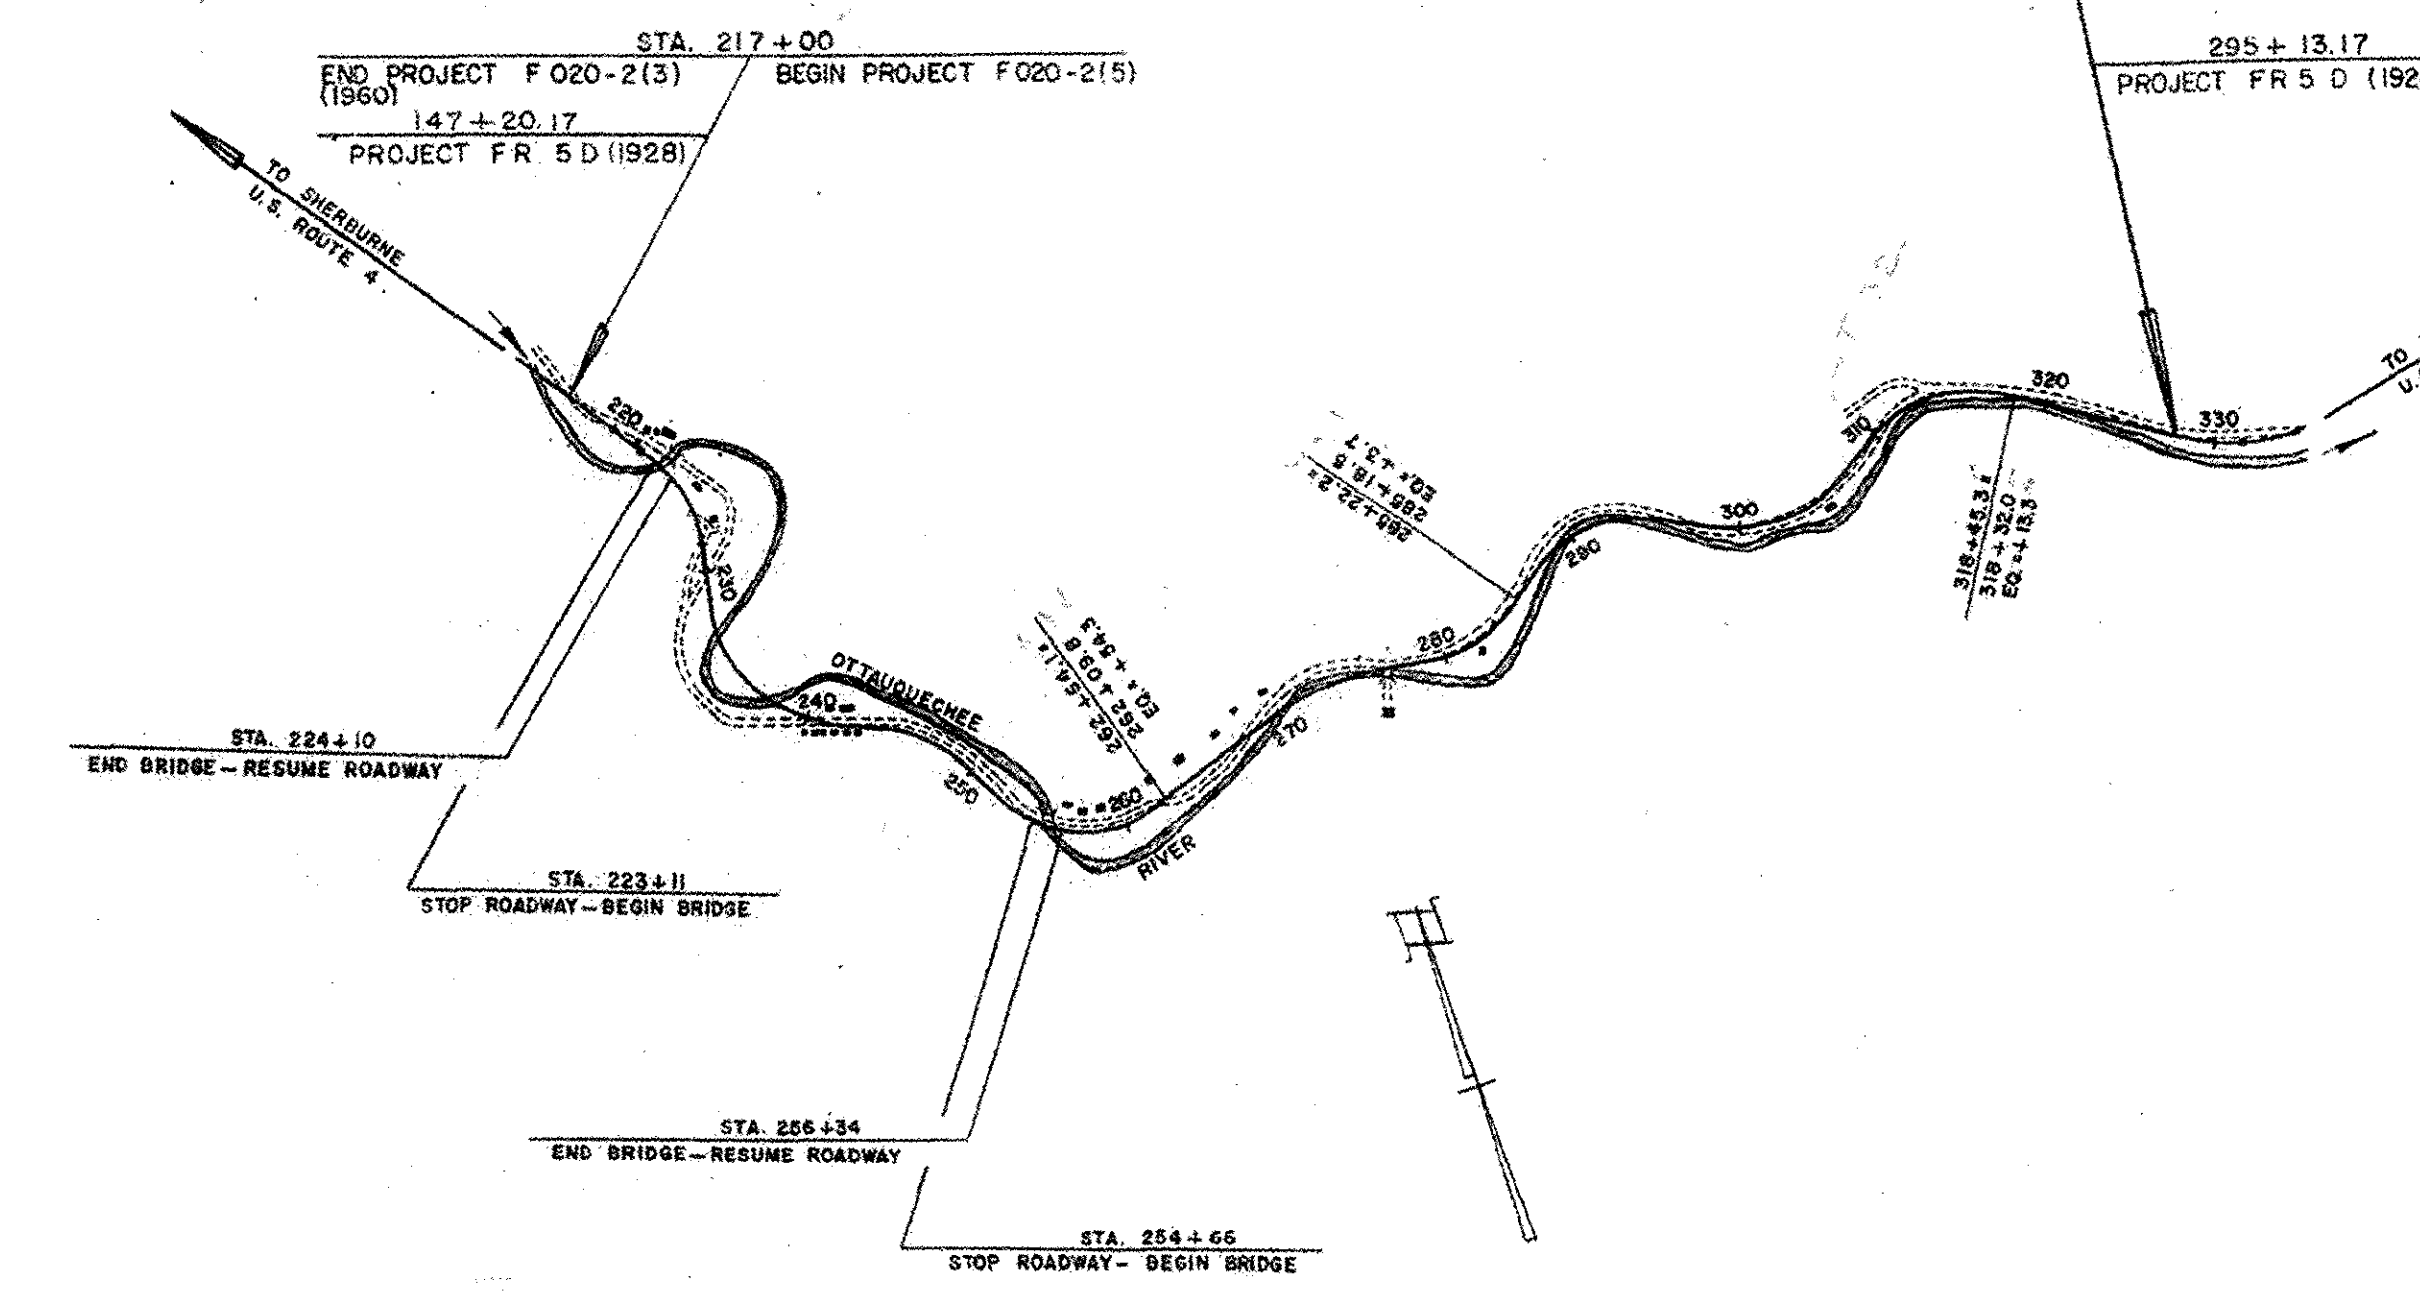

CONTRACTOR-S.V. ROSSI CONST. CO. INC. TORRINGTON, CONN.
RESIDENT ENGINEER- PAUL J. JETTE.
INSPECTORS-A. DAVIS, C. HARPAN, E. NEWTON & T. BIRT.
RECORD PLANS- PAUL J. JETTE.

BRIDGE 40
FOR REFERENCE ONLY
SHEET 5 OF 16

PROJECT	BRIDGEWATER
NUMBER	F 020-2(5)
TYPE	BRIDGE
CONTRACTOR	S.V. ROSSI CONST. CO. INC.
LOCATION	BRIDGEWATER, VERMONT
DATE	1961
BY	PAUL J. JETTE
CHECKED	PAUL J. JETTE
APPROVED	PAUL J. JETTE
DATE	1961
REVISIONS	
NO.	
DATE	
DESCRIPTION	
BY	
CHECKED	
APPROVED	
DATE	

SCALE	DESCRIPTION
1" = 100'	TITLE
1" = 2'	TYPICAL
1" = 50'-20"	PLAN
1" = 50'	PROFILE HORIZONTAL
1" = 10'	PROFILE VERTICAL
1" = 5' 8 10"	CROSS-SECTIONS

APPROVED	SECONDARY ENGINEER
DATE	

APPROVED *E. W. Stebbins*
CONSTRUCTION ENGINEER
DATE 28 Sept. 1959

APPROVED *G. D. Bradley*
BRIDGE ENGINEER
DATE 28 Sept. 1959

APPROVED *G. K. Perkins*
DISTRICT ENGINEER
DATE 25 Sept. 1959


APPROVED *G. M. Lane*
HIGHWAY ENGINEER
DATE 29 Sept. 1959

APPROVED *H. E. Jetté*
CHIEF ENGINEER
DATE 29 Sept. 1959
SUBMITTED BY ORDER OF THE STATE HIGHWAY BOARD


THESE PLANS ARE SUBJECT TO SUCH REVISIONS AS MAY BE
REQUIRED BY THE BUREAU OF PUBLIC ROADS OR THE COMMISSIONER
OF HIGHWAYS.

CONSTRUCTION IS TO BE CARRIED ON IN ACCORDANCE WITH
THE PLANS AND THE STANDARD SPECIFICATIONS FOR HIGHWAY AND BRIDGE
CONSTRUCTION OF JANUARY 1956 SUBMITTED TO THE BUREAU OF
PUBLIC ROADS AS APPROVED JULY 5, 1956, INCLUDING ALL SUBSEQUENT
APPROVED REVISIONS AND SUCH REVISED SPECIFICATIONS AND SPECIAL
PROVISIONS AS ARE SUBMITTED WITH THE PLANS.


DEPARTMENT OF COMMERCE BUREAU OF PUBLIC ROADS	
APPROVED	DATE
DIVISION ENGINEER	DATE
PROJECT	F NO. 020-2 (5)
SHEET	5 OF 141 SHEETS

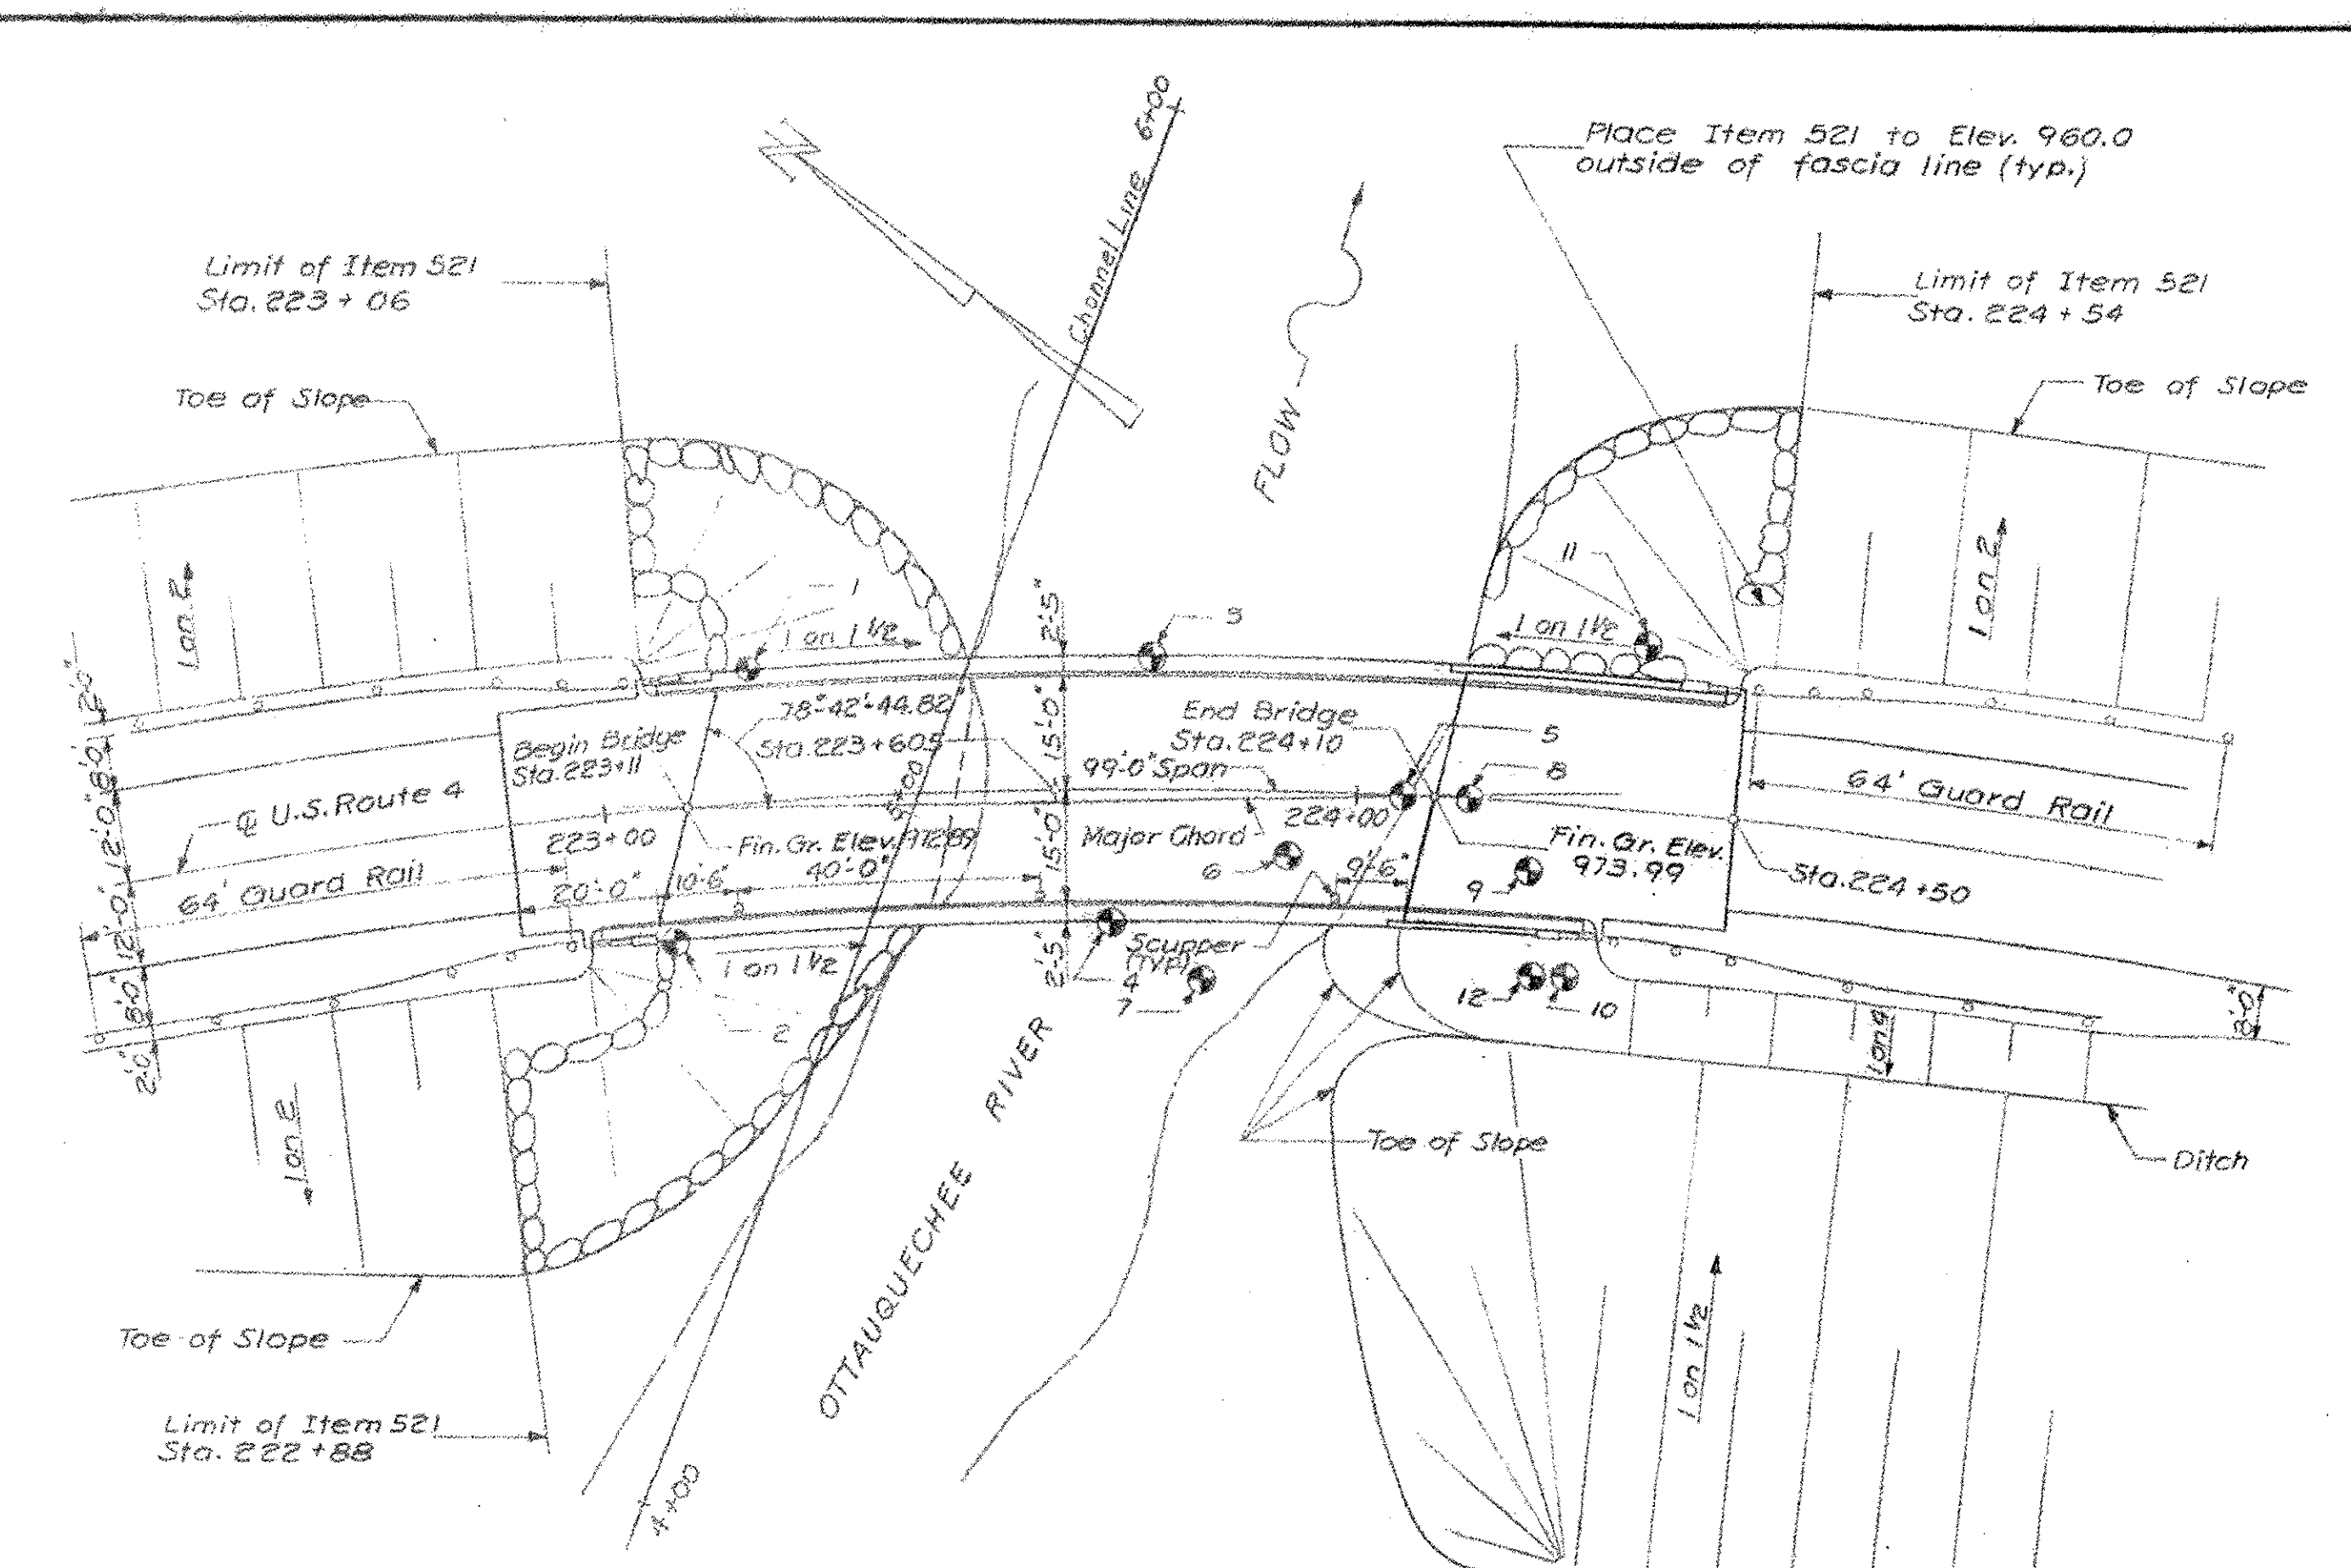

PLAN
Scale: 1" = 20'


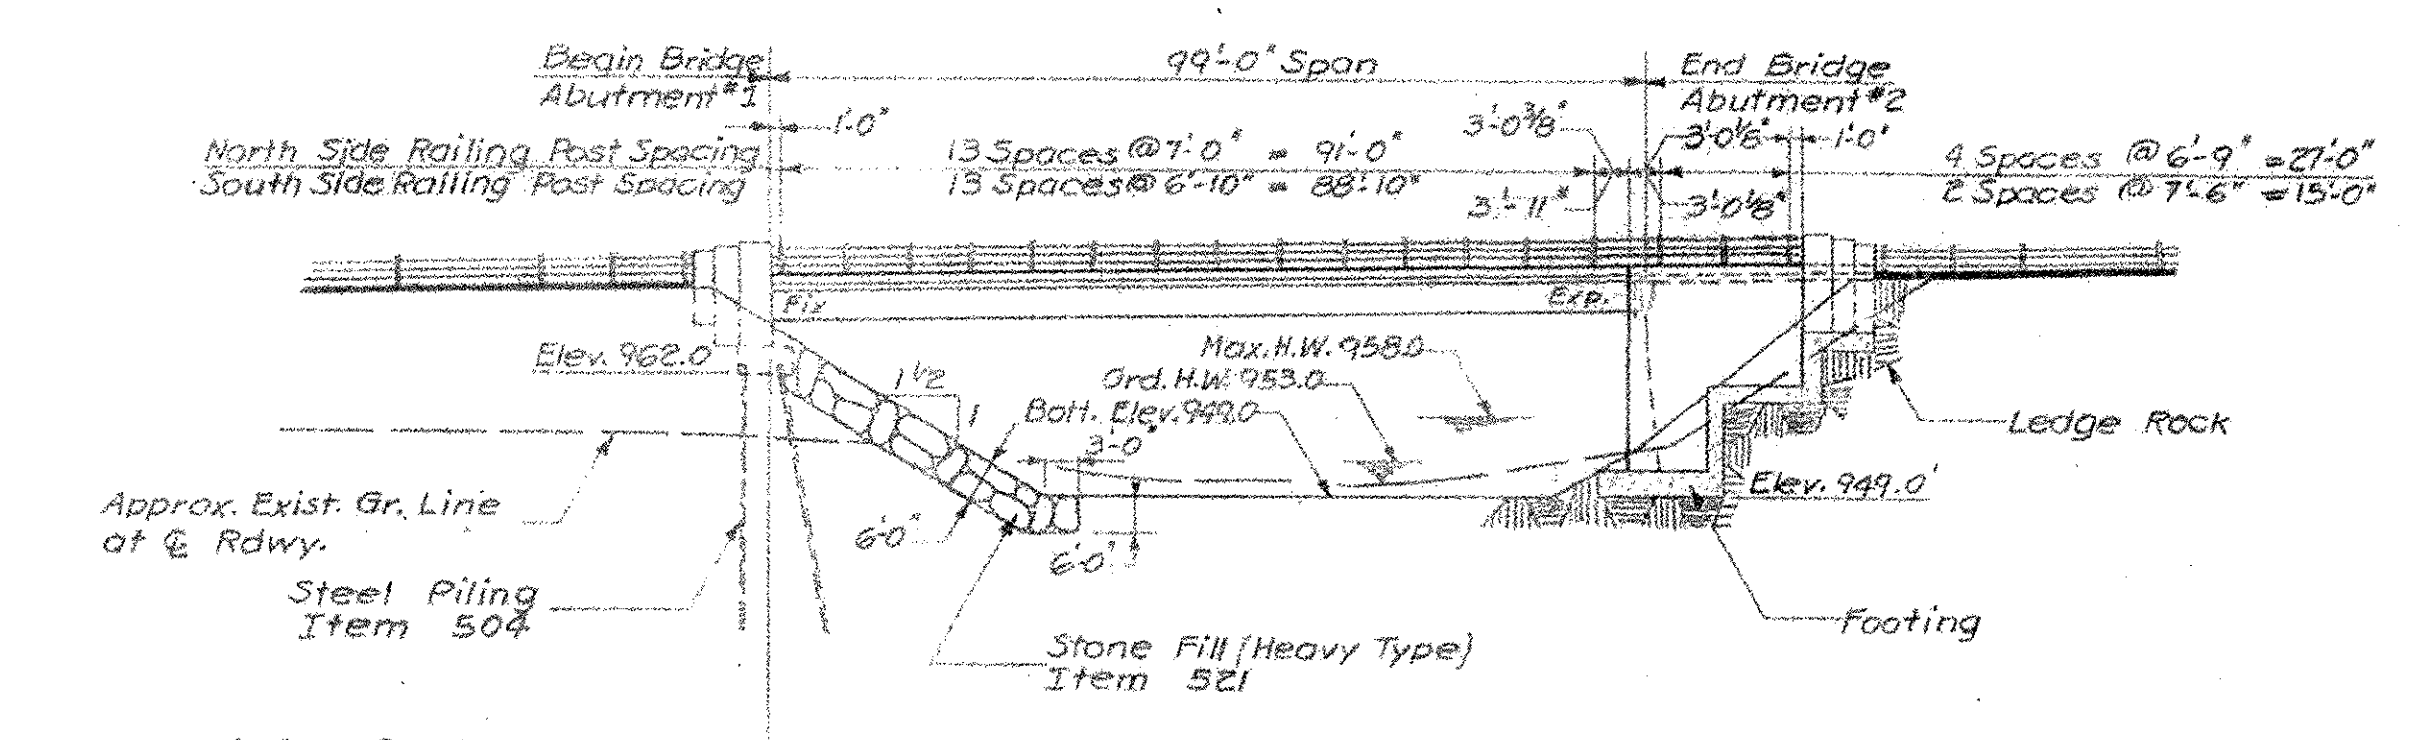


ELEVATION
Scale: 1" = 20'

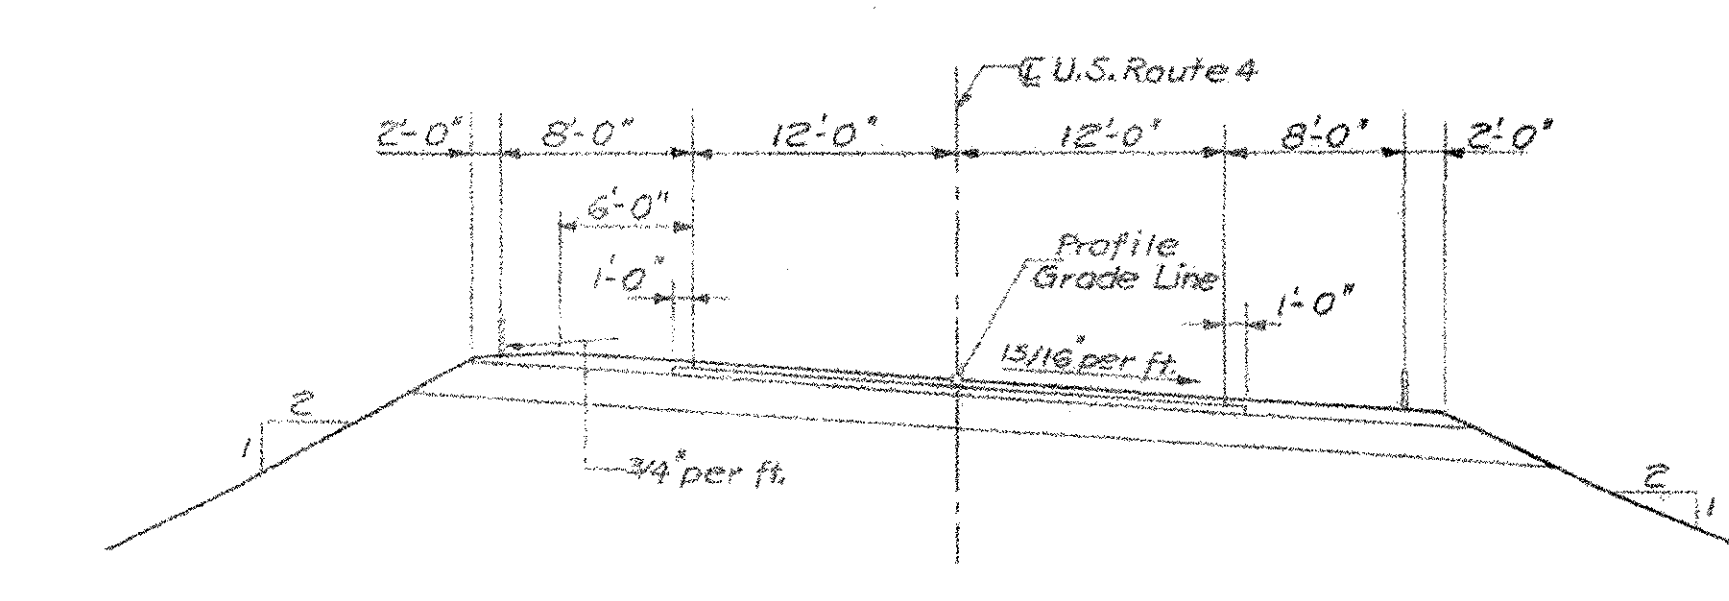


TYPICAL APPROACH SECTION
Scale: 1/8" = 1'-0"

CURVE DATA
 $\Delta = 45^\circ 38' \text{ Rt.}$
 $D = 7'-30"$
 $R = 764.49$
 $T = 321.62$
 $L = 608.44$
 $E = 64.90$
 Sta. 225+80 Bk.
 Sta. 225+45.20 Ah.

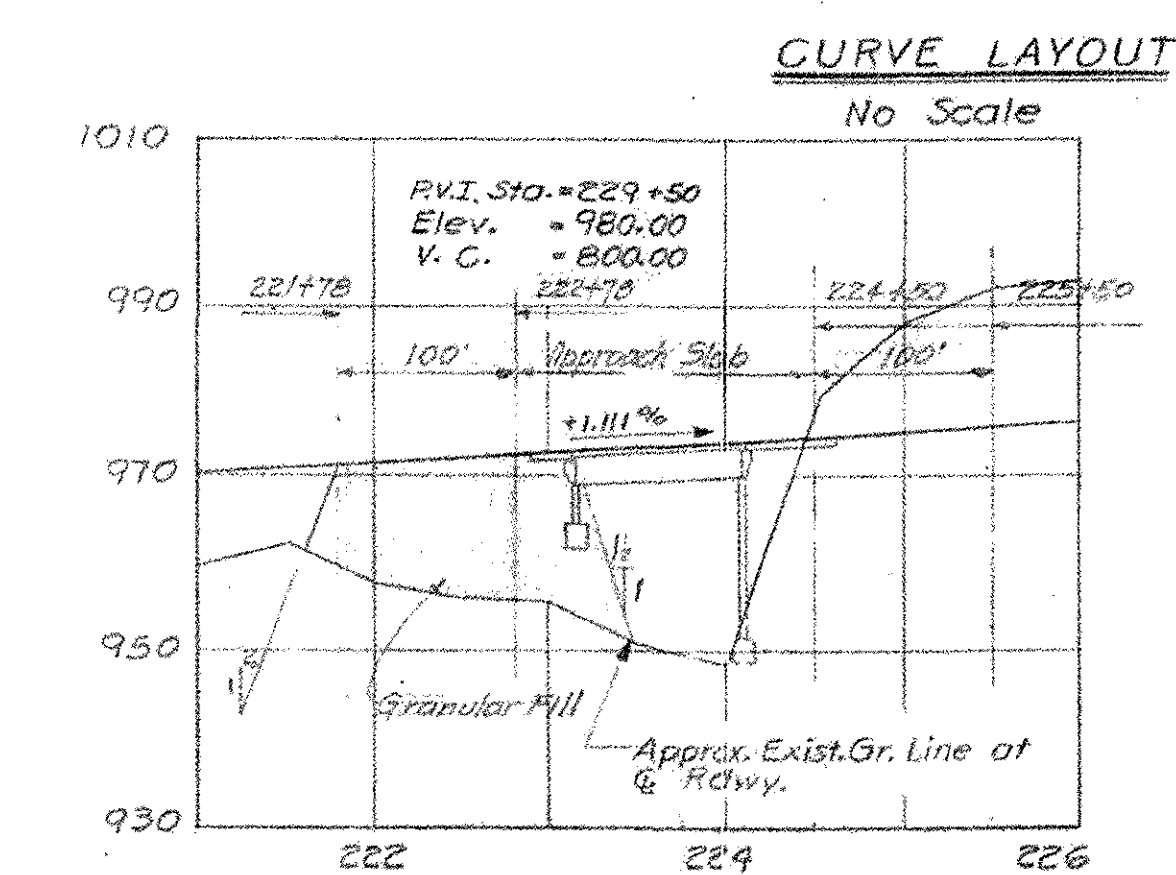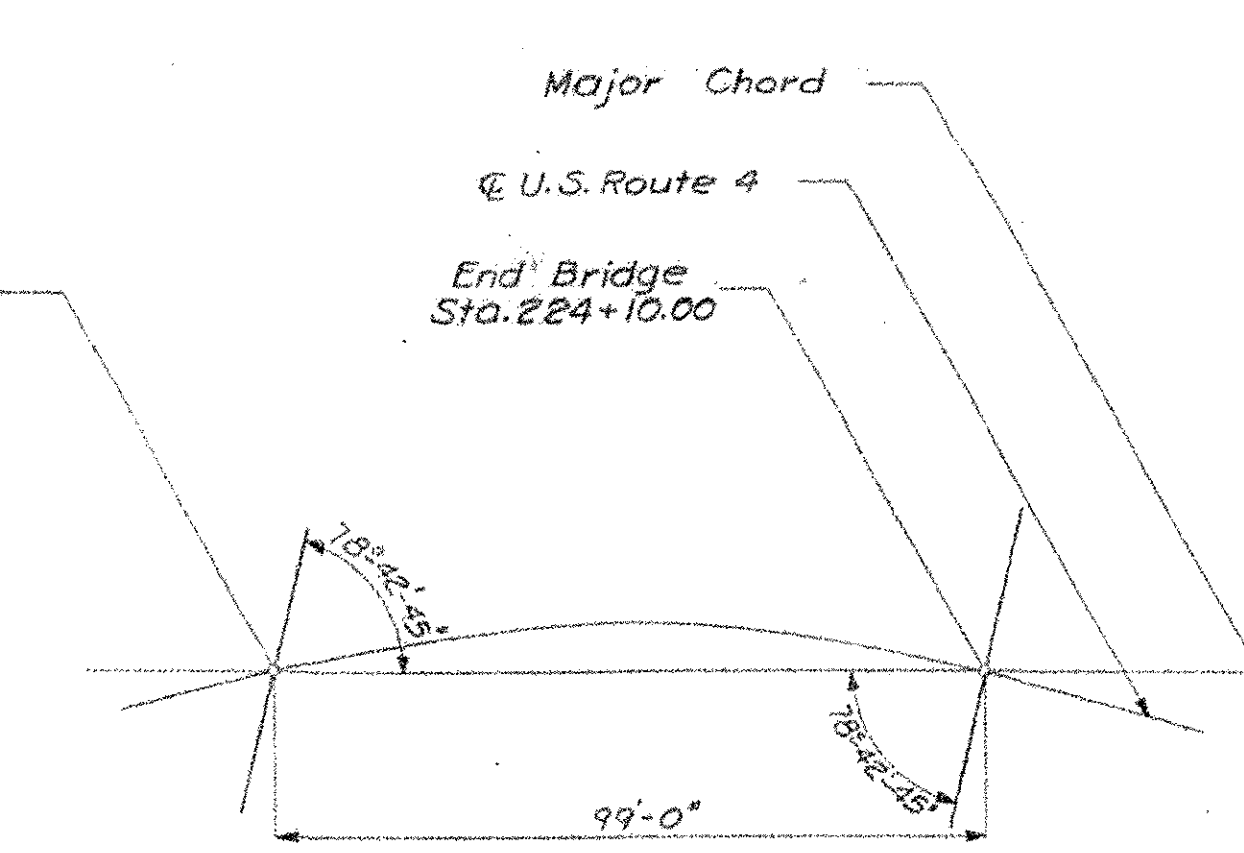

U.S. ROUTE 4 PROFILE
 Scales: Vert.: 1" = 20'
 Horiz.: 1" = 100'

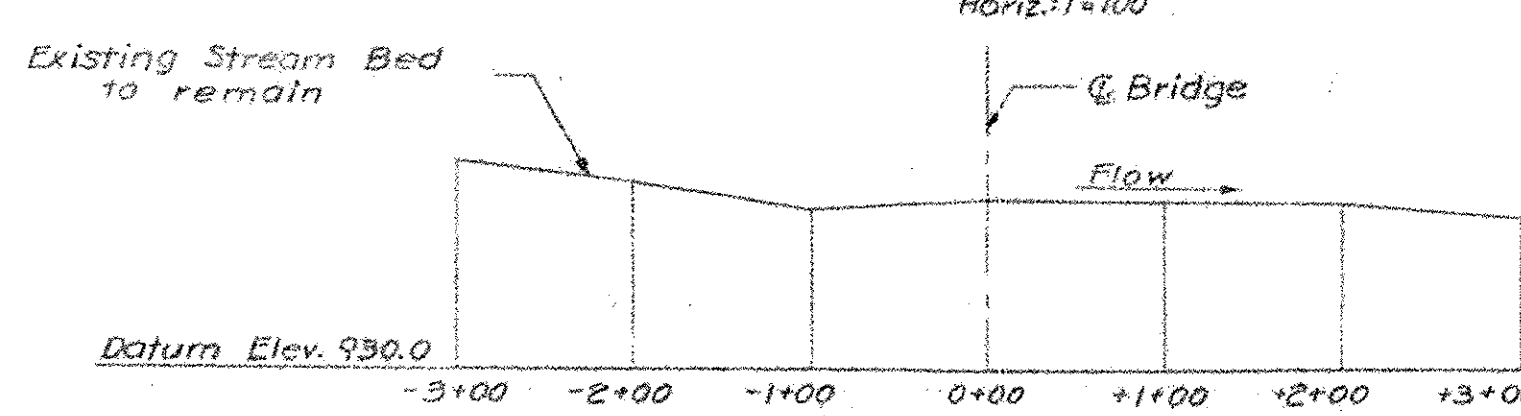

PROFILE OF STREAM CHANNEL
 Scales: Vert.: 1" = 20'
 Horiz.: 1" = 100'

SUMMARY OF QUANTITIES				
ITEM NO.	ITEM	UNIT	QUANTITY	FINAL
102-A	Granular Borrow	c.y.	0	232
106	Unclassified Channel Excavation	c.y.	93.5	93.5
107	Structure Excavation	c.y.	164	192
222	Gravel Backfill	c.y.	159	107
361-B	Bituminous Concrete Pav't. (Mod.)	ten	58	*
401-B	Concrete Class B (Mod.)	c.y.	511	521
402	Reinforcing Steel	lb.	51,727	49,369
403	Spiral Reinforcement (2550#)	l.s.	1	1
404-A	Structural Steel	lb.	192,866	193,311
407	Asphaltic Asbestos Coating	s.y.	81	8
442	Removal of Existing Superstructure	l.s.	1	1
501	Furnishing Equipment for Driving Piles	l.s.	Required	1/2
504	Steel Piling	l.f.	492	453
521	Stone Fill (Heavy Type)	c.y.	1,222	1,506
556-C	Granite Bridge Curb	l.f.	275	276
572	Bridge Railing	l.f.	235	241
503	Splices for Steel Piling	ex.	3	1
318	Tar Emulsion For Bridge Floors	Gal.	217	*

- GENERAL NOTES:** * Roadway Items
- Material and Construction shall conform to State of Vermont Standard Specification for Highway and Bridge Construction, dated 1956.
 - All design in accordance with A.A.S.H.O. Standard Specifications for Highway Bridges, dated 1957. Loading is H20-S16-44 Truck as Modified for National System of Interstate Highways.
 - Concrete shall attain a minimum strength of 2000 PSI, prior to the addition of any superimposed load.
 - All concrete to be Class B.
 - All welding to conform with the American Welding Society Standard Specifications for Welded Highway and Railway Bridges.
 - Reinforcing steel in top of abutments shall be placed so as to allow drilling for anchor bolts.
 - All dimensions given are measured horizontally or vertically unless noted.
 - Beam seats to slope 1/4" per ft. and be coated with Asphaltic-Asbestos coating, Item 407, except under bearings.
 - Railing posts and pylon lines to be normal to grade and top of pylon to be parallel to grade.
 - The haunch over the beam to vary in order to compensate for camber remaining after D.L. deflection.
 - The beam seat elevations have been lowered to account for difference between actual camber and required camber.
 - Where piles are driven in fill, the material should be such as to have no stones large enough to interfere with driving of piles.
 - All piles to be 10BP42 and driven to a minimum bearing capacity of 37 tons.
 - Maximum bearing pressure for foundations is 5 tons per sq. ft.
 - Where rock is encountered footings shall not be poured until all blasting has been completed.
 - Cross slope of 15/16" per ft. extends full length of bridge and approach slabs.
 - Piles shall not be spliced, except with the written approval of the Engineer.
 - Minimum cover for reinforcing bars shall be 2" unless noted.
 - Standards SCB-30-58 & SB-5G-57 shall be modified by substituting the following:
 Use 2" of Bituminous Concrete pavement in lieu of the 2 1/2" indicated
 Granite Bridge Curb (Modified) as indicated in the General Special Provisions shall be substituted in lieu of Granite Bridge Curb Type 1. The curb height finish grade to top of curb will therefore be 12".

**BRIDGE 40
FOR REFERENCE ONLY**
 SHEET 6 OF 16


VERMONT
 STATE HIGHWAY DEPARTMENT
 TOWN OF BRIDGEWATER
 U.S. ROUTE 4

BRIDGE AT STA. 223+605
 GENERAL PLAN, ELEVATION,
 PROFILES & SECTIONS

WM. H. McFARLAND
 ENGINEER
 BINGHAMTON, N.Y.


DESIGNED: F.W.C. CHECKED: K.R. DATE: 2-6-59
 DRAWN: H.H.T. IN CHARGE: H.G.C. SCALE: AS SHOWN
 PROJECT NO. F-020-2 (5) SH. 40 OF 141

- LIST OF SHEETS:**
- Sheet 1: General PLAN, Elevation, Profiles & Sections
 - Sheet 2: Framing Plan, Section & Boring Logs.
 - Sheet 3: Abutment No. 1 Details.
 - Sheet 4: Abutment No. 2 Details.
 - Sheet 5: " " " "
 - Sheet 6: Approach Slab
 - Sheet 7: Reinforcing Bar Schedule.
- REFERENCE:**
- Std. Drwg. SCB-30-58, Sheet 1 & 2: Superstructure
 - " " SB-5G-57, Sheet 1 & 2: Bridge Railing
 - " " SB-20-56: " Bearings & Steel Diaphr.
 - " " SB-AS-15" Skew-57: " Approach Slab
 - Std. Drwg. SB-22-58: " Exp. Jt.'s at Abut.

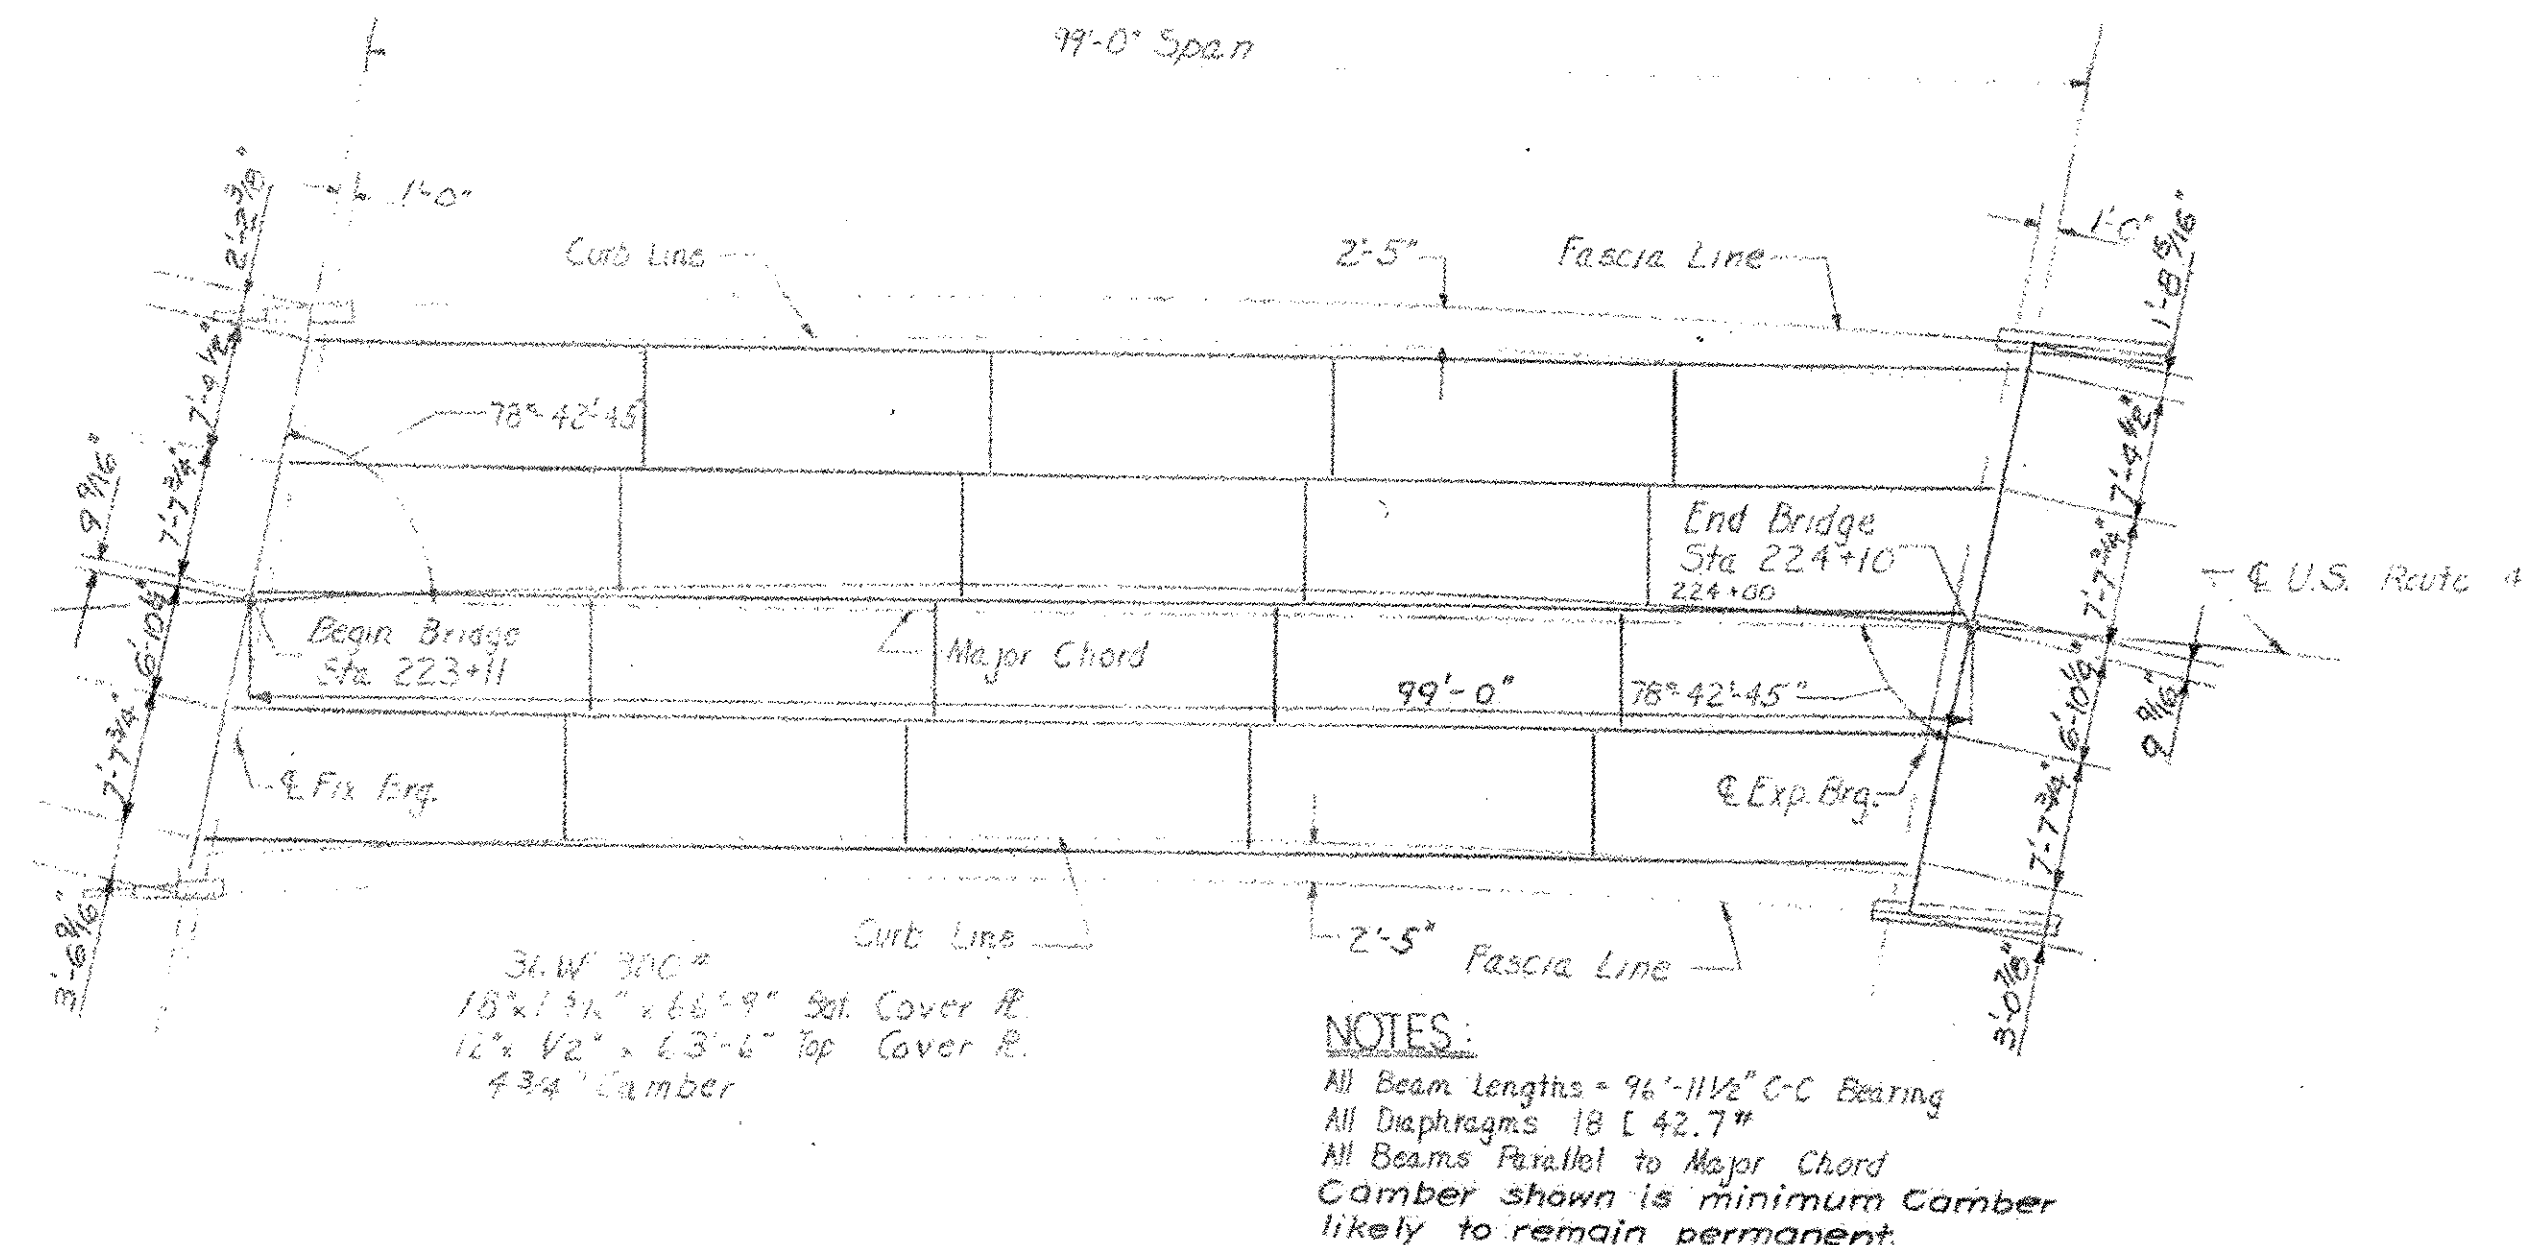


NOTES:
 All Beam Lengths = 96'-11 1/2" C-C Bearing
 All Diaphragms 18' C 42.7"
 All Beams Parallel to Major Chord
 Camber shown is minimum Camber likely to remain permanent.

FRAMING PLAN
Scale 1/4"=1'-0"

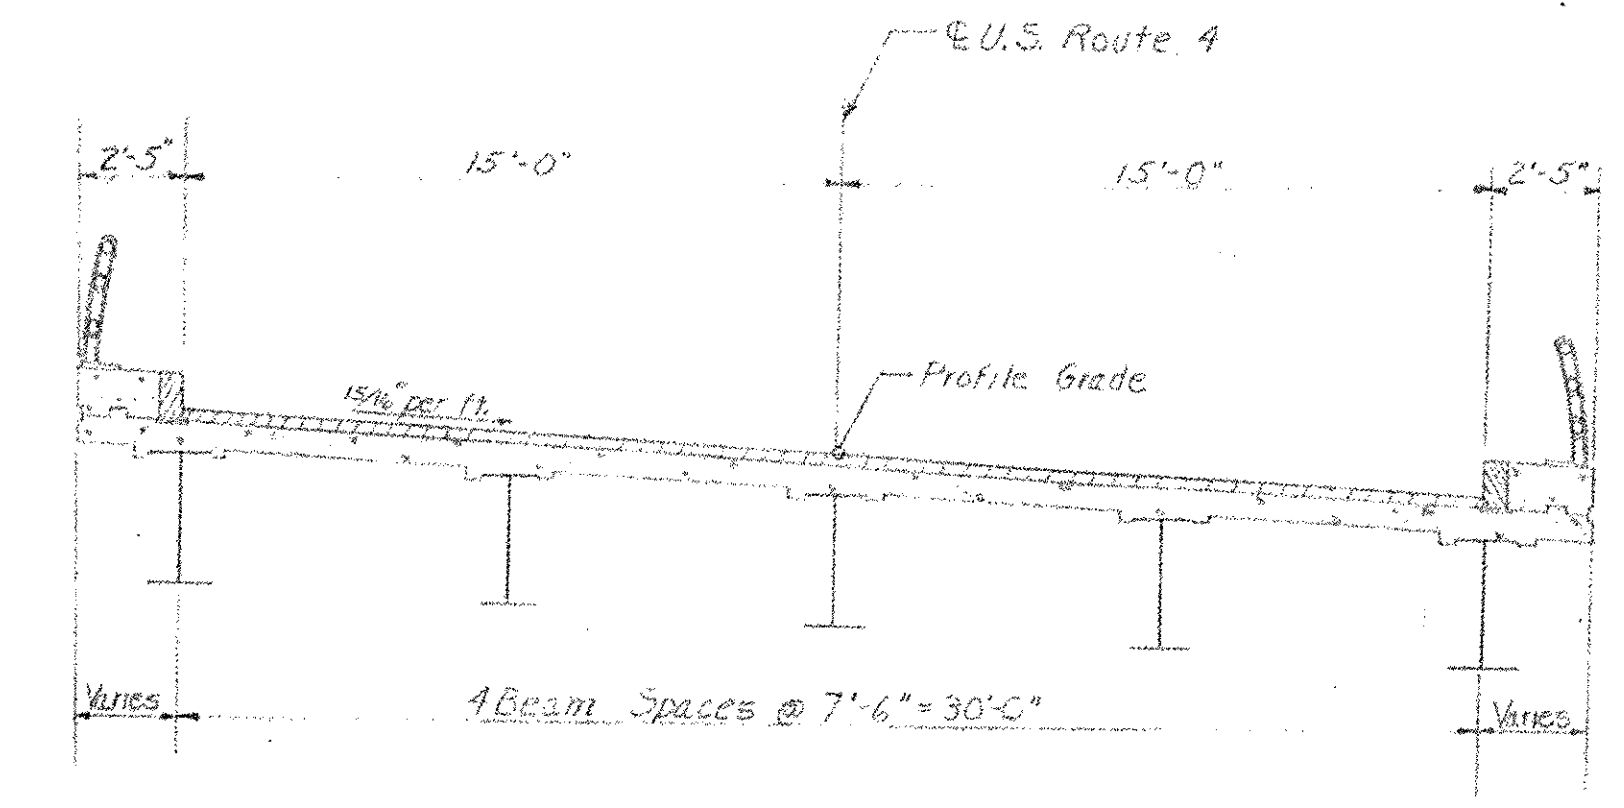

TYPICAL BRIDGE SECTION
Scale: 1/4"=1'-0"

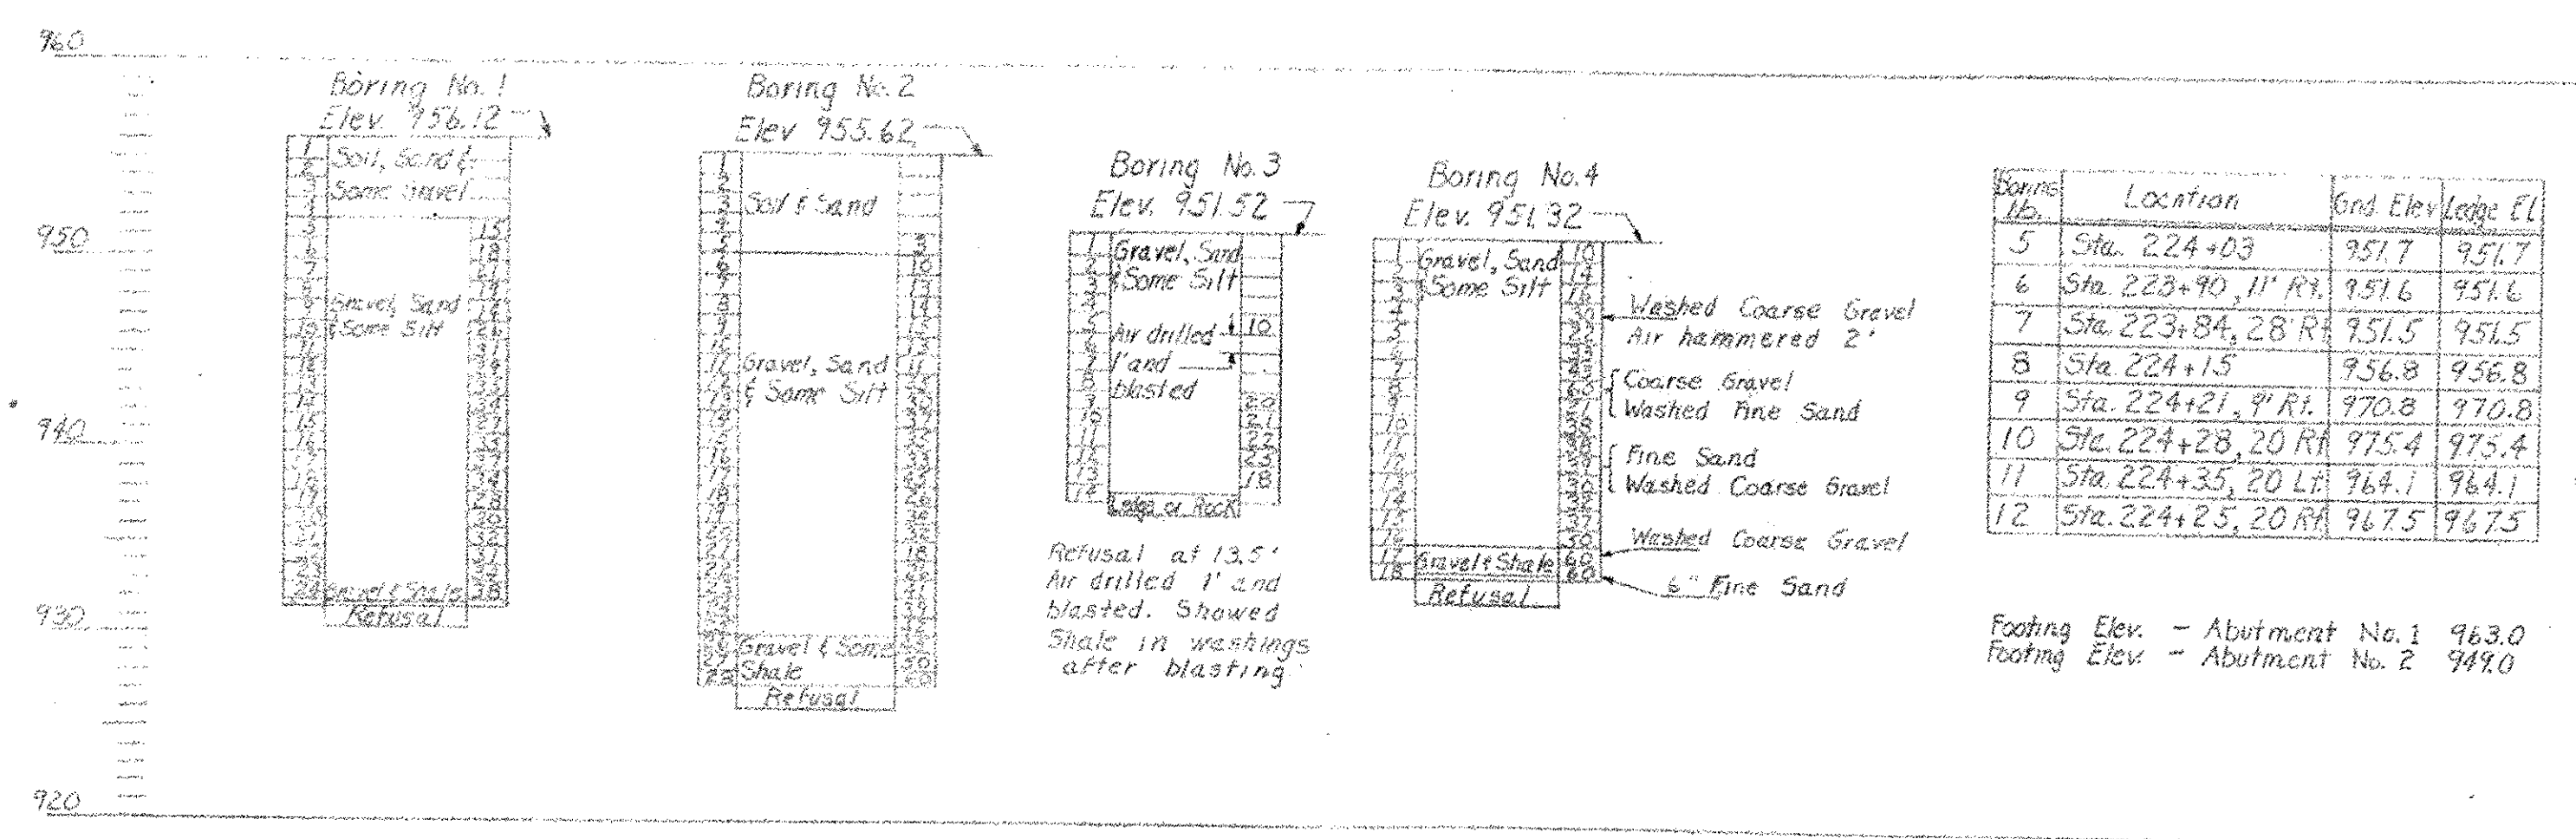

BORING LOGS

NOTES:
 Foundation information obtained for design purposes only, and the State assumes no responsibility whatsoever for the sufficiency or accuracy of the information shown. Boulders may be encountered at any pier or abutment location. For location of borings, see Sheet 1.

BRIDGE 40
FOR REFERENCE ONLY
SHEET 7 OF 16

VERMONT
 STATE HIGHWAY DEPARTMENT
 TOWN OF BRIDGEWATER
 U.S. ROUTE 4

BRIDGE AT STA. 223+605
 BORING LOGS, FRAMING PLAN
 & TYPICAL BRIDGE SECTION

WM. H. McFARLAND
 ENGINEER
 BINGHAMTON, N.Y.

DESIGNED: E.W.C. CHECKED: T.L.S. DATE: Feb. 6, 1937
 DRAWN: E.F.D. IN CHARGE: H.C.C. SCALE: AS SHOWN

PROJECT NO. Q-020-215 SH. 41 OF 141

NOTE:
 1. - For General Notes, see sheet #1.

INDEX OF SHEETS	
GENERAL SHEETS	
SHEET 1	TITLE PAGE
2	TYPICAL ROADWAY SECTIONS BITUMINOUS CONCRETE PAVEMENT ITEM 961-B, MOD.
3	QUANTITY SHEET, ITEMS
4	QUANTITY SHEET, ITEMS
5	QUANTITY SHEET, DRAINAGE
6, 7, 8, 9 A	EARTHWORK SHEETS
9-12, 12A, 13-20	PLAN & PROFILE SHEETS
21-23	SUPERELEVATION TRANSITION, TALC MILL UNDERPASS
	BRIDGE AT STA. 114+50
24	PRELIMINARY INFORMATION SHEET
25A	GENERAL PLAN & ELEVATION
26-32	BRIDGE DETAILS
33	BLANK
34	BRIDGE AT STA. 165+40
35	PRELIMINARY INFORMATION SHEET
36	GENERAL PLAN & ELEVATION
37-44	BRIDGE DETAILS
DEPARTMENT STANDARDS	
45-59A	ROADWAY STANDARDS B-1, B-5, B-6, D-1, D-2, D-3, D-4, D-8, D-10, D-11, D-13, E-1, E-9, G-2, G-3, G-4, H-1a, H-1b, J-1
67-71	BRIDGE STANDARDS SCB-30-58, SHT K; SCB-30-58, SHT 21; SB-20-56; SB-56-57, SHT 11; SB-56-57, SHT 2
CROSS SECTIONS	
72-187	HIGHWAY RELOCATION
188-193	ROUTE 10 INTERSECTION, TOWN RD. NO. 19 & 21
194-200	CHANNEL RELOCATION
201-208	CHANNEL IMPROVEMENT SECTIONS

STATE OF VERMONT
DEPARTMENT OF HIGHWAYS

PROPOSED IMPROVEMENT
FEDERAL AID PROJECT
TOWN OF CHESTER



COUNTY OF WINDSOR
VERMONT ROUTE 103
CHESTER-LUDLOW ROAD

BEGINNING AT A POINT APPROXIMATELY 0.5 MILES SOUTH OF THE INTERSECTION OF VERMONT ROUTES 10 & 103 AND EXTENDING NORTHWESTERLY TO THE CAVENDISH CHESTER TOWN LINE.


LENGTH OF ROADWAY 13,428.59 FT. = 2.543 MILES
LENGTH OF BRIDGE 522.47 FT. = 0.099 MILES
LENGTH OF PROJECT 13,951.06 FT. = 2.642 MILES

PROJECT NAME & NUMBER	TYPE	PAVEMENT AREA
CHESTER F 025-1(18)	BIT. CONCRETE	20,756 S.Y.
RECORD PLANS		
MATERIALS		
SUBBASE OF GRAVEL - SCHALLOW PIT - PROCTORSVILLE, VT.		
SHATTUCK PIT - PERKINSVILLE, VT.		
CRUSHED STONE BASE COURSE - VERMONT MARBLE CO. - FLORENCE, VT.		
ASPHALT & TAR - ALL STATES ASPHALT CO. INC. - SUNDERLAND, MASS.		
BITUMINOUS CONCRETE PAVE. - L.M. PIKE & SON - (PLANT) MANCHESTER, VT.		
CONCRETE CLASS - CHARLESTOWN READY MIX INC. - CHARLESTOWN, N.H.		
REINFORCING & STRUCTURAL STEEL - CITY IRON WORKS - BRIDGEPORT, CONN.		
REINFORCED CONCRETE PIPE - AMERICAN MARIETTA CO. - WINDSOR, VT.		
ASPH. DATED CORR. GALV. METAL PIPE & METAL BIN RETAINING WALL		
NEW ENGLAND METAL CULVERT CO. - WESTMINSTER, VT.		
GUARD RAIL (CABLE & WOOD) - MAINLINE FENCE CO. - WESTBROOK, MAINE		
BRIDGE RAILING - VERMONT STRUCTURAL STEEL CO. - BURLINGTON, VT.		
GRANITE SLOPE EDGING - ROCK OF AGES CORP. - BARRE, VERMONT.		
CONTRACTORS - CALEDONIA SAND & GRAVEL CO. INC. - CONTRACT		
& MILLER CONST. CO. - WINDSOR, VT. DATED - JAN. 19, 1961.		
RESIDENT ENGINEER - HUGH F. ELDER. STARTED - JAN. 19, 1961.		
INSPECTORS - S. LANGILL & J. DAVIS. COMPLETED - JUNE 29, 1962.		
RECORD PLANS - A.G. SPIDLE. ACCEPTED - JUNE 23, 1962.		

FED. ROAD REGION NO.	STATE	PROJECT NO.	SHEET NO.	TOTAL SHEETS
1	Vt	F 025-1(18)	8	16

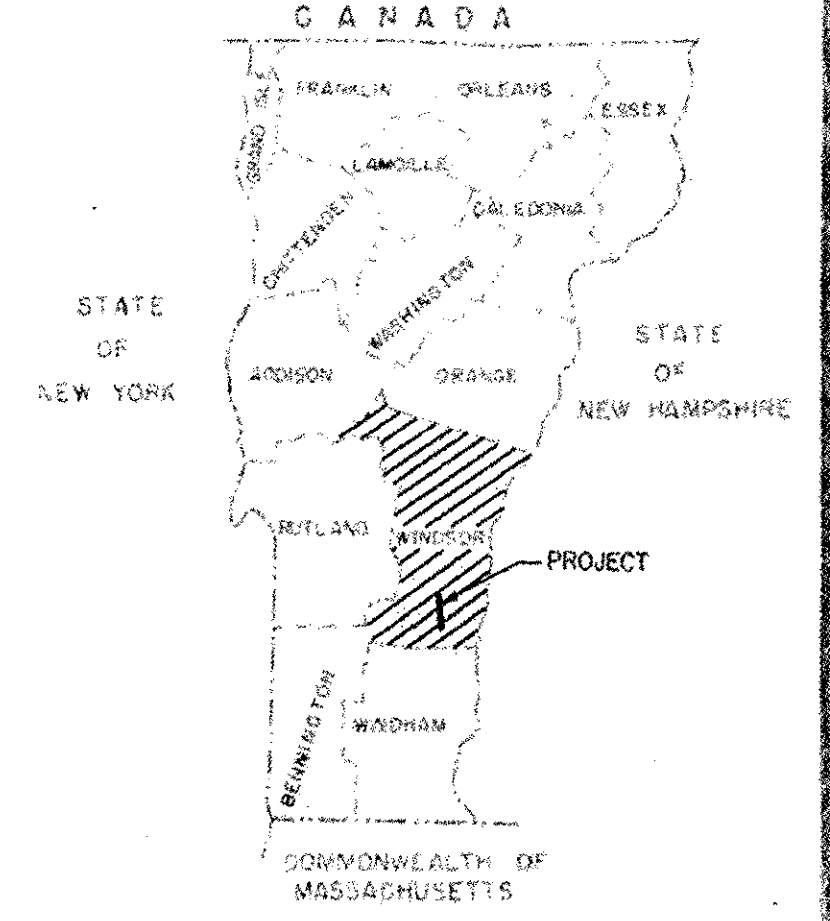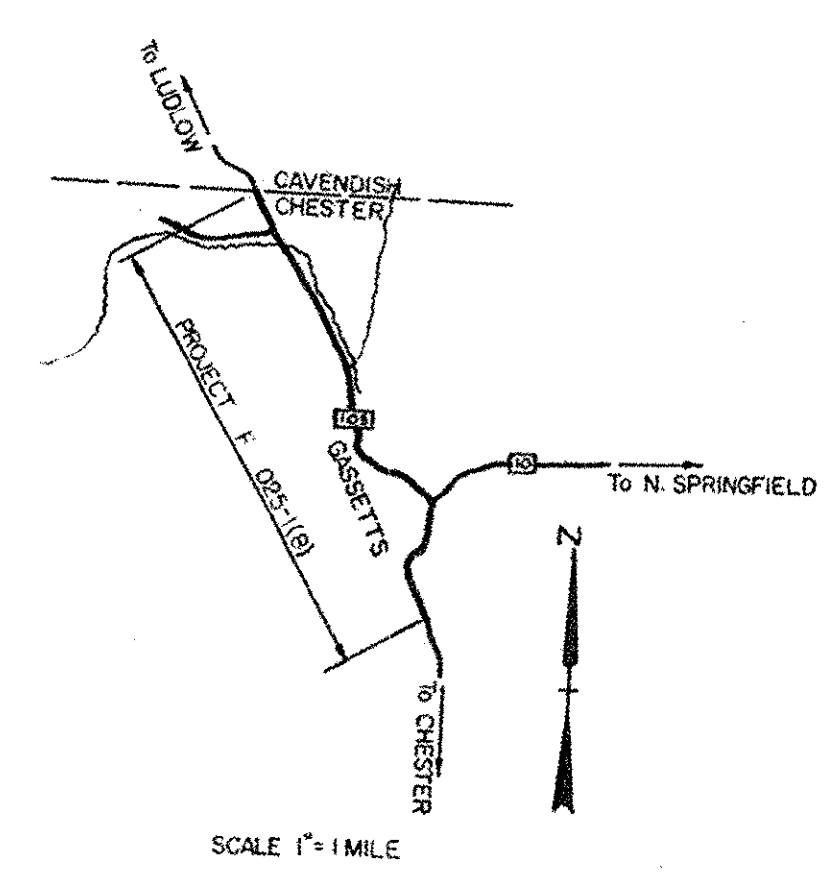

DESIGNATION	DESIGNATION
ADT (1955)	2230
ADT (1960)	3800
DHV (1960)	520
D	55%
T	5%
V	60 MPH

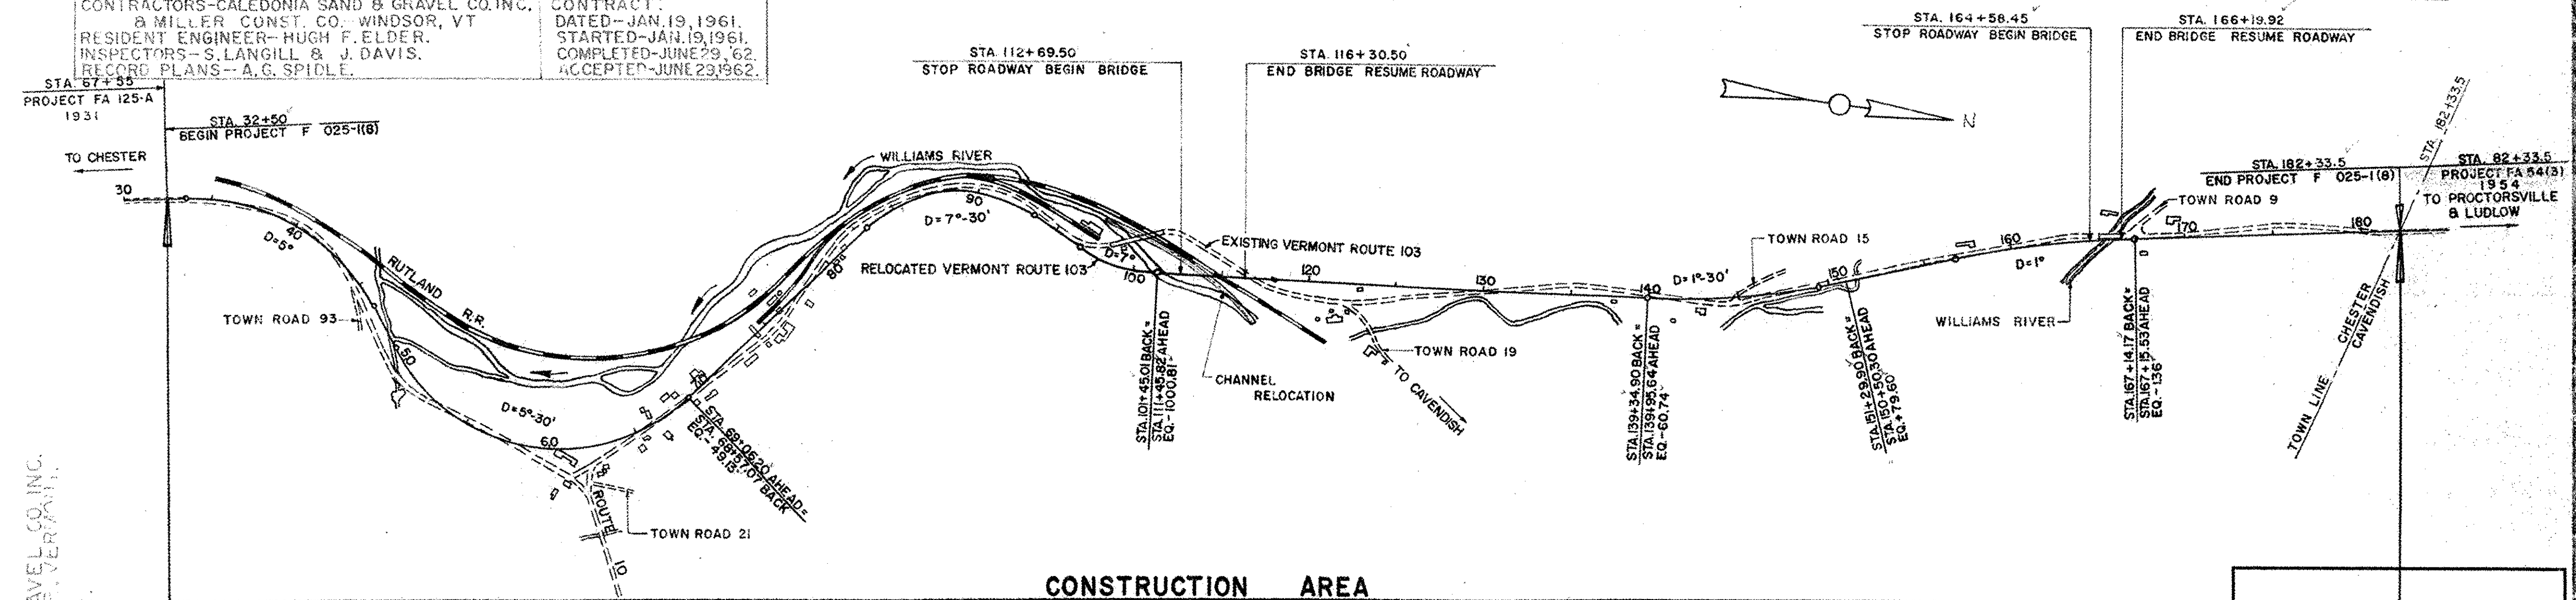

R.O.W. 1 COUNTY 1 TOWN 10 FENCE 10 STONE 10 UNFENCE 10 GUARD R. TRAVEL RAILROAD RETAININ CENTER SURVEY

PROJECT CHESTER F 025-1(18) TYPE BITUMINOUS CONCRETE PAVEMENT

CONTRACTORS CALEDONIA SAND & GRAVEL CO. INC. & MILLER CONST. CO. - WINDSOR, VT. (1961-62)

LOCATION beginning at a point approximately 0.5 miles south of the intersection of Vermont Routes 10 & 103 and extending northwest-ly to the Cavendish-Chester Town Line.

CONTRACTORS - CALEDONIA SAND & GRAVEL CO. INC. & MILLER CONST. CO. - WINDSOR, VERMONT. RECORD PLANS - A.G. SPIDLE. CONSTRUCTION COMPLETED - JUNE 29, 1962.

GROUND ELEVATION	RAISE	LINE
GRADE ELEVATION	RAISE	LINE
CURVE DATA		
DEFLECTION OF ANGLE	A	
DEGREE OF CURVE	D	
RADIUS OF CURVE	R	
TANGENT DISTANCE	T	
LENGTH OF CURVE	L	
EXTERNAL DISTANCE	E	
POINT OF INTERSECTION	PI	
POINT OF CURVE	PC	
POINT OF TANGENT	PT	
POINT ON TANGENT	POT	
POINT ON SUB-TANGENT	POST	

SCALES	
TITLE	1" = 500'
TYPICAL	3/8" = 1' & 1/8" = 1'
PLAN	1" = 50'
PROFILE HORIZONTAL	1" = 50'
PROFILE VERTICAL	1" = 10'
CROSS-SECTIONS	1" = 5' & 1" = 10'


BRIDGE 16 FOR REFERENCE ONLY
SHEET 8 OF 16

THESE PLANS ARE SUBJECT TO SUCH REVISIONS AS MAY BE REQUIRED BY THE BUREAU OF PUBLIC ROADS OR THE COMMISSIONER OF HIGHWAYS.

CONSTRUCTION IS TO BE CARRIED ON IN ACCORDANCE WITH THE PLANS AND THE STANDARD SPECIFICATIONS FOR HIGHWAY AND BRIDGE CONSTRUCTION OF JANUARY 1956 SUBMITTED TO THE BUREAU OF PUBLIC ROADS AS APPROVED JULY 5, 1956, INCLUDING ALL SUBSEQUENT APPROVED REVISIONS AND SUCH REVISED SPECIFICATIONS AND SPECIAL PROVISIONS AS ARE SUBMITTED WITH THE PLANS.


APPROVED SECONDARY ENGINEER DATE	APPROVED CONSTRUCTION ENGINEER DATE 8/3/60	APPROVED BRIDGE ENGINEER DATE Aug 2, 1960	APPROVED DISTRICT ENGINEER DATE 7/28/60	APPROVED HIGHWAY ENGINEER DATE 7/29/60	APPROVED CHIEF ENGINEER DATE 8/3/60
--	--	---	---	--	---

DEPARTMENT OF COMMERCE BUREAU OF PUBLIC ROADS	
APPROVED	DATE
DIVISION ENGINEER	DATE
PROJECT F NO. 025-1(18)	SHEET 8 OF 16 SHEETS

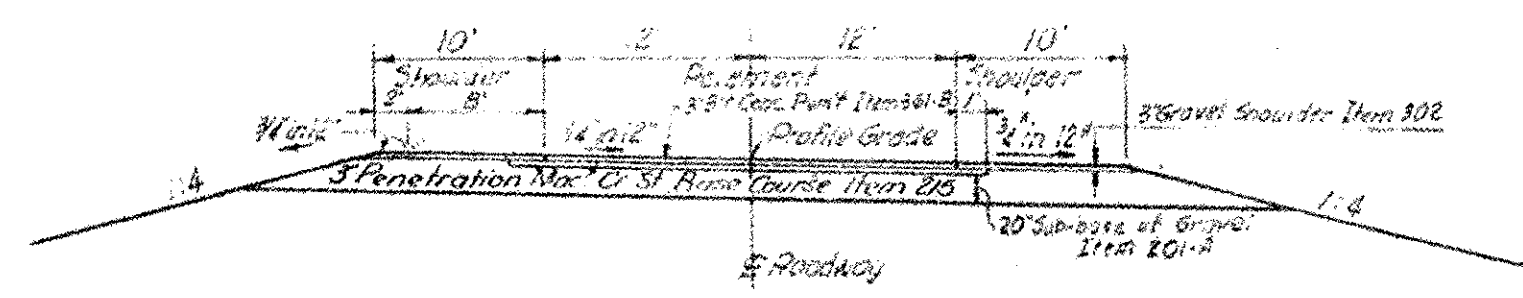


NEW HIGHWAY SECT-ADJACENT TO BRIDGE

SCALE: 1"=10'

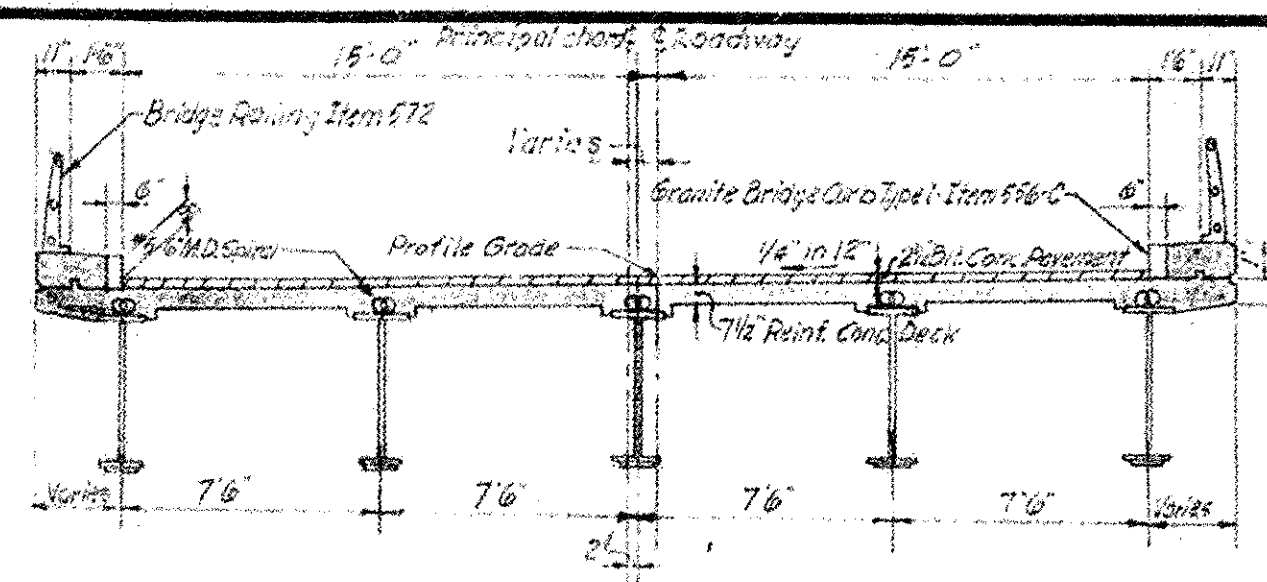

TYPICAL BRIDGE SECTION

SCALE 1"=5'

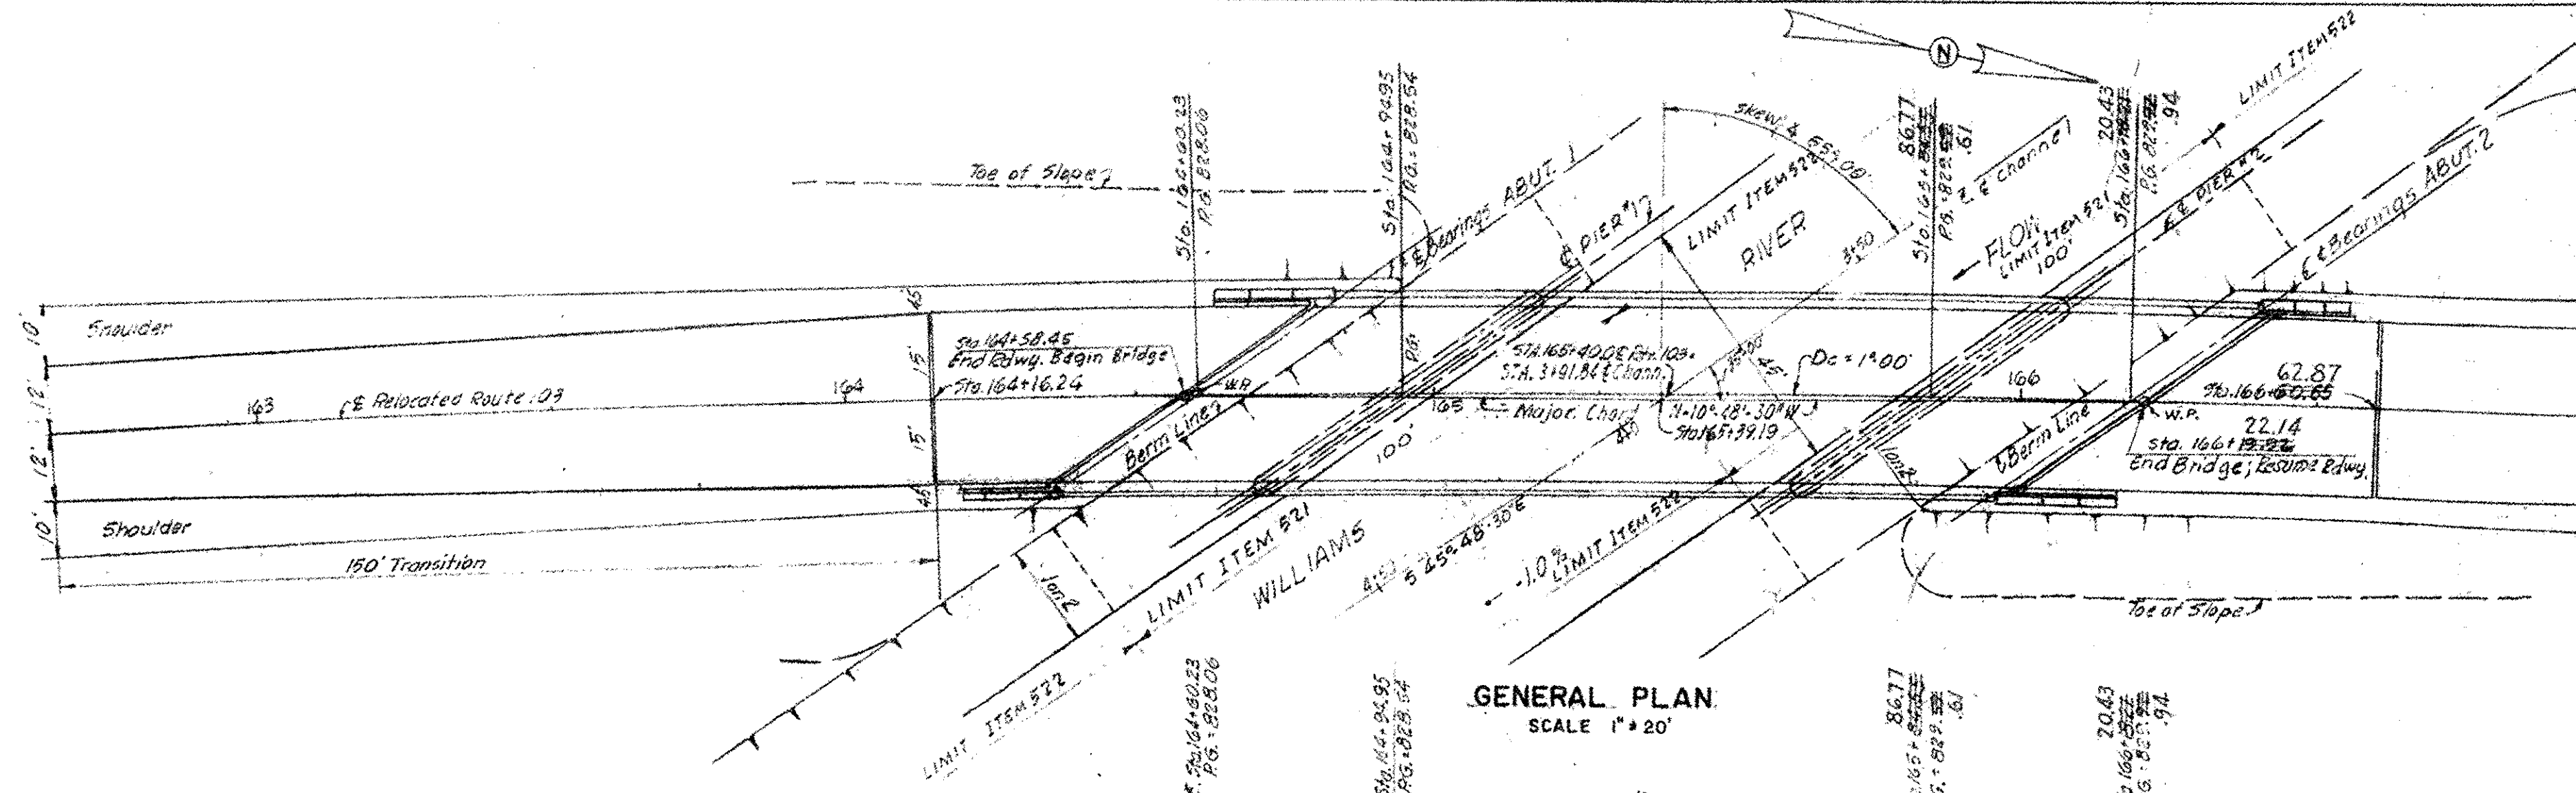

GENERAL PLAN


SCALE 1"=20'

HORIZONTAL CURVE DATA

Bank 1/4" per ft.
 $\Delta = 10^\circ 17' RT.$
 $D = 1^\circ 00'$
 $R = 5729.58'$
 $T = 515.55'$
 $L = 1028.33'$


VERTICAL CURVE DATA

400 Vertical Curve
 PVI Sta. 164+00 ELEV. 821.8
 PVI Sta. 166+00 ELEV. 820.4
 PVI Sta. 168+00 ELEV. 818.0
 $E = 0.61\%$
 $g_1 = +1.64\%$
 $g_2 = +0.31\%$

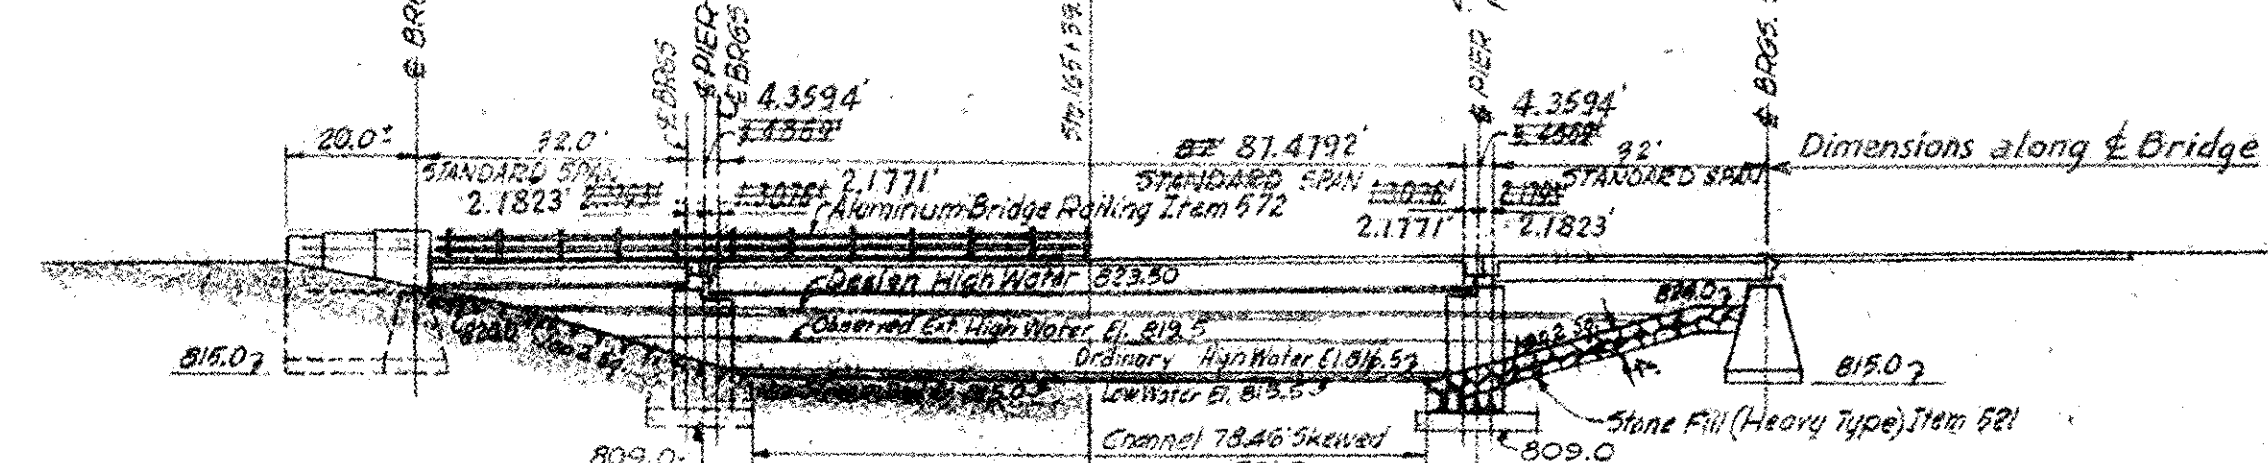

HALF ELEVATION - HALF SECTION

SCALE 1"=20'

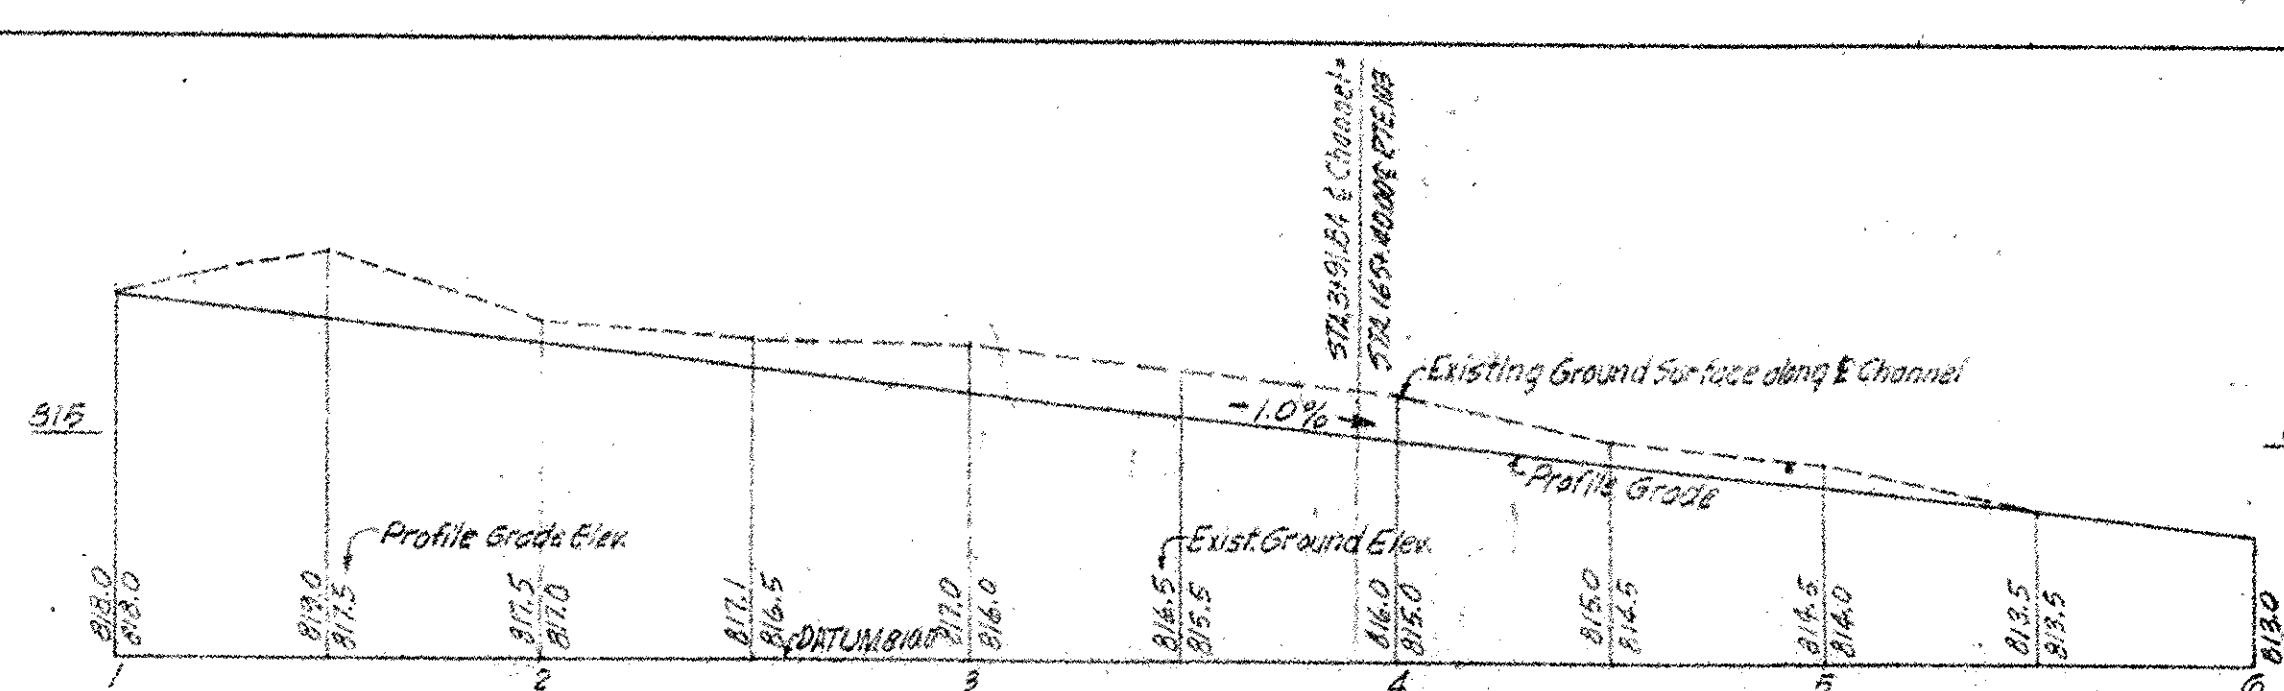

PROFILE OF PROPOSED STREAM CHANNEL

SCALE HOR. 1"=40'
 VERT. 1"=4'

HIGHWAY NO. Vt. Rt. 103 NAME OF HIGHWAY _____
 STRUCTURE NO. _____ COUNTY WINDSOR TOWN CHESTER
 PROJECT NO. F 025-1(8) LOCATION APPROX. 1700' SOUTH OF
CHESTER-CAVENDISH TOWN LINE


EXISTING STRUCTURE

- 1 RATED LOADING OF EXISTING STRUCTURE H15
- 2 TYPE OF EXISTING STRUCTURE SINGLE SPAN PONY TRUSS
- 3 UNDERCLEARANCE ELEVATION OF EXISTING STRUCTURE 823.4
- 4 WHAT DISPOSITION SHOULD BE MADE OF EXISTING STRUCTURE TO STATE. COST OF REMOVAL \$1,000.00
- 5 SHOULD EXISTING STRUCTURE BE USED TO MAINTAIN TRAFFIC DURING CONSTRUCTION OF NEW STRUCTURE NO
- 6 SHOULD NEW TEMPORARY STRUCTURE BE BUILT YES
- 7 ORDINARY HIGH WATER SURFACE ELEV. AT EXISTING STRUCTURE 812.4 WATERWAY TO ORDINARY H.W. 50 SF
- 8 EXTREME HIGH WATER AT EXISTING STRUCTURE (OBSERVED) 820.2 WATERWAY TO EXTREME H.W. 200 SF
- 9 SPAN OF EXISTING BRIDGE UPSTREAM 34 FT WATERWAY TO EXTREME H.W. 110.5 SF
- 10 SPAN OF EXISTING BRIDGE DOWNSTREAM 35 FT WATERWAY TO EXTREME H.W. 100.0 SF
- 11 TYPE OF FOUNDATION UNDER EXISTING ABUTMENTS MOIST SAND CORRECTION AND BENTONITE
- 12 DOES ALL WATER AT FLOOD ELEVATION PASS THROUGH EXISTING STRUCTURE YES
- 13 IF NOT AT WHAT ELEVATION IS RELIEF AFFORDED _____
- 14 ADDITIONAL WATERWAY AREA PROVIDED NONE

NEW STRUCTURE

- 1 RECOMMENDED TYPE OF STRUCTURE THREE SPAN COMPOSITE DECK AND STEEL BEAM BRIDGE 87.48' NON-STANDARD
- 2 RECOMMENDED CLEAR SPAN OR SPANS DEPARTMENT STANDARD SPANS 32'-00" 32'-00" 32'-00"
- 3 MEASURED PARALLEL TO NEW HIGHWAY 28.05' 28.05' 28.05' CLEAR SPANS # 84.86'
- 4 MEASURED AT RIGHT ANGLES TO STREAM 16.01' 16.01' 16.01' CLEAR SPANS # 84.86'
- 5 ARE THERE OBJECTIONS TO A PIER IN THE STREAM, ANSWER YES OR NO YES
- 6 ORDINARY HIGH WATER ELEVATION AT NEW STRUCTURE 818.5
- 7 EXTREME HIGH WATER ELEVATION AT NEW STRUCTURE 819.5 SOURCE OF INFORMATION LOCAL RESIDENTS
- 8 IS ALL WATER INTENDED TO PASS THROUGH NEW STRUCTURE? YES
- 9 DOES STREAM REACH ITS MAXIMUM HIGH WATER ELEVATION RAPIDLY? NO IS ORDINARY RISE RAPID? YES
- 10 LOW WATER ELEVATION AT NEW STRUCTURE 818.5
- 11 DRAINAGE AREA IN ACRES ABOVE STRUCTURE 11.000 CHARACTER OF TERRAINE HILLY
- 12 IS STREAM EVER DRY? NO
- 13 VELOCITY OF STREAM AT DESIGN HIGH WATER STAGE 14.8 FPS ESTIMATED DISCHARGE 7830 CFS
- 14 AREA FULL OPENING 450 S.F. AREA BELOW ORDINARY H.W. 70 S.F. BELOW E.H.W. 250 S.F.
- 15 CHARACTER OF SCOUR NEGLECTIBLE DRIFT POSSIBLE ICE VERY POSSIBLE
- 16 ESTIMATED DRAINAGE AREA ABOVE NATURAL OR ARTIFICIAL STORAGE NOT APPLICABLE
- 17 VERTICAL CLEARANCE ABOVE FLOOD ELEVATION 1.0 FT 1' ABOVE DESIGN HIGH WATER
- 18 ARE SIDEWALKS REQUIRED, IF SO ON WHAT SIDE NONE BOTH SIDES _____
- 19 RECOMMENDED TYPE OF PAVEMENT 2 1/2" BITUMINOUS CONCRETE ITEM 301-B
- 20 TRAFFIC TO BE MAINTAINED UNDER ITEM NO. 108 ONE OR TWO WAYS TWO PROBABLE COST _____
- 21 PROBABLE COST OF CLEARING AND GRUBBING STREAM CHANNEL AT STRUCTURE SITE NONE
- 22 SHOULD PROVISIONS BE MADE FOR PUBLIC UTILITIES? NO
- 23 ESTIMATED ALLOWABLE LOAD ON FOUNDATIONS 2.0 T/SF SHOULD PILES BE USED? NO EST. LGTH. _____
- 24 DESIGN LOADING AASHTO H20-S16

BRIDGE 16
 FOR REFERENCE ONLY
 SHEET 9 OF 16

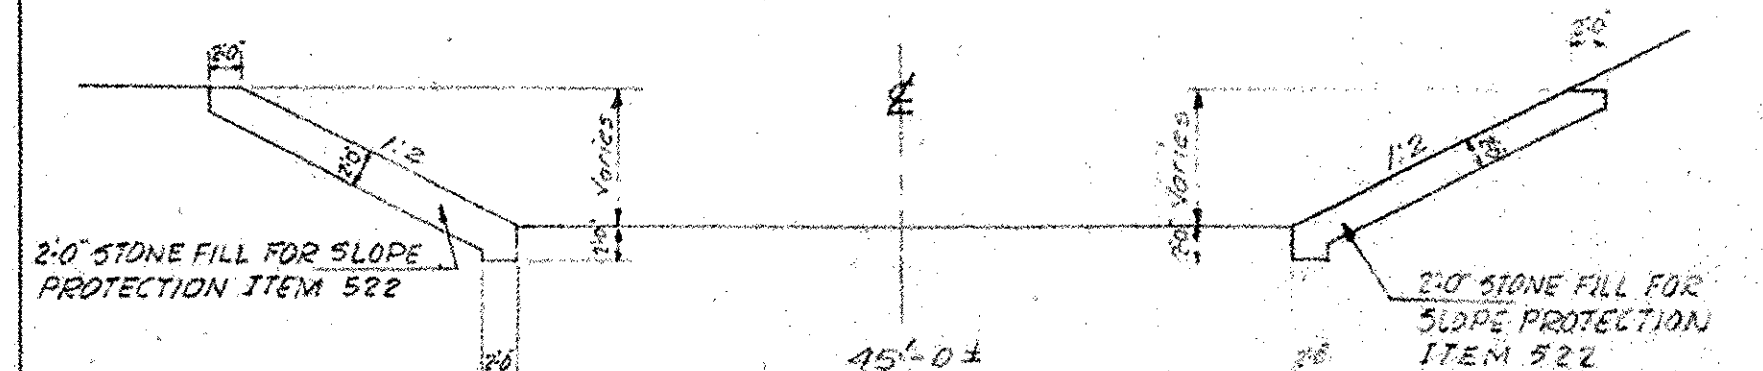

TYPICAL SECTION CHANNEL IMPROVEMENT

SCALE 1"=10'

DEPT. STANDARD BRIDGE SHEET NOS.

1. SCB-30-58 10F2
2. SCB-30-58 20F2
3. SB-20-56
4. SB-56-57 10F2

STATE OF VERMONT
 DEPARTMENT OF HIGHWAYS


ROUTE 103
 CHESTER PROJECT F 025-1(8)
 BRIDGE AT STATION 165+40

PRELIMINARY INFORMATION SHEET

SURVEYED BY J. J. B. CHECKED BY J. J. B. SCALE AS SHOWN
 DRAWN BY J. J. B. IN CHARGE DATE 22 FEB 55
 PROJECT NO. F 025-1(8) SHEET 35 OF 208

CORRECT
 BRIDGE ENGINEER


APPROVED
 CHIEF ENGINEER

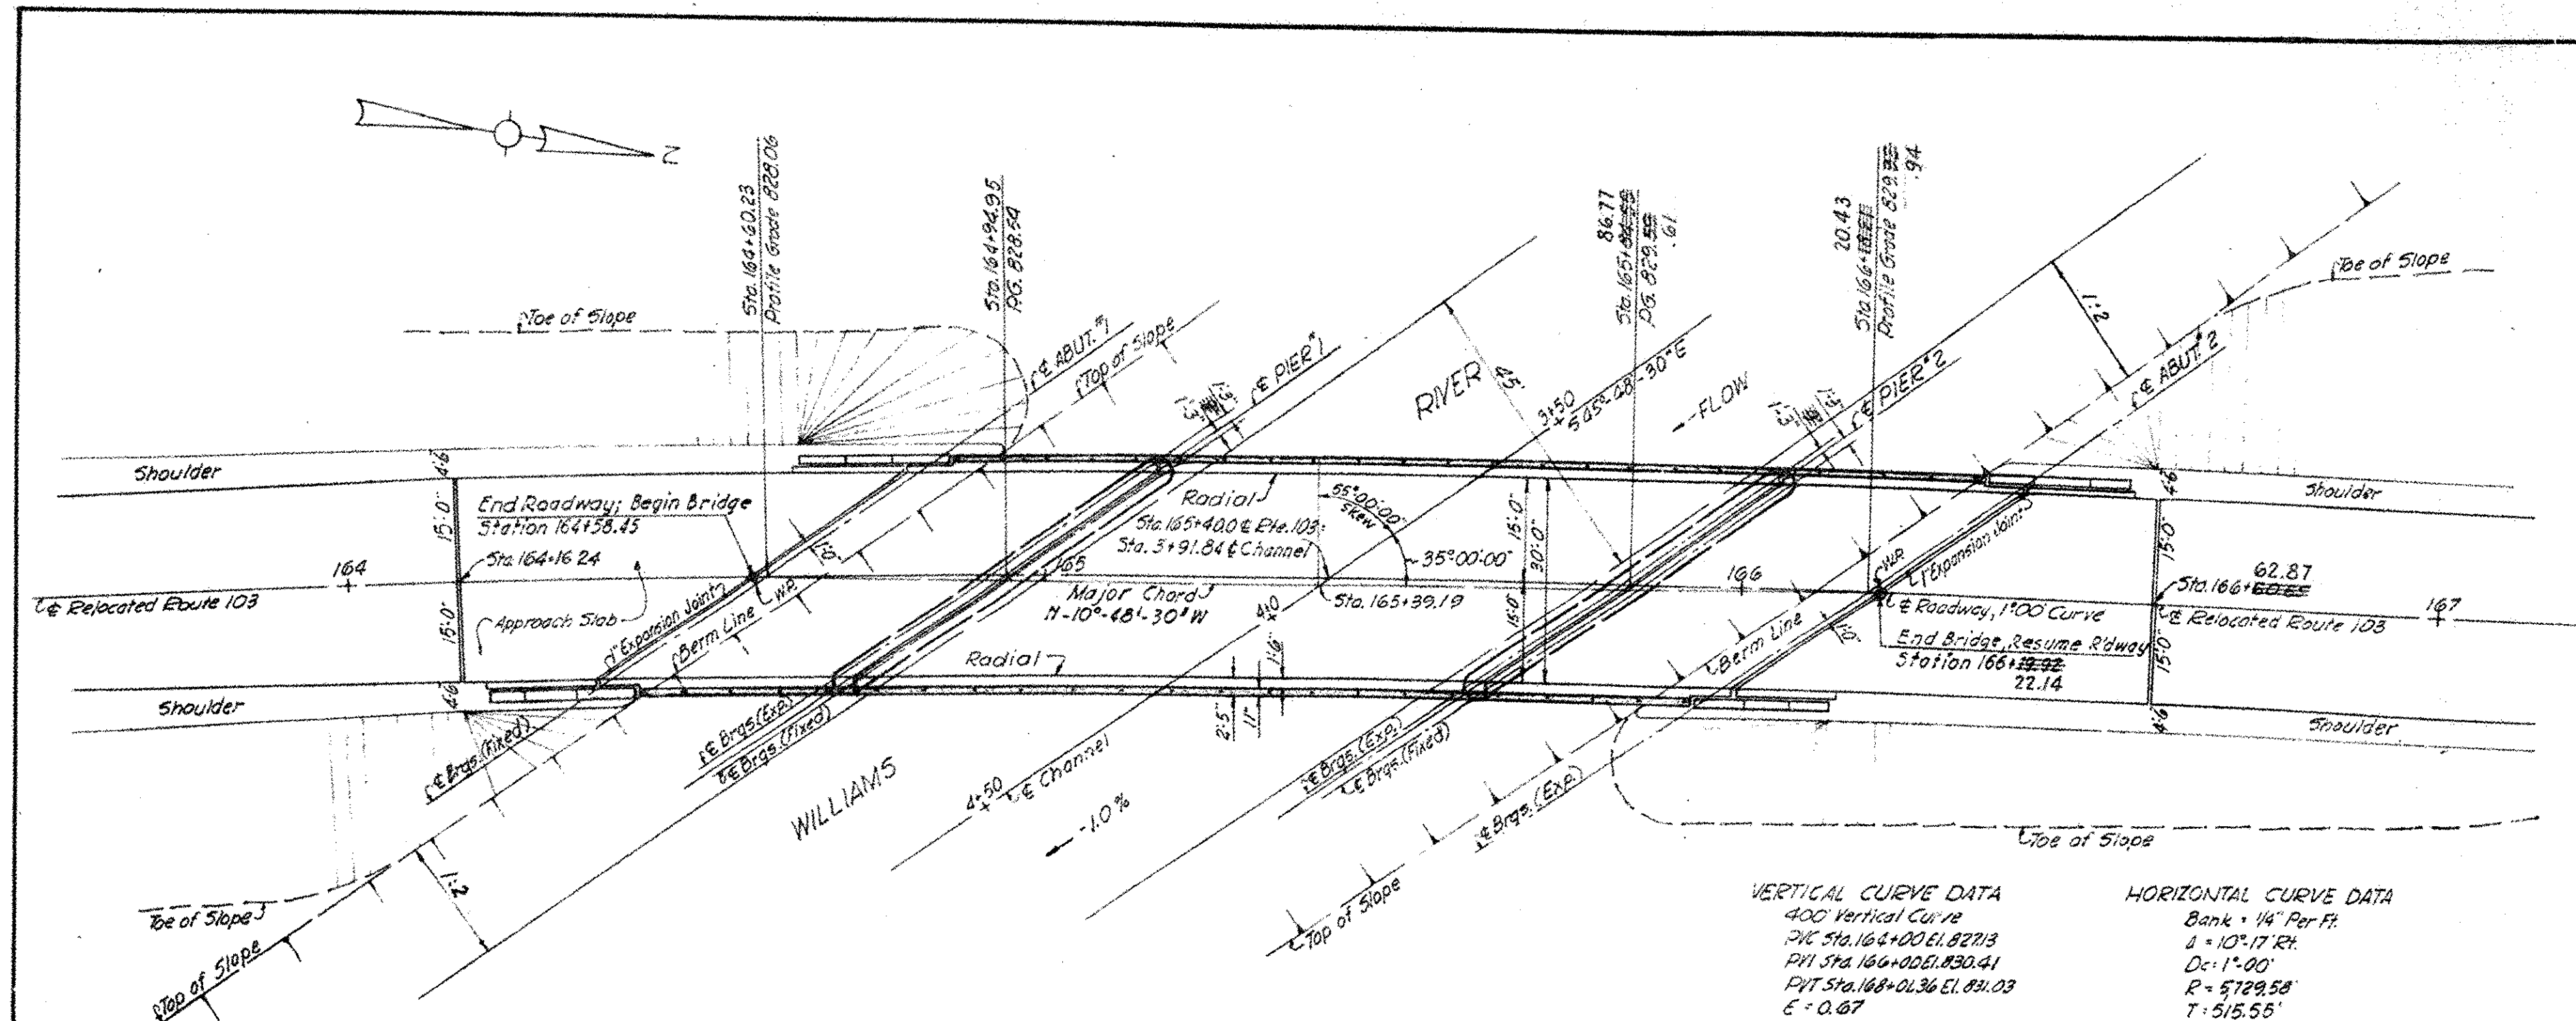

VERTICAL CURVE DATA
 400' Vertical Curve
 PVI Sta. 164+00.00 El. 828.18
 PPT Sta. 164+00.00 El. 830.41
 PVT Sta. 164+00.00 El. 828.18
 E = -0.67
 G₁ = +1.64%
 G₂ = +0.31%

HORIZONTAL CURVE DATA
 Bank = 1/4" Per Ft.
 Δ = 10° 17' 18"
 D = 1'-00"
 R = 5729.58'
 T = 515.55'
 L = 1028.83'
 PC Sta. 156+85.84
 PT Sta. 167+14.17 Back =
 PT Sta. 167+15.53 Ahead

PLAN
 1/16" = 1'-0"

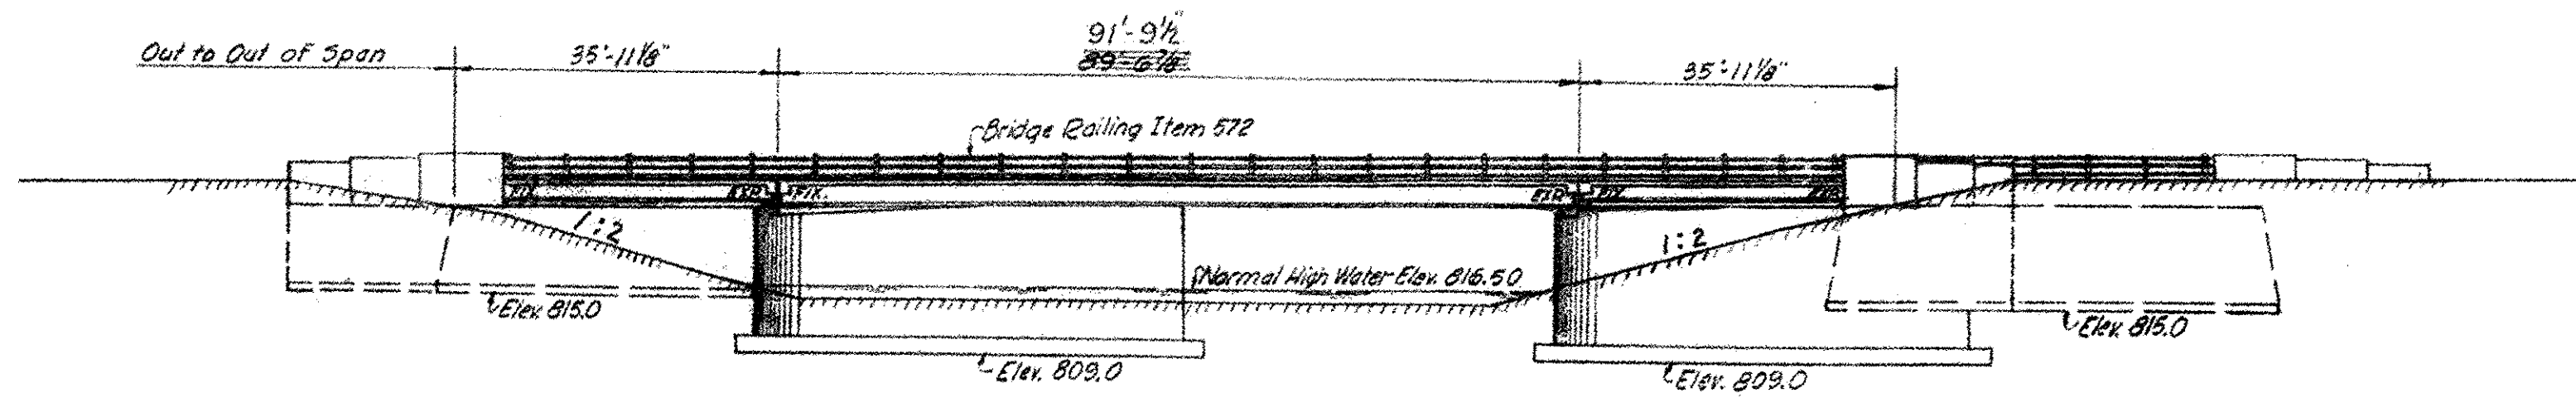

ELEVATION
 1/16" = 1'-0"

GENERAL NOTES:

- Design in accordance with the American Association of State Highway Officials Standard Specifications for Highway Bridges, 1957, and the State of Vermont Department of Highways, Standard Specifications for Highway & Bridge Construction, 1956.
- Design Live Loading H-20-516 - S-16.
- All elevations from U.S.G.S. datum.
- Foundations shall be taken to elevations given on plans unless otherwise directed by the Engineer.
- Existing structure shall be dismantled and stored according to the direction of the Engineer, for disposition by the State. The Contractor shall erect a temporary bridge for the purpose of maintaining traffic during construction of the new structure.
- All concrete shall have an ultimate compressive strength of 3,000 PSI at the age of 28 days.
- All reinforcing steel shall be intermediate grade with an allowable tensile working stress of 20,000 PSI. Deformations shall conform to ASTM Designation A-305-53T.
- All structural steel shall conform to ASTM Designation A-7 and shall have an allowable tensile working stress of 18,000 PSI.

ESTIMATE OF BRIDGE QUANTITIES						
Final	Item No.	Item Description	Unit	Net	Overrun	Total
3,441	106-C	Unclassified Channel Excavation	C.Y.	4,987	513	5,500
725	107	Structure Excavation	C.Y.	623	67	690
129	222	Gravel Backfill	C.Y.	156	14	170
* 0	361-B	Bituminous Concrete Pavement	Tons	115	15	130
983	401-B	Concrete Class B (MOD)	C.Y.	992	50	1,042
71,201	402	Reinforcing Steel	LB.	68,196		68,196
1	409	Spiral Reinforcement - #620#	LS	1		1
193,600	404-A	Structural Steel	LB.	183,815	3,785	193,600
74	407	Asphaltic-Asbestos Coating	S.Y.	74		74
1	441	Temporary Bridge	LS	1		1
1	442	Removal of Present Superstructure	LS	1		1
875	521	Stone Fill (Heavy Type)	C.Y.	700	70	770
1,245	522	Stone Fill For Slope Protection	C.Y.	900	100	1000
382	556-C	Granite Bridge Curb	L.F.	369		369
354	572	Bridge Railing	L.F.	297		297
220	318	Tar Emulsion For Bridge Floors	Gal	323		323

*Included in Roadway Quantity

INDEX TO BRIDGE DRAWINGS	
TITLE	PLAN SHEET NO.
General Plan & Elevation	36 OF 208
Framing Plan	37 OF 208
Abutment No. 1	38 OF 208
Abutment No. 2	39 OF 208
Wingwall & Miscellaneous Details	40 OF 208
Piers	41 OF 208
Approach Slabs	42 OF 208
Reinforcing Schedule Sheet No. 1 of 2	43 OF 208
	44 OF 208
Vermont Dept. of Highways Standards	67-71
Channel Sections	201-208

BRIDGE 16
FOR REFERENCE ONLY
SHEET 10 OF 16

STATE OF VERMONT
 DEPARTMENT OF HIGHWAYS

TOWN OF CHESTER

ROUTE NO. 103 LOG STA. _____

GENERAL PLAN
AND ELEVATION







SCALE AS NOTED

SURVEYED BY R.S.

DRAWN BY H.H.S. CHECKED BY J.T.H.

PROJECT NO. F 025-1181

SHEET 36 OF 208

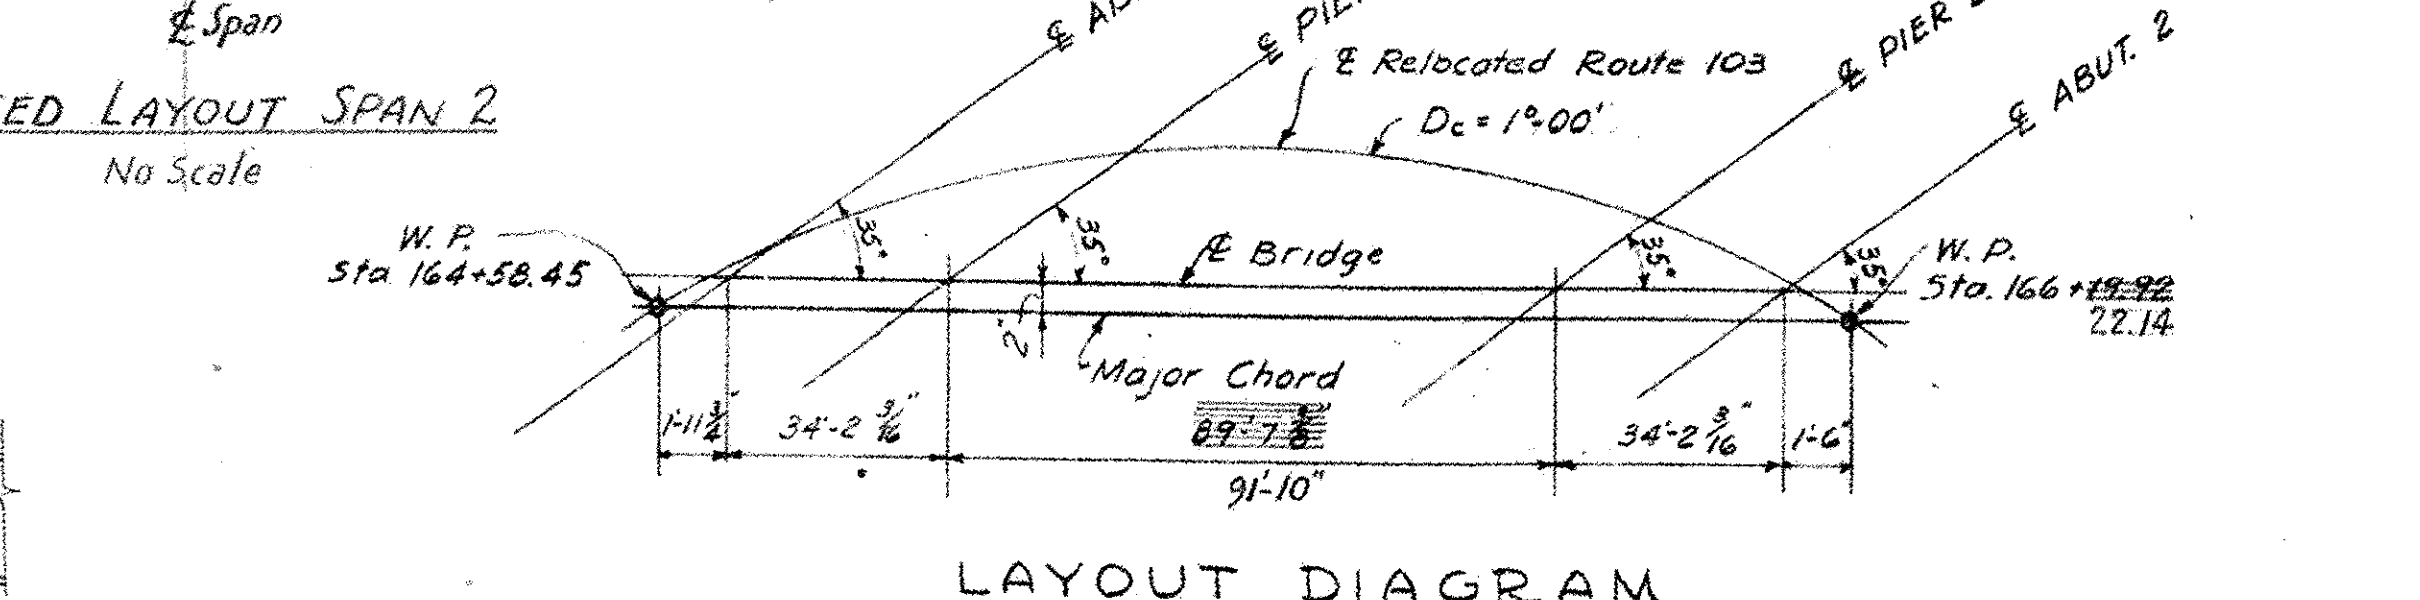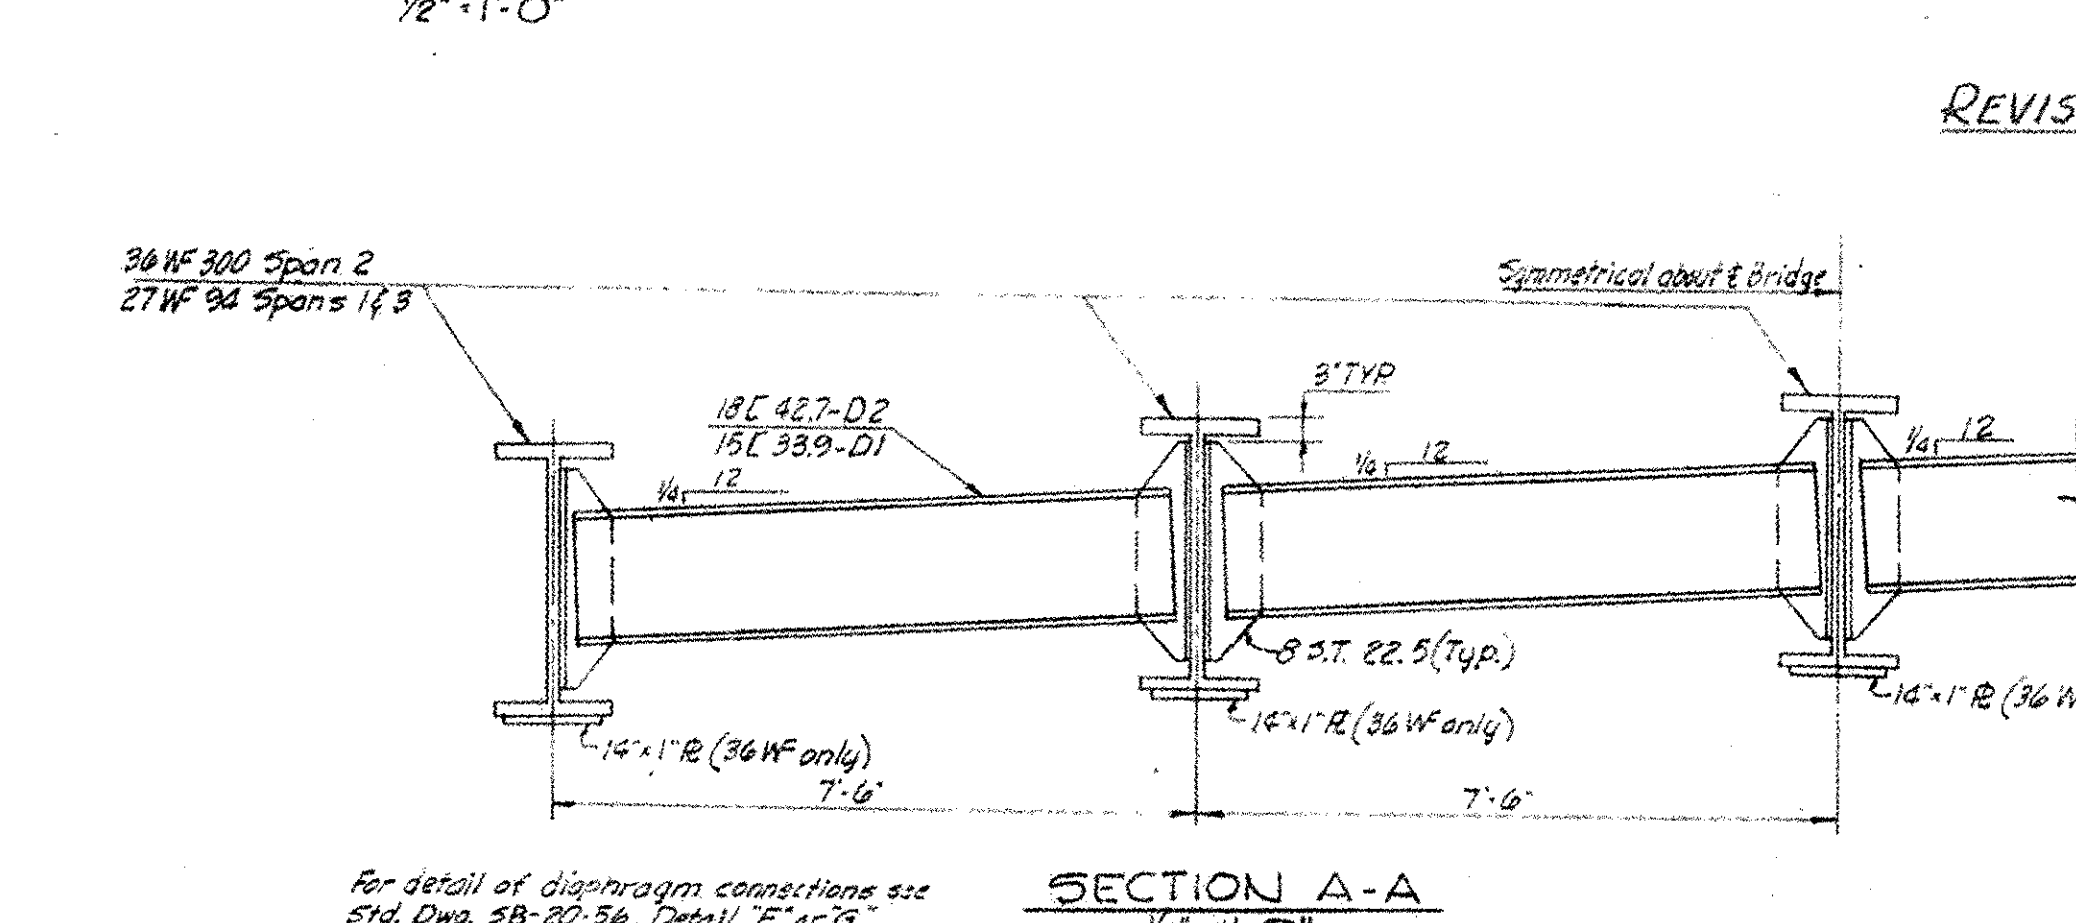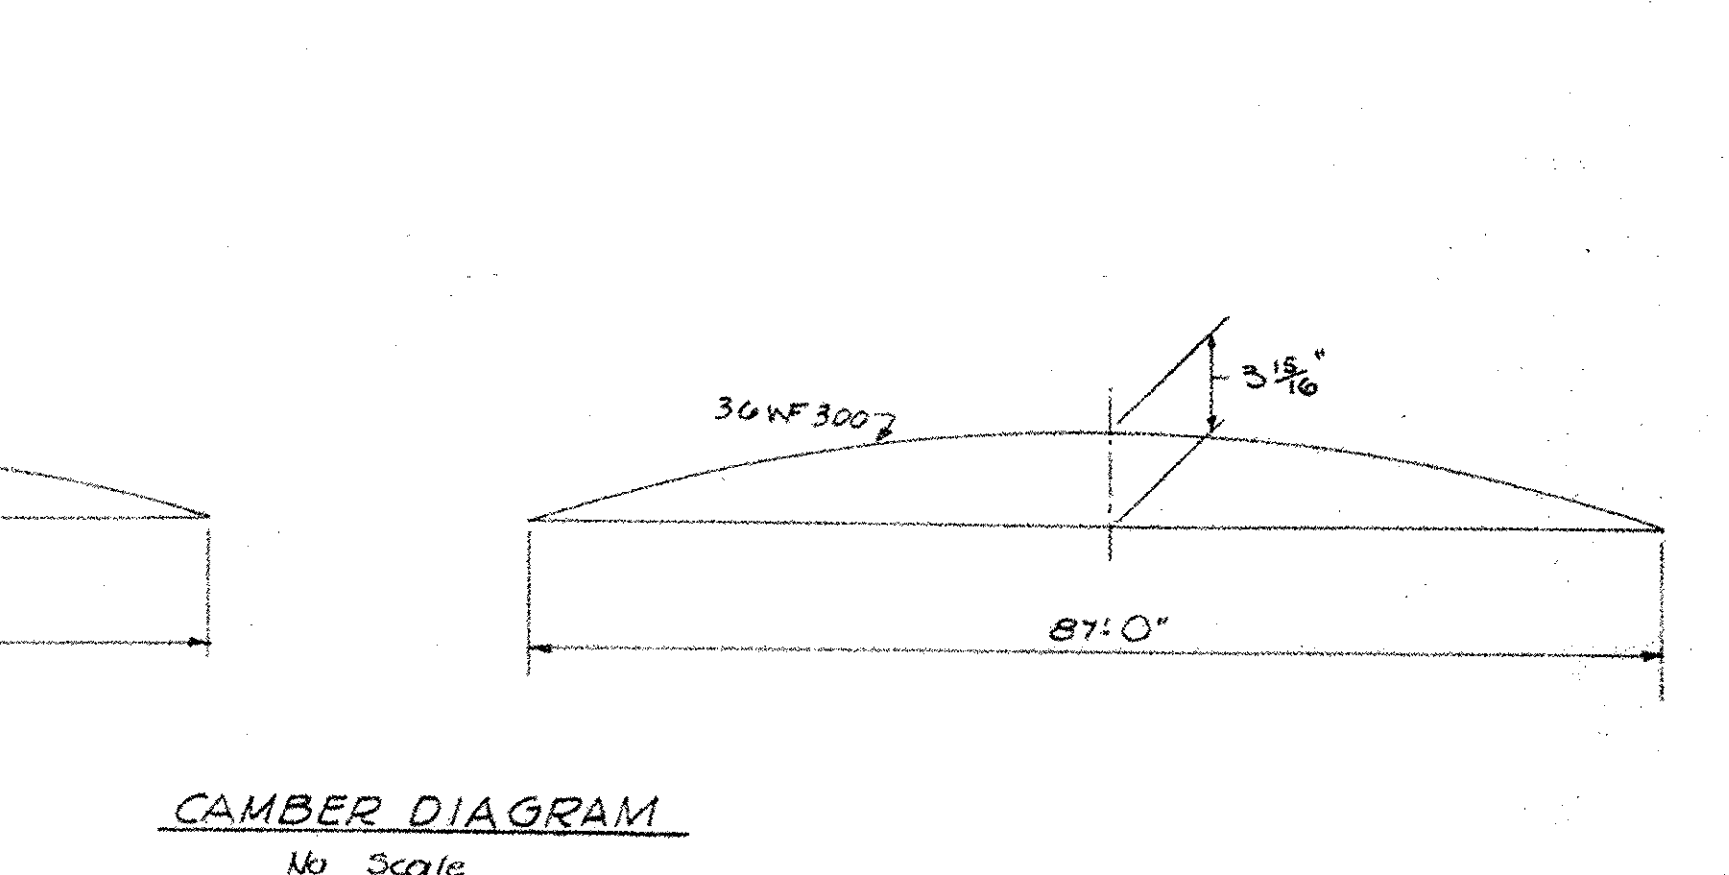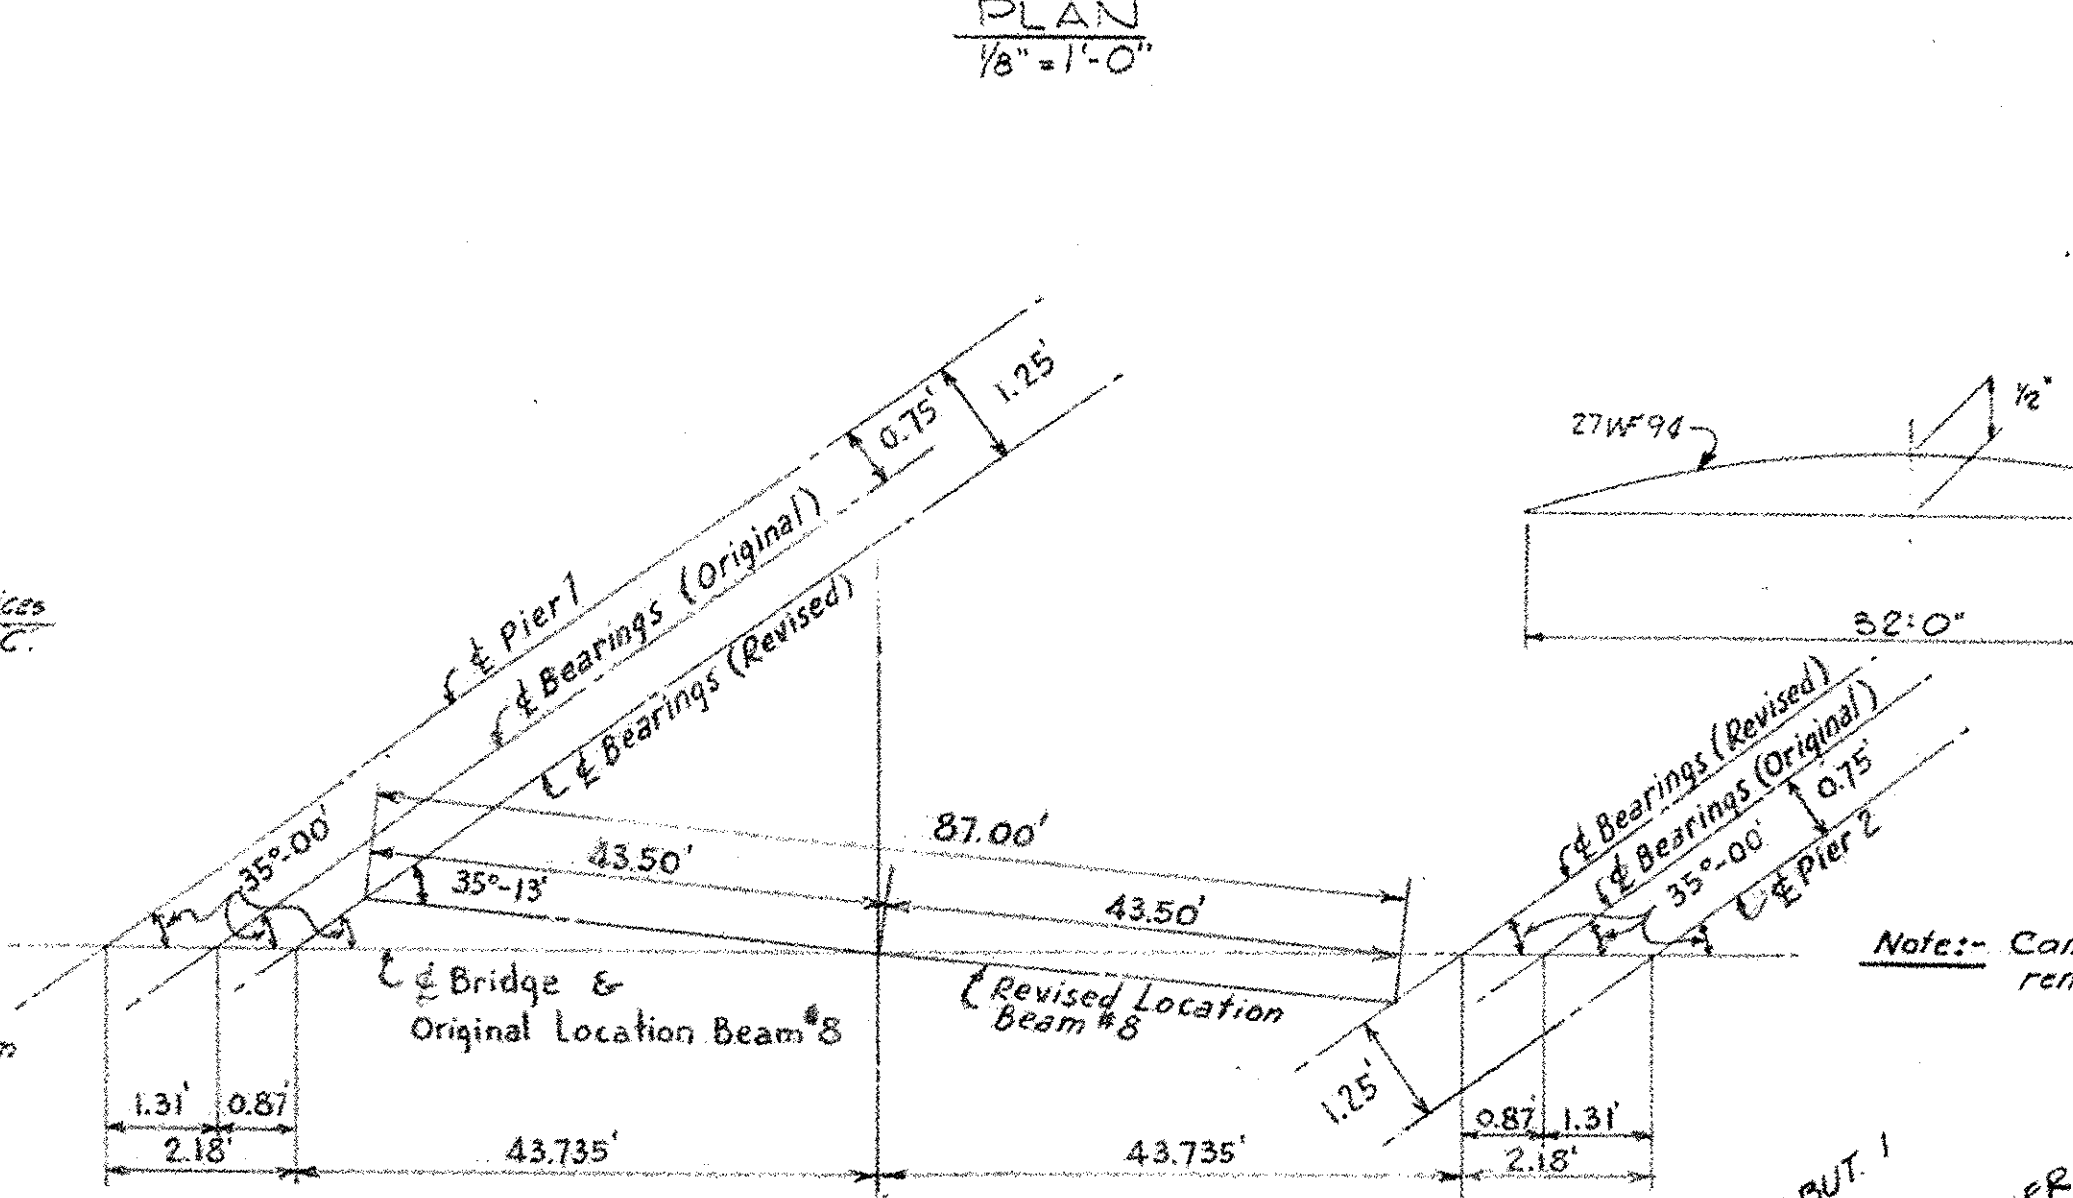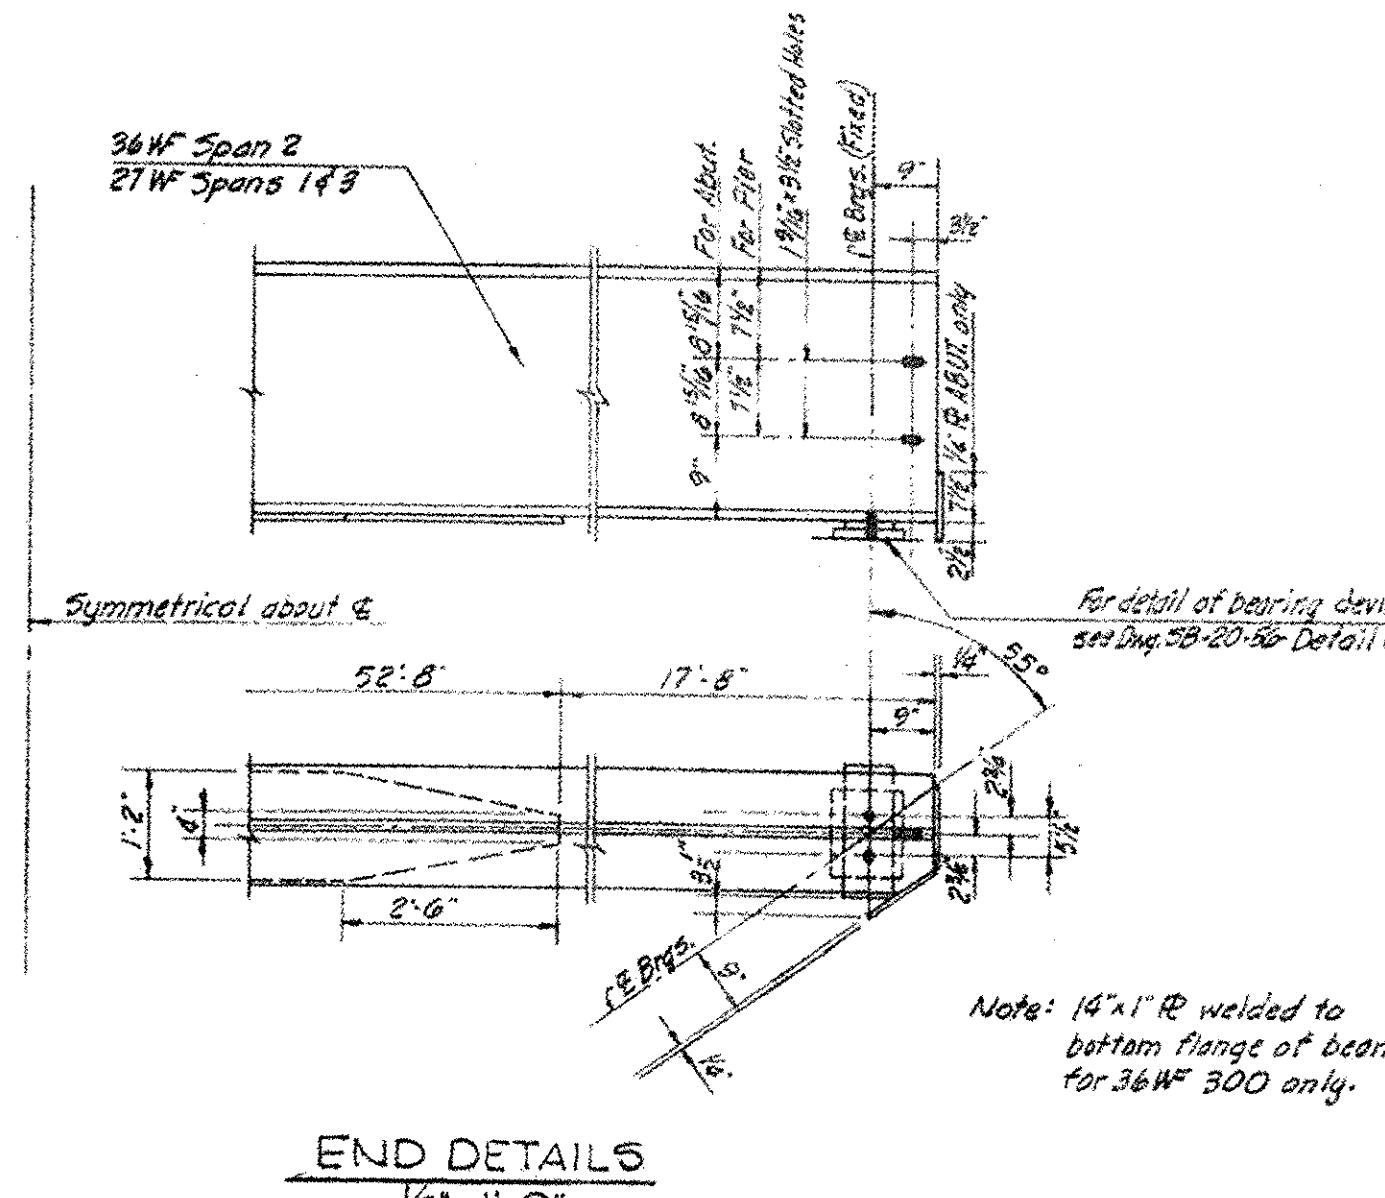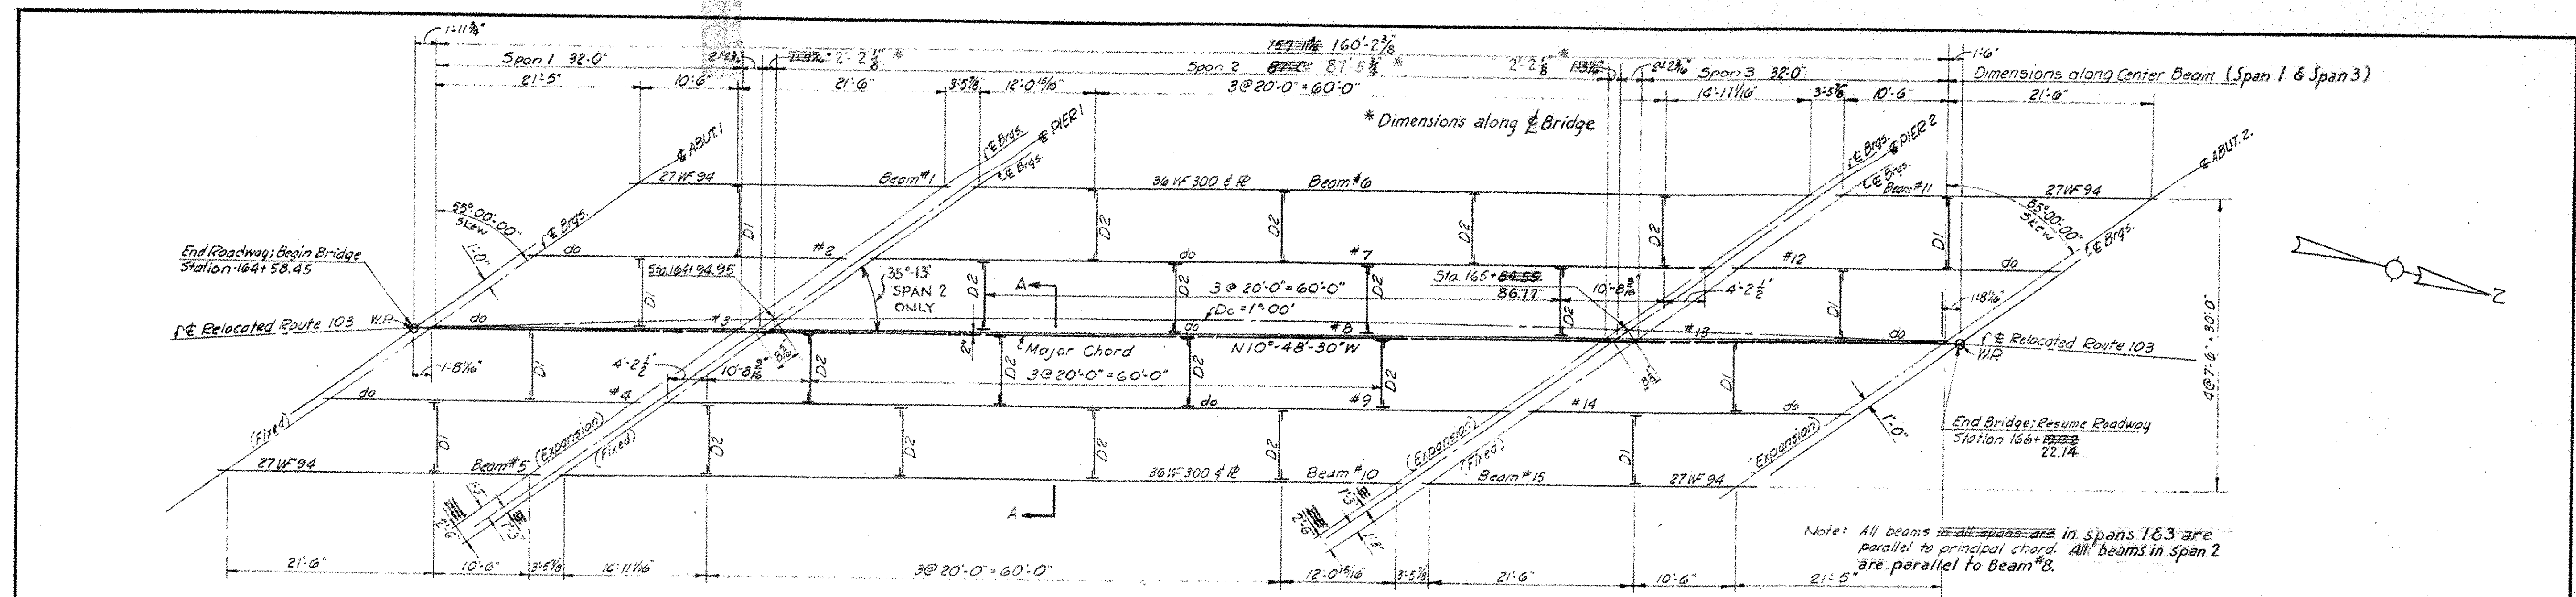

ESTIMATE OF SHEET QUANTITIES					
ITEM NO.	ITEM DESCRIPTION	FINAL	UNIT	NEAT	OVERRUN TOTAL
404-A	Structural Steel	193,600	LB.	189,815	3,785 193,600

BRIDGE 16
FOR REFERENCE ONLY
SHEET 11 OF 16

STATE OF VERMONT
DEPARTMENT OF HIGHWAYS

TOWN OF CHESTER
ROUTE NO. 103 LOG STA. _____
FRAMING PLAN

SCALE AS NOTED
SURVEYED BY R.S.
DRAWN BY H.M.S. CHECKED BY J.T.H.
PROJECT NO. F 025-1(8)
SHEET 37 OF 208

INDEX OF SHEETS

SHEET NO. 1	TITLE PAGE
2	TYPICAL CROSS-SECTION OF IMPROVEMENT DOUBLE TACK COAT OF REFINED TAR, WITH PEASTONE SEAL, ITEM 312-A
3	BANKING AND WIDENING TABLES
4-5	EARTHWORK SHEETS
6	QUANTITY SHEET (DRAINAGE)
7	QUANTITY SHEET (ITEMS)
8-9	PLAN AND PROFILE
10	PRELIMINARY INFORMATION SHEET
11	STRUCTURE SHEET-BRIDGE PLAN AND ELEVATION
12	STRUCTURE SHEET-ABUTMENT NO.1 (DETAIL)
13	STRUCTURE SHEET-ABUTMENT NO.2 AND LT. WING (DETAILS)
14	STRUCTURE SHEET-ABUTMENT NO.2 AND RT. WING (DETAILS)
15	STRUCTURE SHEET-SUPERSTRUCTURE
16	STANDARD STRUCTURE SHEET SB-55-1 BRIDGE RAILING
17	STANDARD STRUCTURE SHEET SB-20 TYPICAL DETAILS
18	STANDARD STRUCTURE SHEET SB-11 BARRICADES, SIGNS AND LIGHTS (BRIDGE)
19	STANDARD STRUCTURE SHEET S-40 BARRICADES, SIGNS AND LIGHTS (ROADWAY)
20	STANDARD STRUCTURE SHEET S-41 TYPICAL GRADING
21	STANDARD STRUCTURE SHEET S-46-45 PROJECT MARKERS
22	STANDARD STRUCTURE SHEET S-47-45 PIPE CULVERTS
23	STANDARD STRUCTURE SHEET S-45-45 TWO CABLE GUARD RAIL
24	STANDARD STRUCTURE SHEET S-51-48 STEEL BEAM GUARD RAIL-TYPE II-SAFETY-BEAM
25	STANDARD STRUCTURE SHEET S-52-48 STEEL BEAM GUARD RAIL-TYPE I-FLEX-BEAM
26-44	CROSS-SECTIONS

STANDARD STRUCTURE SHEETS APPROVED BY THE CHIEF ENGINEER, VERMONT STATE DEPARTMENT OF HIGHWAYS.

S-40 JUNE 10, 1950
 S-46-45 JAN. 16, 1950
 S-47-45 JAN. 16, 1950

 S-51-48 NOV. 10, 1947
 S-52-48 NOV. 10, 1947

**STATE OF VERMONT
 STATE HIGHWAY DEPARTMENT**



**PLAN AND PROFILE OF PROPOSED
 STATE HIGHWAY**

**TOWN OF THETFORD
 COUNTY OF ORANGE
 VERMONT ROUTE 113-A
 CHELSEA-THETFORD CENTER ROAD**

BEGINNING AT A POINT 3,181.5 FEET SOUTHWESTERLY OF THE INTERSECTION OF VERMONT ROUTES 113-A AND 113 AND EXTENDING NORTHEASTERLY 2,100 FEET ON VERMONT ROUTE 113-A

LENGTH OF ROADWAY 2,021.0 FT.=0.383 MI.
 LENGTH OF BRIDGE 79.0 FT.=0.015 MI.
 LENGTH OF PROJECT 2,100.0 FT.=0.398 MI.

FED. ROAD DIV. NO.	STATE	PROJ. NO.	FISCAL YEAR	SHEET NO.	TOTAL SHEETS
1	VT.	S 72 (1)	WAR	1	44

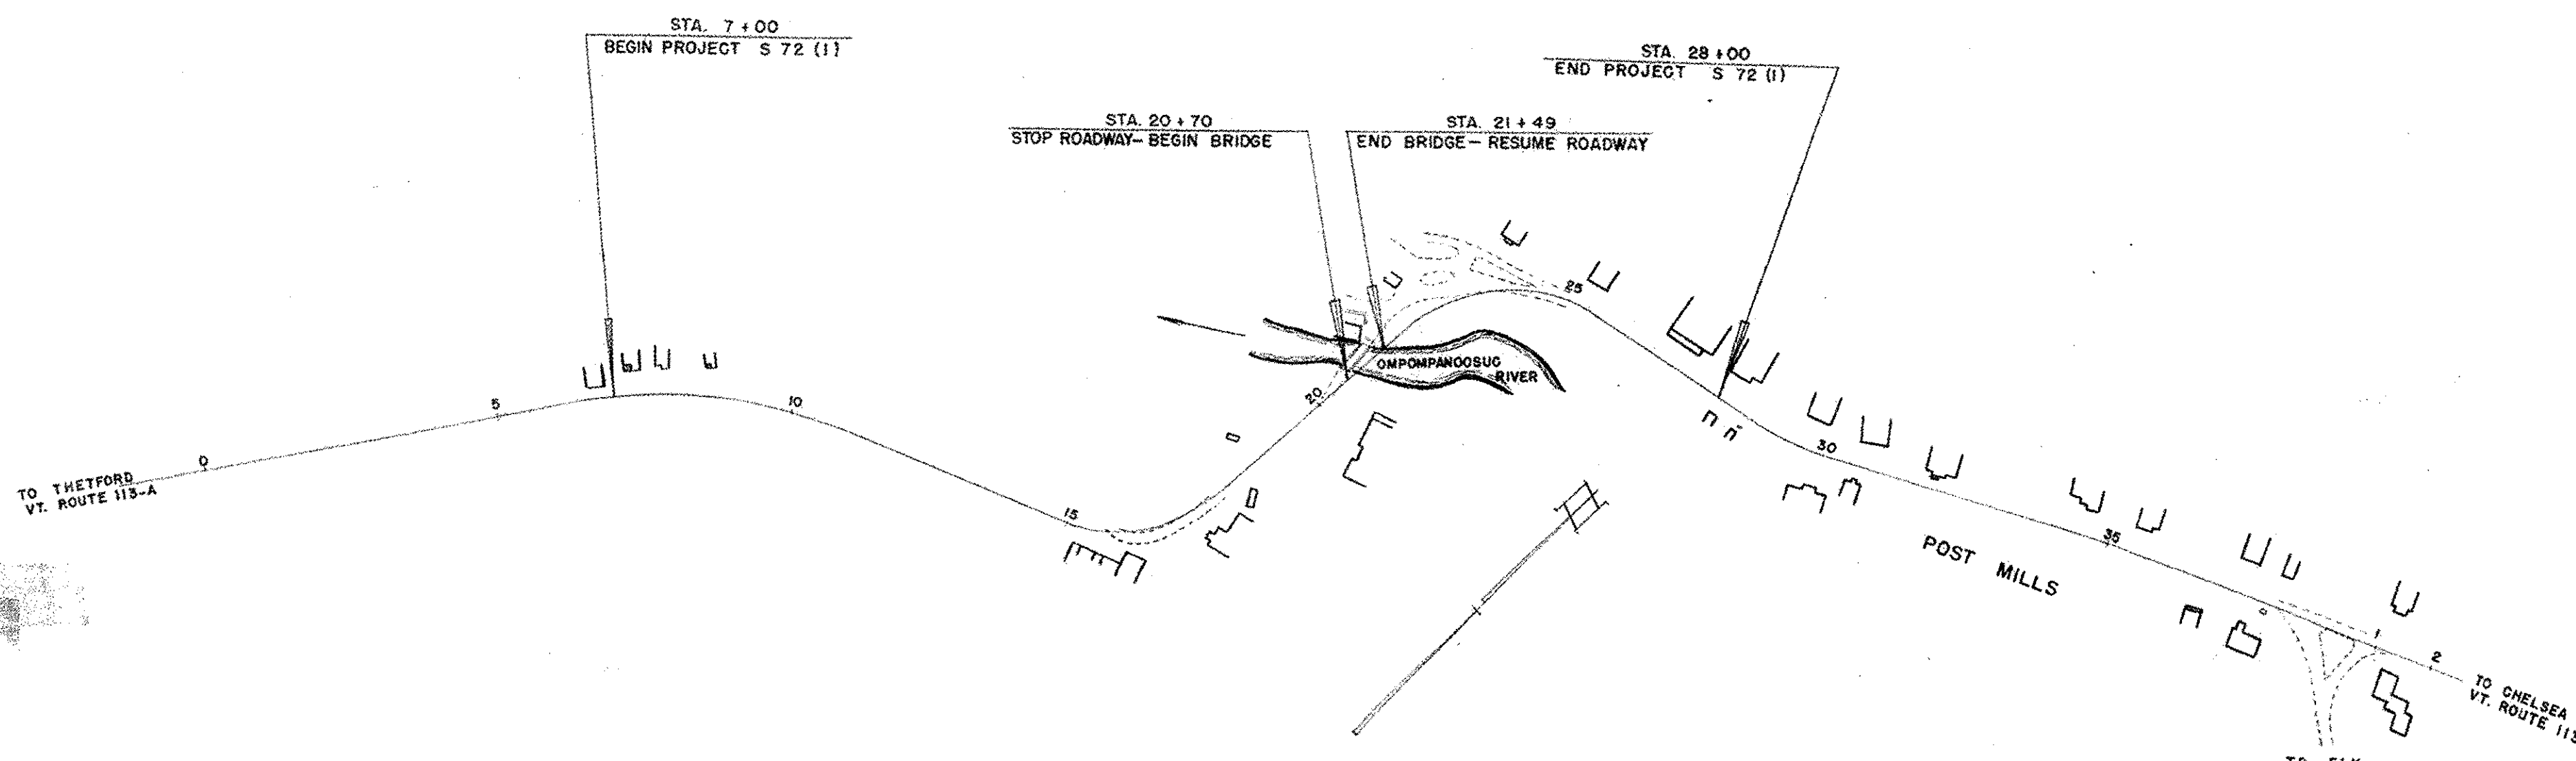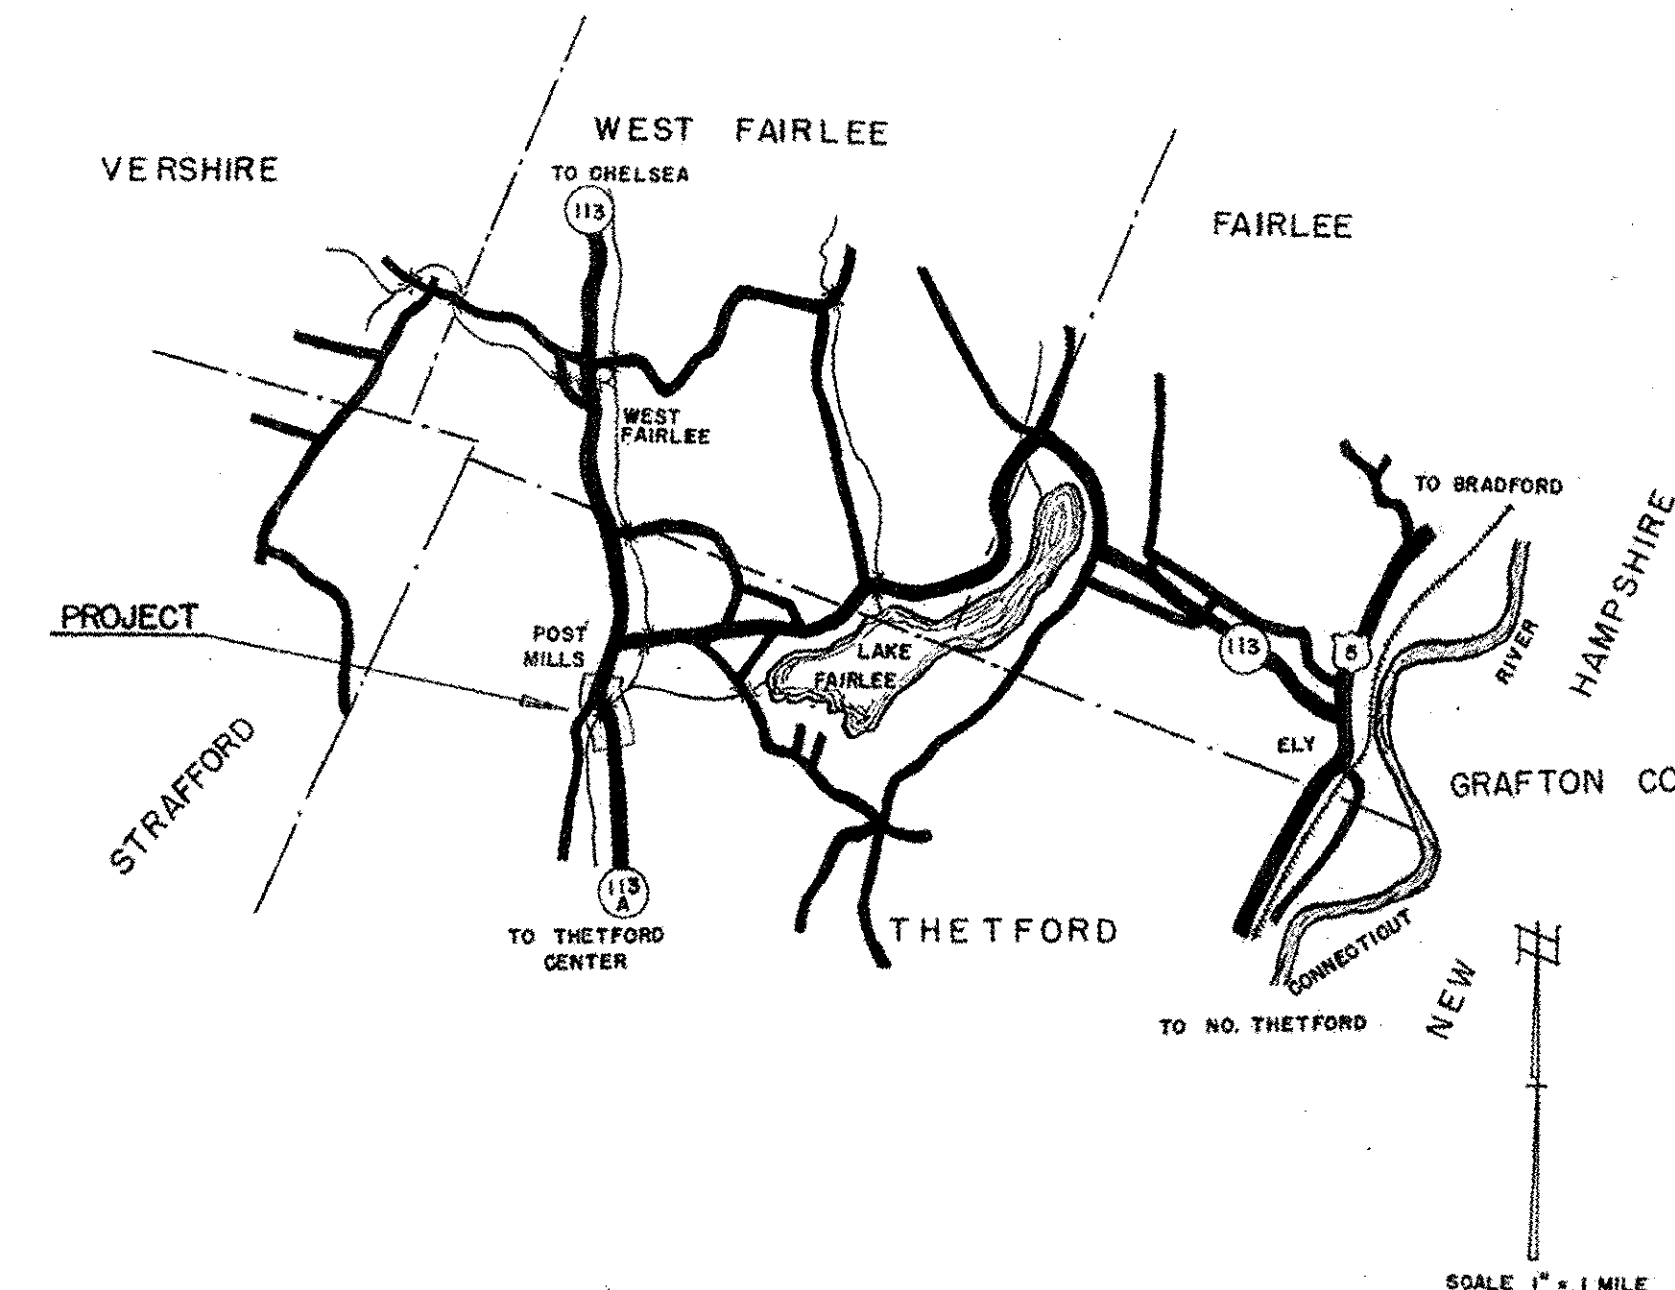

CO TO FEI
 UN GU
 RA RE
 CE SU
 CU DR
 PO TR
 TE
 TH

PROJECT Thetford - Post Mills Bc
 SHEET S-72(1)
 DATE W. Ben & Co. Const. Co. 11/10/47
 CONTRACTOR Miller Const. Co.
 LOCATION Rt. 113-A
 YEAR 19

GROUND ELEVATION DATUM LINE
 GRADE ELEVATION DATUM LINE

CURVE DATA

DEFLECTION ANGLE	Δ
DEGREE OF CURVE	D
RADIUS OF CURVE	R
TANGENT DISTANCE	T
LENGTH OF CURVE	L
EXTERNAL DISTANCE	E
POINT OF INTERSECTION	P. I.
POINT OF CURVE	P. C.
POINT OF TANGENT	P. T.
POINT ON TANGENT	P. O. T.

SCALES

TITLE	1" = 200'
TYPICAL	1" = 2'
PLAN	1" = 30'
PROFILE HORIZONTAL	1" = 30'
PROFILE VERTICAL	1" = 10'
CROSS SECTIONS	1" = 3'

APPROVED: FEB. 16, 1951
H. Edgmont
 CHIEF ENGINEER

SUBMITTED BY ORDER OF THE STATE HIGHWAY BOARD

**BRIDGE 25
 FOR REFERENCE ONLY
 SHEET 12 OF 16**

DEPARTMENT OF COMMERCE
 BUREAU OF PUBLIC ROADS
 RECOMMENDED FOR APPROVAL
 DISTRICT ENGINEER DATE
 APPROVED


THESE PLANS ARE SUBJECT TO SUCH REVISIONS AS MAY BE REQUIRED BY THE BUREAU OF PUBLIC ROADS OR THE COMMISSIONER OF HIGHWAYS.
 CONSTRUCTION IS TO BE CARRIED ON IN ACCORDANCE WITH THE PLANS AND THE STANDARD ROAD AND BRIDGE SPECIFICATIONS OF 1948, AS APPROVED JULY 25, 1949 BY THE BUREAU OF PUBLIC ROADS, INCLUDING ALL SUBSEQUENT APPROVED REVISIONS AND SUCH REVISED SPECIFICATIONS AND SPECIAL PROVISIONS AS ARE SUBMITTED WITH THE PLANS.

APPROVED NOV. 13, 1950 <i>[Signature]</i> BRIDGE ENGINEER	APPROVED FEB. 16, 1951 <i>[Signature]</i> HIGHWAY ENGINEER	APPROVED FEB. 24, 1951 <i>[Signature]</i> DISTRICT HIGHWAY COMMISSIONER	SERIES S No. 72 (1) FILED SHEET 1 OF 44
---	--	---	--


BRIDGE DATA		
Item	Present	Proposed
Overall Span along & Road	52'-8"	70'-0"
roadway Width Face to Face of Curb	16'-0"	30'-0"
Clear Span Along & of Road	50'-0"	75'-0"
Clear Span Normal to Stream	47'-0"	71'-0"
Clear Height to Low Bridge Seat	23'-0"	2'-0"
Max. High Water Elev.	633.2	631.0
Waterway Area to Low Bridge Seat	1000 sq ft	1290 sq ft
Normal to Max. H.W. Elev.	400 sq ft	520 sq ft
To Stream Us Normal H.W. Elev.	2600 sq ft	300 sq ft
Stream Velocity	10 ft/min	10 ft/min
Drift & Scour	None	None

Sheet No.	Description
10	Preliminary Information Sheet
11	Plan & Profile
12	Bridge Plan & Elevation
13	Abutment No. 1 (Detail)
14	Abutment No. 2 & Lt. Wing (Details)
15	Abutment No. 2 - Rt. Wing (Details)
16	Superstructure
17	Std. Pipe & Spindle Rail - Std. Dwg. SB-551
18	Typical Details - Std. Dwg. SB-201 (Det. A, C, D, E, F, H, J, K, & L)
19	Barricades, Signs & Lights - Std. Dwg. SB-11
20	Steel Beam Guard Rail - Std. Dwg. SB-148
21	Steel Beam Guard Rail - Std. Dwg. SB-148

Parcel Instrument Date	Grantor	Grantee	Recorded Book	Recorded Page	Recorded Date	Remarks
#3 A & B W.D.O.E. 11-1-50	FRANK E. HATCH	ST. OF VT.	37	618-19	12-22-50	
#4 A & B W.D.O.E. 11-14-50	WALTER A. MALMQUIST	ST. OF VT.	39	4-5-6	1-17-51	
#5 W.D.O.E. 10-25-50	CARL S. & LINNA S. KELLEY	ST. OF VT.	37	610-11	12-22-50	
#6 W.D.O.E. 10-25-50	EDWIN S. & CLARA G. KNIGHT	ST. OF VT.	37	617-18	12-22-50	Culvert 25' x 12'

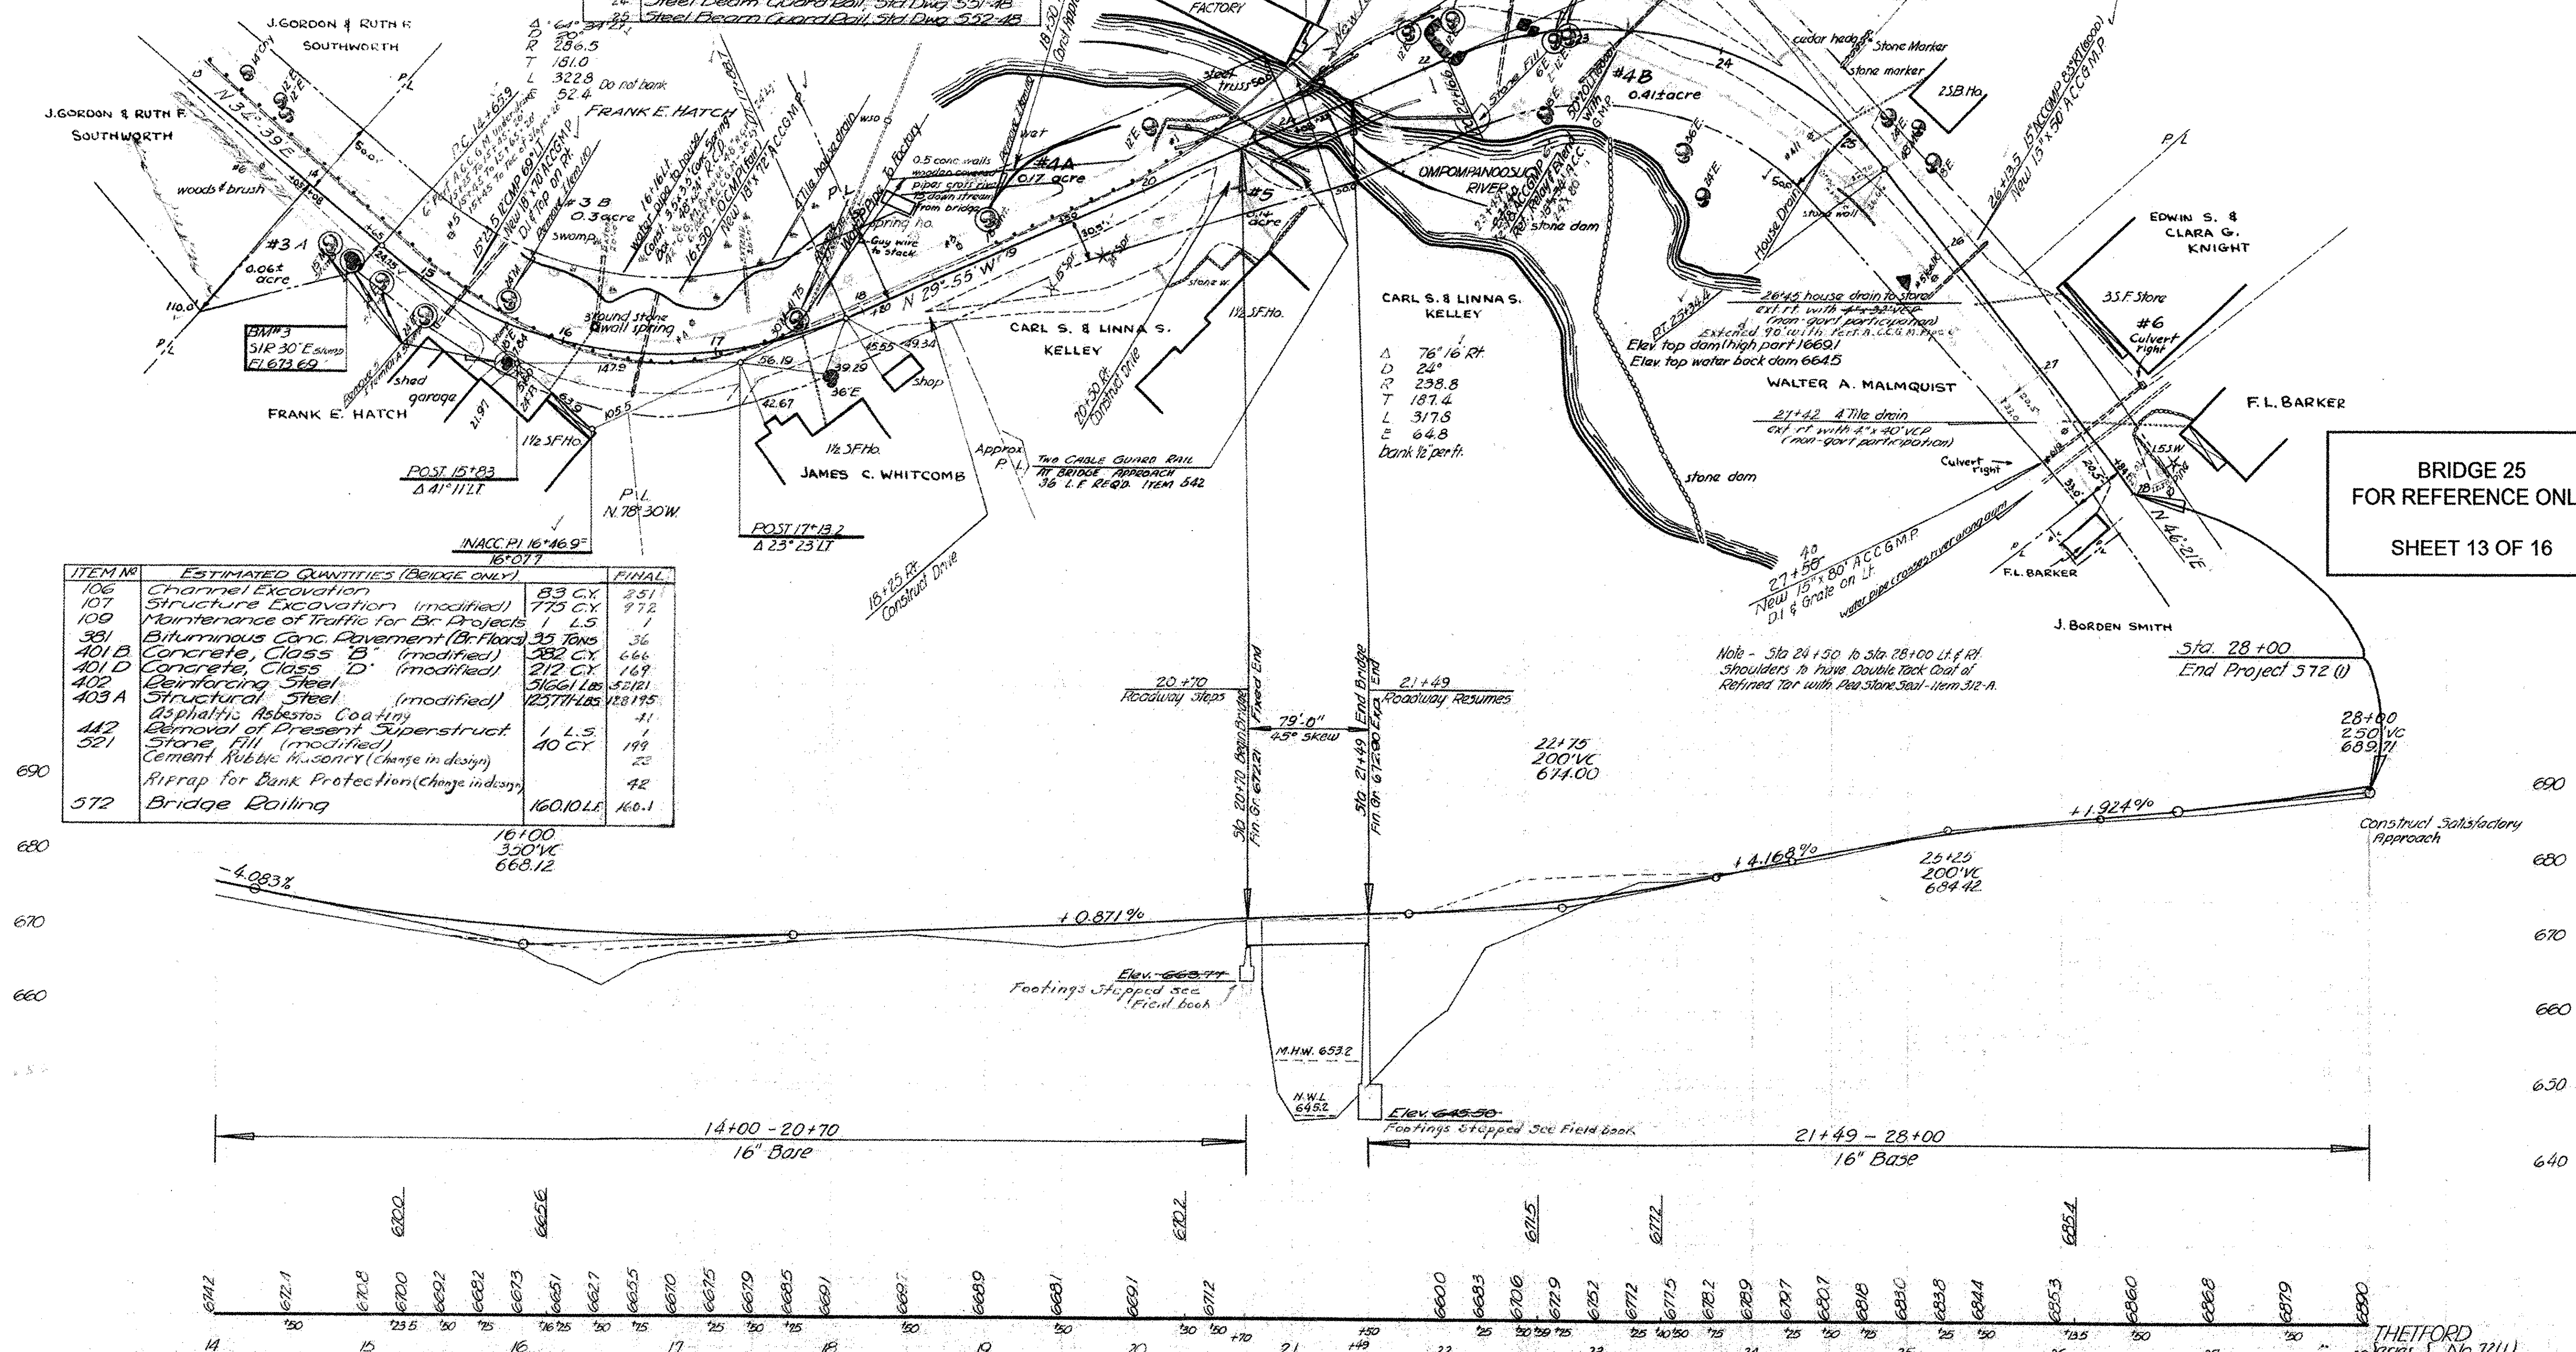

ITEM NO.	ESTIMATED QUANTITIES (BRIDGE ONLY)	FINAL
106	Channel Excavation	83 CY 251
107	Structure Excavation (modified)	775 CY 772
109	Maintenance of Traffic for Br Projects	1 L.S. 1
351	Bituminous Conc. Pavement (Br. Floor)	35 Tons 36
401 B	Concrete, Class B (modified)	382 CY 666
401 D	Concrete, Class D (modified)	212 CY 169
402	Reinforcing Steel	51661 Lbs 52121
403 A	Structural Steel (modified)	125711 Lbs 128195
412	Asphaltic Asbestos Coating	1 L.S. 1
521	Removal of Present Superstruct Stone Pill (modified)	40 CY 199
	Cement Rubble Masonry (change in design)	22
	Rifrap for Bank Protection (change in design)	42
572	Bridge Railing	160.10 LF 160.1

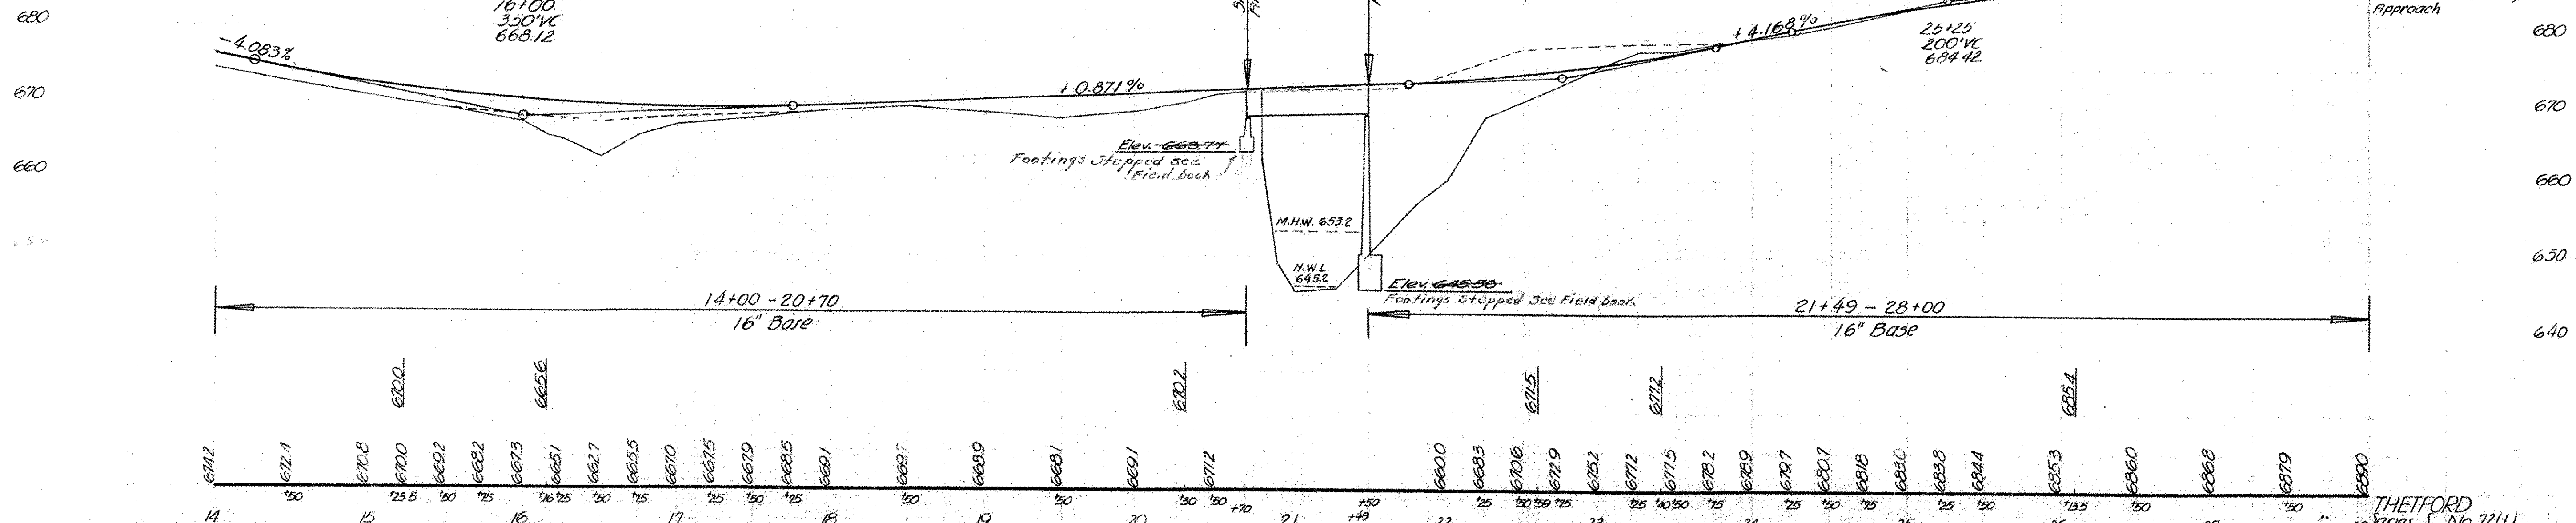

B.M. #3 16' Rt. 14+56 51R 30' Elm Stump - Elev. 673.69
 B.M. #4 15' Lt. Sta 21+37 Spot on Conc. Loading Platform - Elev. 675.11

BRIDGE 25
 FOR REFERENCE ONLY
 SHEET 13 OF 16



THETFORD
 Series 5 No. 72(1)
 Sheet 9 of 44

NEW HIGHWAY SECT. SEE SHEET 2 of 44

SCALE

NEW HIGHWAY PROFILE ALONG ϕ SEE SHEET 9 of 44

SCALE

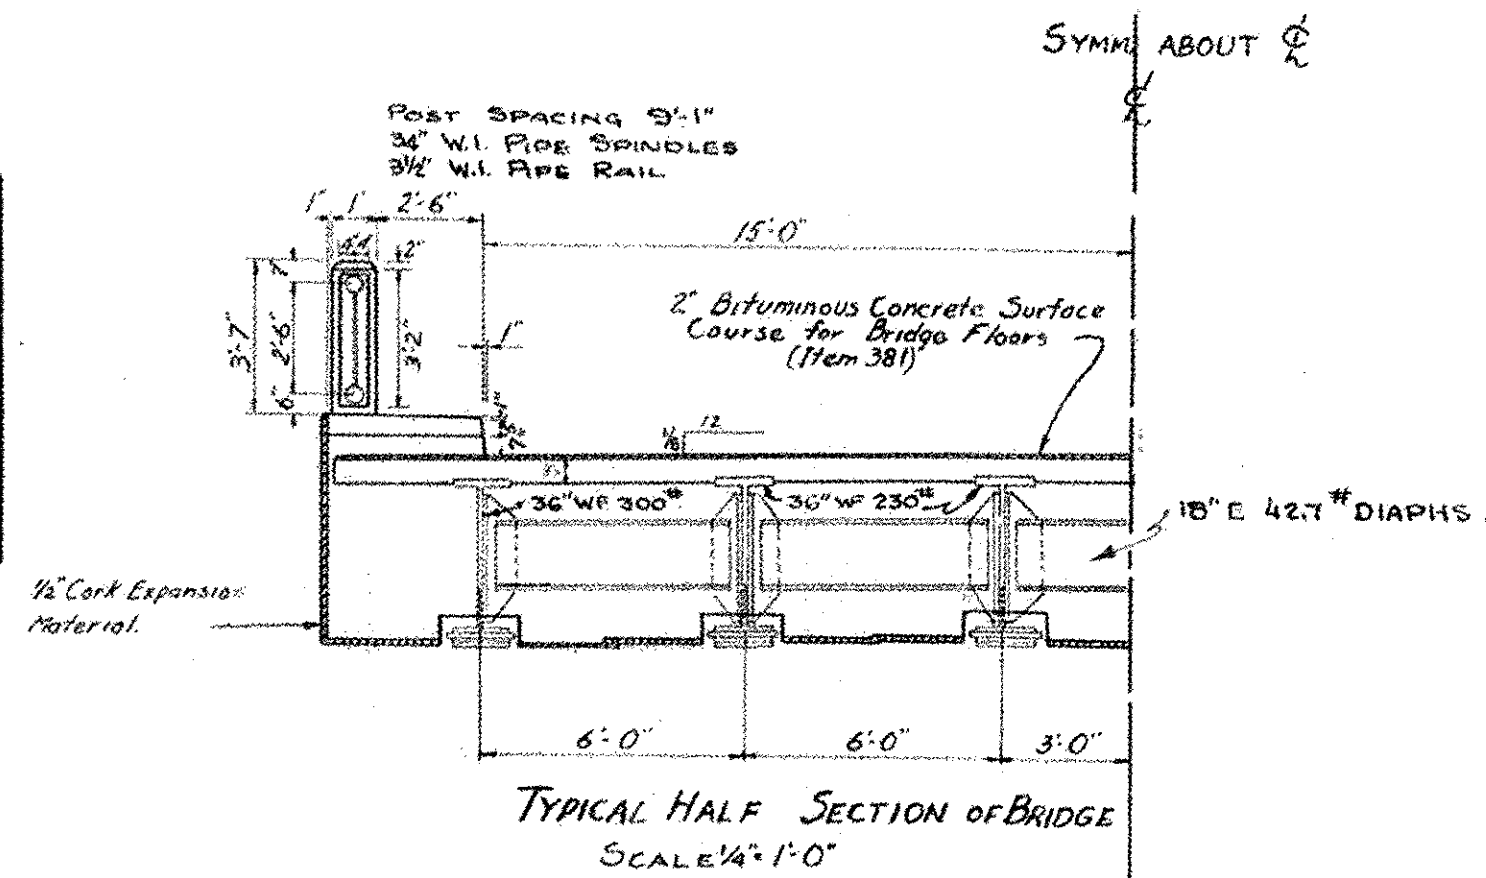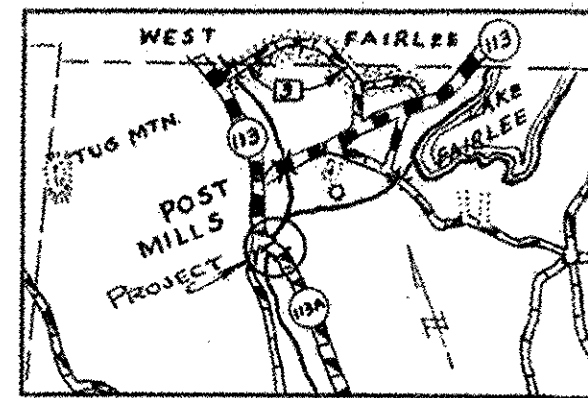

TYPICAL HALF SECTION OF BRIDGE
SCALE 1/4" = 1'-0"

PLAN SEE SHEET 9 of 44

SCALE

PROFILE OF PROPOSED STREAM CHANNEL

SCALE



Highway No. 113-A Name of Highway _____
 Structure No. _____ County ORANGE Town THETFORD
 Approved _____ Date _____
 Bridge Engineer, Dist. No. 9

EXISTING STRUCTURE

1. Posted loading of existing structure H-10
2. Location and type of existing structure LOG STA 392+32 STEEL RONY TRUSS, OPEN GRID FLOOR
3. Underclearance elevation of existing structure 23'-0"
4. What disposition should be made of the existing structure and probable cost of removal \$200.00
5. Should existing structure be utilized to maintain traffic during construction of new structure Yes
6. Should new temporary structure be built No
7. Ordinary high water surface elevation of existing structure or structures up or down stream 645.2
8. Extreme high water at existing structure 653.2
9. Span and waterway area below ordinary high water surface elevation of existing structure
50 FT. SPAN 400 SQ. FT. WATERWAY
10. Type of foundation under existing abutments LEDGE
11. If existing structure is to be widened or extended, attach sketch containing complete data to prepare plans for widening or extending and to determine safe loading capacity, substructure, and superstructure.

NEW STRUCTURE

1. Recommended type of structure WF BM. CONCRETE DECK
2. Recommended clear span or spans
Measured parallel to ϕ new highway 75'-0"
Measured at right angles to ϕ stream 50'-2"
3. Are there objections to a pier in the stream, answer yes or no No
4. Ordinary high water elevation of new structure 645.2
5. Ordinary elevation of water at new structure 645.2
6. Extreme high water elevation of new structure 651
7. Does stream reach its maximum high water elevation rapidly No Is ordinary rise rapid No
8. Low water elevation at new structure 640.6
9. Drainage area in acres above structure 34,000 Character of terrain HILLY
10. Is stream ever dry No
11. Velocity of stream at high water stage 6 Ft./Sec. \pm
12. Recommended waterway area below ordinary high water elevation, measured at 1/2 mile of stream 500'
13. Does erosion occur No
14. Does stream carry light, medium or heavy drift and ice LIGHT
15. Should roadway be banked? If so how much per foot No
16. Are sidewalks required? If so, on what side Both sides? Yes 2'-6" Wide
17. Recommended type of pavement REINF. CONC. SLAB WITH BIT. CONC. WEARING SURF.
18. Traffic to be maintained under what item no.? 109 One or two ways? ONE Probable cost? \$300.00
19. Probable cost of clearing and grubbing stream channel at structure site NONE
20. Should provisions be made for public utilities NONE REQUESTED
21. Estimated allowable load on foundations Should piles be used? No. Est. lgh. \rightarrow

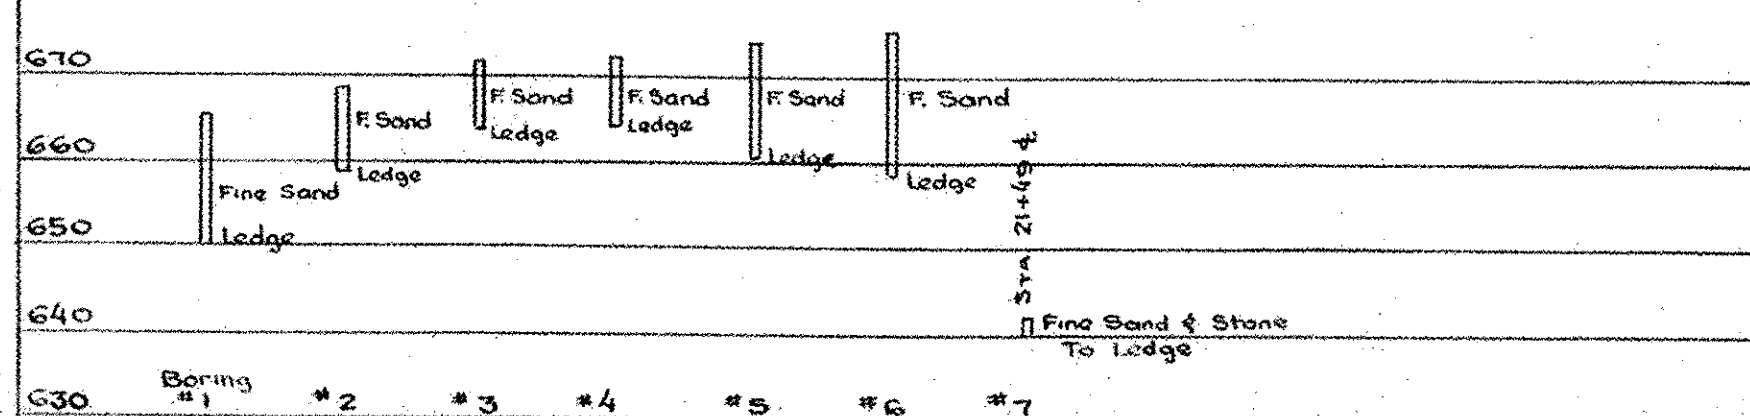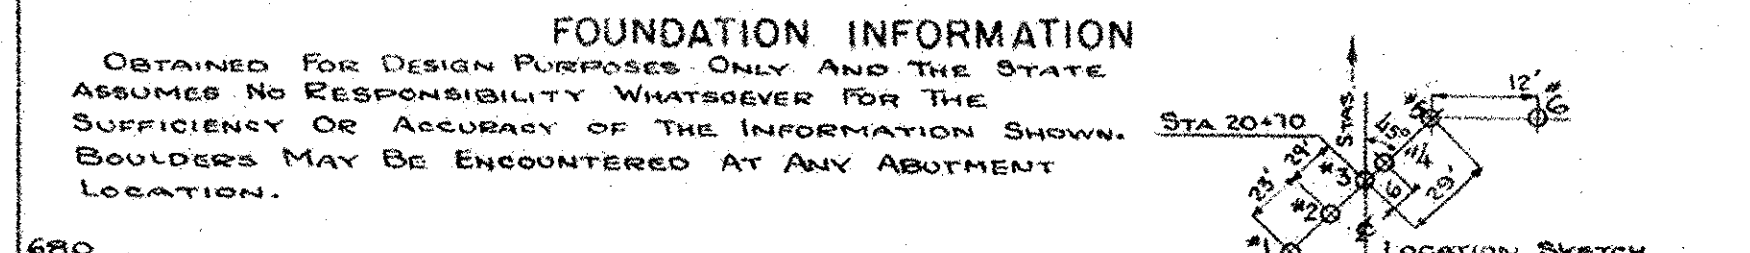

NOTES:
 CASING DIA. 2 1/2" WATER JET, CORE BIT INSIDE
 LEDGE OUTCROPPING THROUGHOUT ENTIRE SECTION

**BRIDGE 25
 FOR REFERENCE ONLY**
 SHEET 14 OF 16


STATE OF VERMONT
 DEPT. OF HIGHWAYS

RECOMMENDED FOR APPROVAL

APPROVED


CORRECT _____ APPROVED _____
 BRIDGE ENGINEER _____ COMMISSIONER OF HIGHWAYS _____

PROJECT No. 572(1)
 Sheet 10 of 44 Sheets

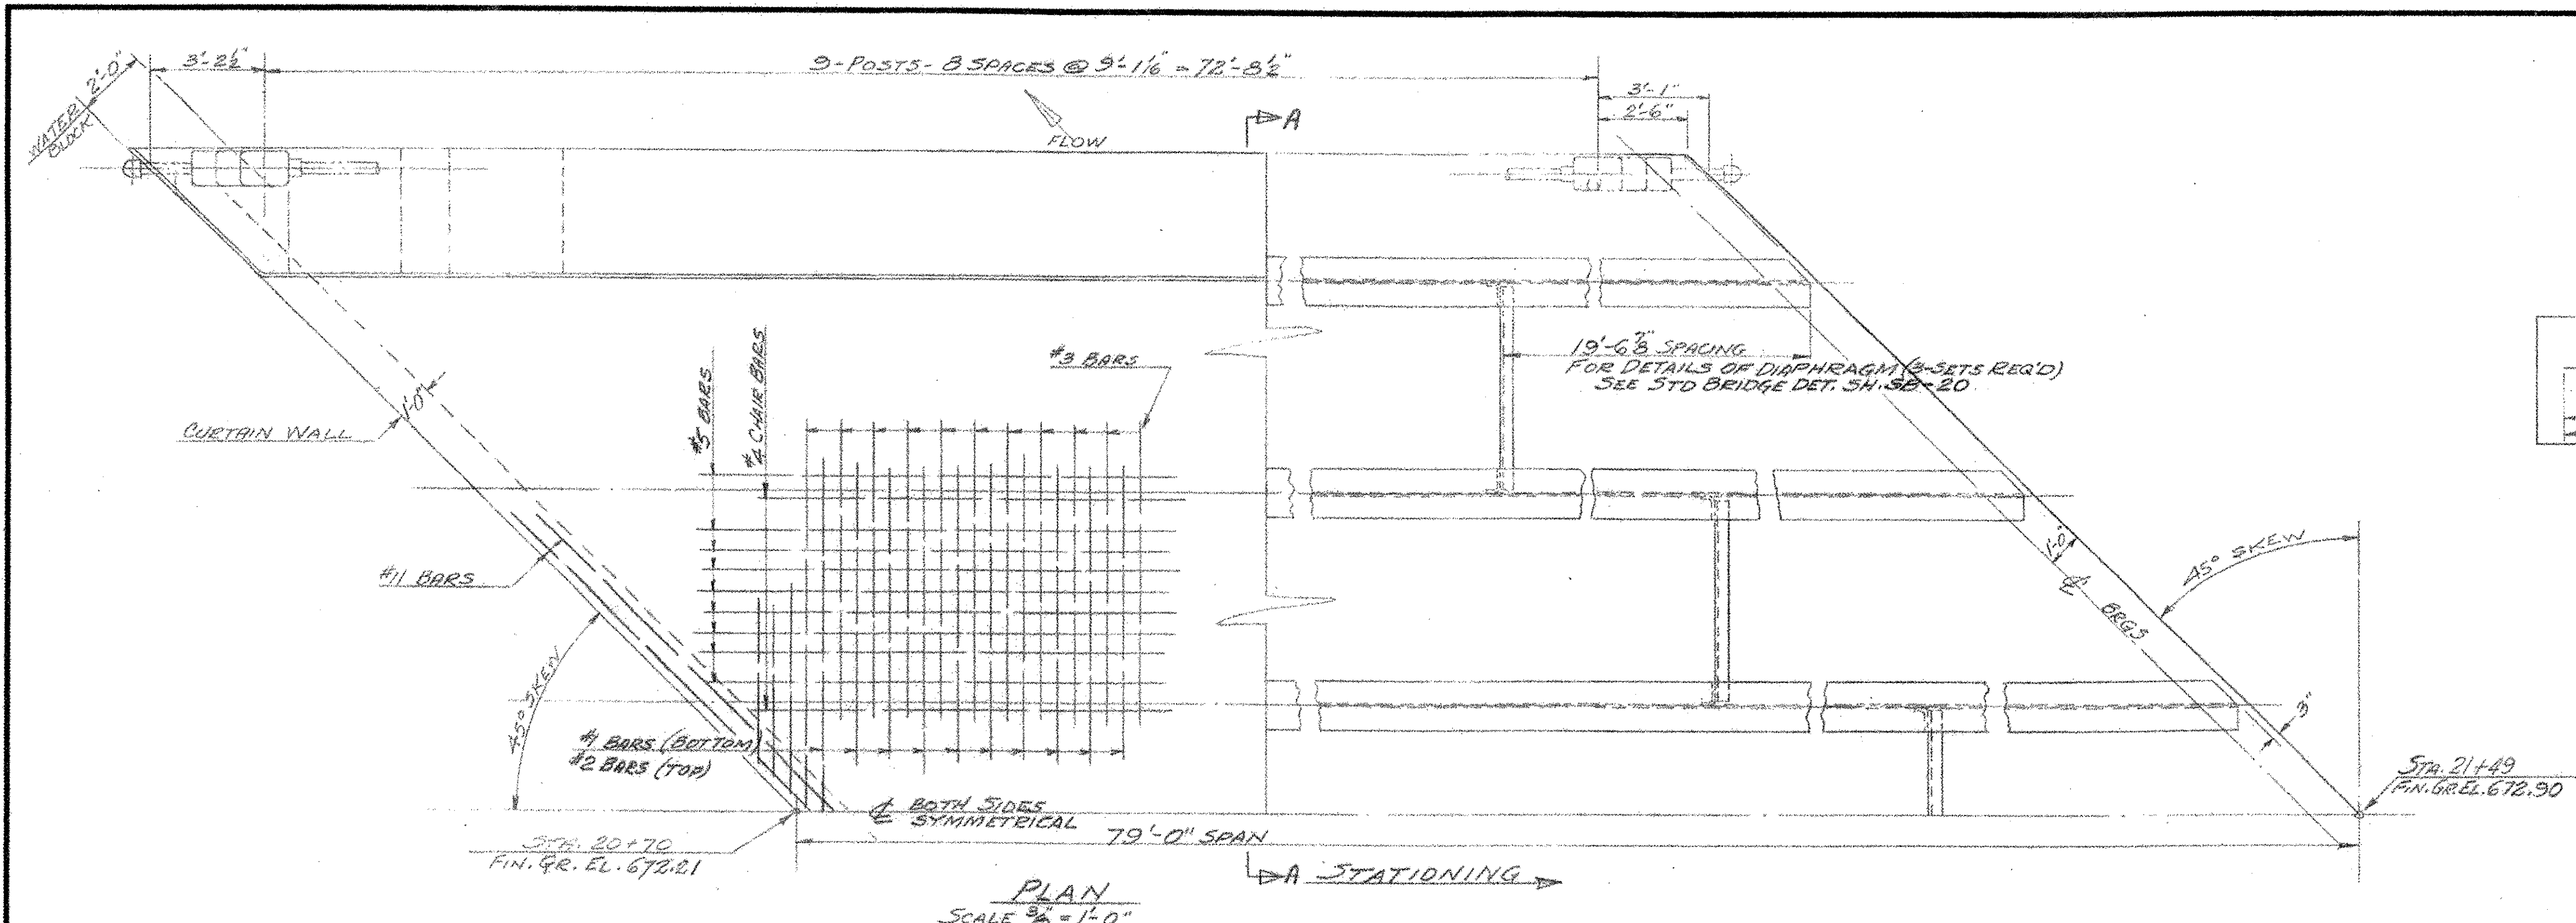

REINFORCING STEEL
(INTERMEDIATE GRADE BAR STOCK)

BAR NO.	NO.	SIZE	TOTAL LGTH	DETAIL
1A	87	5" φ	16'-6"	STRAIGHT
1B	87	5" φ	22'-6"	
2A	87	5" φ	17'-4"	
2B	87	5" φ	23'-4"	
3B	86	5" φ	24'-4"	
4	18	5" φ	28'-1"	STRAIGHT
5	204	1" φ	27'-6"	STRAIGHT
6	70	1" φ	6'-7"	
6S	16	1" φ	8'-8" 3'-9"	
7	238	5" φ	3'-3"	STRAIGHT
8	68	1" φ	5'-11"	
9	66	1" φ	27'-6"	
10	24	5" φ	27'-4"	STRAIGHT
11	8	5" φ	27'-4"	STRAIGHT
3A	86	5" φ	18'-1"	

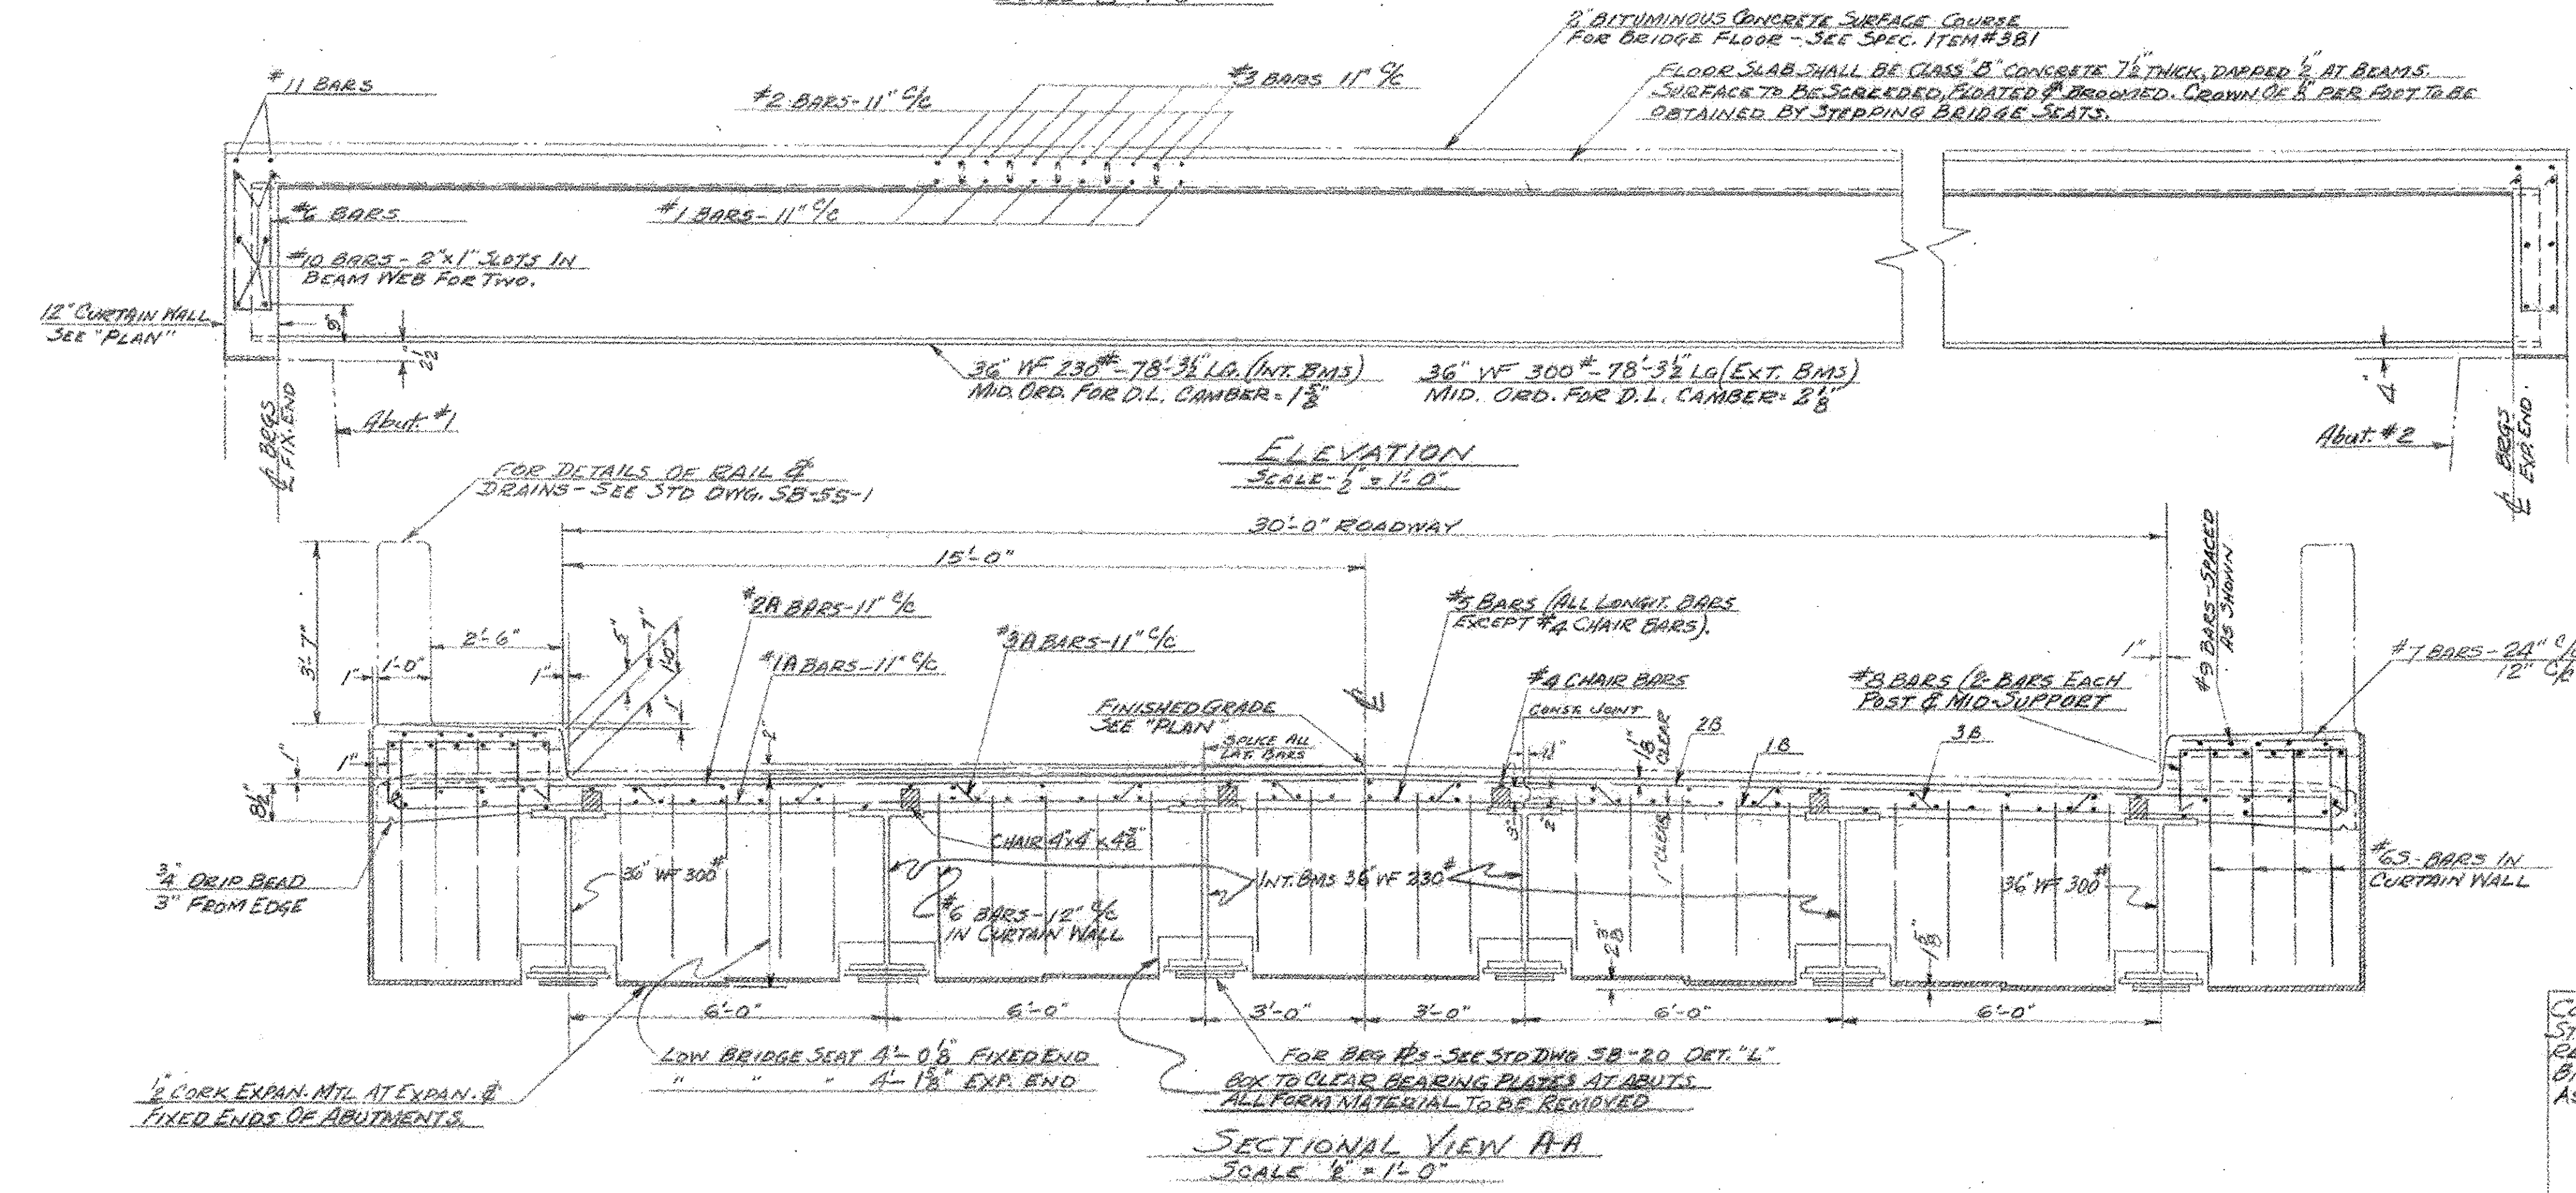

NOTES

THIS SHEET DOES NOT INCLUDE QUANTITIES FOR GUARD RAILING AND POSTS.

STRUCTURAL STEEL TO INCLUDE WE BEAMS, THE BEARING PLATE ASSEMBLIES AND INDICATED DIAPHRAGMS. ALL STEEL BEAMS SHALL BE ROLLED TO A TRUE CIRCULAR CAMBER, FULL LENGTH OF THE BEAM AND THE MIDDLE ORDINATE TO BE AS NOTED. FOR DIAPHRAGMS USE 18" C 42.7".

ALL STRUCTURAL STEEL SHALL BE PAINTED AS SPECIFIED UNDER ITEM 403 "A" OR "B" OF THE STATE OF VERMONT, DEPT. OF HIGHWAYS, STD. SPEC. FOR ROAD & BRIDGE CONSTRUCTION, DATED NOVEMBER 1943. THE FINAL COAT OF FIELD PAINT SHALL BE GREEN, UNLESS OTHERWISE DIRECTED BY THE ENGINEER.

THE ASPHALTIC ASBESTOS COATING SHALL BE APPLIED IN WINDOWS BEFORE JOINTS ARE POURED.

ALL MATERIALS AND CONSTRUCTION SHALL CONFORM TO THE STATE OF VERMONT, DEPT. OF HIGHWAYS, STD. SPEC. FOR ROAD & BRIDGE CONSTRUCTION, DATED NOVEMBER 1943, AND THE A.S.H.T.O. SPEC. FOR 1943, DESIGNED FOR H 20 (24) LIVE LOADING, 25' 10" PAVING ALLOWANCE, DEAD LOAD INCLUDES WEIGHT OF BEAMS, SLAB & RAIL.

ALL DIMENSIONS FOR REINFORCING STEEL GIVEN TO C.O.F. BARS.

TRANSVERSE BARS ARE FURNISHED AS FOR A SQUARE SPAN. BARS SHALL BE CUT IN FIELD TO FIT ONE SKEW END AND CUT OFF ENDS SHALL BE USED IN OPPOSITE SKEW END.

WELD CUT TRANSVERSE BARS BARS #2 @ 13" TO #1 BARS & THE CUT TRANSVERSE BARS #1 TO THE TOP LOW OF 10 BARS. THE COST OF WELDING SHALL BE INCLUDED IN THE UNIT PRICE BID FOR REINFORCING STEEL.

BRIDGE 25
FOR REFERENCE ONLY

SHEET 16 OF 16

SUPERSTRUCTURE
THETFORD
ROUTE #113A
STA. 20+70 TO 21+49
LOG. STA. 392+32

ESTIMATED QUANTITIES SCALE AS NOTED.

CONCRETE - CLASS 'B'	97 - C.Y.	Surveyed by	
STRUCTURAL STEEL	125 771 - Lbs	Designed by	H. B.
REINFORCING STEEL	19 126 - Lbs	Drawn by	D. 150
BITUMINOUS CONCRETE	30 - TON	Checked by	J. L. H. QUANT HAS
ASPHALTIC ASBESTOS COATING	41 S.Y.	Series	5 No. 70(1) Filed

Sheet 15 of 44 Sheets