

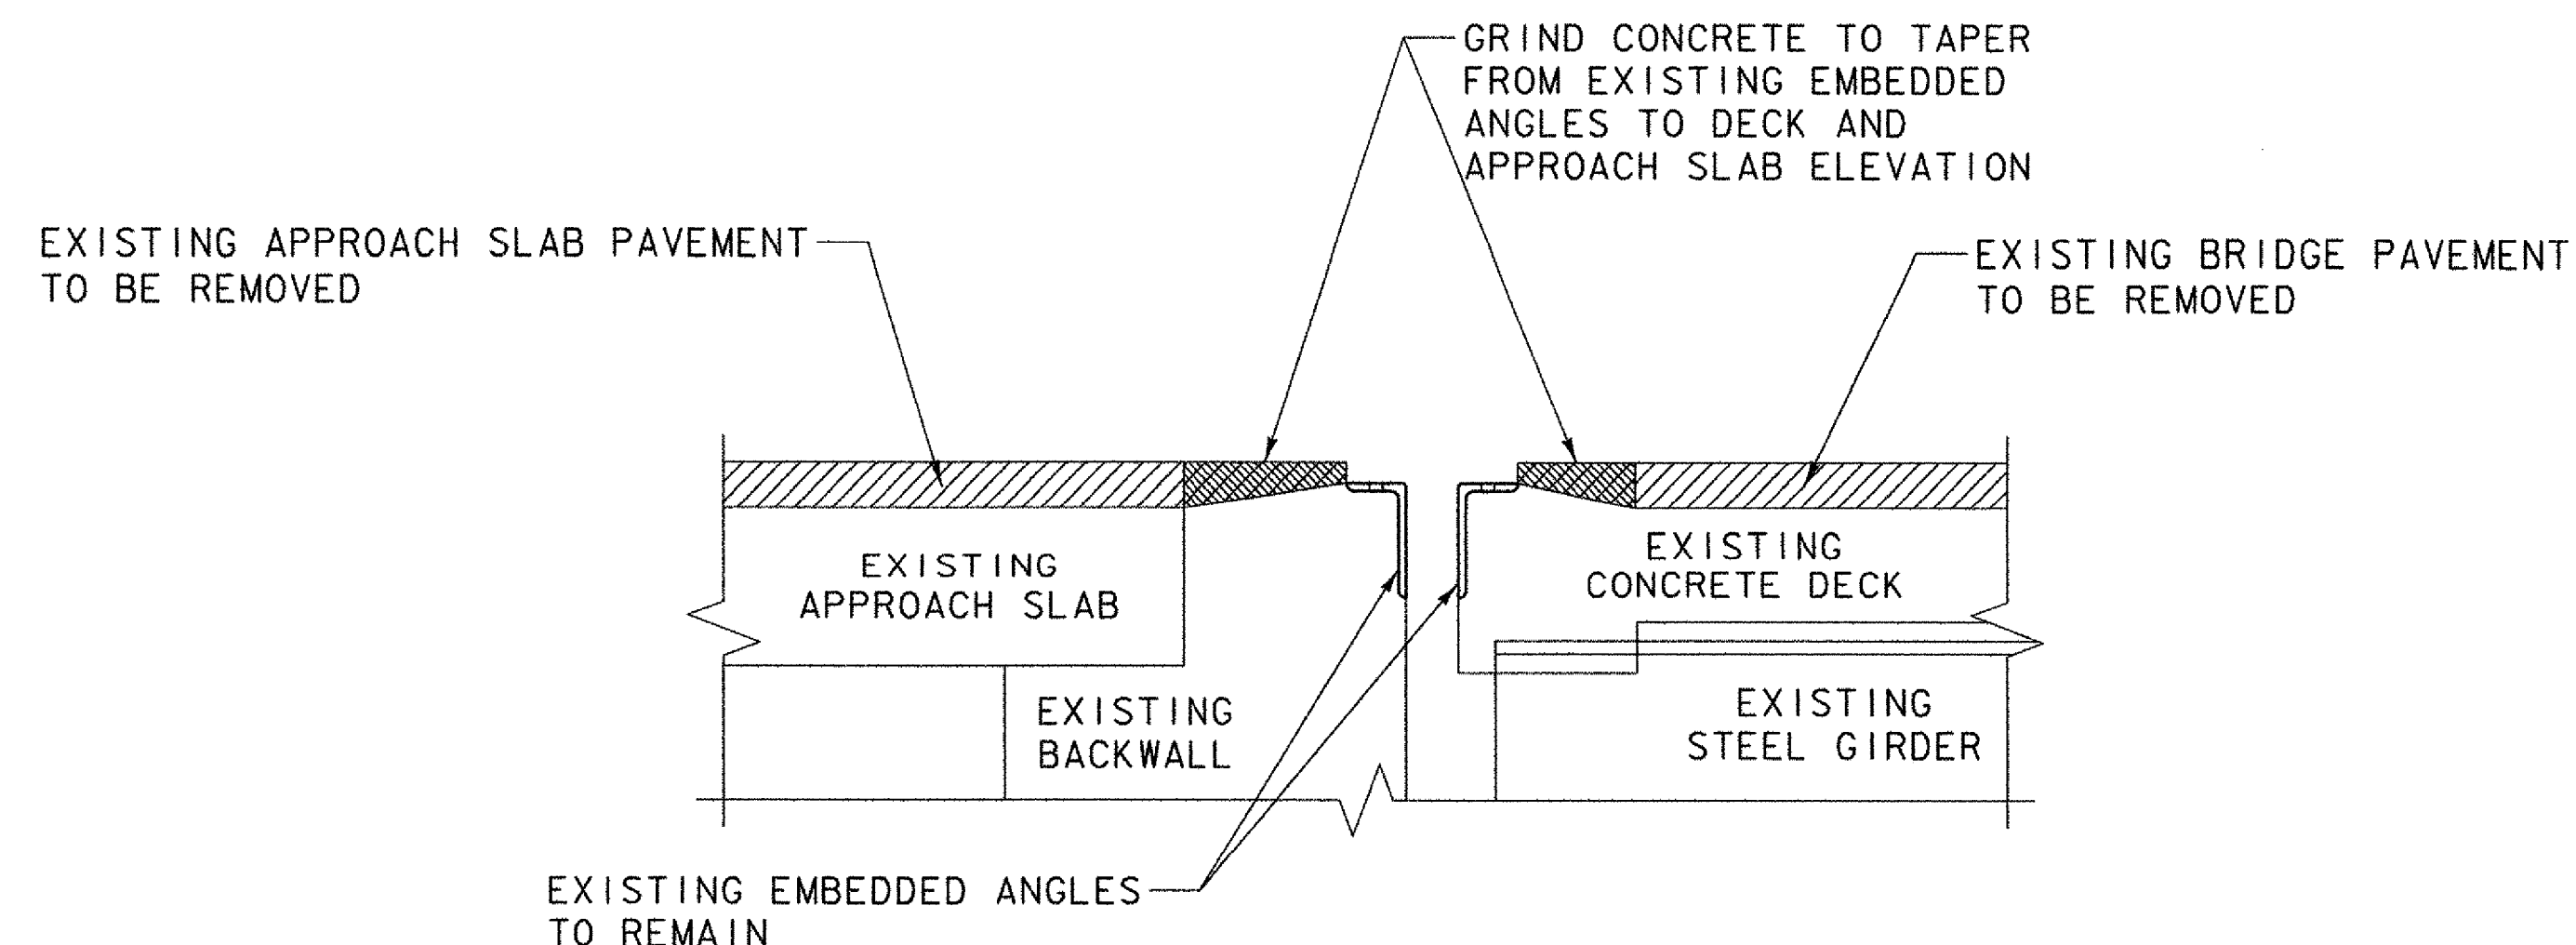
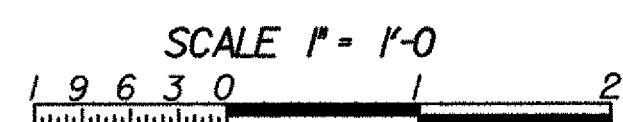




BRIDGE NO. 11
EXISTING EXPANSION JOINT

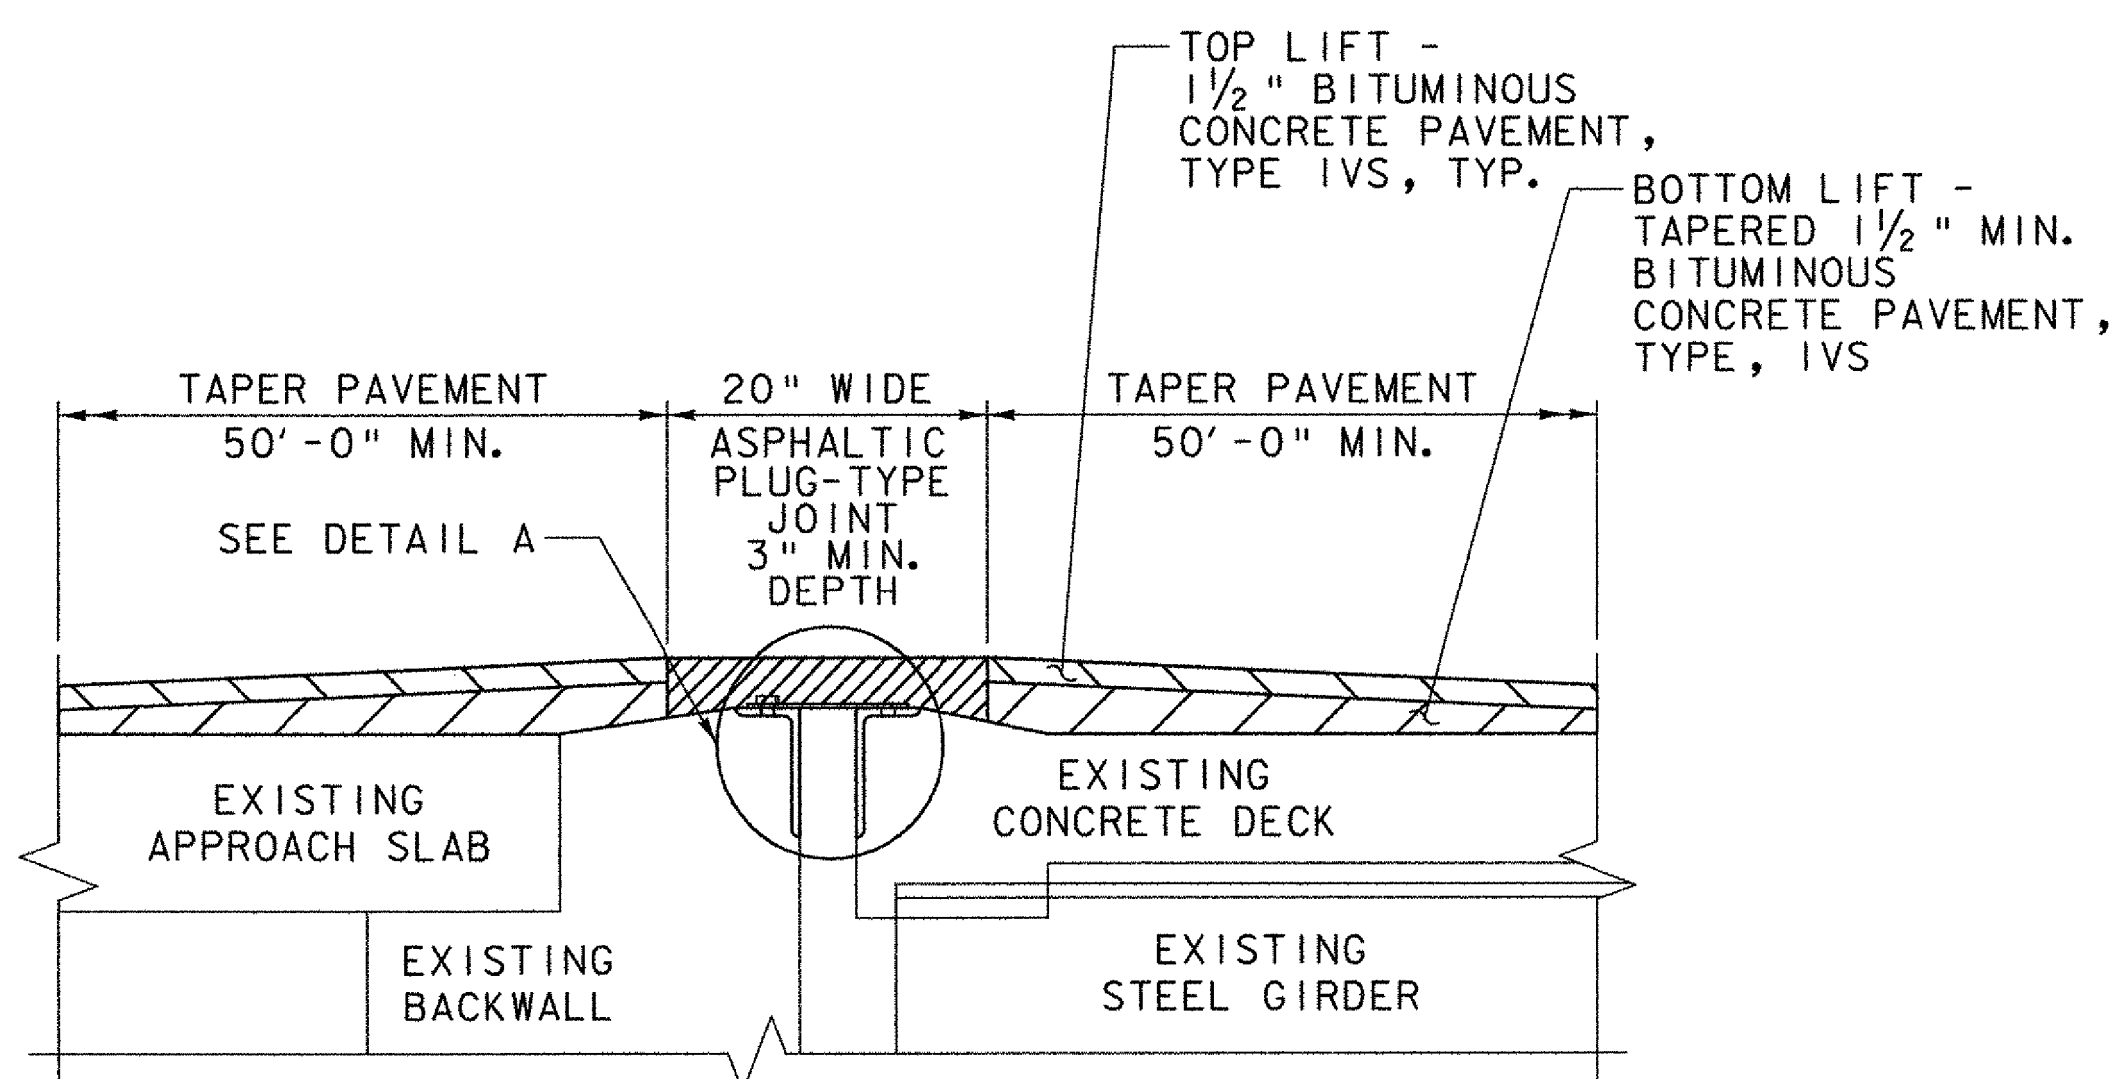

BRIDGE NO. 11
EXPANSION JOINT REMOVAL

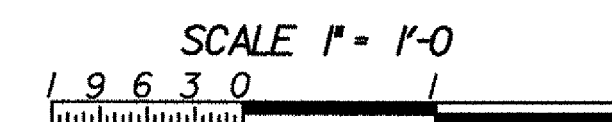

BRIDGE NO. 11
ASPHALTIC PLUG-TYPE JOINT

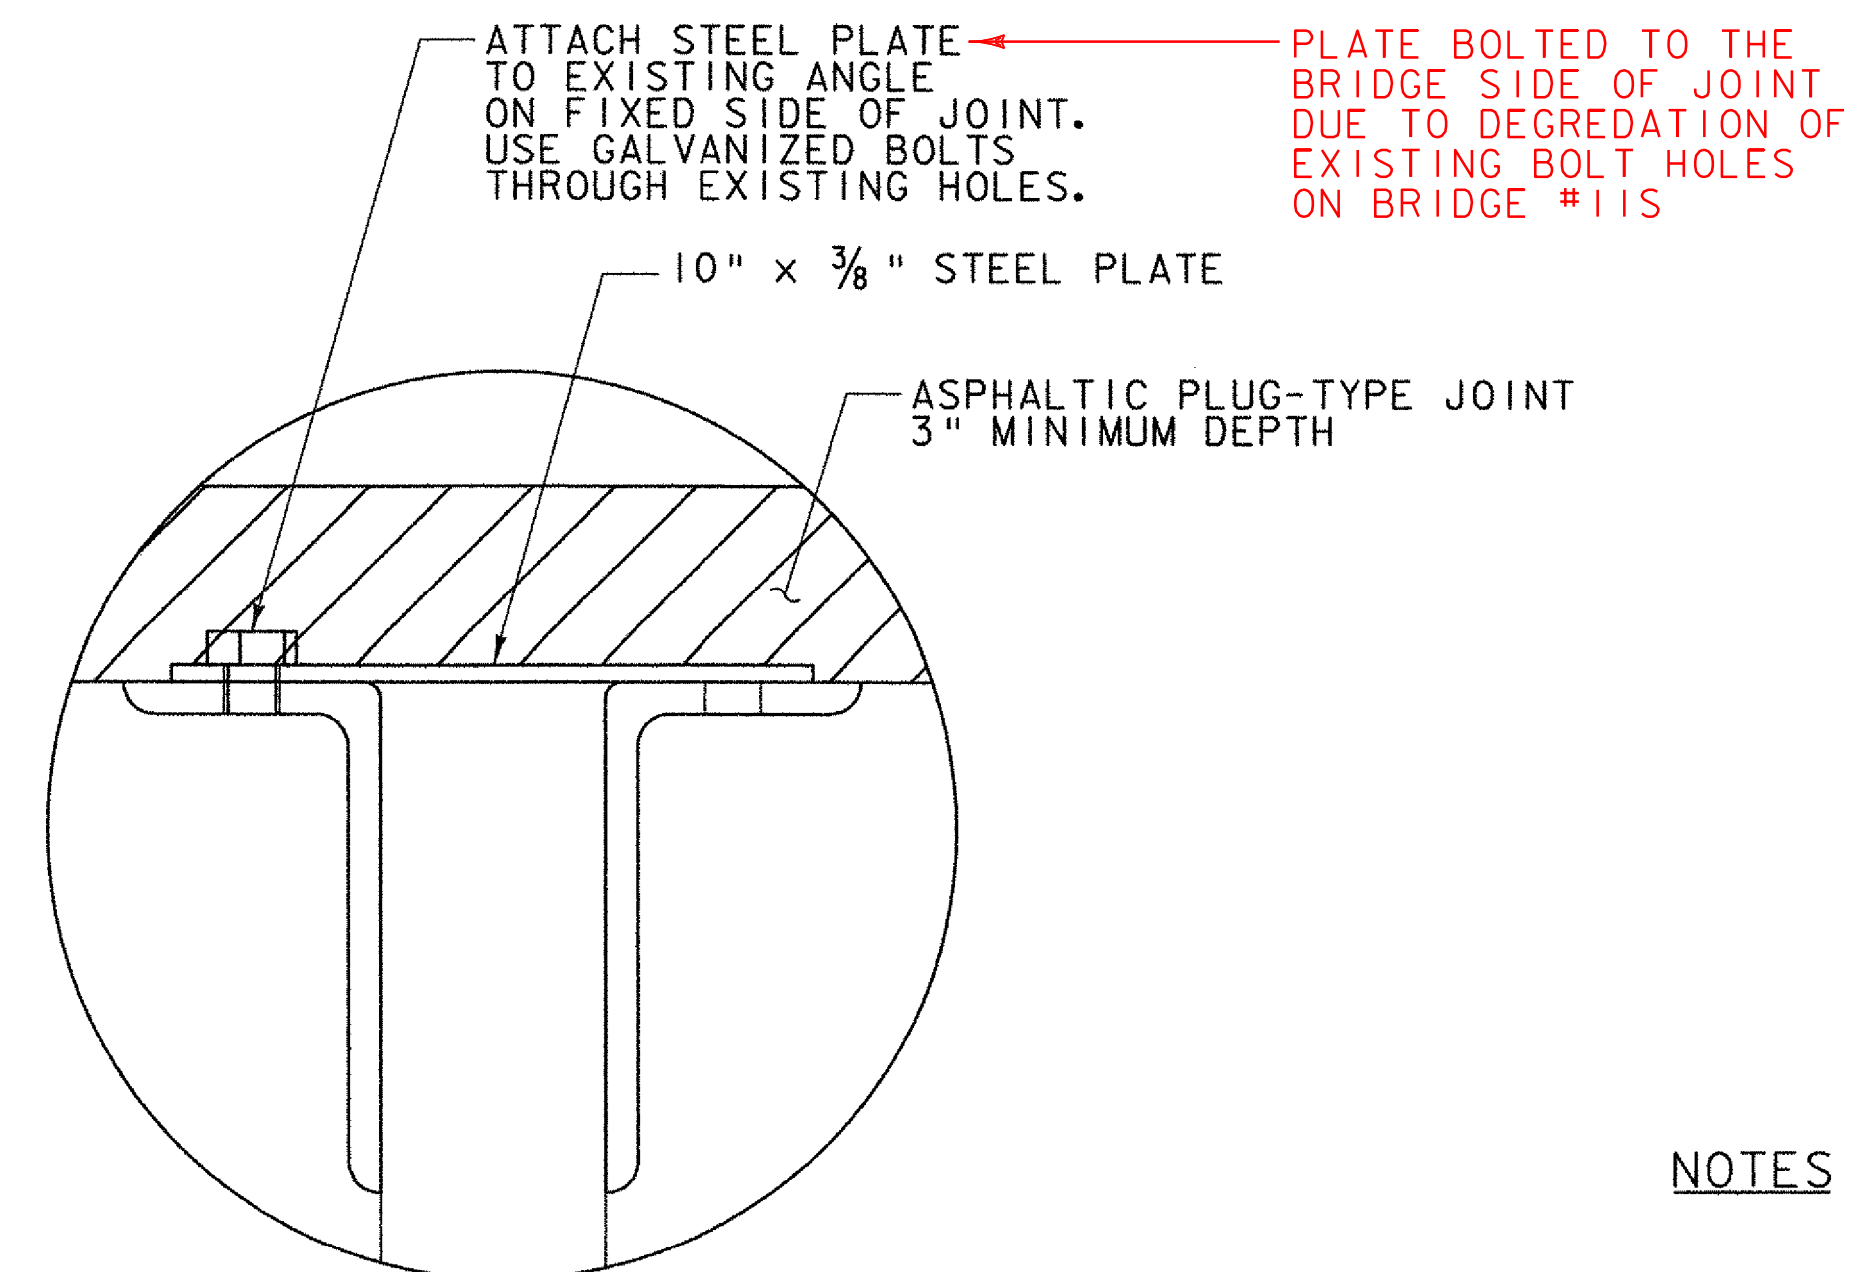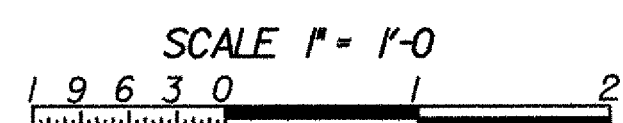

DETAIL A

NTS

NOTES

1. ALL HARDWARE AND MATERIALS SHALL BE IN ACCORDANCE WITH SECTION 516 OF THE SPECIFICATIONS.
2. REFER TO ASPHALTIC PLUG JOINT NOTES ON SHEET 6.

PROJECT NAME: BENNINGTON - SHAFTSBURY
PROJECT NUMBER: BHF MEMB(3)

FILE NAME: z08e054detail.dgn PLOT DATE: 7/15/2008
PROJECT LEADER: APG DRAWN BY: RHB
DESIGNED BY: APG CHECKED BY: EPD
DETAIL SHEET 2 SHEET 7 OF 45