



APPROACH SLAB NO. 1
SCALE 3/32" = 1'-0"

APPROACH SLAB NO. 2
SCALE 3/32" = 1'-0"

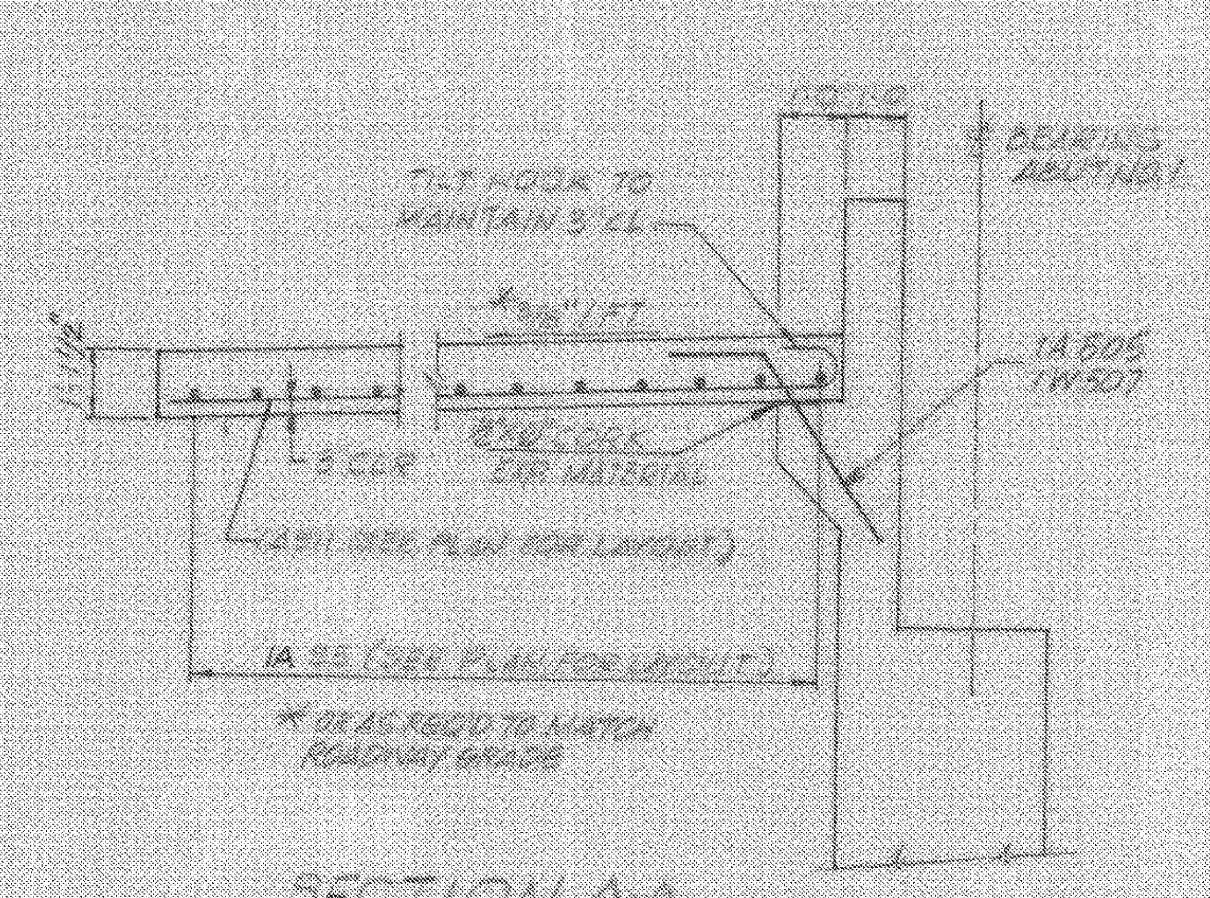

SECTION A-A
SCALE 3/8" = 1'-0"

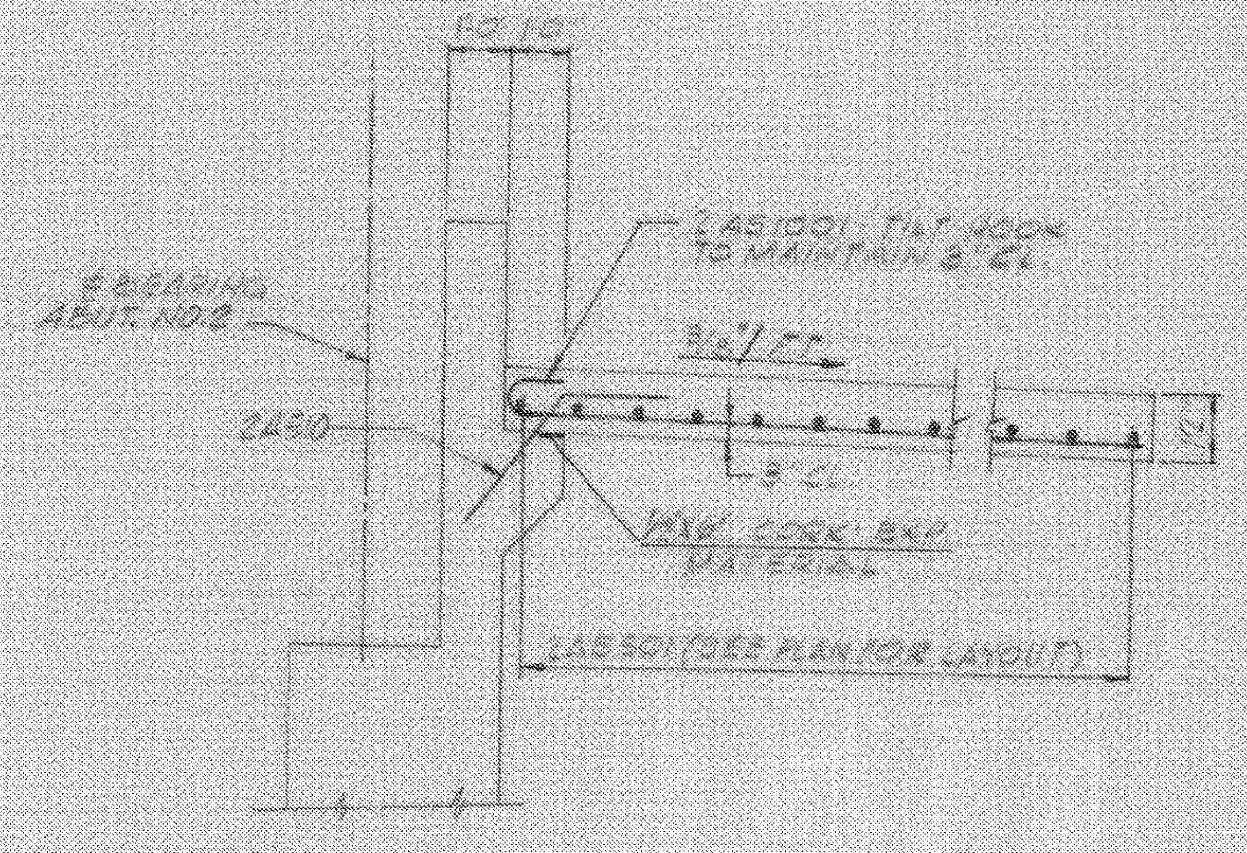

SECTION B-B
SCALE 3/8" = 1'-0"

For Reference Only
Waterbury-Moretown
BHF MEMB (12)
Sheet 12 of 28

STATE OF VERMONT AGENCY OF TRANSPORTATION			
Town Of WATERBURY-DUXBURY-MORETOWN	Bridge No. 48		
Highway No. US RTE 2	Log Sta. Surv. Sta. 15+61		
U.S. RTE. 2 OVER WINOOSKI RIVER			
APPROACH SLAB DETAILS			
Designed By C.J.B.	Date 9/89	Drawn By D.F.H.	Bridge Design Supervisor DWC
Checked By L.J.C.	Date 9/89	Date 9/90	
PROJECT WATERBURY-DUXBURY-MORETOWN		PROJECT NO. BRF-013-4(10)	
L.S.C. Info. Bridge Sheet No. BR 116		Sheet 12 of 28	

BARNES AND JARNIS, INC.
CONSULTING ENGINEERS
BOSTON, MASS.