



PLAN ABUTMENT NO. 2
SCALE: 3/16" = 1'-0"

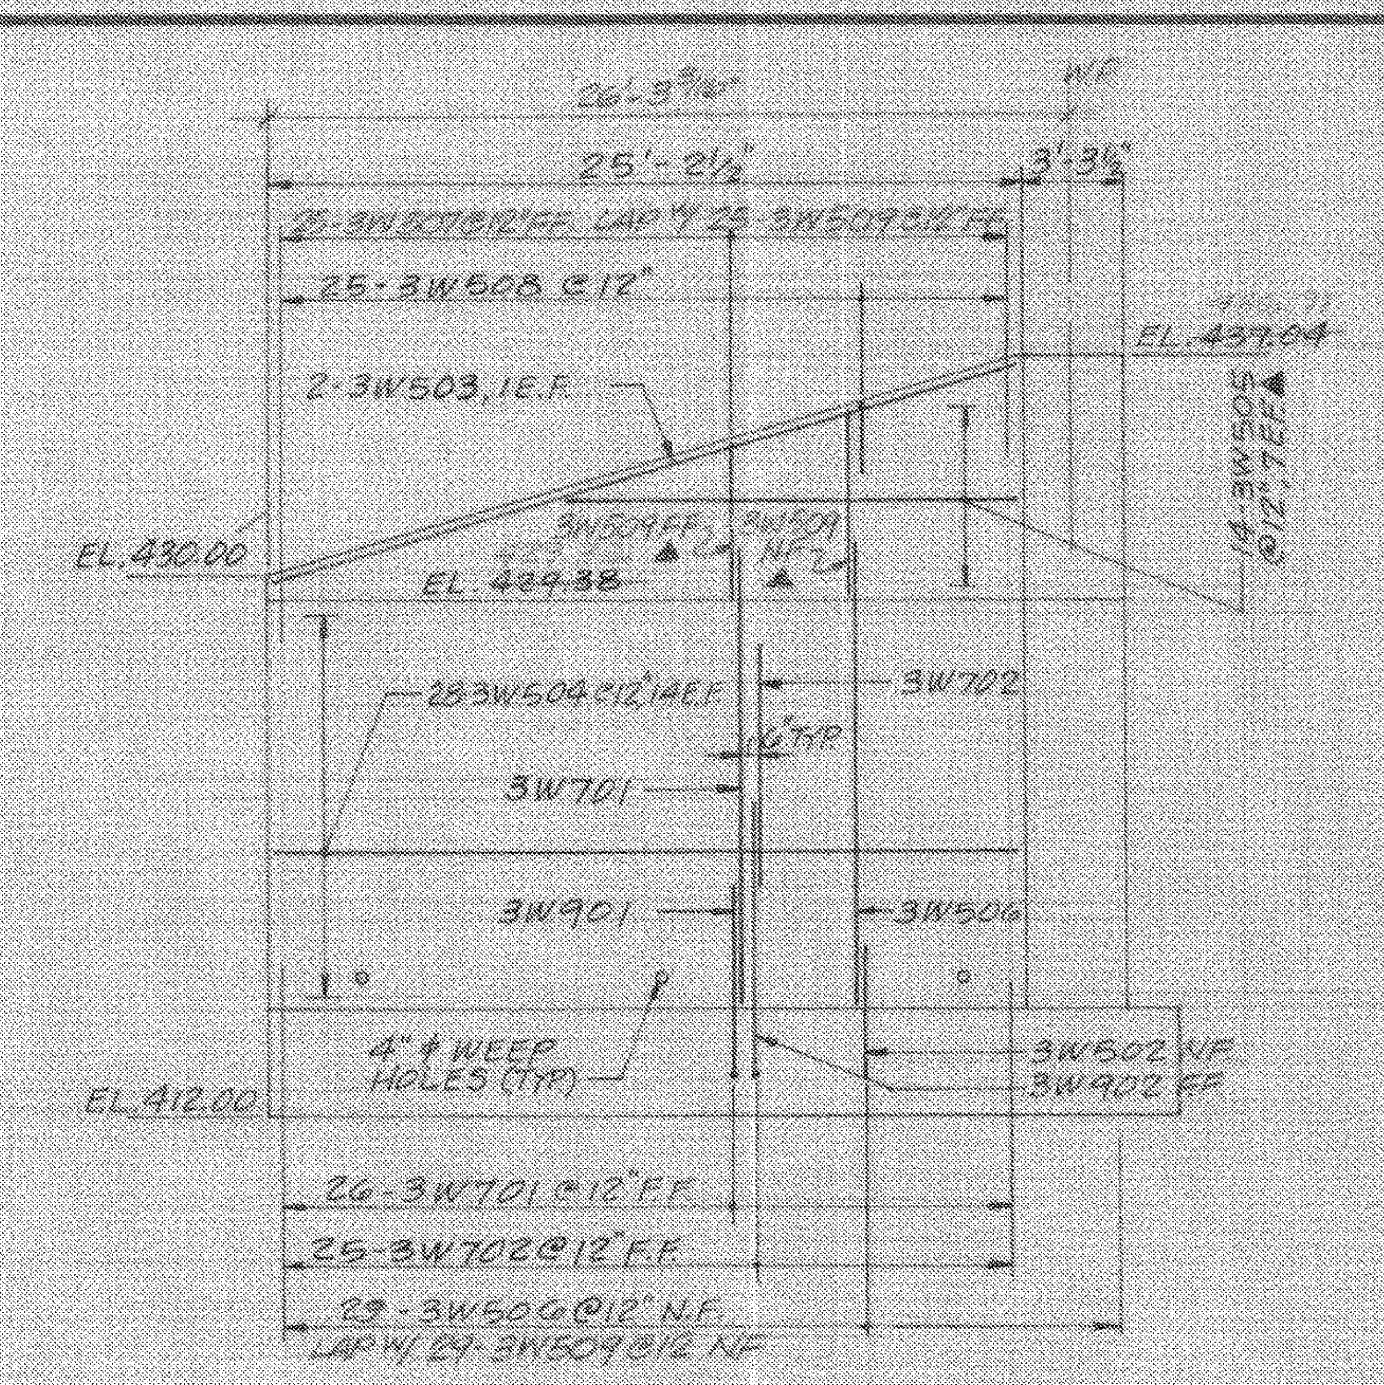

WINGWALL NO. 3 ELEVATION
SCALE: 3/16" = 1'-0"

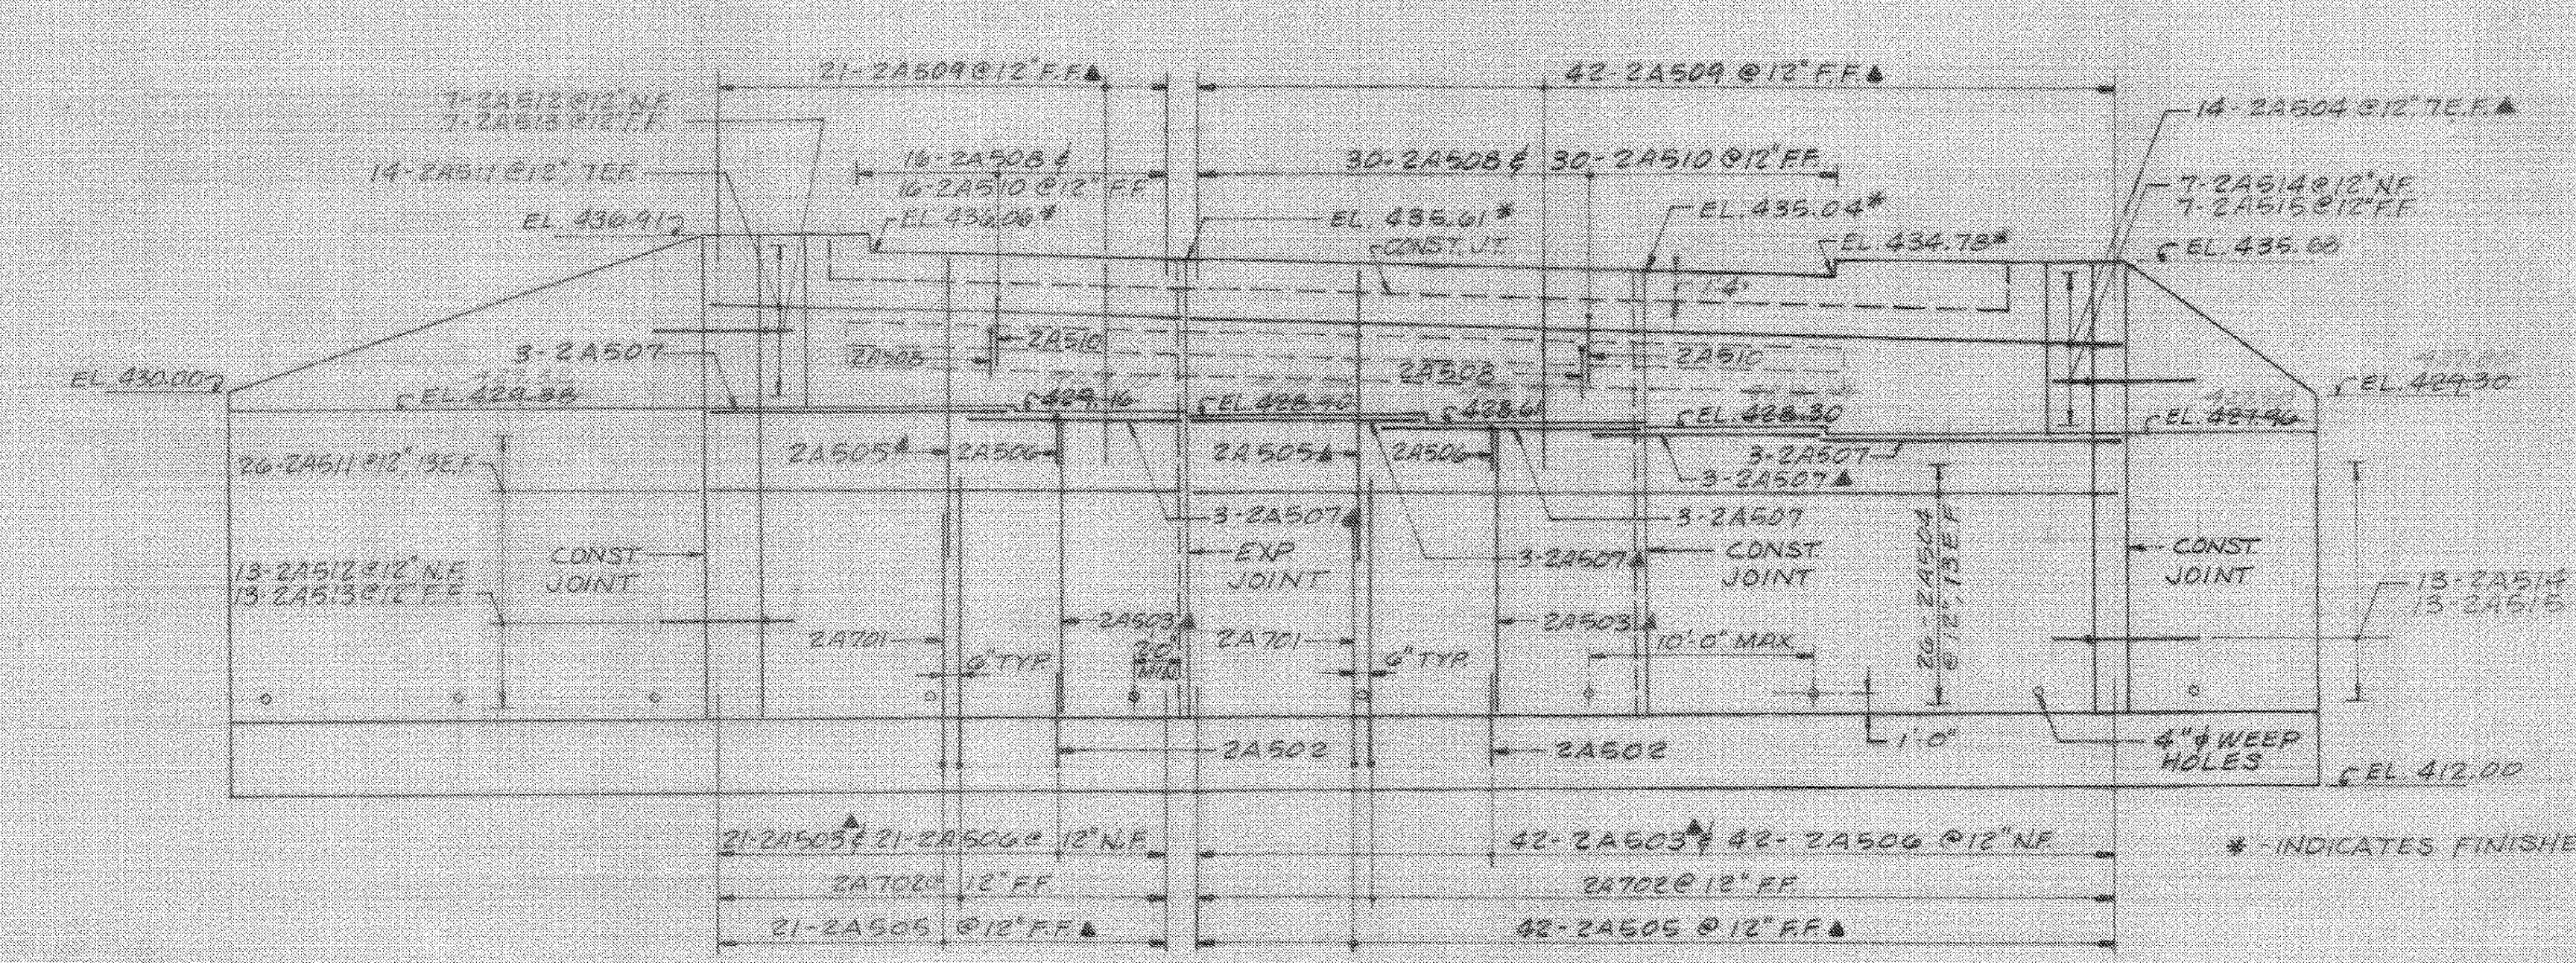

ABUTMENT NO. 2 ELEVATION
SCALE: 3/16" = 1'-0"

NOTE: BRIDGE SEAT ELEVATIONS LISTED ON DRAWING EXTRA THICKNESS OF BEARING DEVICES.

For Reference Only
Waterbury-Moretown
BHF MEMB (12)
Sheet 15 of 28

STATE OF VERMONT AGENCY OF TRANSPORTATION			
Town of WATERBURY-DUXBURY-MORETOWN	Bridge No. 48	Log Sta.	
Highway No. U.S. RTE 2	Surv. Sta. 15+61		
U.S. RTE 2 OVER WINOOSKI RIVER			
PLAN & ELEVATION - ABUTMENT NO. 2			
Designed By C.J.B.	Drawn By R.J.L.		
Checked By DWC	Date 9/89	Bridge Design Supervisor DWC	Date 9/90
PROJECT WATERBURY-DUXBURY-MORETOWN	PROJECT NO. BRF-013-4(10)		
L&C info.		Bridge Sheet No. BR 123 Sheet 17 of 182	

BARNES AND JARNIS, INC.
CONSULTING ENGINEERS
BOSTON, MASS.

BR-4