

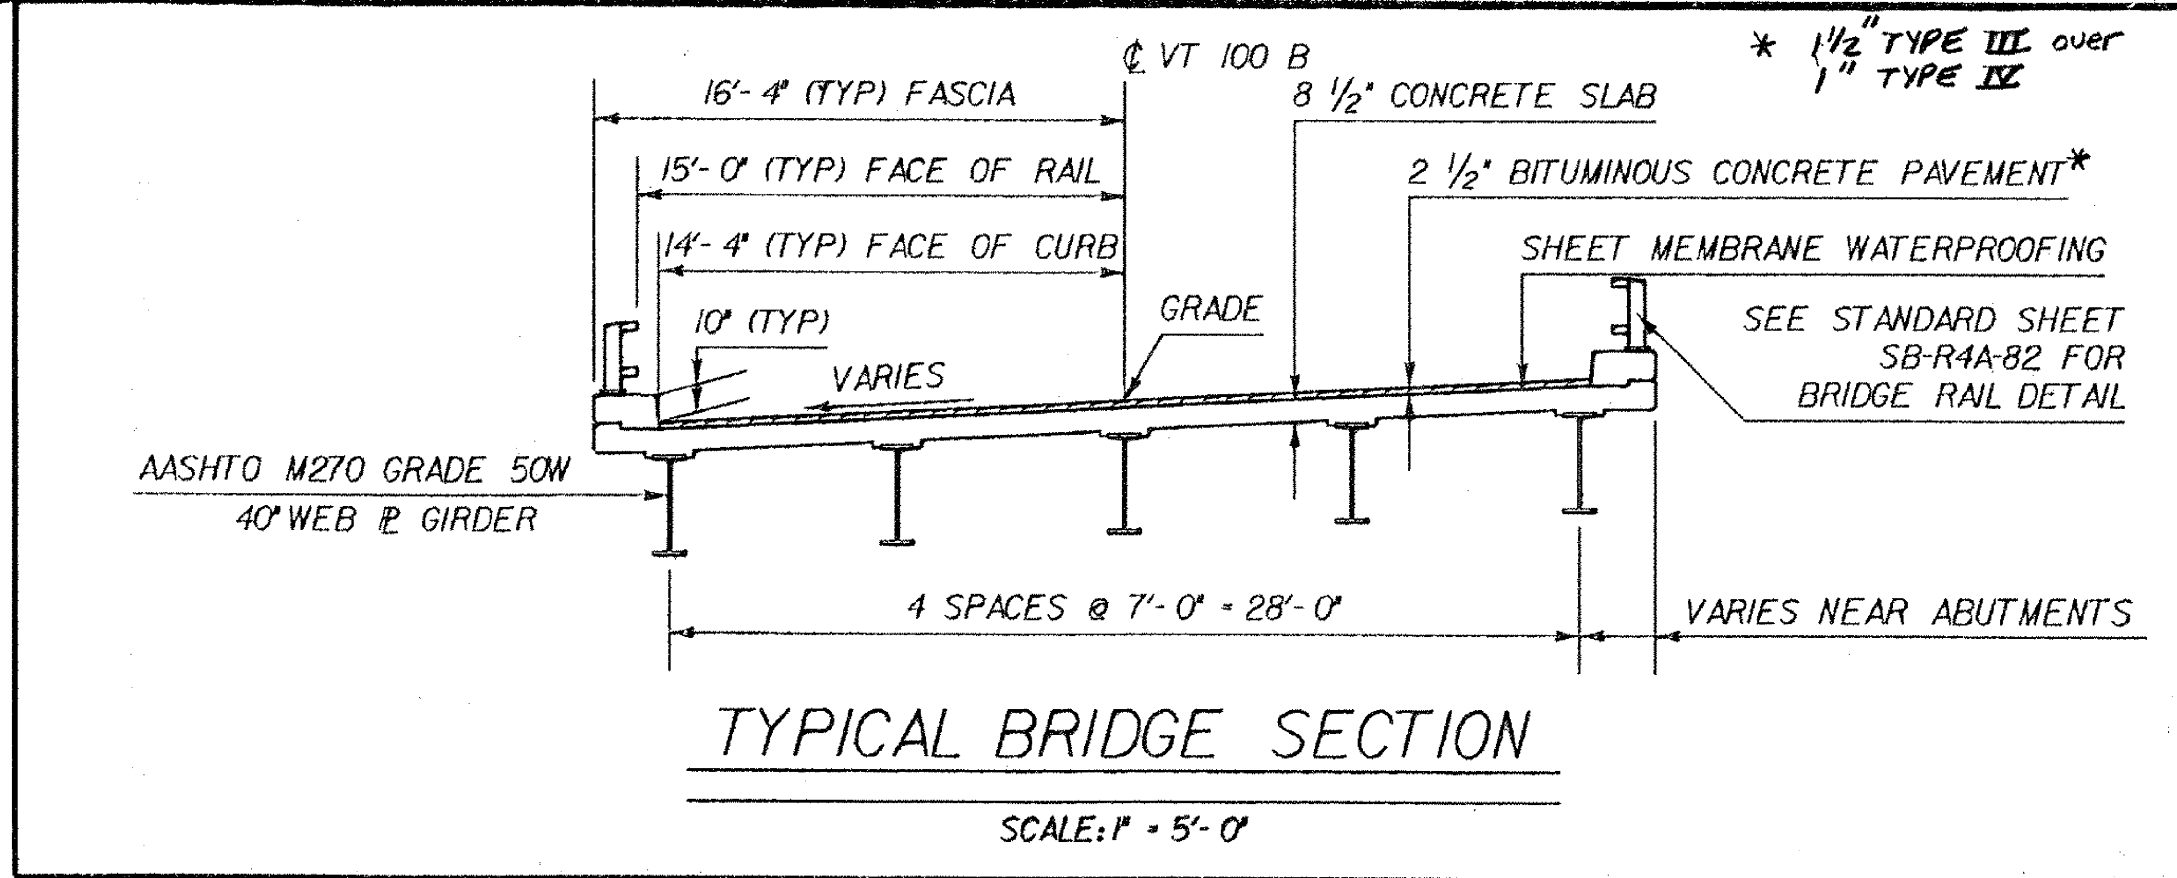


LIST OF SHEETS

BR100	PRELIMINARY INFORMATION
BR101	BRIDGE QUANTITIES
BR102	GENERAL NOTES
BR103	PLAN & ELEVATION
BR104-106	BORING INFORMATION
BR107	TYPICAL SECTION & DECK REINFORCING PLAN
BR108	FRAMING PLAN & GIRDER ELEVATION
BR109	DIAPHRAGM & SPLICE DETAILS
BR110	APPROACH SLAB DETAILS
BR111	BEARING DETAILS
BR112	ABUTMENT 2 BEARING DETAILS & BEARING NOTES
BR113	MISCELLANEOUS DETAILS
BR114	ABUTMENT 1 DETAILS
BR115	ABUTMENT 2 DETAILS
BR116	FOOTING REINFORCING STEEL
BR117	PILE LAYOUT
BR118	WINGWALL 1 DETAILS
BR119	WINGWALL 2,3,4 DETAILS
BR120	BACKWALL DETAILS
BR121	PIER DETAILS
BR122	EXPANSION JOINT DETAILS
BR123	EXPANSION JOINT PLAN VIEW
BR124	END BRIDGE RAIL DETAIL
BR125	SCUPPER DETAILS
BR126-127	REINFORCING STEEL SCHEDULE
BR128-133	CHANNEL SECTIONS

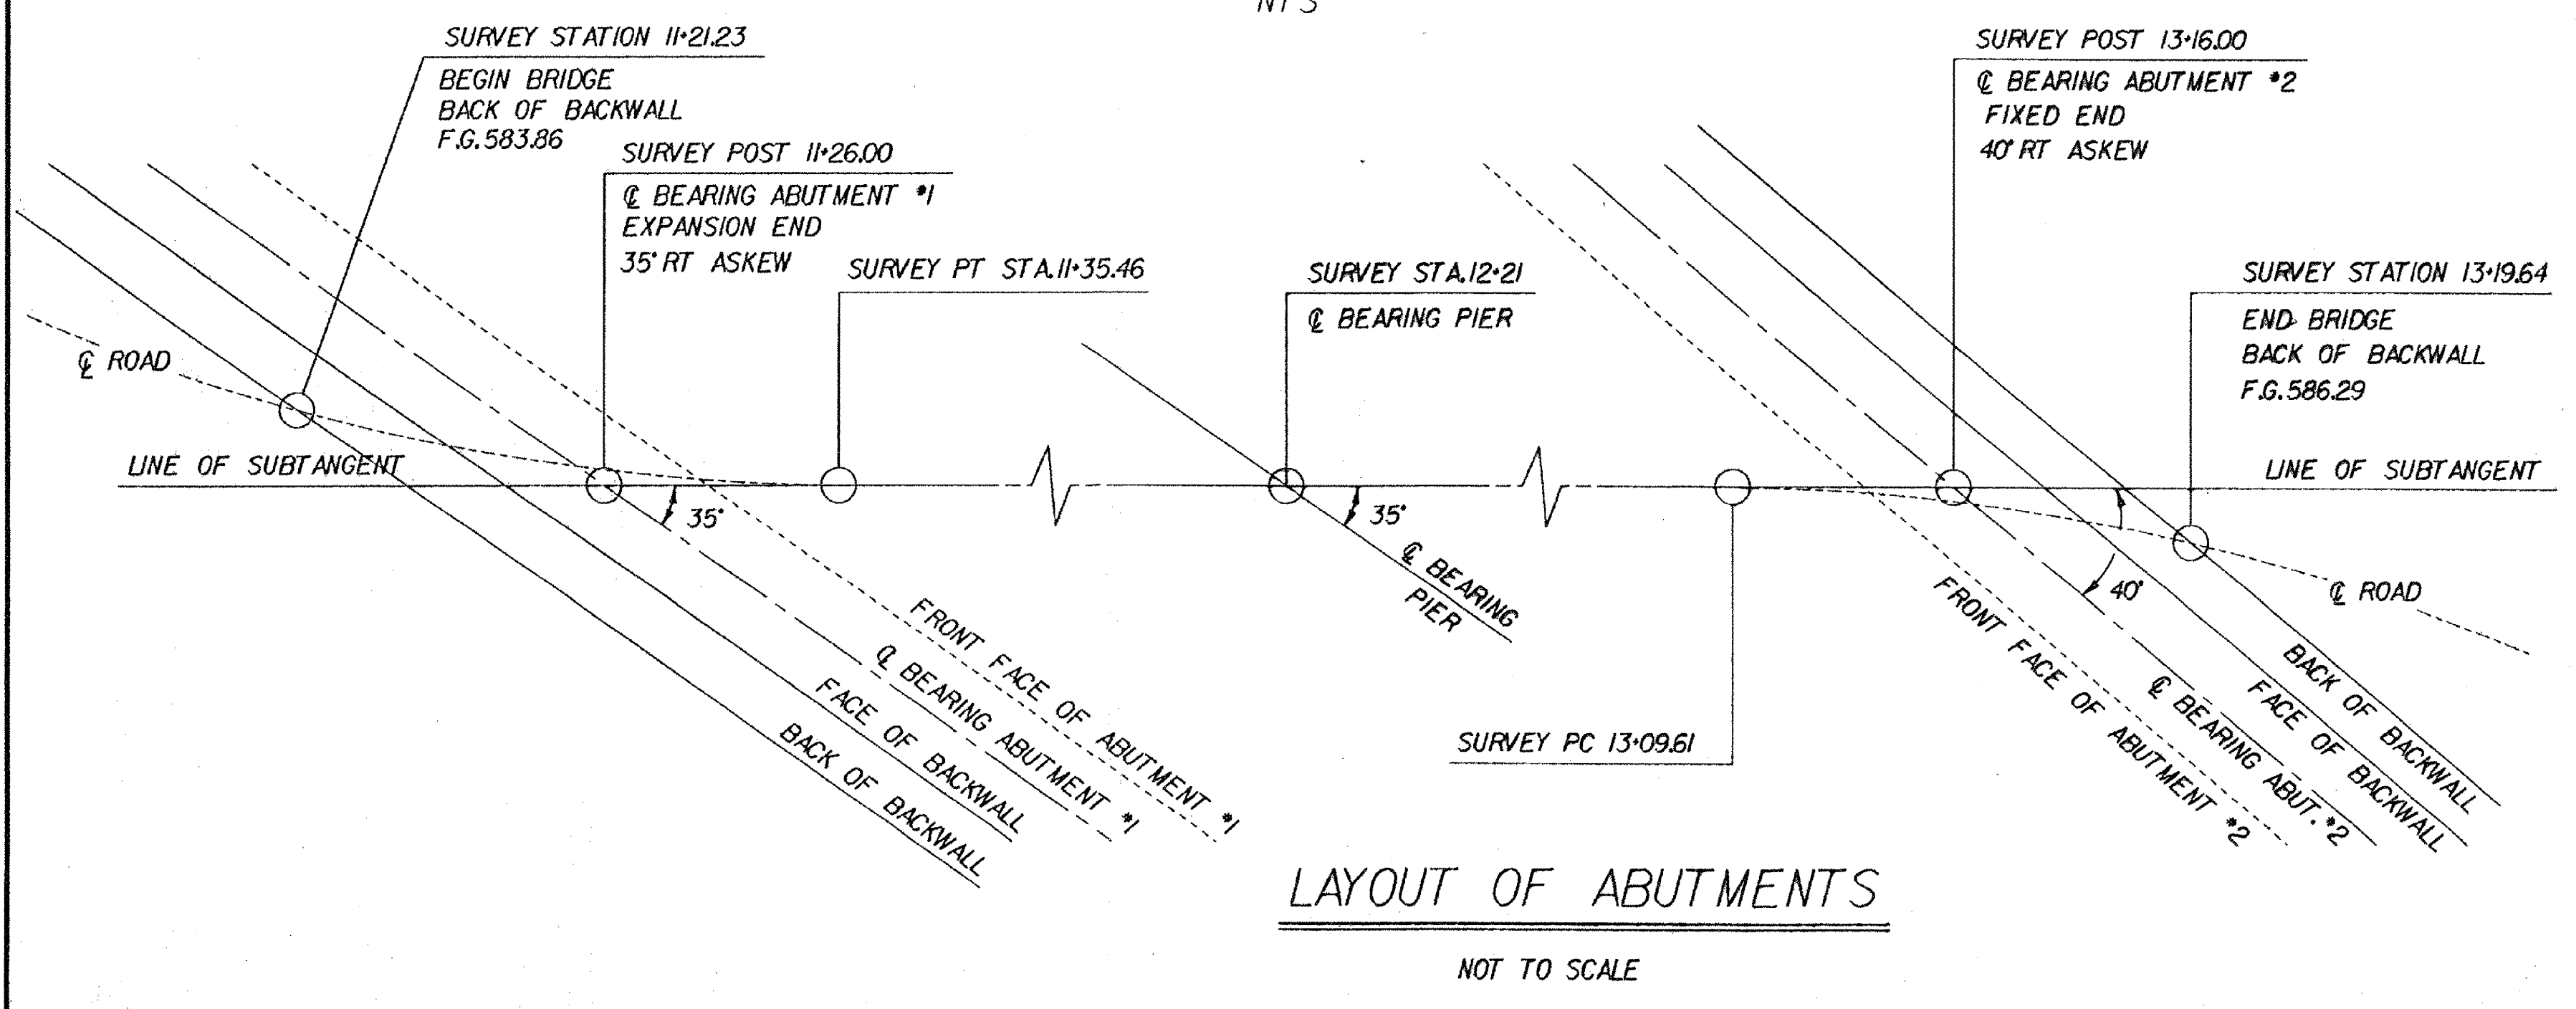

- NOTES**
1. THE SEQUENCE OF POURS 1 & 2 MAY BE INTERCHANGED. A MINIMUM OF 96 HOURS BETWEEN POURS IS REQUIRED.
 2. IF APPROVED BY THE ENGINEER, POURS 1 & 2 OR ALL SECTIONS MAY BE Poured THE SAME DAY PROVIDED THE MAXIMUM TIME OF THE POUR IS 8 HOURS AND THE INDICATED POURING SEQUENCE IS FOLLOWED AND A RETARDING ADMIXTURE IS USED SO THAT THE DECK CONCRETE WILL NOT SET UP UNTIL ALL THE POUR HAS BEEN MADE. THE RETARDING ADMIXTURE WILL BE SUBSIDIARY TO THE ITEM 50122, CONCRETE CLASS A.
 3. ALL POURS SHALL START FROM THE LOW END (ELEVATION WISE).
 4. IF ALL SECTIONS ARE NOT Poured IN THE SAME DAY, USE TRANSVERSE BRIDGE SLAB CONSTRUCTION JOINTS. (SEE SHEET BR113 FOR DETAILS.)
 5. BRIDGE DECK CONCRETE SHALL BE DEPOSITED AND SCREEDED PARALLEL TO THE CENTERLINE OF BEARING.

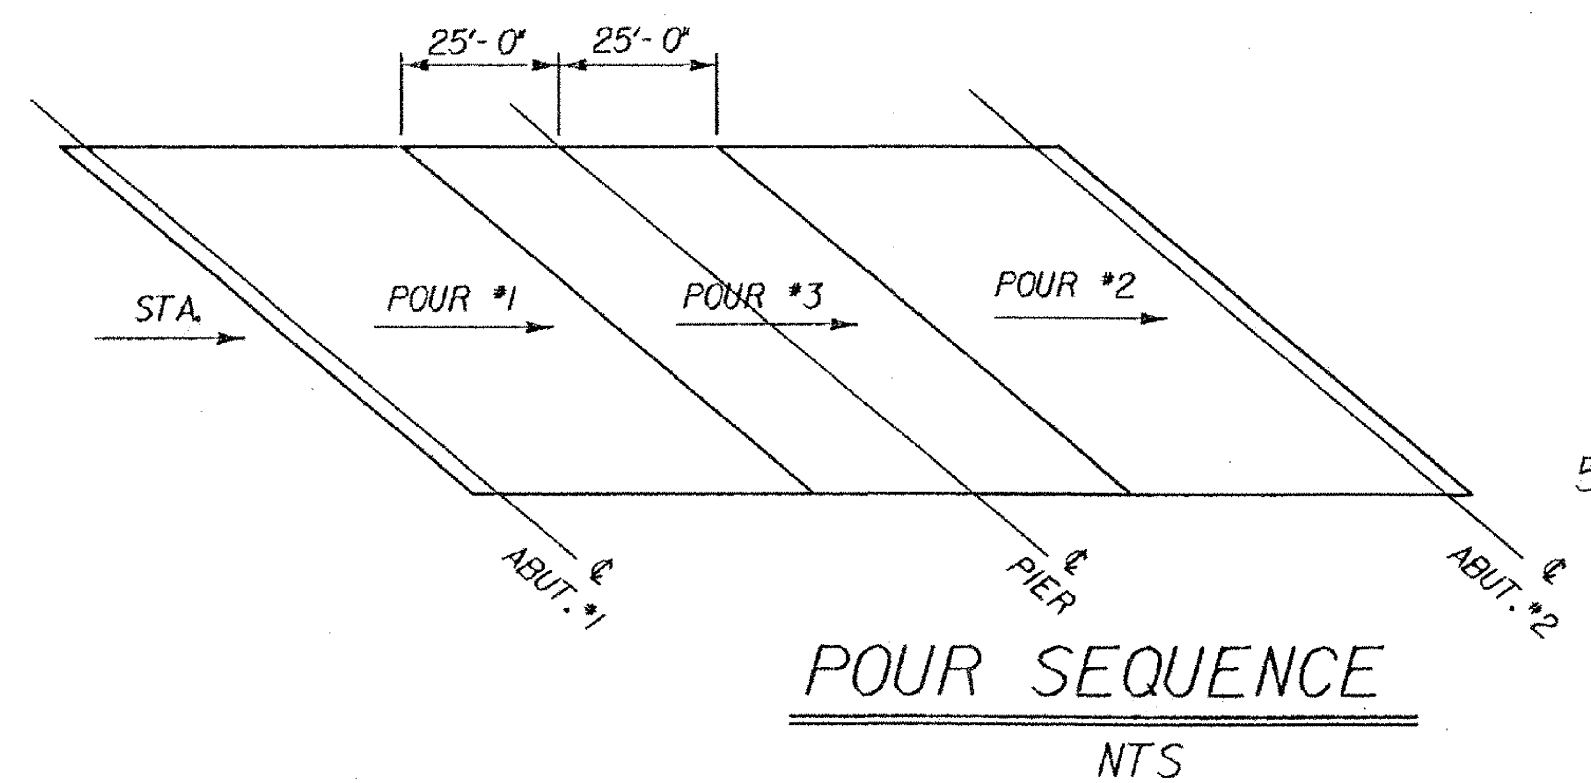

EXISTING STRUCTURE	
1. STRUCTURE TYPE	SINGLE SPAN STEEL
2. SPAN LENGTH(S) CENTER TO CENTER OF BEARINGS	125.0'
3. CLEAR SPAN LENGTH(S) NORMAL TO STREAM	125.0'
4. WATERWAY AREA OF FULL OPENING (NORMAL TO STREAM)	1650 SQ. FT.
5. WATER SURFACE ELEVATION @ Q 2.33	569.5
6. WATER SURFACE ELEVATION AT FLOOD OF RECORD	YEAR 1927 ESTIMATED DISCHARGE
7. DOES ALL WATER PASS THROUGH EXISTING STRUCTURE? YES/IF NOT, AT WHAT FREQUENCY AND ELEVATION DOES RELIEF OCCUR?	
8. TYPE OF SUBSTRUCTURE FOUNDATION MATERIAL	TIMBER PILES TO LEDGE
9. DISPOSITION OF STRUCTURE	REMOVE EXISTING STRUCTURE

NEW STRUCTURE	
1. STRUCTURE TYPE	2 SPAN CONTINUOUS PLATE GIRDER
2. SPAN LENGTH(S) CENTER TO CENTER OF BEARINGS	2 SPANS @ 95.0'
3. VERTICAL CLEARANCE ABOVE STREAMBED OR ROAD UNDER	15.2'
4. CLEAR SPAN LENGTH(S) NORMAL TO STREAM	91.5, 93.5 TOTAL 185.0'
5. WATERWAY AREA OF FULL OPENING (NORMAL TO STREAM)	1630 SQ. FT.
6. ARE PROVISIONS TO BE MADE FOR PUBLIC UTILITIES?	

HYDRAULIC DATA			
Q 2.33	4000 CFS	WATER ELEVATION	569.5
Q 10	9400 CFS	WATER ELEVATION	573.0
Q 25	12600 CFS	WATER ELEVATION	574.7
Q 50	15000 CFS	WATER ELEVATION	575.8
Q 100	17000 CFS	WATER ELEVATION	576.0
Q 150	18000 CFS	WATER ELEVATION	576.0
Q 200	18500 CFS	WATER ELEVATION	576.0
Q 250	18800 CFS	WATER ELEVATION	576.0
Q 300	19000 CFS	WATER ELEVATION	576.0
Q 350	19200 CFS	WATER ELEVATION	576.0
Q 10000	57800 CFS	WATER ELEVATION	576.0

ALLOWABLE STRESSES:	
1. DESIGN LIVE LOAD	AASHTO HS 25
2. ALLOWABLE LOAD FOR SPREAD FOOTINGS ON SOIL	ON LEDGE
3. ALLOWABLE LOAD FOR PILING	2 KSI TYPE HP 14X73 ESTIMATED LENGTH SEE BORING LOGS
4. ALLOWABLE STRESS FOR STRUCTURAL STEEL	AASHTO M 270 GRADE 50W TENSION 27 KSI
5. ALLOWABLE STRESS FOR REINFORCING STEEL	GRADE 60 TENSION 24 KSI COMPRESSION 20 KSI
6. ALLOWABLE STRESS FOR CONCRETE	CLASS A f _c 3.5 KSI f _c 1.4 KSI CLASS B f _c 3.5 KSI f _c 1.4 KSI

TRAFFIC MAINTENANCE:	
1. IS TRAFFIC TO BE MA	