


STATE OF VERMONT AGENCY OF TRANSPORTATION



PROPOSED IMPROVEMENT BRIDGE PROJECT TOWN OF JERICO COUNTY OF CHITTENDEN

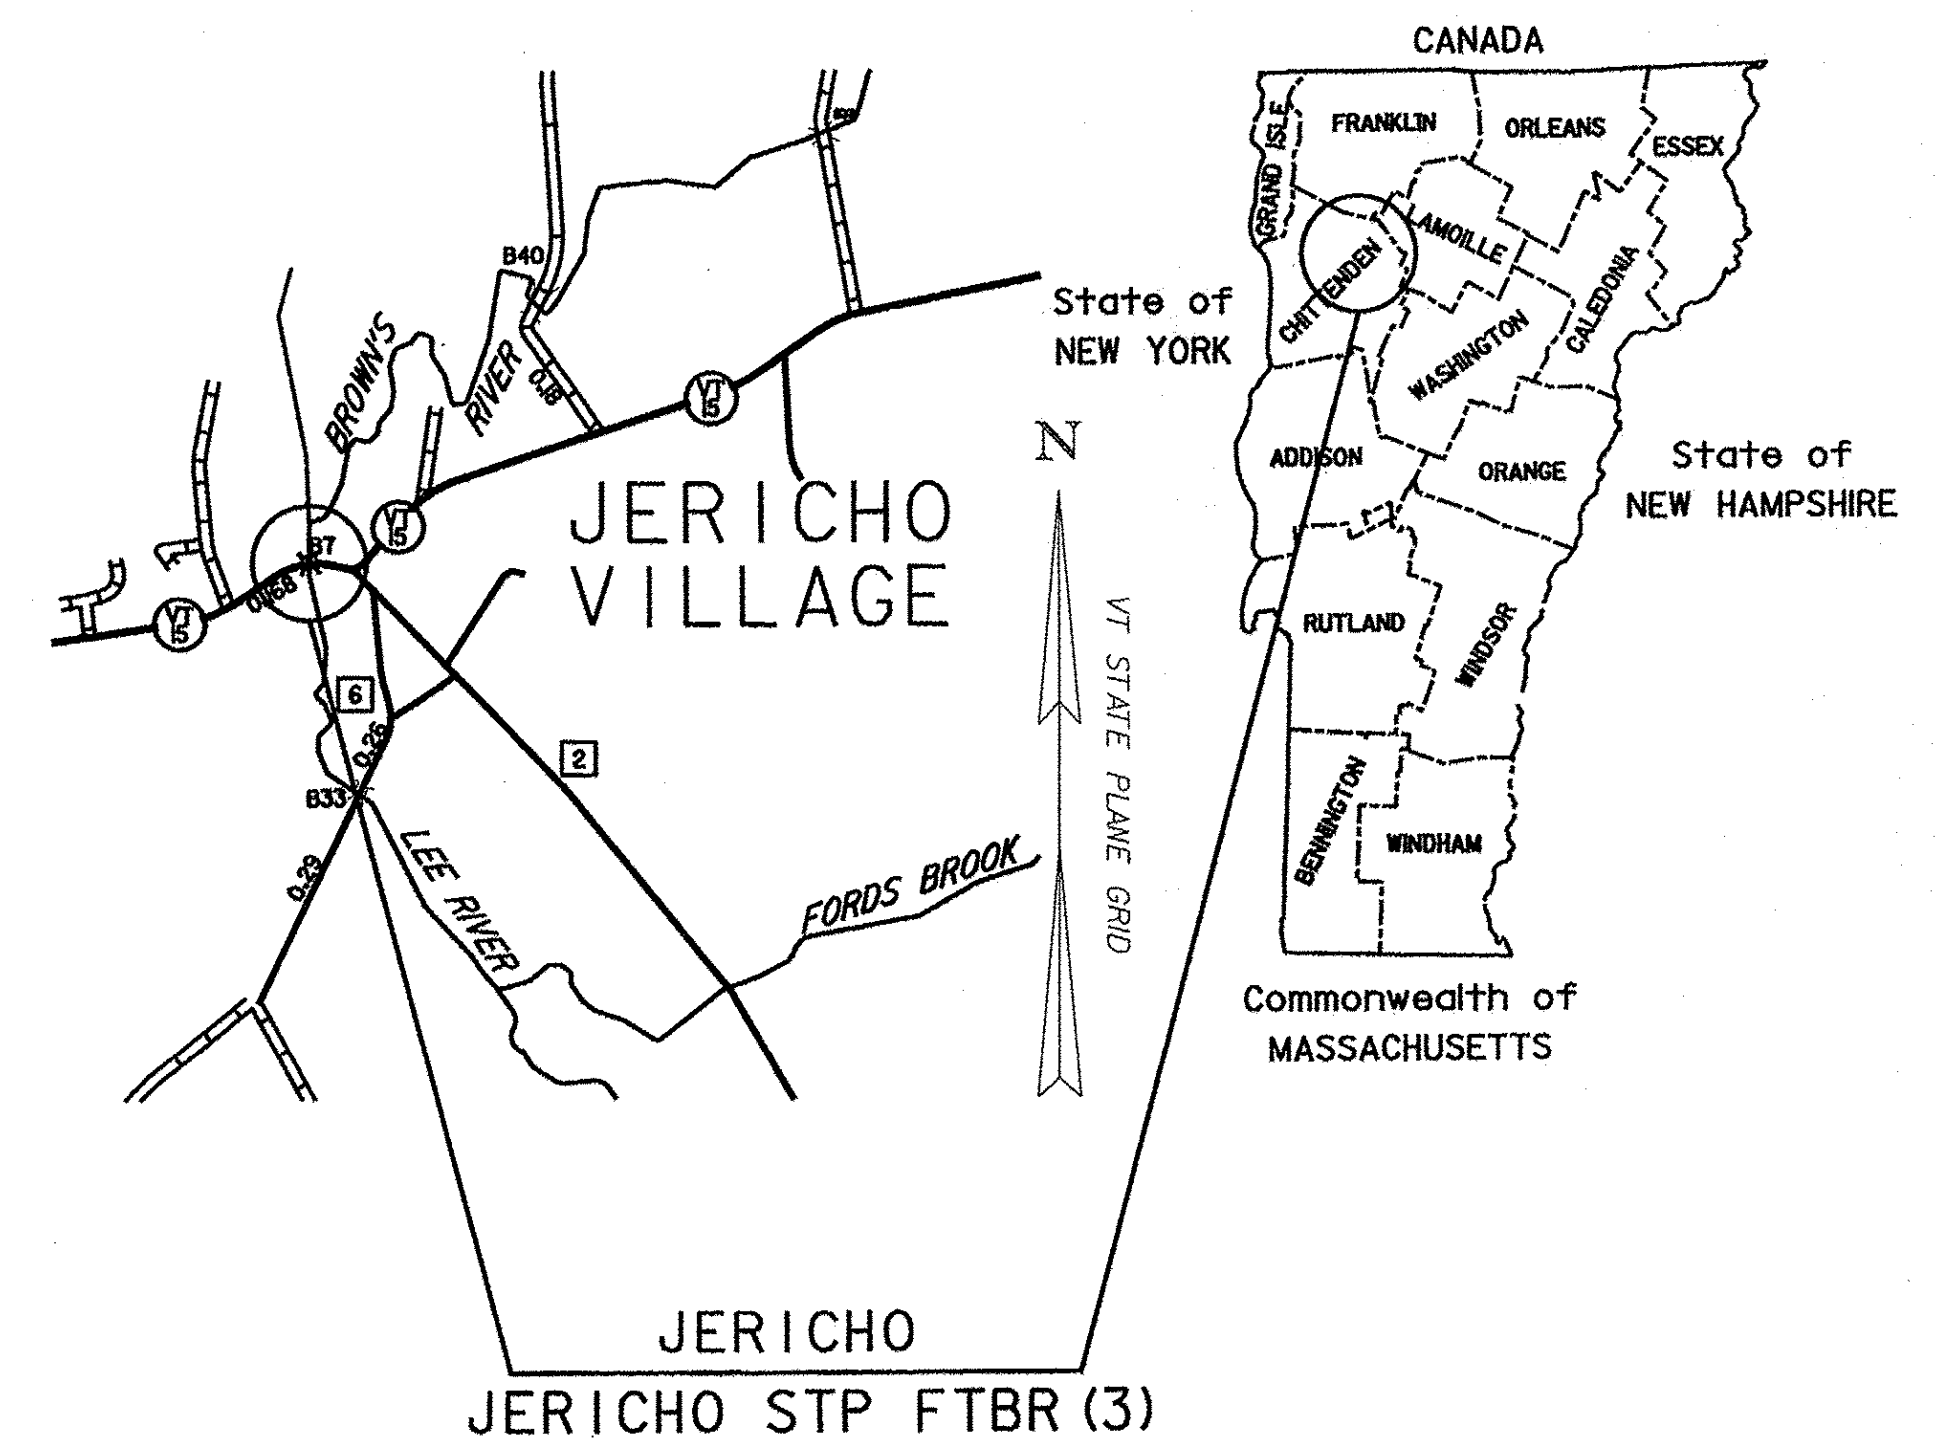

RECORD PLANS	
CONTRACTOR:	BLOW & COTE INC. - MORRISVILLE, VT
RESIDENT ENGINEER:	GREG WILCOX
CONSTRUCTION BEGAN:	JULY 25, 2014
CONSTRUCTION COMPLETE:	SEPTEMBER 25, 2015
RECORD PLANS BY:	GREG WILCOX & KEVIN KING
I HEREBY CERTIFY THAT ALL THE CONSTRUCTION REQUIRED BY THIS SET OF DRAWINGS HAS BEEN ACCOMPLISHED AS INDICATED HEREIN.	
BY	<i>Greg Wilcox</i> RESIDENT ENGINEER
DATE	3/2/16
NOTE: Any further information concerning final quantities, amounts or other details relative to this project may be found at Central Files in the electronic archives.	

ROUTE NO : VT 15 (MINOR ARTERIAL) BRIDGE NO : PEDESTRIAN BRIDGE

PROJECT LOCATION: LOCATED IN THE COUNTY OF CHITTENDEN, TOWN OF JERICO, ADJACENT TO BRIDGE NO. 7 ON VT 15 OVER BROWNS RIVER, APPROXIMATELY 0.45 MILE EAST OF THE ESSEX-JERICO TOWN LINE.

PROJECT DESCRIPTION: CONSTRUCTION OF A NEW PEDESTRIAN BRIDGE, APPROACH WALKWAYS AND ADJACENT RETAINING WALL, COLD PLANING AND PAVING OF VT 15 AND RED MILL DRIVE.

LENGTH OF STRUCTURE : 72.00 FEET
 LENGTH OF ROADWAY : 94.70 FEET
 LENGTH OF PROJECT : 166.70 FEET



PLANS PREPARED BY



111 Winners Circle, PO Box 5269 • Albany, NY 12205-0269
 Main: (518) 453-4500 • www.chacompanies.com


QUALITY ASSURANCE PROGRAM: LEVEL 2

CONVENTIONAL SYMBOLS

COUNTY LINE	
TOWN LINE	
LIMITS OF ACCESS	
POINT OF ACCESS	
FENCE LINE	
STONE WALL	
TRAVELED WAY	
GUARD RAIL	
RAILROAD	
SURVEY LINE	
CULVERT	
POWER POLE	
TELEPHONE POLE	
TREES	
CONTROL OF ACCESS	
PROPERTY LINE	
R.O.W. TAKING LINE	
SLOPE RIGHTS	
TOP OF CUT	
TOE OF SLOPE	

SURVEYED BY : L. ORVIS
 SURVEYED DATE : OCTOBER 2006

DATUM
 VERTICAL NAVD 88
 HORIZONTAL NAD 83 (92)

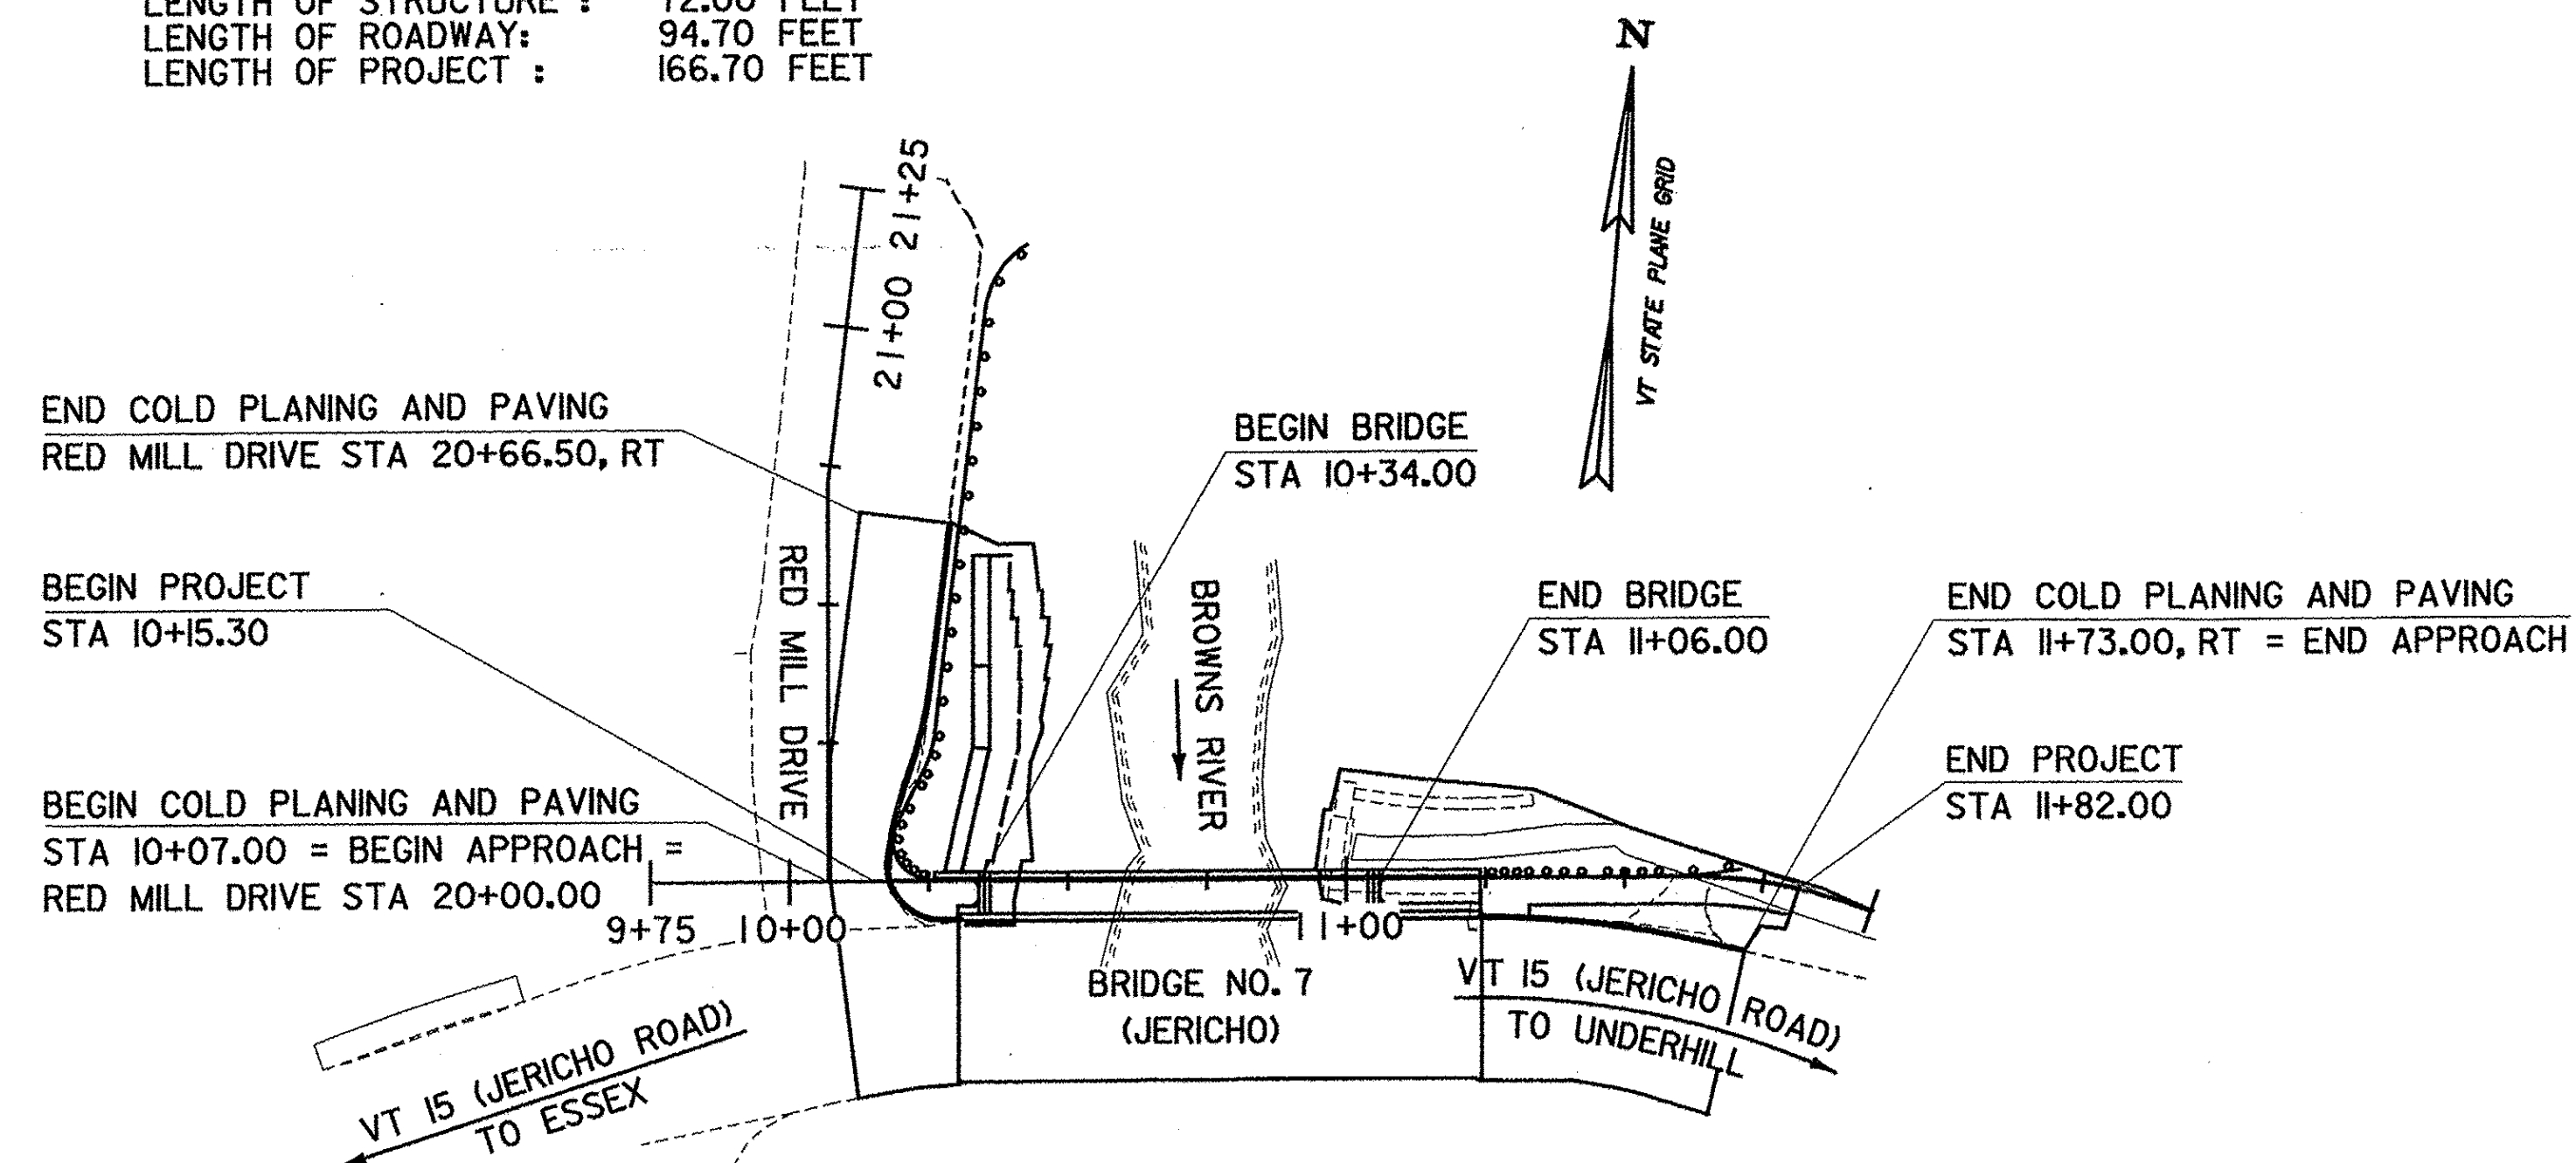

PLAN

SCALE 1" = 30' - 0"
 30 0 30

THESE PLANS ARE SUBJECT TO SUCH ENGINEERING CHANGES AS MAY BE REQUIRED BY THE FEDERAL HIGHWAY ADMINISTRATION OR THE DIRECTOR OF PROGRAM DEVELOPMENT.

CONSTRUCTION IS TO BE CARRIED ON IN ACCORDANCE WITH THESE PLANS AND THE STANDARD SPECIFICATIONS FOR CONSTRUCTION DATED 2011, AS APPROVED BY THE FEDERAL HIGHWAY ADMINISTRATION ON JULY 20, 2011 FOR USE ON THIS PROJECT, INCLUDING ALL SUBSEQUENT REVISIONS AND SUCH REVISED SPECIFICATIONS AND SPECIAL PROVISIONS AS ARE INCORPORATED IN THESE PLANS.

DIRECTOR OF PROGRAM DEVELOPMENT	
APPROVED <i>Karl J. Marshall</i>	DATE 4/1/14
PROJECT MANAGER: MARK SARGENT	
PROJECT NAME: JERICO	
PROJECT NUMBER: STP FTBR (3)	
SHEET 1 OF 62 SHEETS	