



# TYPICAL SECTIONS

MATERIAL ITEM	THICKNESS TOLERANCE
PAVEMENT (TOTAL DEPTH)	+1/4"
SUBBASE	+1"

1 1/4"	WEARING COURSE, SPECIAL PROVISION (BITUMINOUS CONCRETE PAVEMENT, SMALL QUANTITY), TYPE IVS
4"	BASE COURSE, BITUMINOUS CONCRETE GUTTER AND TRAFFIC ISLAND, TYPE IIS, 2 - 2" LIFTS
12"	SUBBASE OF DENSE GRADED CRUSHED STONE

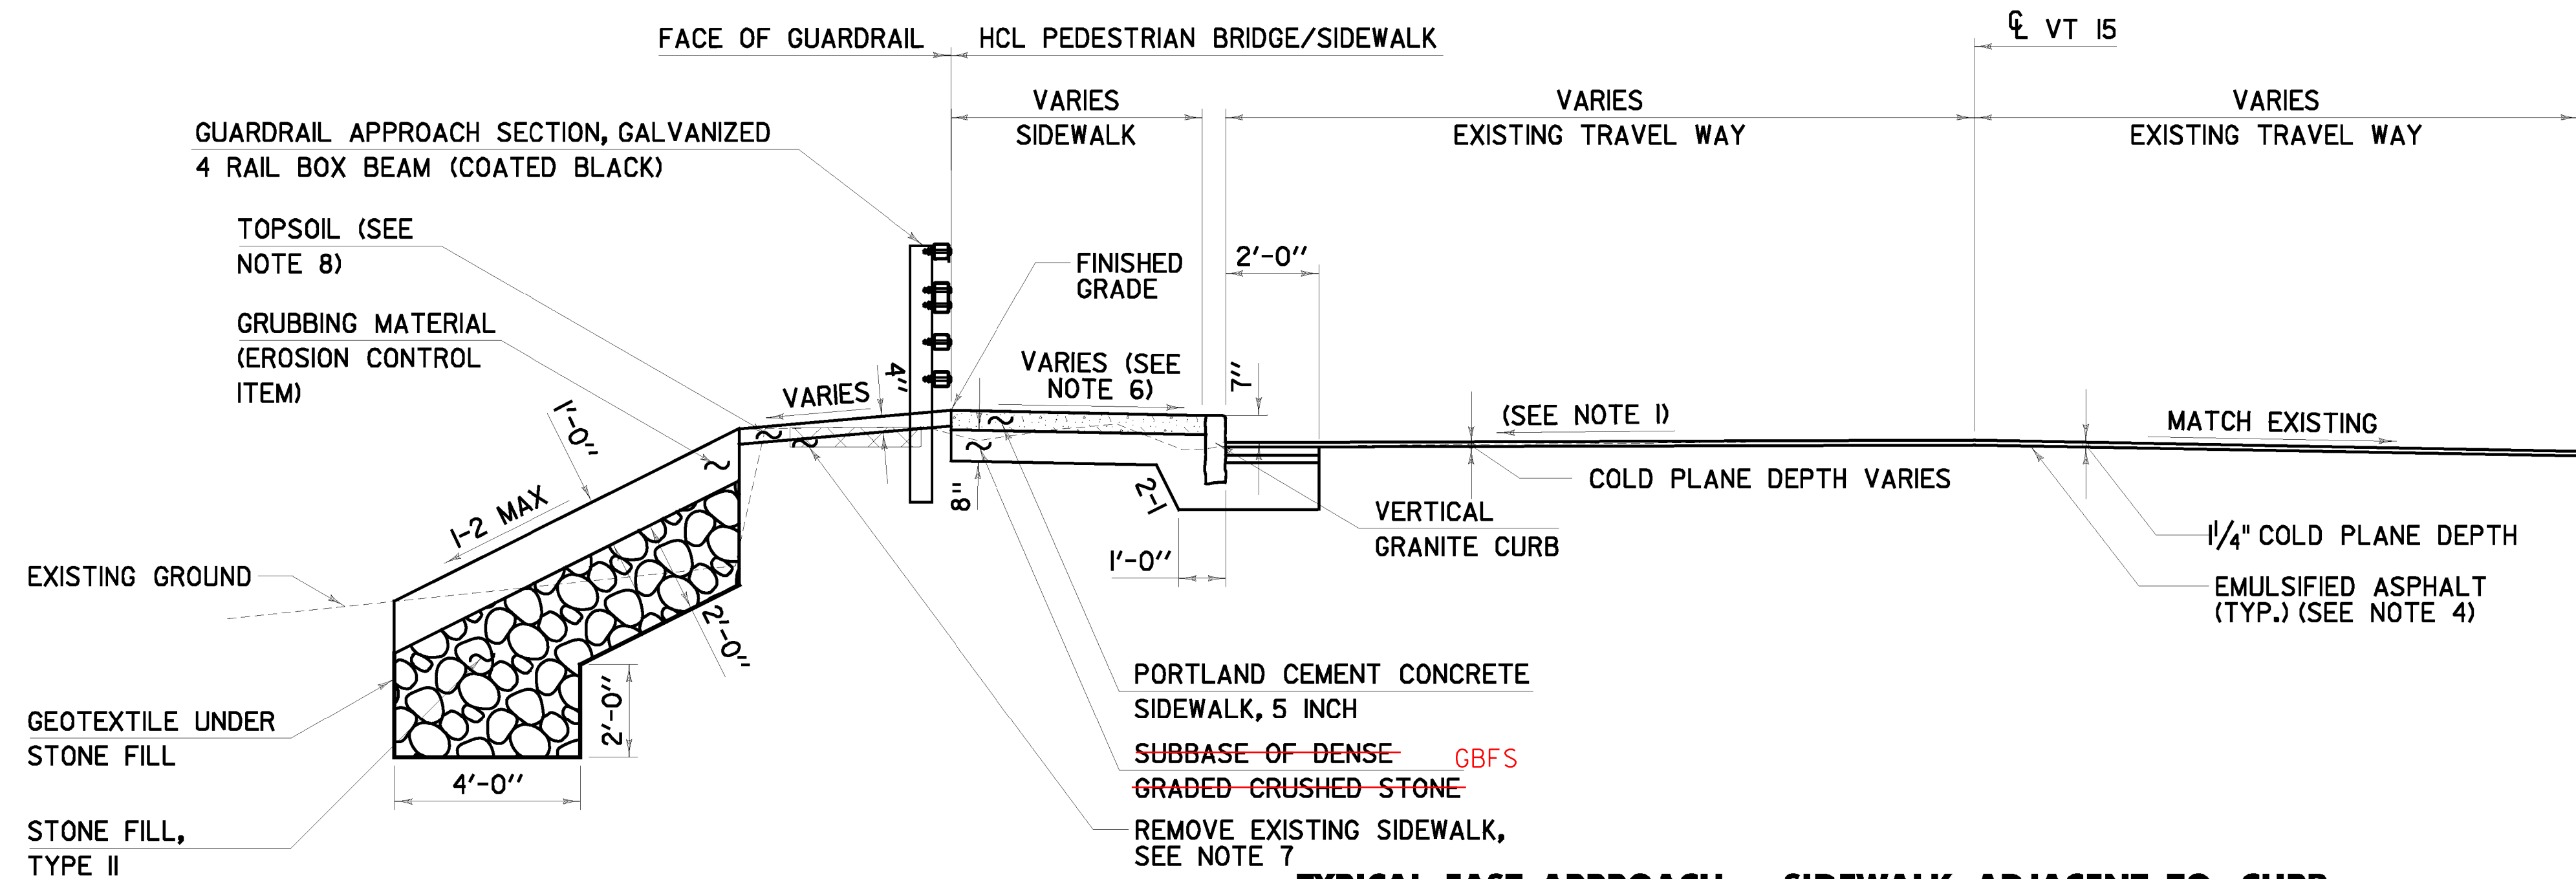

**TYPICAL EAST APPROACH - SIDEWALK ADJACENT TO CURB**  
STA 11+20.00 TO STA 11+32.85

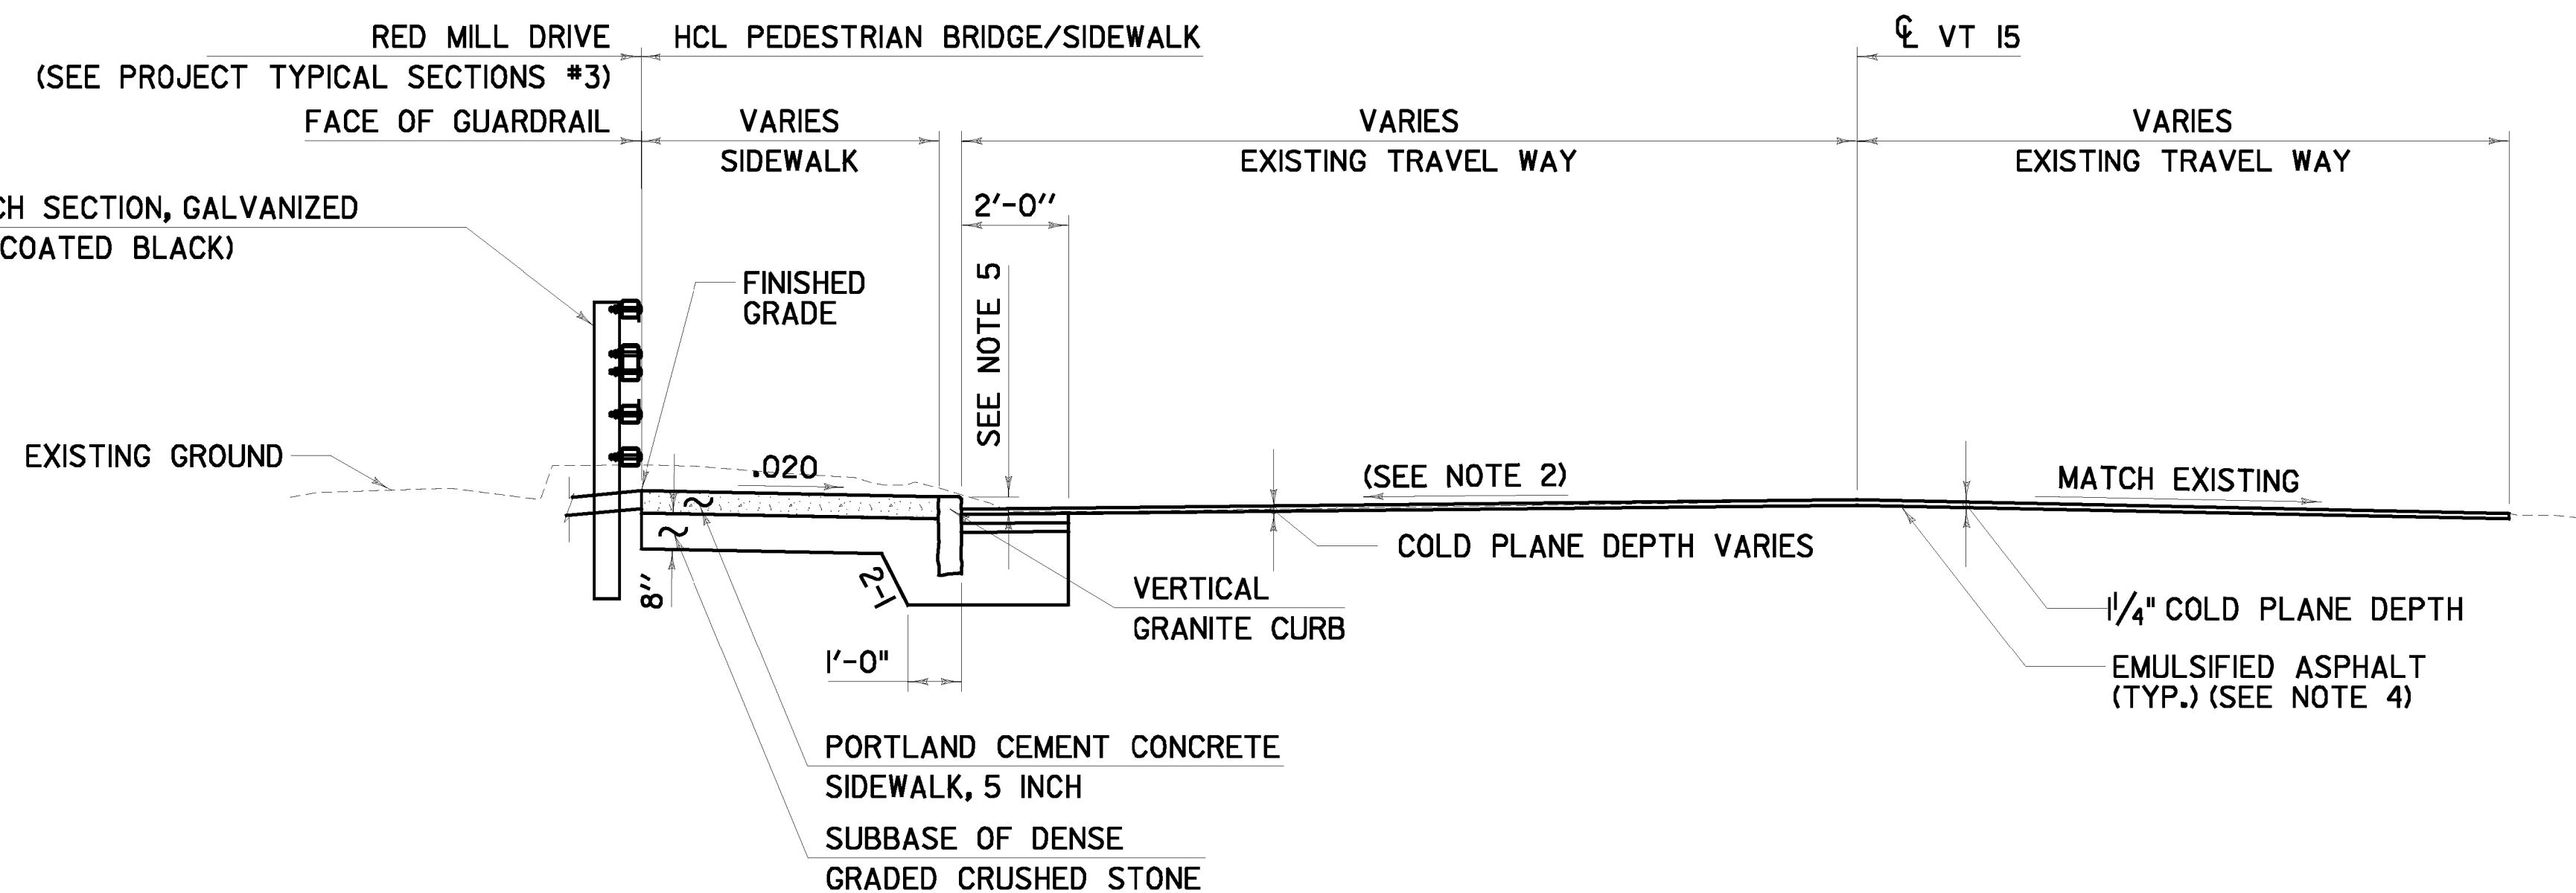

**TYPICAL WEST APPROACH - SIDEWALK RAMP**  
STA 10+07.00 TO STA 10+30.00

## NOTES

- MODIFY ROADWAY CROSS SLOPE ON EAST AND WEST APPROACHES AS REQUIRED TO MATCH EXISTING GRADE AT THE VT 15 CROWN LINE AND TO ACHIEVE THE CURB REVEAL SHOWN ON CROSS SECTIONS. CURB REVEAL TRANSITION DESCRIBED IN NOTE 5.
- MODIFY ROADWAY CROSS SLOPE ON WEST APPROACH TO ACHIEVE THE CURB REVEAL SHOWN ON CROSS SECTIONS OR AS DIRECTED BY THE ENGINEER. MATCH EXISTING PAVEMENT CROSS SLOPE AT STA 10+30.0. CURB REVEAL TRANSITION DESCRIBED IN NOTE 5.
- FOR AREAS OF NEW CURB INSTALLATION, EXISTING PAVEMENT SHALL BE SAWCUT 2' FROM PROPOSED FACE OF NEW GRANITE CURB. SAWCUT WILL BE CONSIDERED INCIDENTAL TO ITEM 900.680 SPECIAL PROVISION (BITUMINOUS CONCRETE PAVEMENT, SMALL QUANTITY).
- COLD PLANED SURFACES SHALL HAVE A TACK COAT APPLICATION RATE OF 0.08 GAL/SQ. YD. OF CRS-IH OR RS-IH. TACK COAT APPLICATION ON ALL OTHER PAVED SURFACES SHALL BE 0.025 TO 0.040 GAL/SQ. YD. OF CRS-IH OR RS-IH. TACK COAT SHALL BE PAID FOR UNDER ITEM 900.683 SPECIAL PROVISION (EMULSIFIED ASPHALT) (RS-IH OR CRS-IH).
- TRANSITION CURB REVEAL ALONG LENGTH OF SIDEWALK RAMP FROM 1" AT STA 10+22.6 TO 7" AT STA 10+30.0. SEE CROSS SECTIONS FOR CURB ELEVATION AND REVEAL.
- TRANSITION SIDEWALK CROSS SLOPE FROM -.020 AT STA 11+30.0 TO +.020 AT STA 11+60.0.
- REMOVE EXISTING CONCRETE SIDEWALK FROM STA 11+00.6 TO STA 11+82.0, LT AND RT. EXCAVATION PAID UNDER ITEM 203.16 SOLID ROCK EXCAVATION. SHOULD BACKFILL MATERIAL BE REQUIRED, IT SHALL COME FROM THE PROJECT'S EARTHWORK SURPLUS, AND MEET THE MATERIAL REQUIREMENTS OF EARTH BORROW, SUBSECTION 703.02 OF THE STANDARD SPECIFICATIONS.
- TURF SHALL BE ESTABLISHED ON TOPSOILED AREAS AS SHOWN ON THE EROSION CONTROL FINAL CONDITION PLAN SHEET, SHEET 58, AND THE EROSION CONTROL DETAILS SHEET #2, SHEET 60.

SCALE 3/8" = 1'-0"  
1 0 1 2 3 4

CHA

PROJECT TYPICAL SECTIONS #1	PROJECT NAME: JERICHO	
	PROJECT NUMBER: STP FTBR (3)	PLOT DATE: 4/7/2014
PROJECT LEADER: M.D.S.	DRAWN BY: C.R.H.	
DESIGNED BY: C.R.H.	CHECKED BY: D.E.G.	
DWG. NO.: TYP-1	SHEET 3 OF 62	