

60L0910 15" CPEP 12+50
 STA 11+63.0 - STA 11+67.6 RT (12.0 LF)
~~604.47 CAST IRON GRATE WITH FRAME, TYPE D~~
~~STA 11+67.6 RT (1 EACH) PART OF C.O. 006~~
 605.10 6 INCH UNDERDRAIN PIPE
 STA 20+03.0 - STA 20+59.1 RT (56.0 LF)
 605.20 6 INCH UNDERDRAIN CARRIER PIPE
 STA 10+29.7 - STA 10+42.5 LT (12.8 LF)
 STA 20+03.0 RT (12.7 LF)
 STA 20+59.1 RT (8.7 LF)
~~605.23 12 INCH UNDERDRAIN CARRIER PIPE~~
~~STA 20+36.4 RT (2.1 LF)~~
~~STA 20+42.4 RT (3.1 LF)~~
~~STA 20+47.4 RT (4.1 LF)~~
~~STA 20+52.4 RT (3.0 LF)~~
 605.95 UNDERDRAIN FLUSHING BASIN
 STA 20+03.0 RT (1 EACH)
 STA 20+59.1 RT (1 EACH)
 END COLD PLANING AND PAVING
 STA 20+66.50, RT

TEMPORARY POLE TO REMAIN,
 TELEPHONE AERIAL ROUTING
 BY OTHERS

BEGIN PROJECT
 STA 10+15.30

BEGIN APPROACH
 PEDESTRIAN BRIDGE/SIDEWALK
 POT STA 10+07.00
 = BEGIN RED MILL DRIVE
 POB STA 20+00.00
 $\Delta = 90^{\circ}00'00"$

1

CHAMPLAIN OIL COMPANY, INC., LESSOR
RAY ELY d/b/a CHITTENDEN MILLS, LLC, LESSEE

96.88°
 N74°E

FACE OF GUARDRAIL
 BACK OF SIDEWALK
 R = 10'

PAVED DRIVE

GRASS

COMB
 40T/160/209

BENCHMARK NO. 6:
 CHISELED SQUARE TOP,
 SW CONCRETE WING WALL
 EL: 534.33

2

JERICO HISTORICAL SOCIETY, INC.

JERICO HISTORICAL SOCIETY, INC.

INSTALL (T)

INSTALL & MAINT (P)

RECONSTRUCT (T)

REMOVE & REPLACE (T)

INSTALL & MAINT (P)

INSTALL & MAINT (P)

RECONSTRUCT (T)

173°

10+00

10+25

1+00

1+25

LIMITS OF COLD PLANING AND PAVING OVERLAY (TYP.)

PULL BOX, STANDARD

REMOVE EXISTING CONDUIT, SEE NOTE 2

FENCE TO BE RETAINED BEYOND CONSTRUCTION LIMITS

WIRED CONDUIT (1/4") (PVC)
 INSTALL & MAINT (P)
 REMOVE AND RESET LIGHT POLE (TYP.)
 REMOVING AND RESETTING FENCE SPECIAL PROVISION (REMOVAL OF TEMPORARY TRAFFIC BARRIER)
 SPECIAL PROVISION (ORNAMENTAL STREET LIGHT)

BEGIN BRIDGE
 STA 10+34.00

PEDESTRIAN BRIDGE/SIDEWALK
 POT STA 10+75.00
 = CHANNEL LINE
 POT STA 10+73.00
 $\Delta = 90^{\circ}00'00"$

ITEM 900.640 SPECIAL PROVISION (ORNAMENTAL FENCE)

BRIDGE NO. 7 (JERICO)

STATE OF VERMONT

NOTES

1. REMOVE ALL UNDERGROUND ELECTRICAL CONDUIT BEYOND THE NEW JUNCTION BOX AT STA 11+74.0. INITIAL DISCOVERY OF THE CONDUIT SHALL BE PAID UNDER ITEM 204.22 TRENCH EXCAVATION OF EARTH, EXPLORATORY. FURTHER EXCAVATION SHALL BE PAID UNDER ITEM 204.20 TRENCH EXCAVATION OF EARTH.
2. REMOVE ALL UNDERGROUND ELECTRICAL CONDUIT BEYOND THE NEW JUNCTION BOX AT STA 20+76.0. INITIAL DISCOVERY OF THE CONDUIT SHALL BE PAID UNDER ITEM 204.22 TRENCH EXCAVATION OF EARTH, EXPLORATORY. FURTHER EXCAVATION SHALL BE PAID UNDER ITEM 204.20 TRENCH EXCAVATION OF EARTH, UNLESS EXCAVATION FALLS WITHIN THE LIMITS OF ITEM 204.25 STRUCTURE EXCAVATION, IN WHICH CASE IT SHALL BE INCIDENTAL TO THAT ITEM.
3. REMOVE EXISTING BITUMINOUS & CONCRETE SIDEWALK FROM STA 11+00.6 TO STA 11+82.0, PAID UNDER ITEM 203.16 SOLID ROCK EXCAVATION.
4. APPROXIMATELY 88 FT OF FENCE IS TO BE REMOVED PER ITEM 620.55. APPROXIMATELY 76.65 FT IS TO BE REINSTALLED IN ACCORDANCE WITH ITEM 620.50. THE REMAINDER SHALL BECOME THE PROPERTY OF THE TOWN.

3

KOZLOWSKI, JAMES S.; KOZLOWSKI, ADAM J.; KOZLOWSKI, TONYA L.L.

REMOVE EXISTING BITUMINOUS & CONCRETE SIDEWALK, SEE NOTE 3

CONCRETE SIDEWALK

WIRED CONDUIT (1/4") (PVC)

REMOVE AND RESET POLE (TYP.)

NEW 4' x 4' RCDI, W/GRATE, TYPE D @ INLET AND 15" x 12" CPEP, CONNECT NEW PIPE TO EXISTING 15" CPEP, REMOVE EXISTING DI PULL BOX (STANDARD)

END PROJECT STA 11+82.00

678.23 WIRED CONDUIT (1/4") (PVC) (68 LF)
 11+34.0 STA 11+35.0 - STA 11+74.0 LT (42.6 LF) 11+91.0
 20+04.0 STA 20+07.0 - STA 20+76.0 RT (66.8 LF) 20+82.0
 678.25 PULL BOX, STANDARD
 STA 11+74.0 RT (1 EACH) NOT INSTALLED
 STA 20+76.0 RT (1 EACH) NOT INSTALLED
 679.21 LIGHT POLE BASE
 STA 11+35.0 LT (1 EACH) 11+34.0
 STA 11+60.0 LT (1 EACH) 11+63.0
 STA 20+05.0 RT (1 EACH)
 STA 20+35.0 RT (1 EACH) 10+28LT 43
 STA 20+62.5 RT (1 EACH) 10+35LT 82
 679.25 REMOVING AND RESETTING LIGHT POLE
 STA 11+35.0 LT (1 EACH) 11+34.0
 STA 11+60.0 LT (1 EACH) 11+60.0
 STA 20+35.0 RT (1 EACH) 10+28LT 43
 STA 20+62.5 RT (1 EACH) 10+35LT 82
 900.620 SPECIAL PROVISION (ORNAMENTAL STREET LIGHT)
 STA 20+07.0 RT (1 EACH)
 10+28.0 LT 3.5'
 STA 12+50 RT
 NEW CB W/FRAME & GRATE, TYPE E

END BRIDGE STA 11+06.00

EXISTING FENCE TO BE REMOVED (TYP.)

SEE SUBSTRUCTURE REMOVAL DETAILS, SHEET 30

VERTICAL GRANITE CURB (TYP.)
 REMOVE EXISTING CONDUIT, SEE NOTE 1

END APPROACH STA 11+73.00


VT 15 (JERICO ROAD) TO UNDERHILL

GRASS

PAVED DRIVE

AER E&T

NOTE:
 SEE SHEET 62 OF 62 FOR R.O.W. LAYOUT SHEET. SHEET 62 IS TO BE USED FOR R.O.W. INFORMATION ONLY

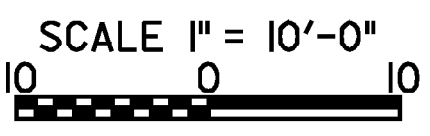

LAYOUT PLAN

PROJECT NAME: JERICO	PROJECT NUMBER: STP FTBR (3)	PROJECT LEADER: M.D.S.	DESIGNED BY: C.R.H.	DWG. NO.: L-01
PROJECT DATE: 4/7/2014		DRAWN BY: C.R.H.		CHECKED BY: D.E.G.
SHEET 16 OF 62				

FILE NAME: V:\Projects\ANY\K2\21113\CAADD\MSTN\08F004\Consult\ents\2081\084L01.dgn
 DATE/TIME: 4/7/2014 4:46:16
 USER: c496