


**PROFILE  
PEDESTRIAN BRIDGE /  
SIDEWALK**

**NOTES:**

- GRADES SHOWN TO NEAREST TENTH REPRESENT EXISTING GROUND ELEVATIONS ALONG BACK OF SIDEWALK.
- GRADES SHOWN TO NEAREST HUNDREDTH REPRESENT FINISHED GRADE ELEVATIONS ALONG BACK OF SIDEWALK.
- GRADES BASED ON RESIDUAL CAMBER AFTER ALL DEAD LOADS ARE APPLIED.

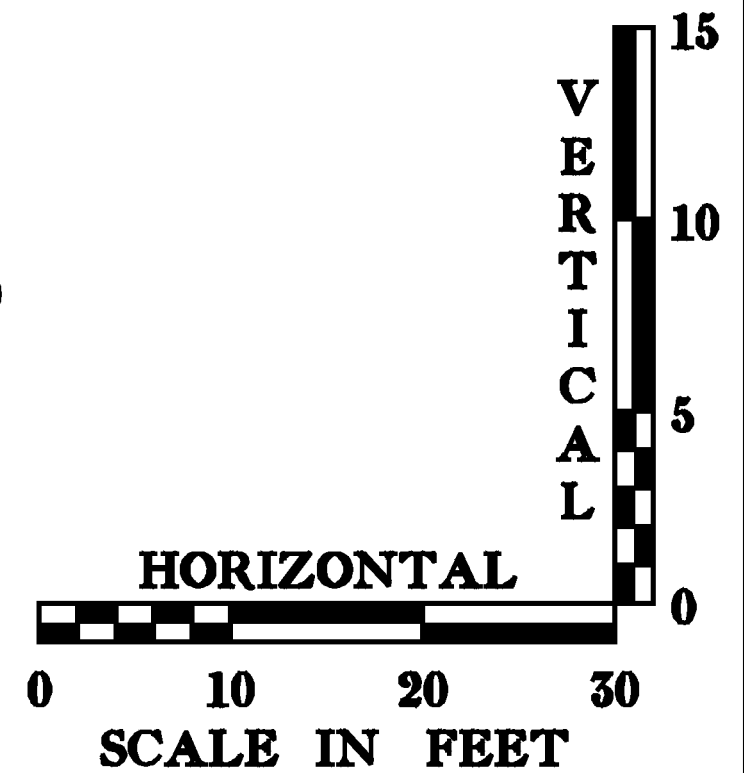

<b>PEDESTRIAN BRIDGE/ SIDEWALK PROFILE</b>	PROJECT NAME: JERICHO	PROJECT NUMBER: STP FTBR (3)
	PROJECT LEADER: M.D.S. DESIGNED BY: C.R.H. DWG. NO.: PRO-1	PLOT DATE: 4/7/2014 DRAWN BY: C.R.H. CHECKED BY: D.E.G. SHEET 17 OF 62

FILE NAME: V:\Projects\ANY\K2\21113\CA00\MSTN\08F004\Consultants\208F004\prof11.eudgn  
 DATE/TIME: 4/7/2014  
 USER: 4916