

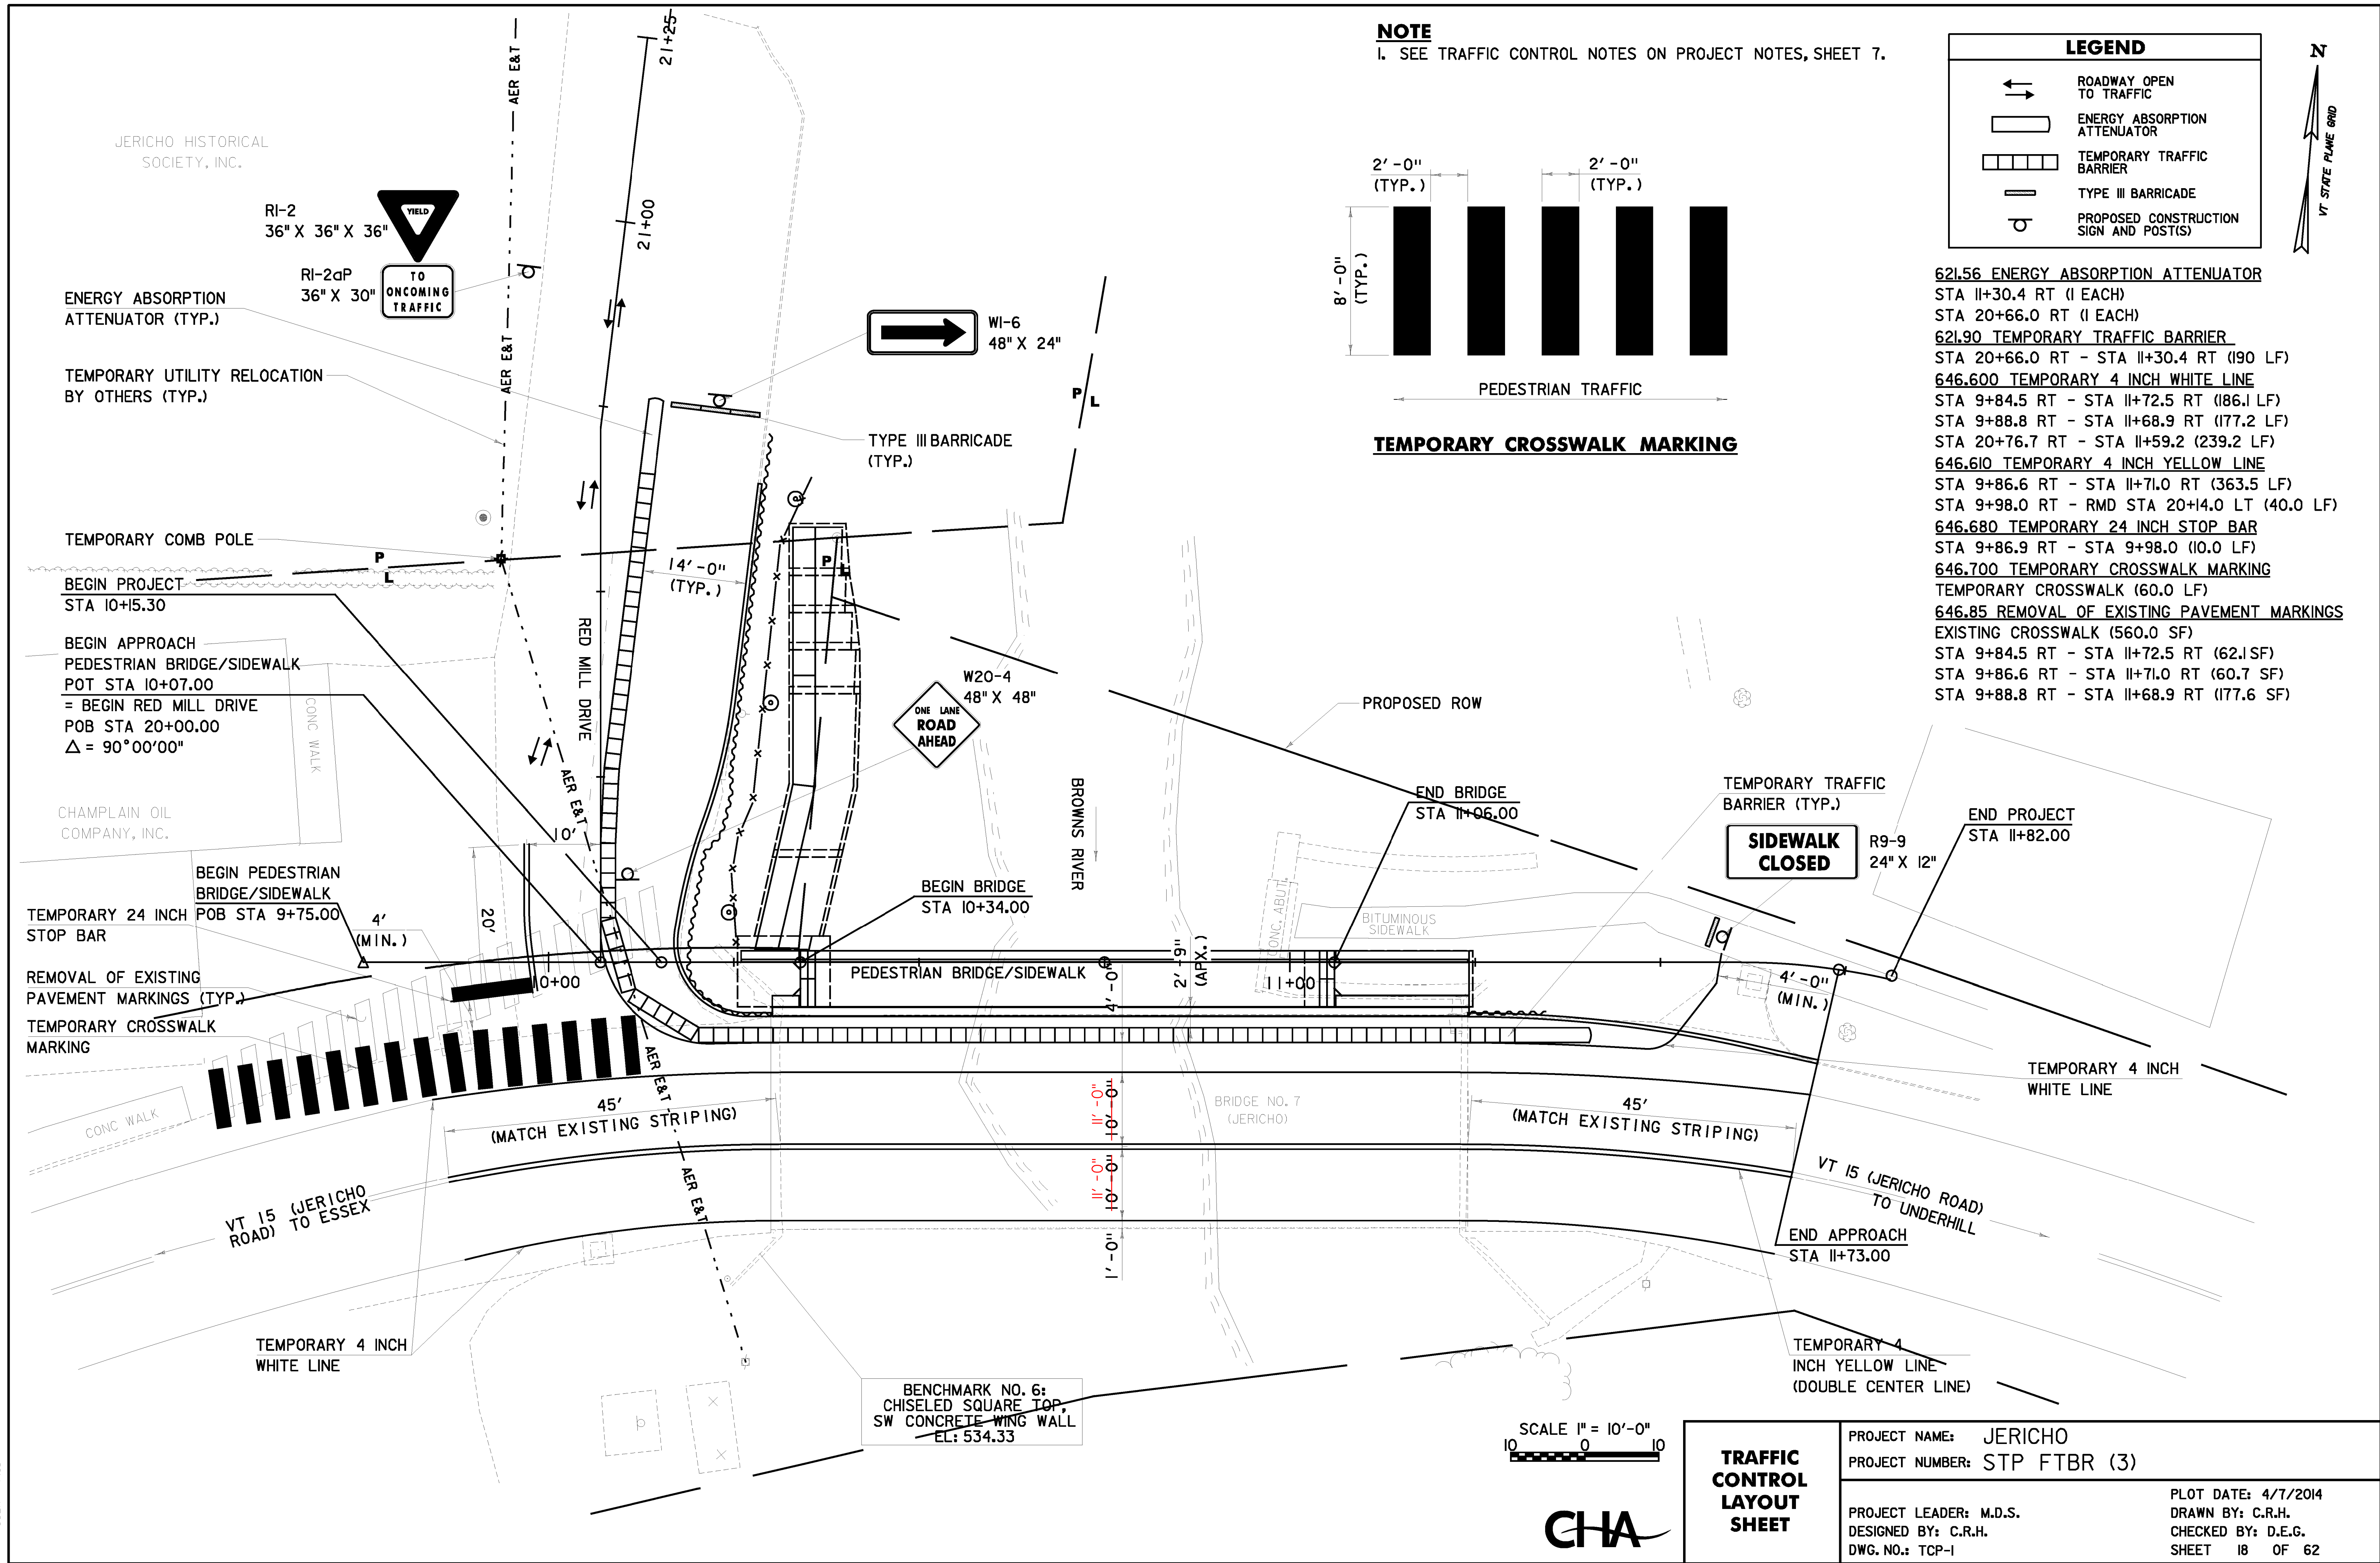


FILE NAME = V:\Projects\ANY\K2\21113\CADD\MSTN\08F004\Consult\to\208F004.tcdgm
 DATE/TIME = 4/7/2014
 USER = 4916

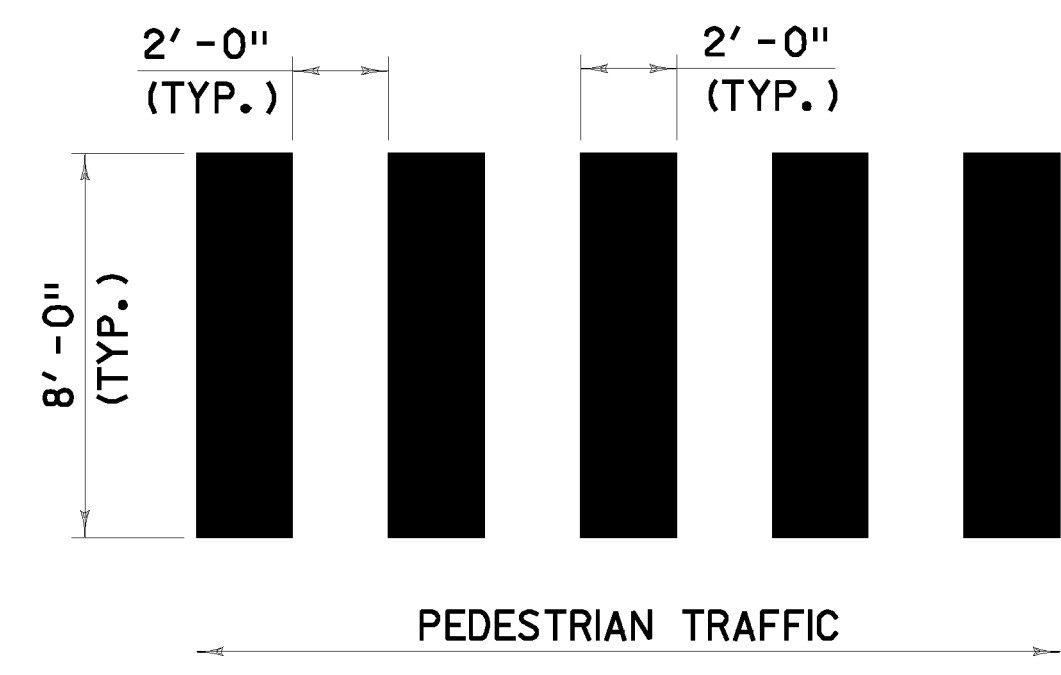

NOTE
 I. SEE TRAFFIC CONTROL NOTES ON PROJECT NOTES, SHEET 7.


LEGEND	
	ROADWAY OPEN TO TRAFFIC
	ENERGY ABSORPTION ATTENUATOR
	TEMPORARY TRAFFIC BARRIER
	TYPE III BARRICADE
	PROPOSED CONSTRUCTION SIGN AND POST(S)

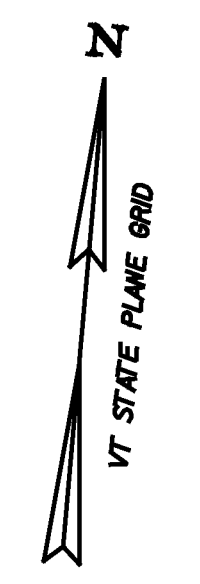

TEMPORARY CROSSWALK MARKING

- 621.56 ENERGY ABSORPTION ATTENUATOR
 STA 11+30.4 RT (1 EACH)
 STA 20+66.0 RT (1 EACH)
- 621.90 TEMPORARY TRAFFIC BARRIER
 STA 20+66.0 RT - STA 11+30.4 RT (190 LF)
- 646.600 TEMPORARY 4 INCH WHITE LINE
 STA 9+84.5 RT - STA 11+72.5 RT (186.1 LF)
 STA 9+88.8 RT - STA 11+68.9 RT (177.2 LF)
 STA 20+76.7 RT - STA 11+59.2 (239.2 LF)
- 646.610 TEMPORARY 4 INCH YELLOW LINE
 STA 9+86.6 RT - STA 11+71.0 RT (363.5 LF)
 STA 9+98.0 RT - RMD STA 20+14.0 LT (40.0 LF)
- 646.680 TEMPORARY 24 INCH STOP BAR
 STA 9+86.9 RT - STA 9+98.0 (10.0 LF)
- 646.700 TEMPORARY CROSSWALK MARKING
 TEMPORARY CROSSWALK (60.0 LF)
- 646.85 REMOVAL OF EXISTING PAVEMENT MARKINGS
 EXISTING CROSSWALK (560.0 SF)
 STA 9+84.5 RT - STA 11+72.5 RT (62.1 SF)
 STA 9+86.6 RT - STA 11+71.0 RT (60.7 SF)
 STA 9+88.8 RT - STA 11+68.9 RT (177.6 SF)

SIDEWALK CLOSED

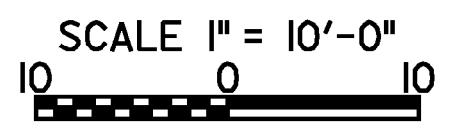

TRAFFIC CONTROL LAYOUT SHEET	PROJECT NAME: JERICHO	PROJECT NUMBER: STP FTBR (3)
	PROJECT LEADER: M.D.S.	DESIGNED BY: C.R.H.
	DWG. NO.: TCP-1	
	PLOT DATE: 4/7/2014	DRAWN BY: C.R.H.
		CHECKED BY: D.E.G.
		SHEET 18 OF 62