




DETAIL 5
SCALE 3/4" = 1'-0"

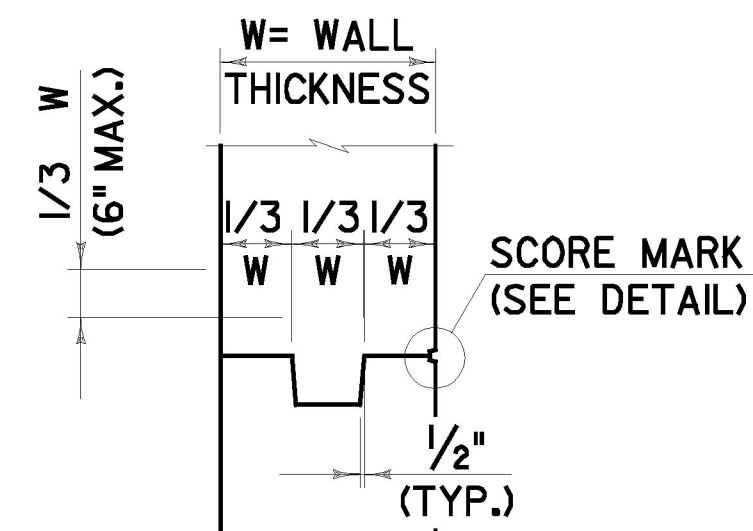


DETAIL 6
SCALE 1/2" = 1'-0"

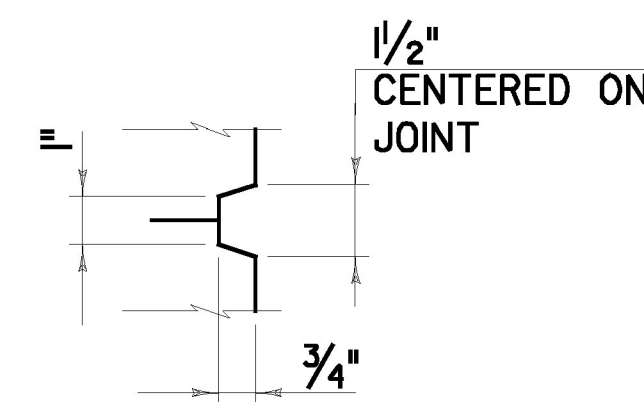


SCORE MARK DETAIL
NOT TO SCALE

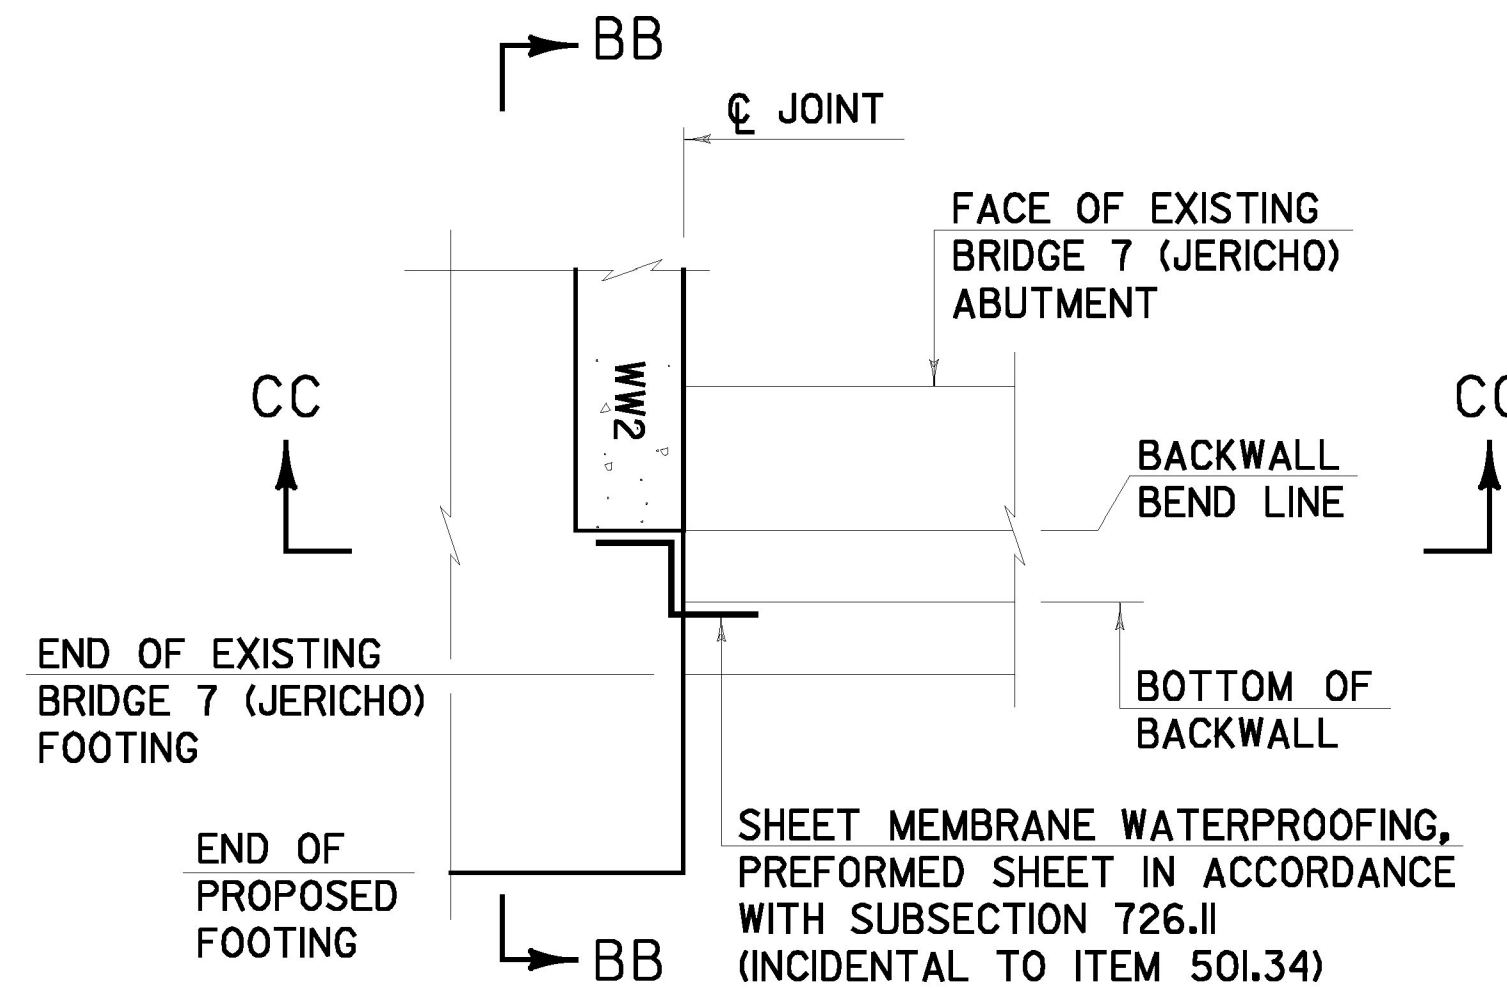


DETAIL 9
(ABUT. 1 SHOWN, ABUT. 2 SIMILAR)
SCALE 3/8" = 1'-0"

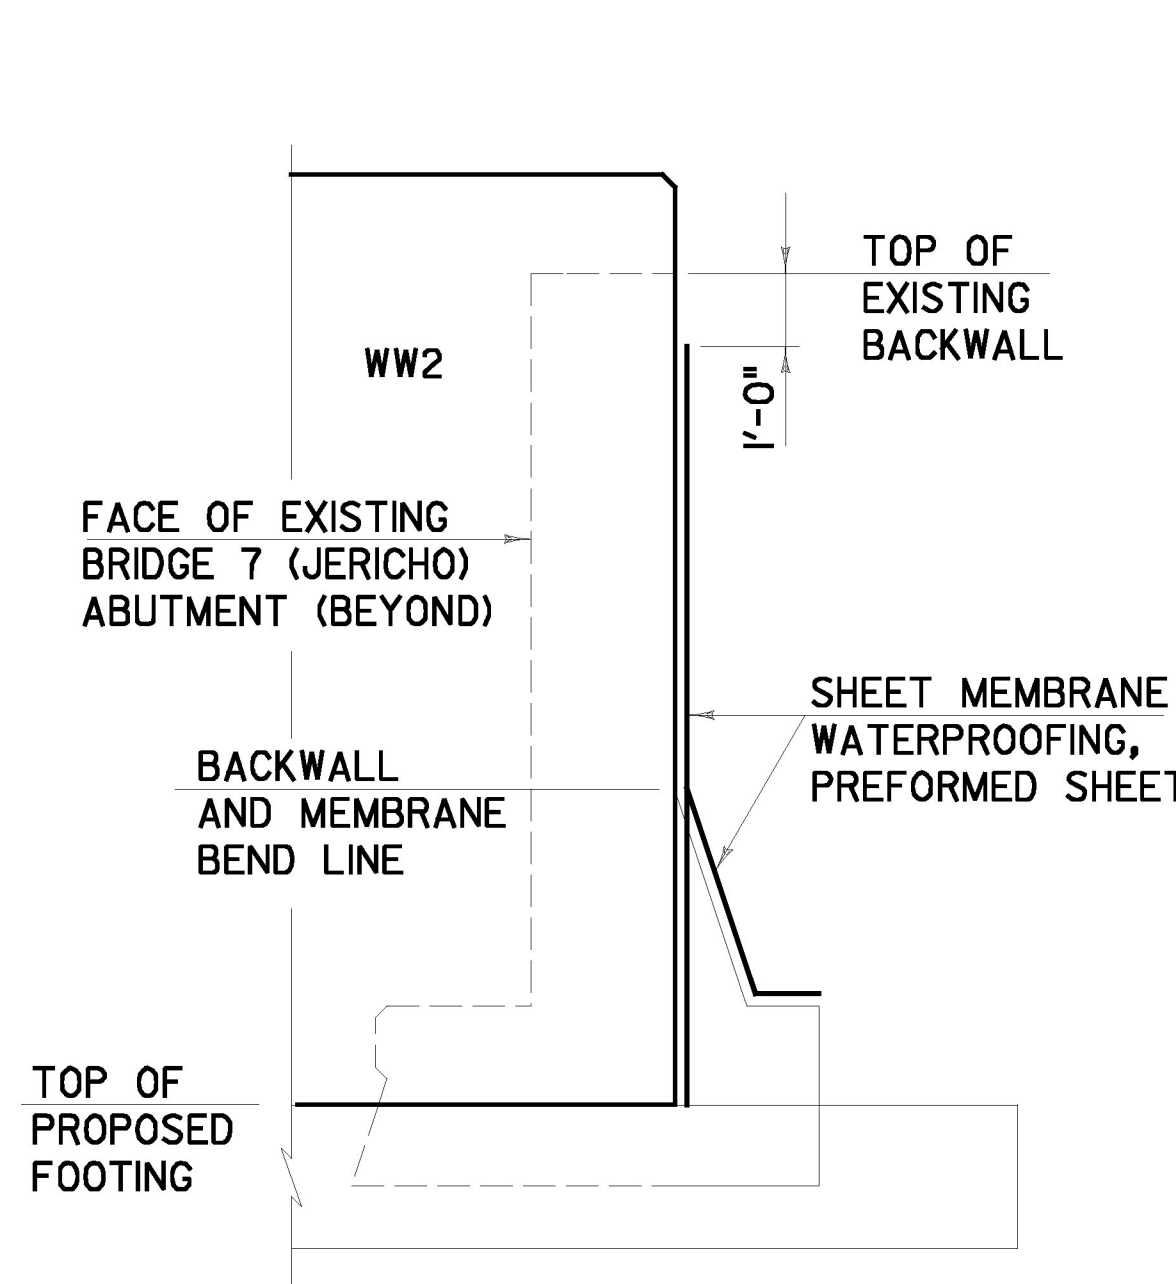



SECTION BB-BB
SCALE 3/8" = 1'-0"

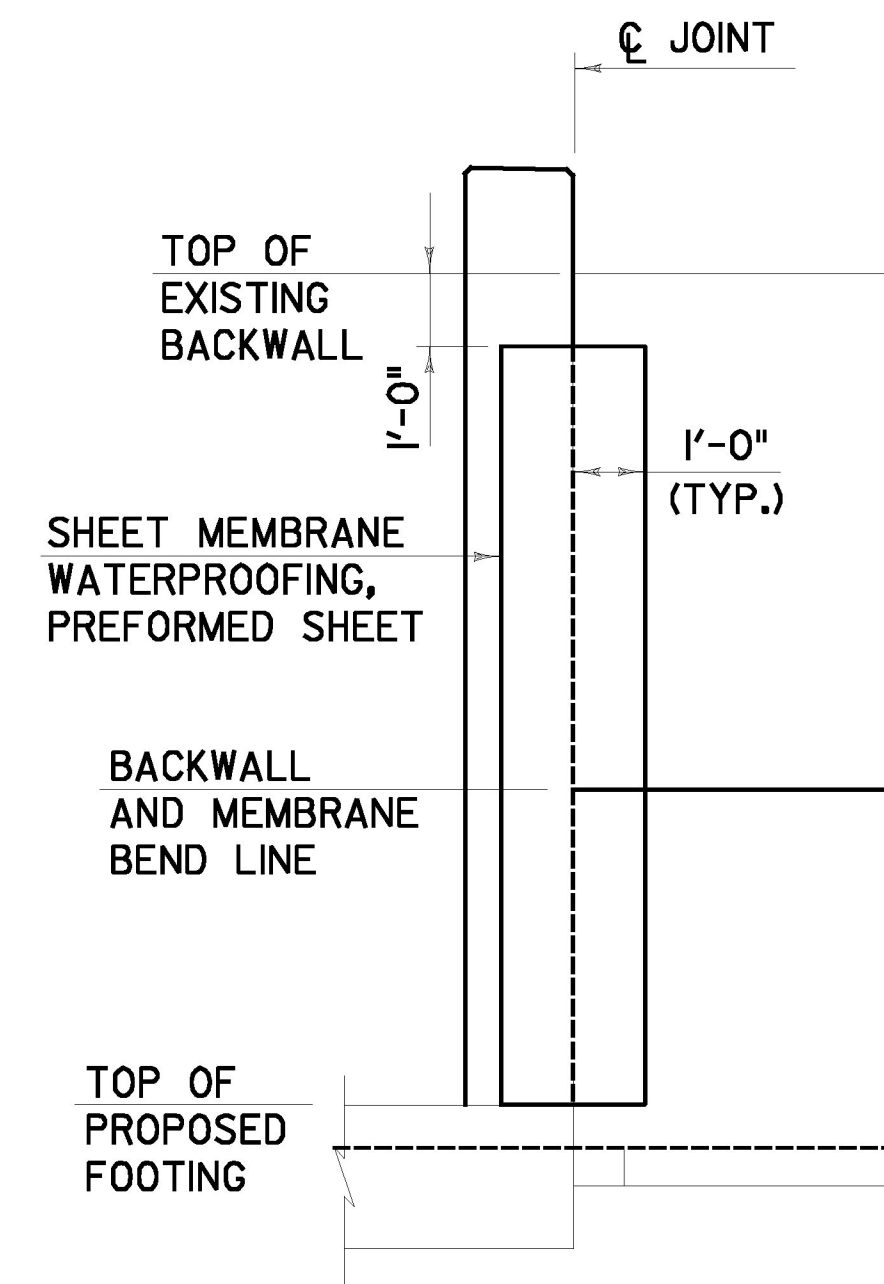

SECTION CC-CC
SCALE 3/8" = 1'-0"

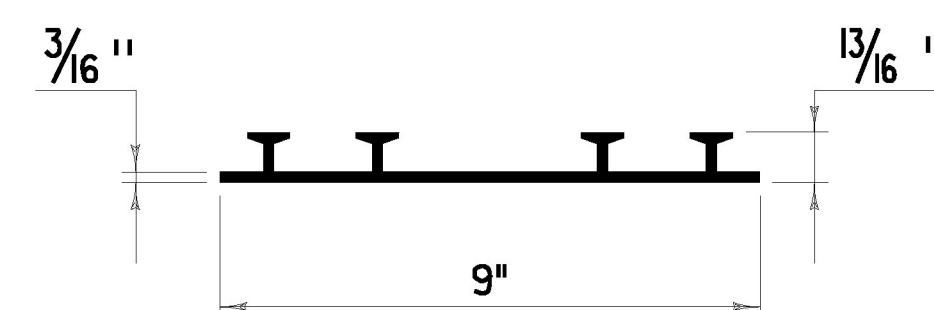


P.V.C. WATERSTOP
NOT TO SCALE

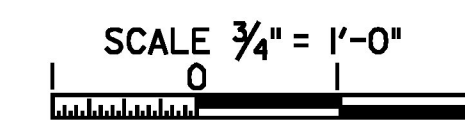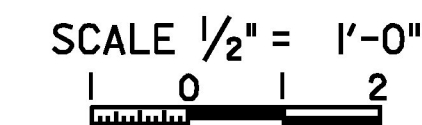


NOTES:


- CONSTRUCTION JOINTS THROUGH CONCRETE CURBS SHALL BE SPACED AT A MAXIMUM OF 15'-0" CENTER TO CENTER. CONCRETE SHALL BE PLACED IN ALTERNATING SECTIONS WITH A MINIMUM OF 48 HOURS BETWEEN ADJACENT POURS. THE CONTRACTOR HAS THE OPTION TO ELIMINATE THE CURB JOINTS AND MAKE THE CURB PLACEMENT USING A SHRINKAGE ADMIXTURE APPROVED BY THE VTRANS MATERIALS AND RESEARCH LABORATORY. THE COST OF ANY SUCH ADMIXTURE SHALL BE INCIDENTAL TO ITEM 501.33.
- LONGITUDINAL REINFORCING SHALL PASS THROUGH CONCRETE CURB CONSTRUCTION JOINTS.
- WATERSTOP MATERIAL SHALL BE IN ACCORDANCE WITH STANDARD SPECIFICATION SUBSECTION 707.10. THE SELECTED WATERSTOP SYSTEM SHALL BE APPROVED BY THE VTRANS MATERIALS AND RESEARCH LABORATORY. THE COST FOR P.V.C. WATERSTOP SHALL BE INCIDENTAL TO ITEM 501.33.

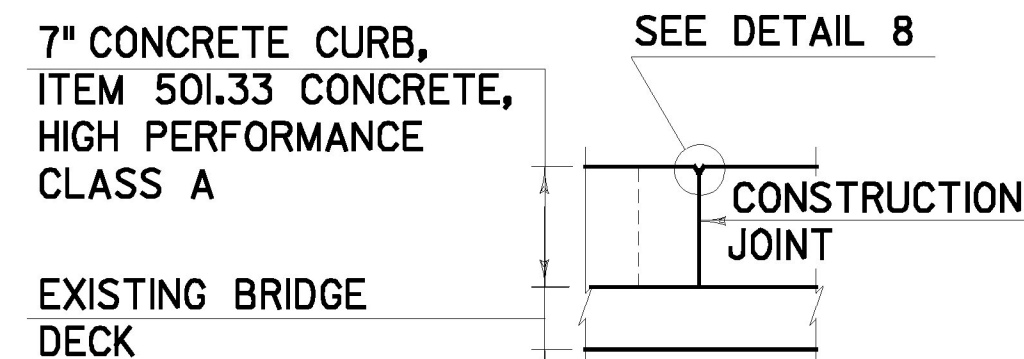

DETAIL 7
SCALE 3/4" = 1'-0"

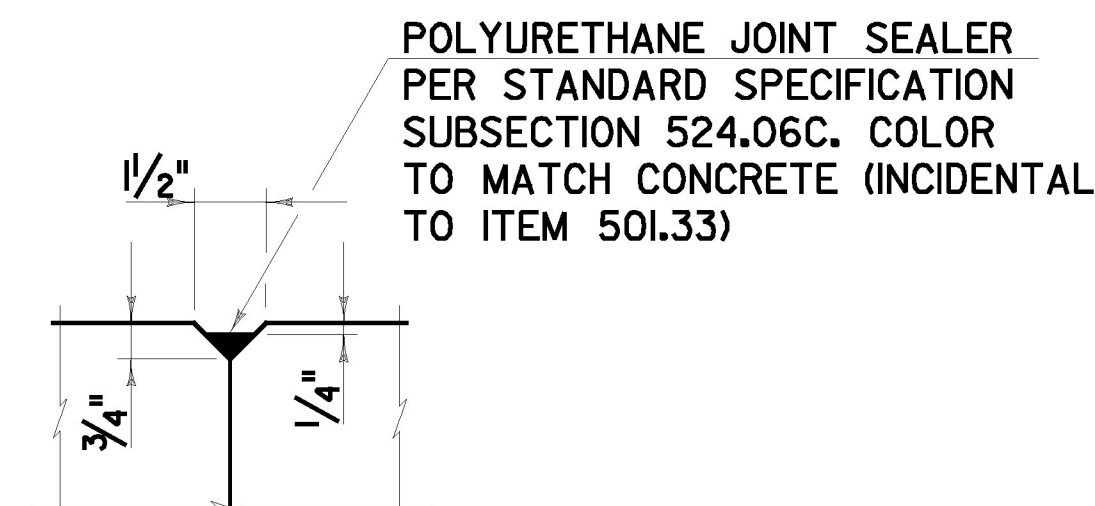

DETAIL 8
NOT TO SCALE

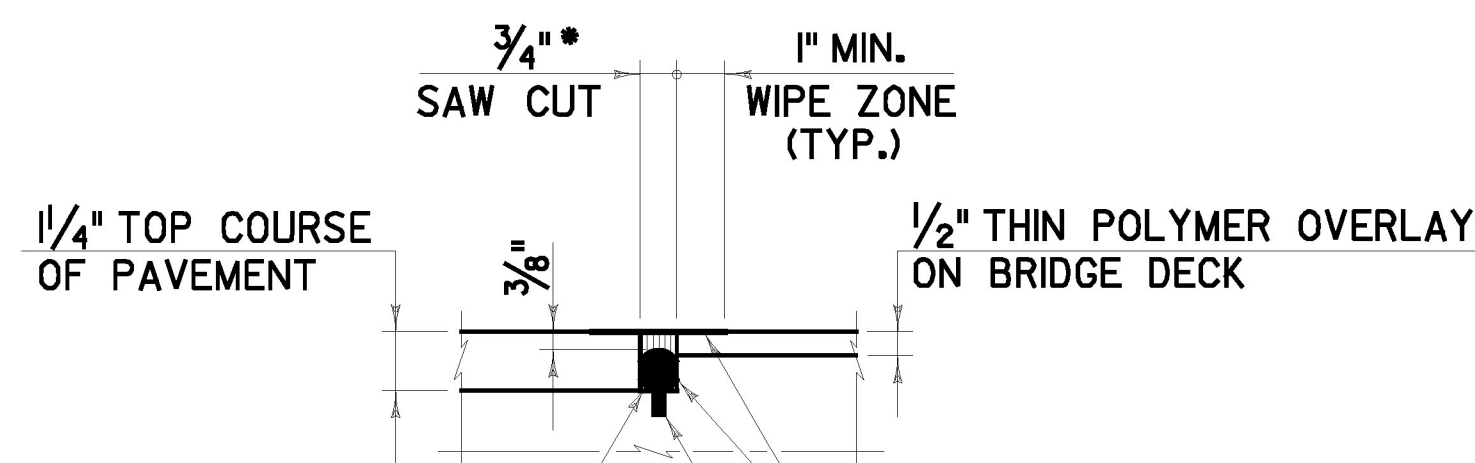

HOT POURED JOINT DETAIL
NOT TO SCALE

3/8" DIA. HEAT RESISTANT BACKER ROD, COMPRESSION FIT REQUIRED TO INSURE THAT POSITION IS MAINTAINED DURING FILLING OPERATION (INCIDENTAL TO ITEM 524.II)

SURFACES TO BE SANDBLASTED ON BOTH SIDES OF JOINT

1/4" WIDE X 1/2" DEEP SAW CUT INTO BOTTOM COURSE OF PAVEMENT TO BE MADE DURING THE SAME WORKDAY AS PLACEMENT

* JOINT IS TO BE LOCATED ACCURATELY BY STRING LINING, OR OTHER MEANS, PRIOR TO PAVING, SO THAT THE SAW CUTS WILL BE MADE DIRECTLY OVER THE END OF THE CONCRETE DECK. JOINT SHALL BE CUT DRY IN A SINGLE PASS AND BE SEALED WITHIN 24 HOURS OR PRIOR TO EXPOSURE TO TRAFFIC. JOINT SHALL BE CLEANED PRIOR TO APPLYING THE JOINT SEALER.

HOT POURED JOINT SHALL BE PAID FOR UNDER ITEM 524.II JOINT SEALER, HOT POURED.

MISCELLANEOUS DETAILS

PROJECT NAME: JERICHO
PROJECT NUMBER: STP FTBR (3)

PROJECT LEADER: M.D.S.
DESIGNED BY: D.M.D.

PLOT DATE: 4/7/2014
DRAWN BY: D.M.D.
CHECKED BY: P.M.P.
SHEET 38 OF 62

