




10+15.30  
BEGIN PROJECT 10+15.30

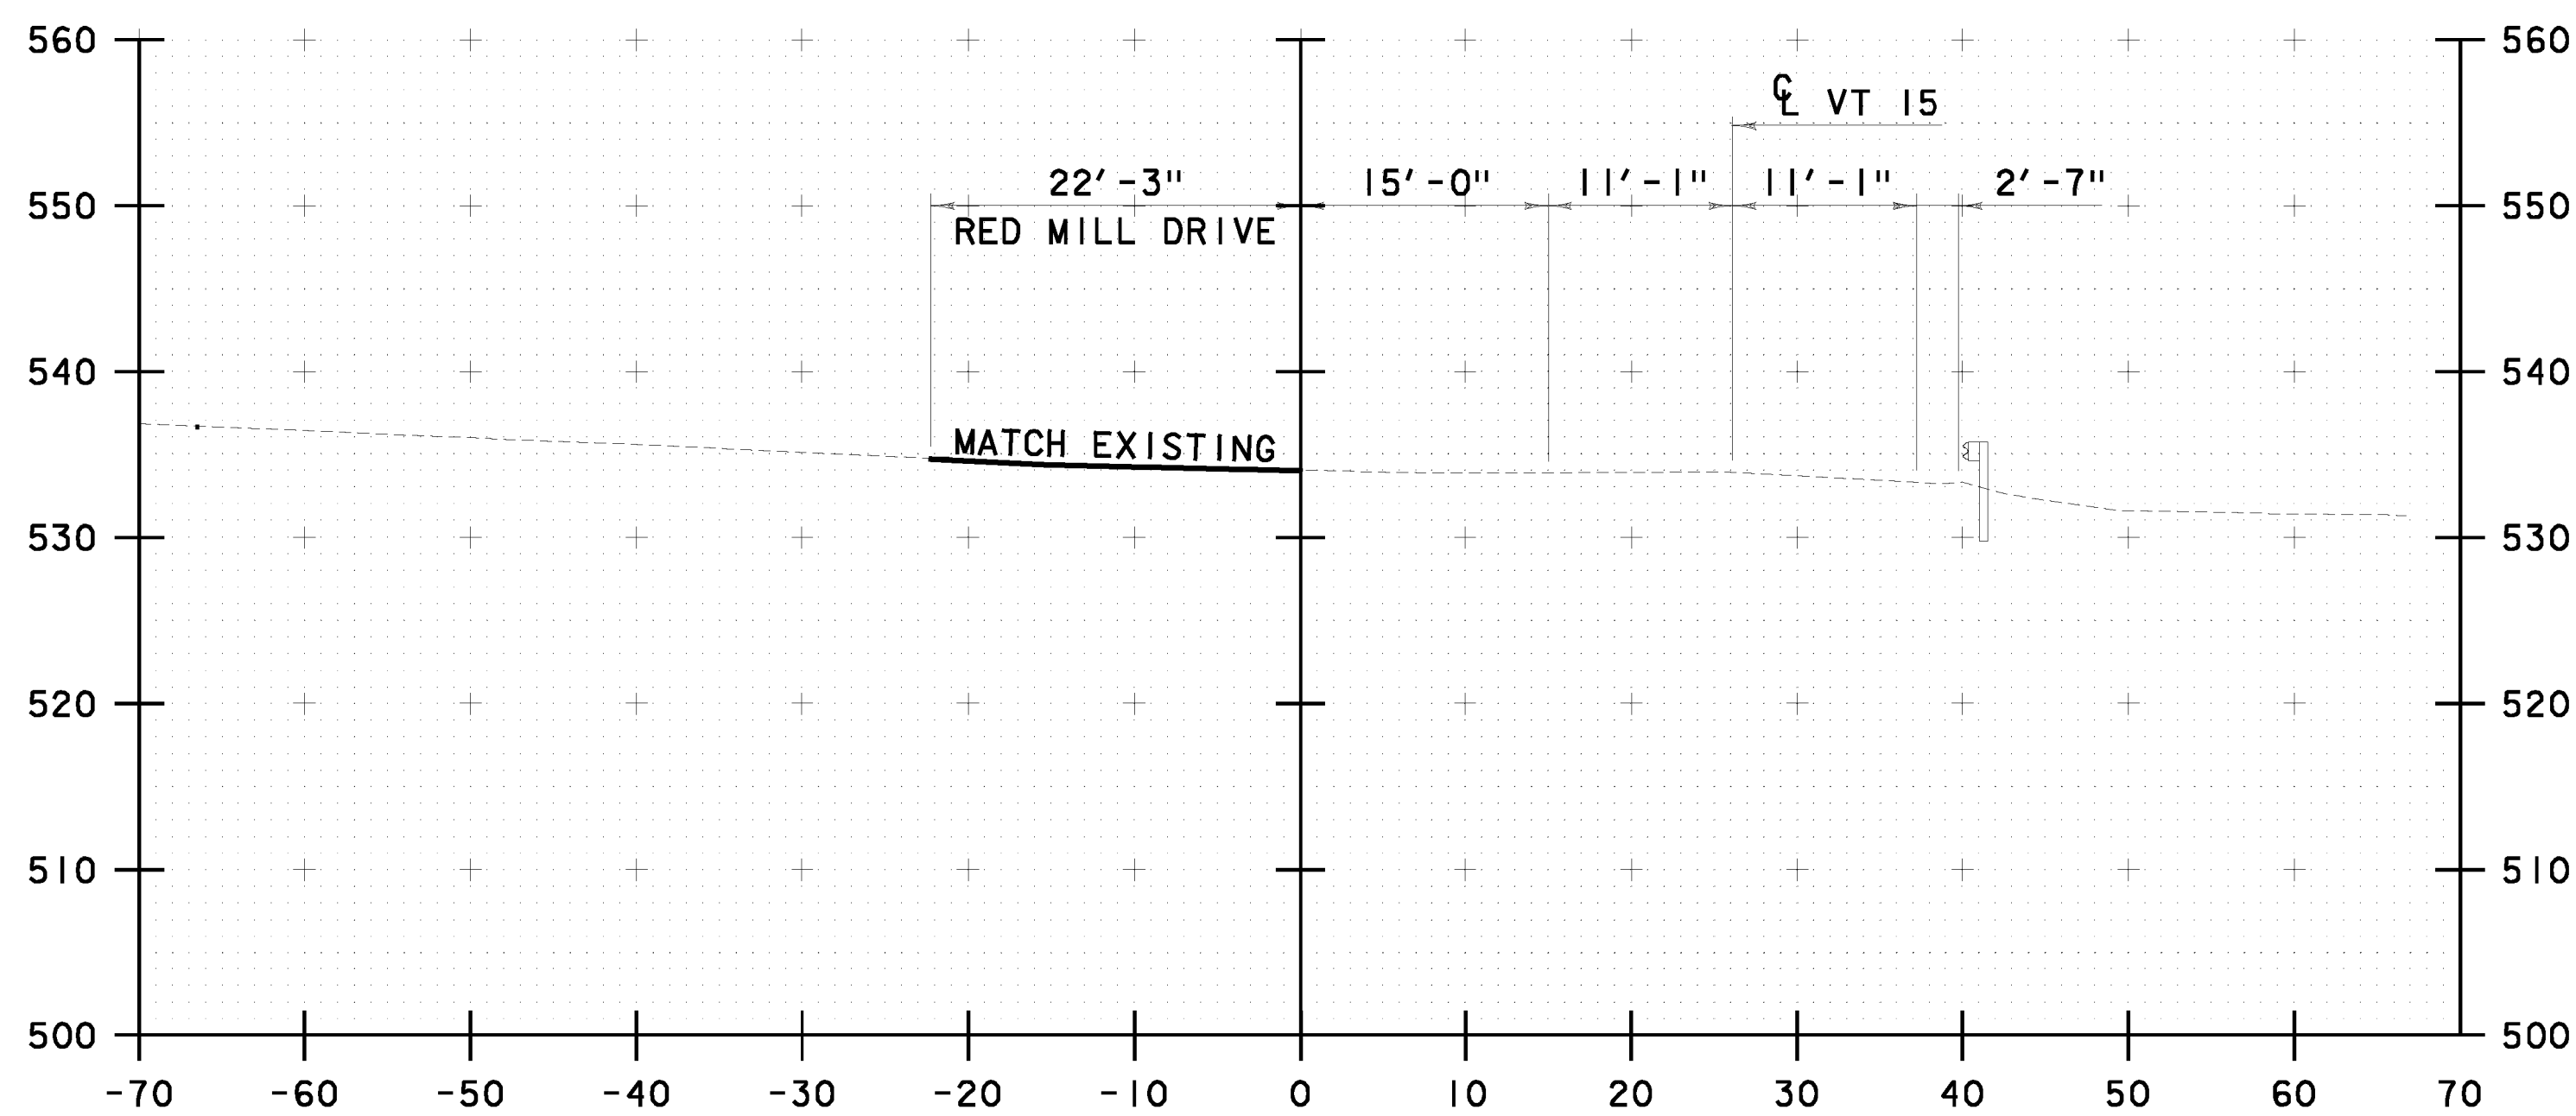

10+07  
BEGIN APPROACH 10+07.00

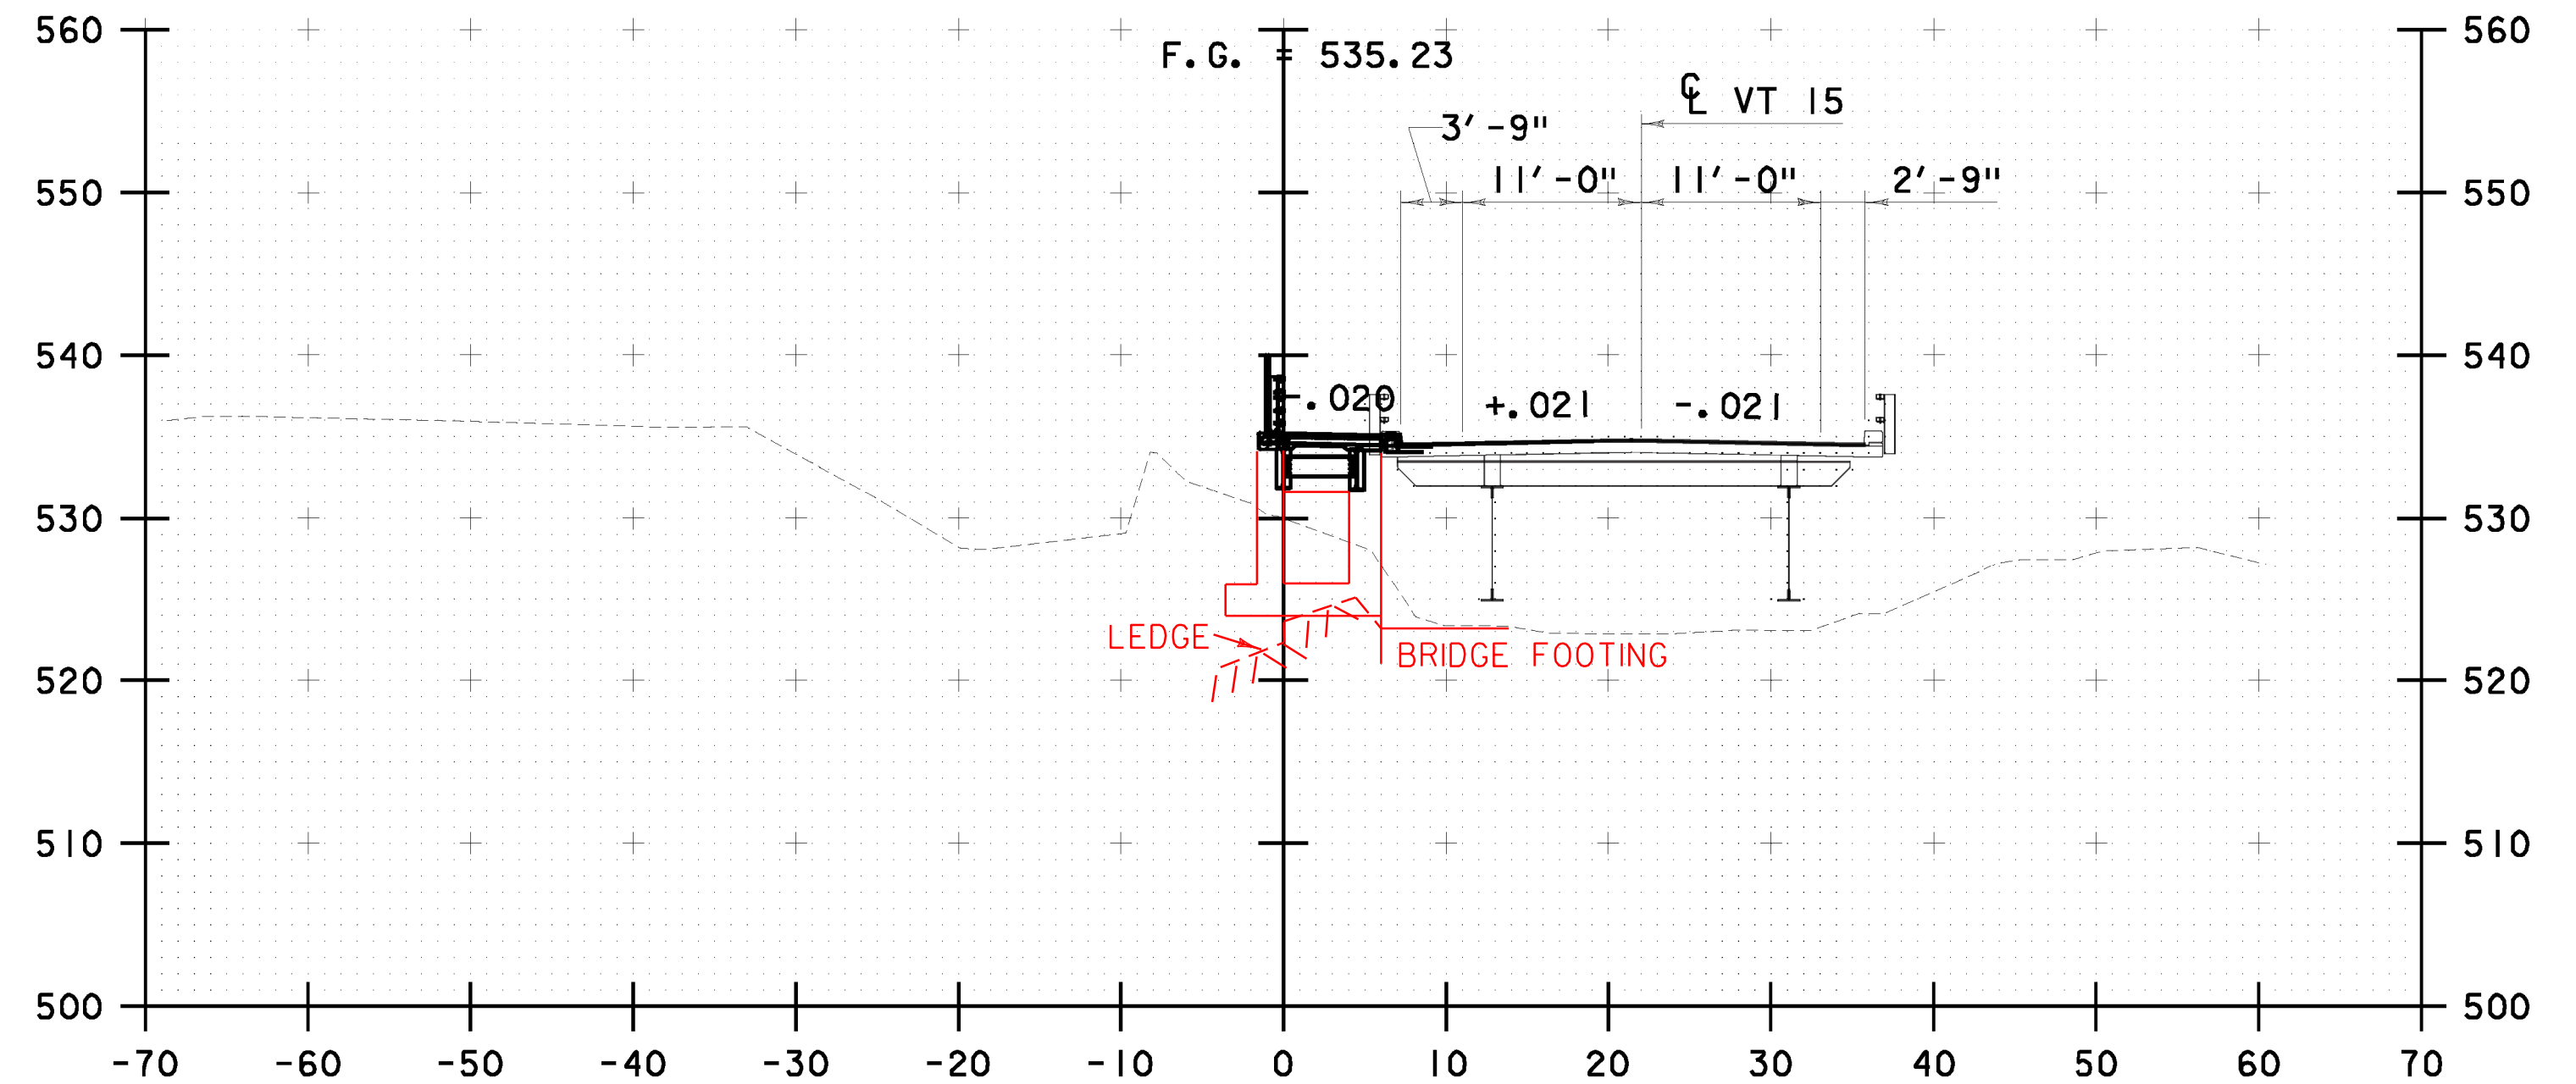

10+34  
BEGIN BRIDGE 10+34.00

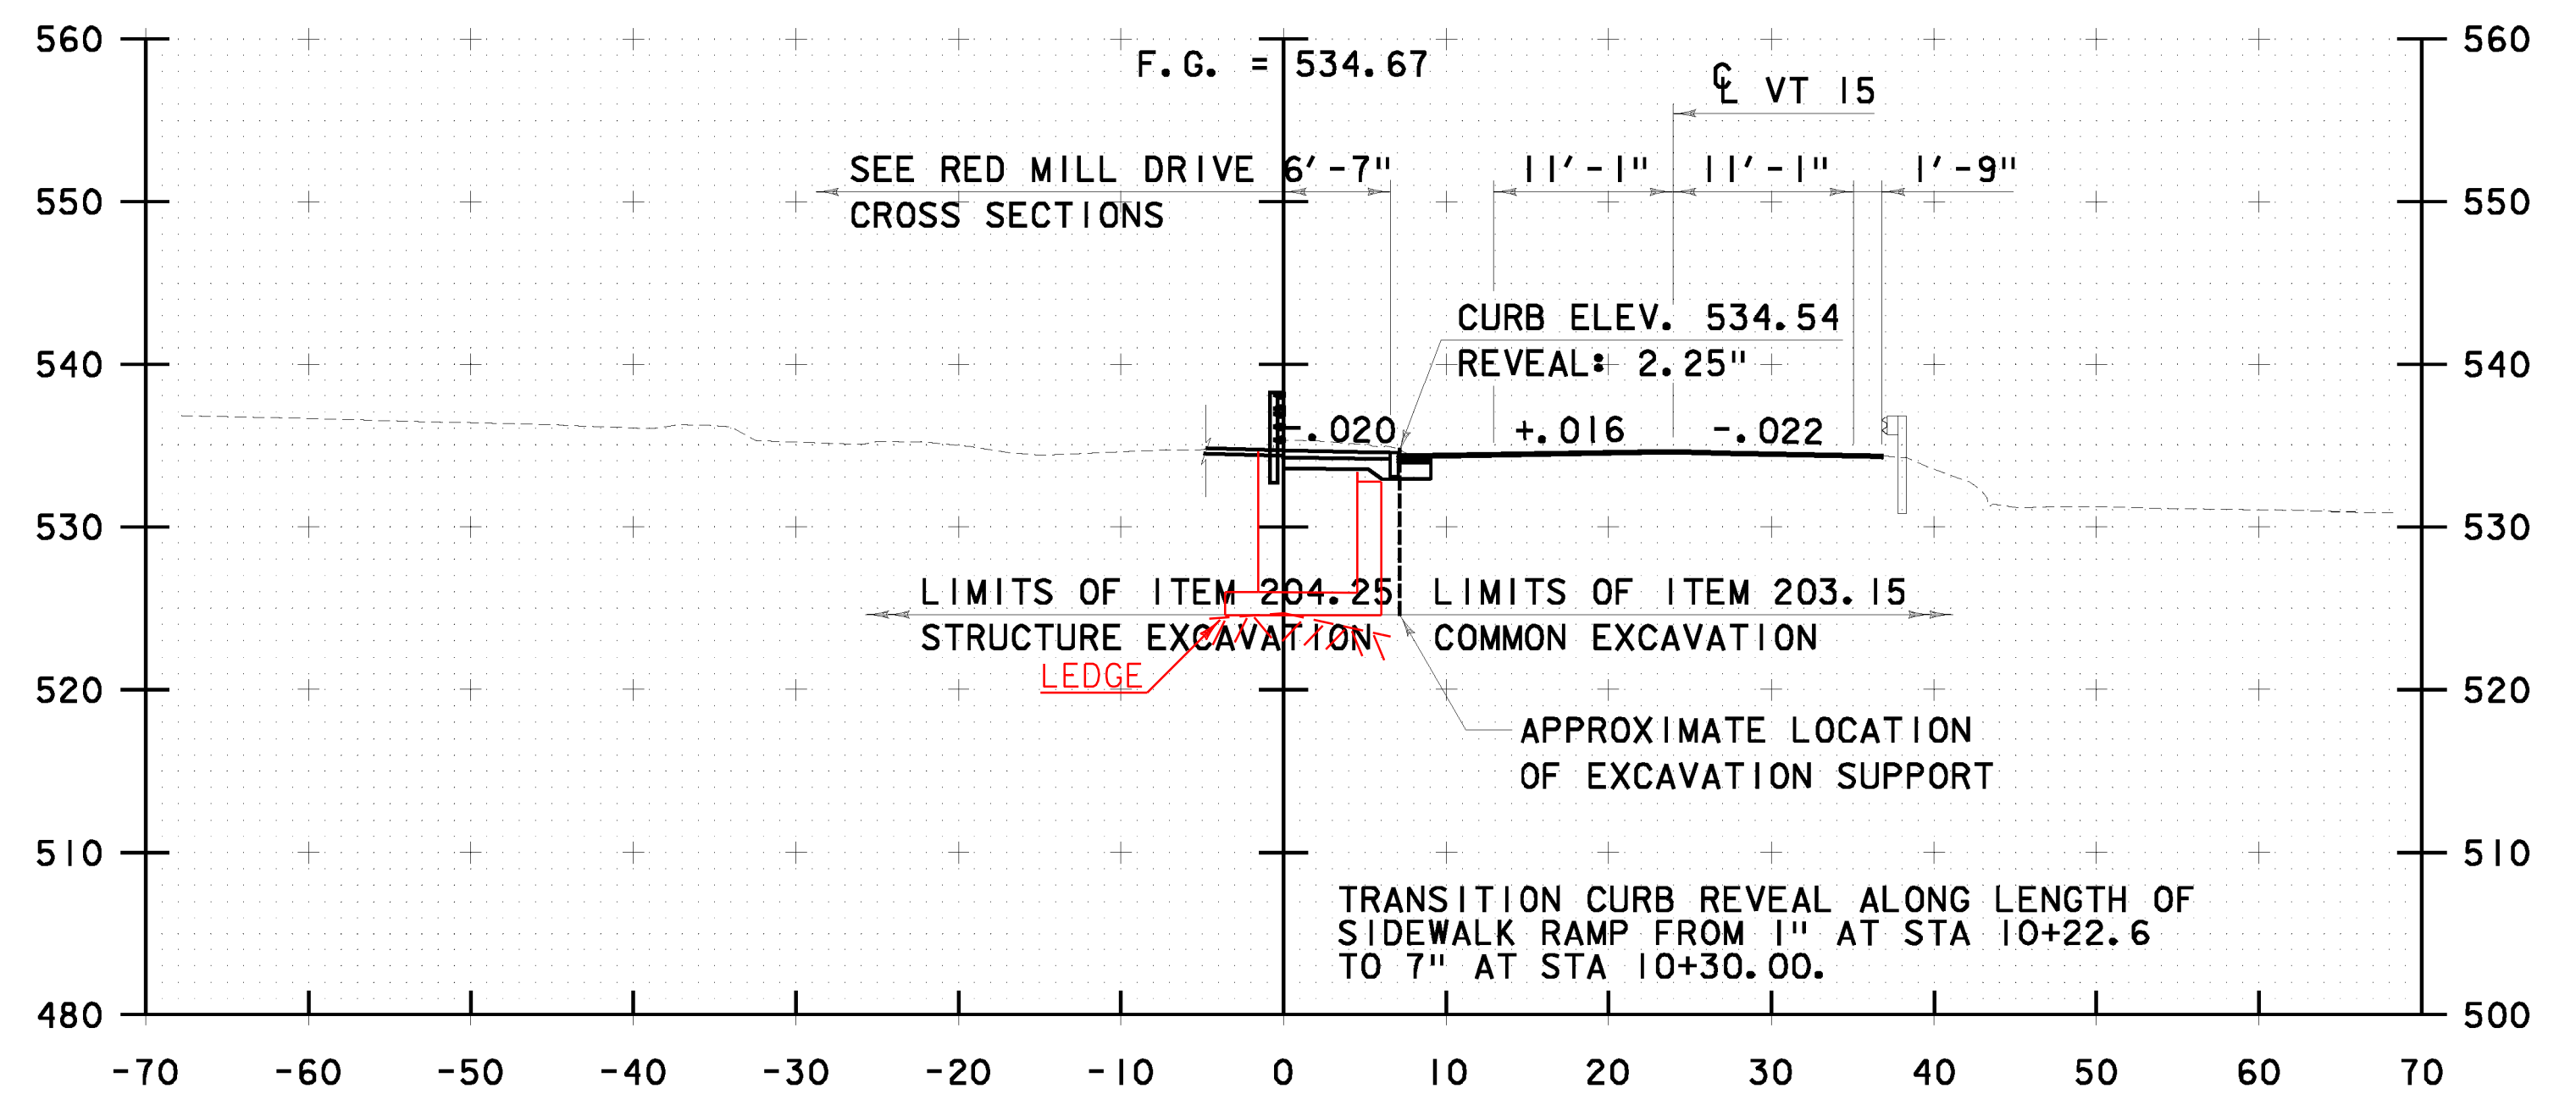

10+25

SCALE 1" = 10'-0"  
10 0 10



**PEDESTRIAN  
BRIDGE/  
SIDEWALK  
CROSS  
SECTIONS #1**

PROJECT NAME: JERICHO  
PROJECT NUMBER: STP FTBR (3)

PROJECT LEADER: M.D.S.  
DESIGNED BY: C.R.H.  
DWG. NO.: PBXS-1

PLOT DATE: 4/7/2014  
DRAWN BY: C.R.H.  
CHECKED BY: D.E.G.  
SHEET 44 OF 62

STA 10+07 TO STA 10+34

FILE NAME: V:\Projects\ANY\K2\21113\CADD\MSTN\_08F004\Consultants\10B1\004\SL.dgn  
DATE/TIME: 4/7/2014  
USER: 4916