




10+75

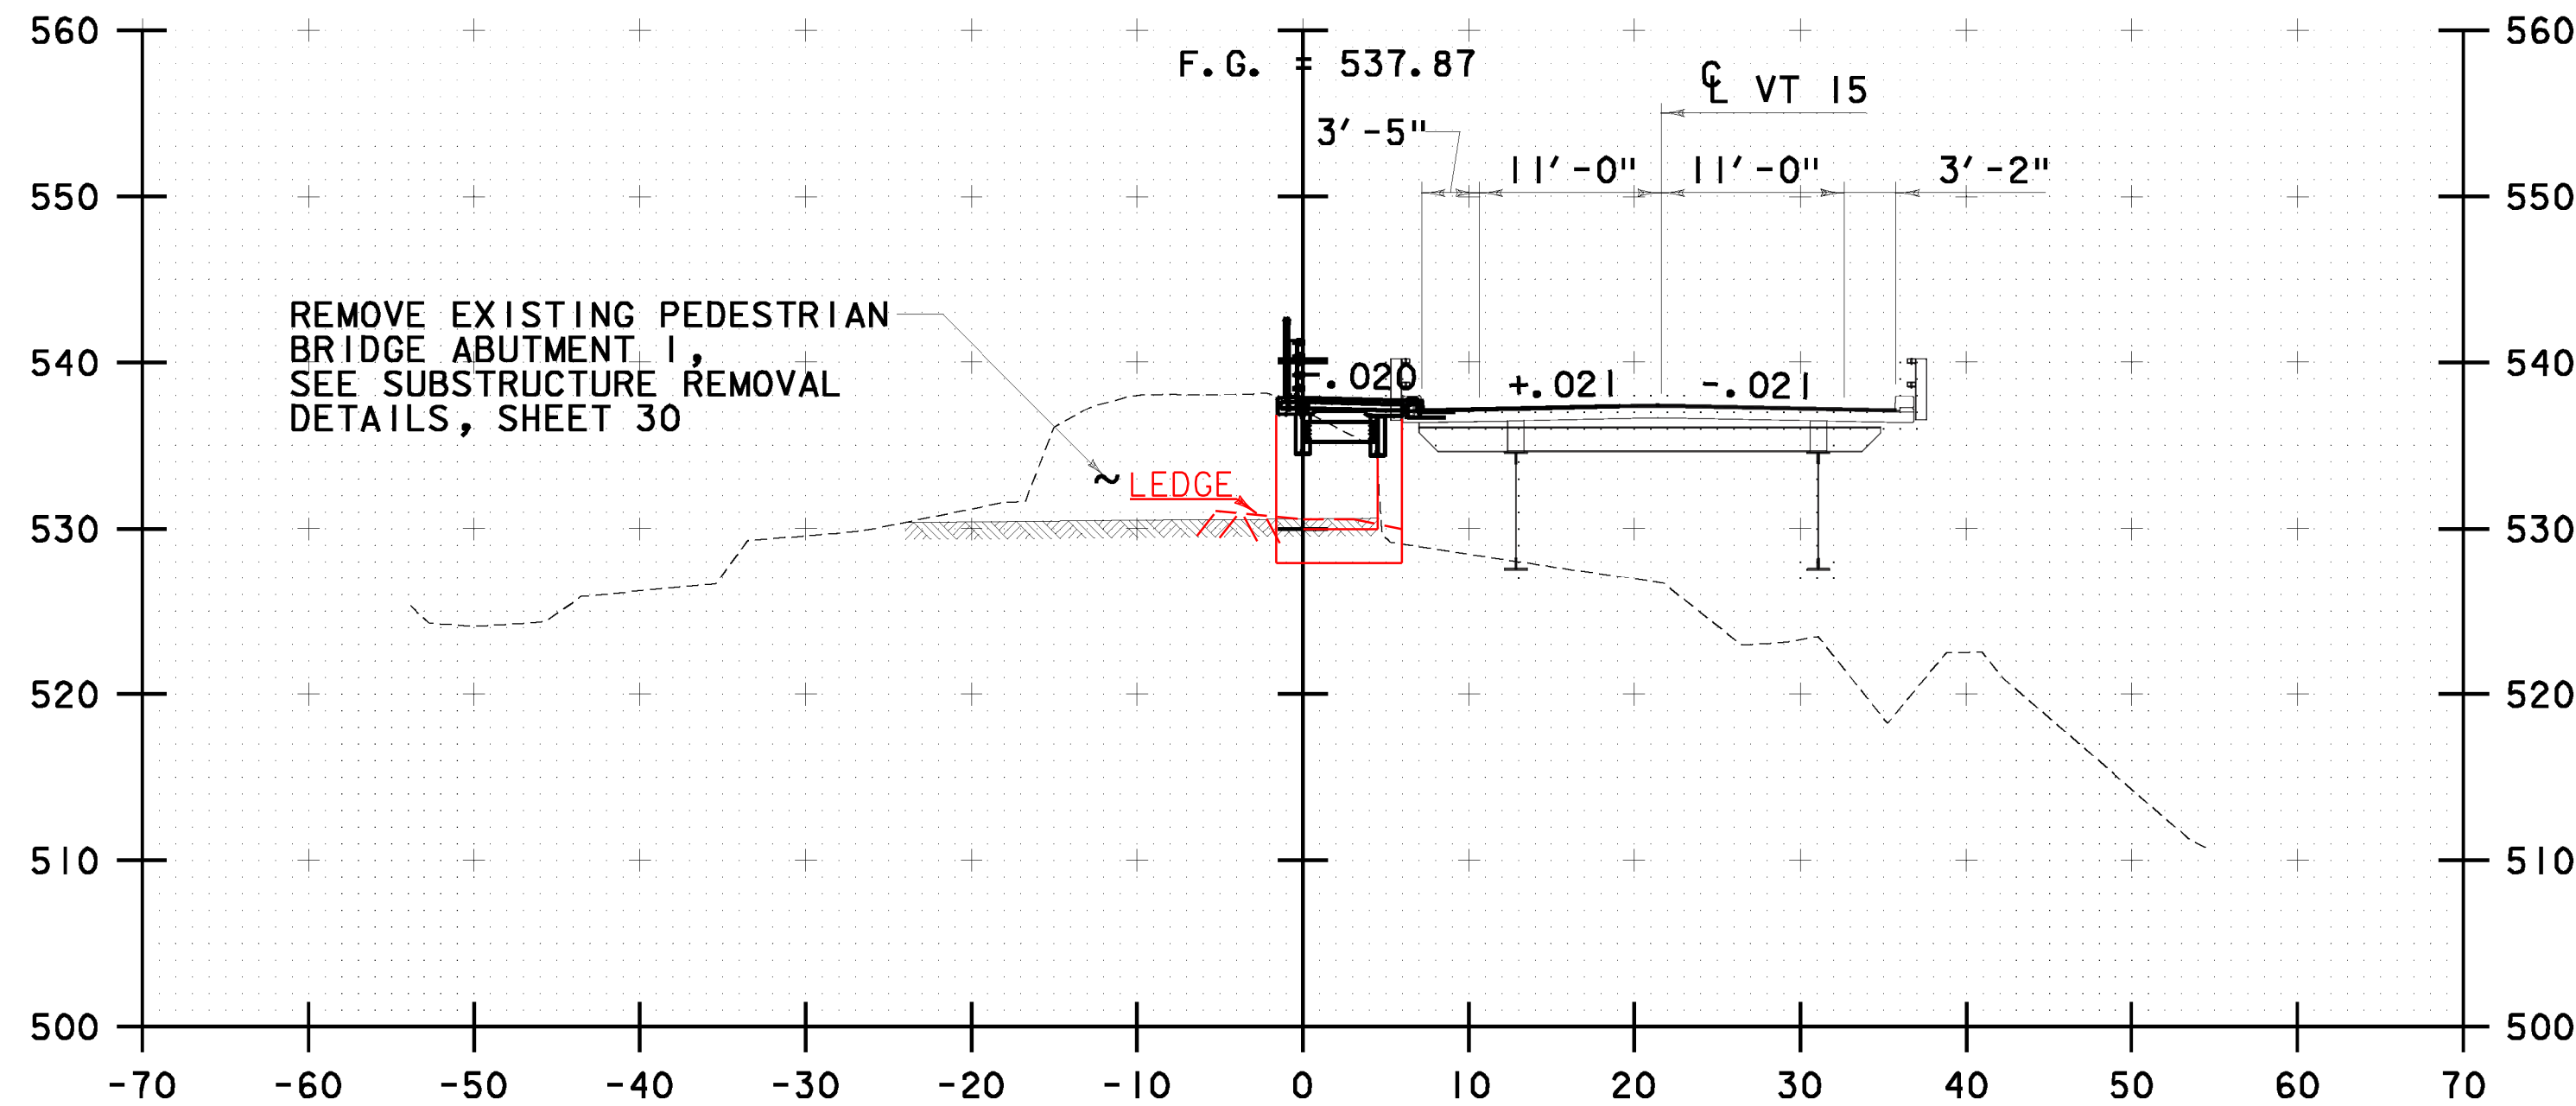

11+06
END BRIDGE 11+06.00

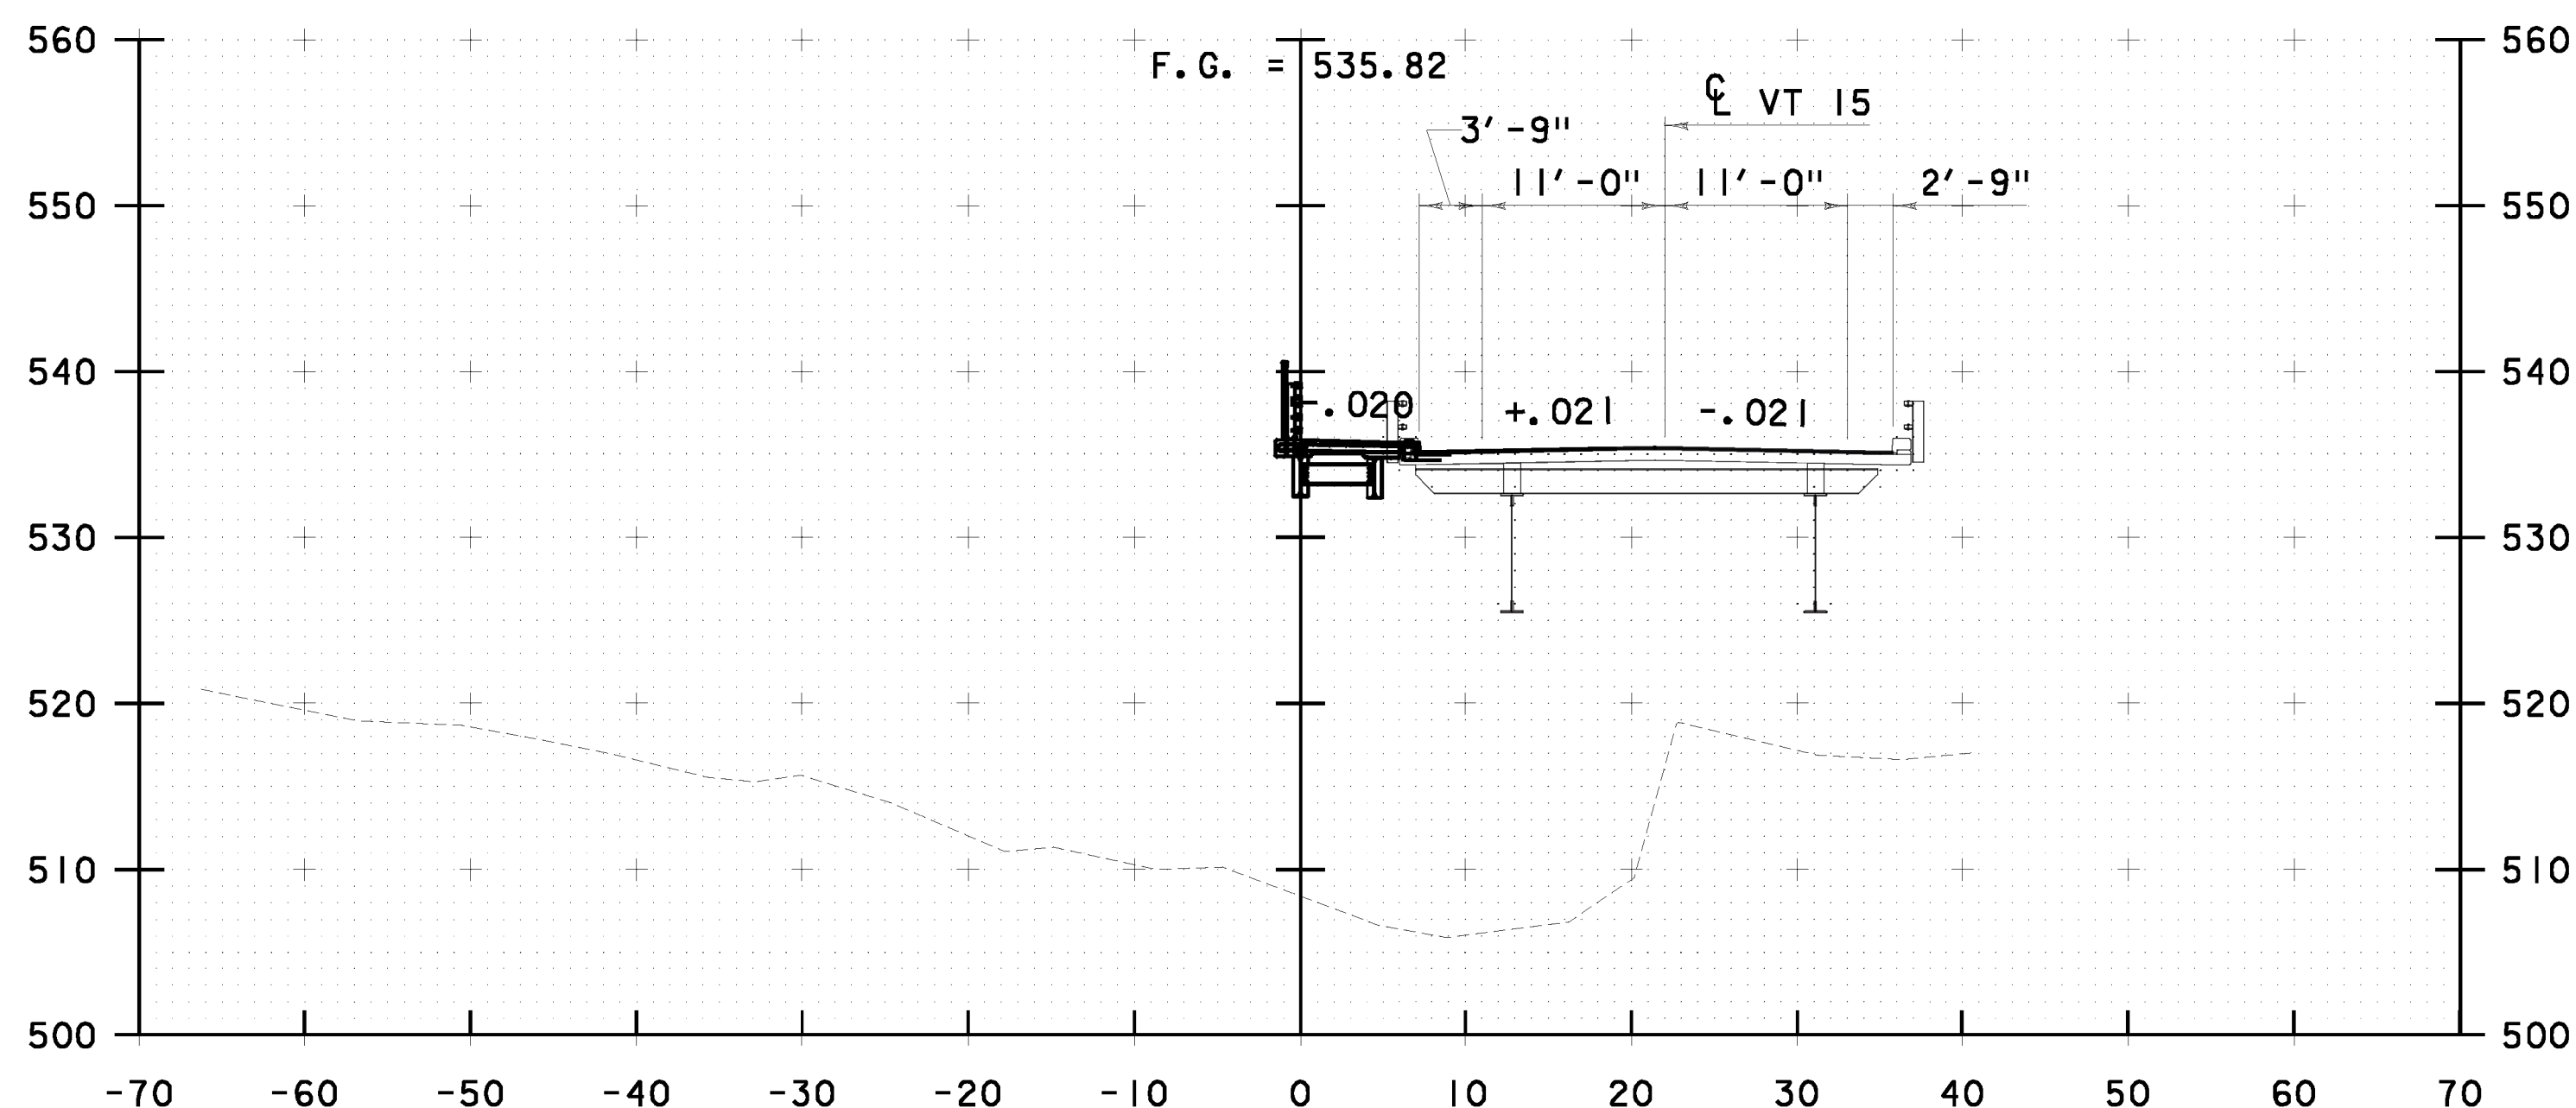


10+50

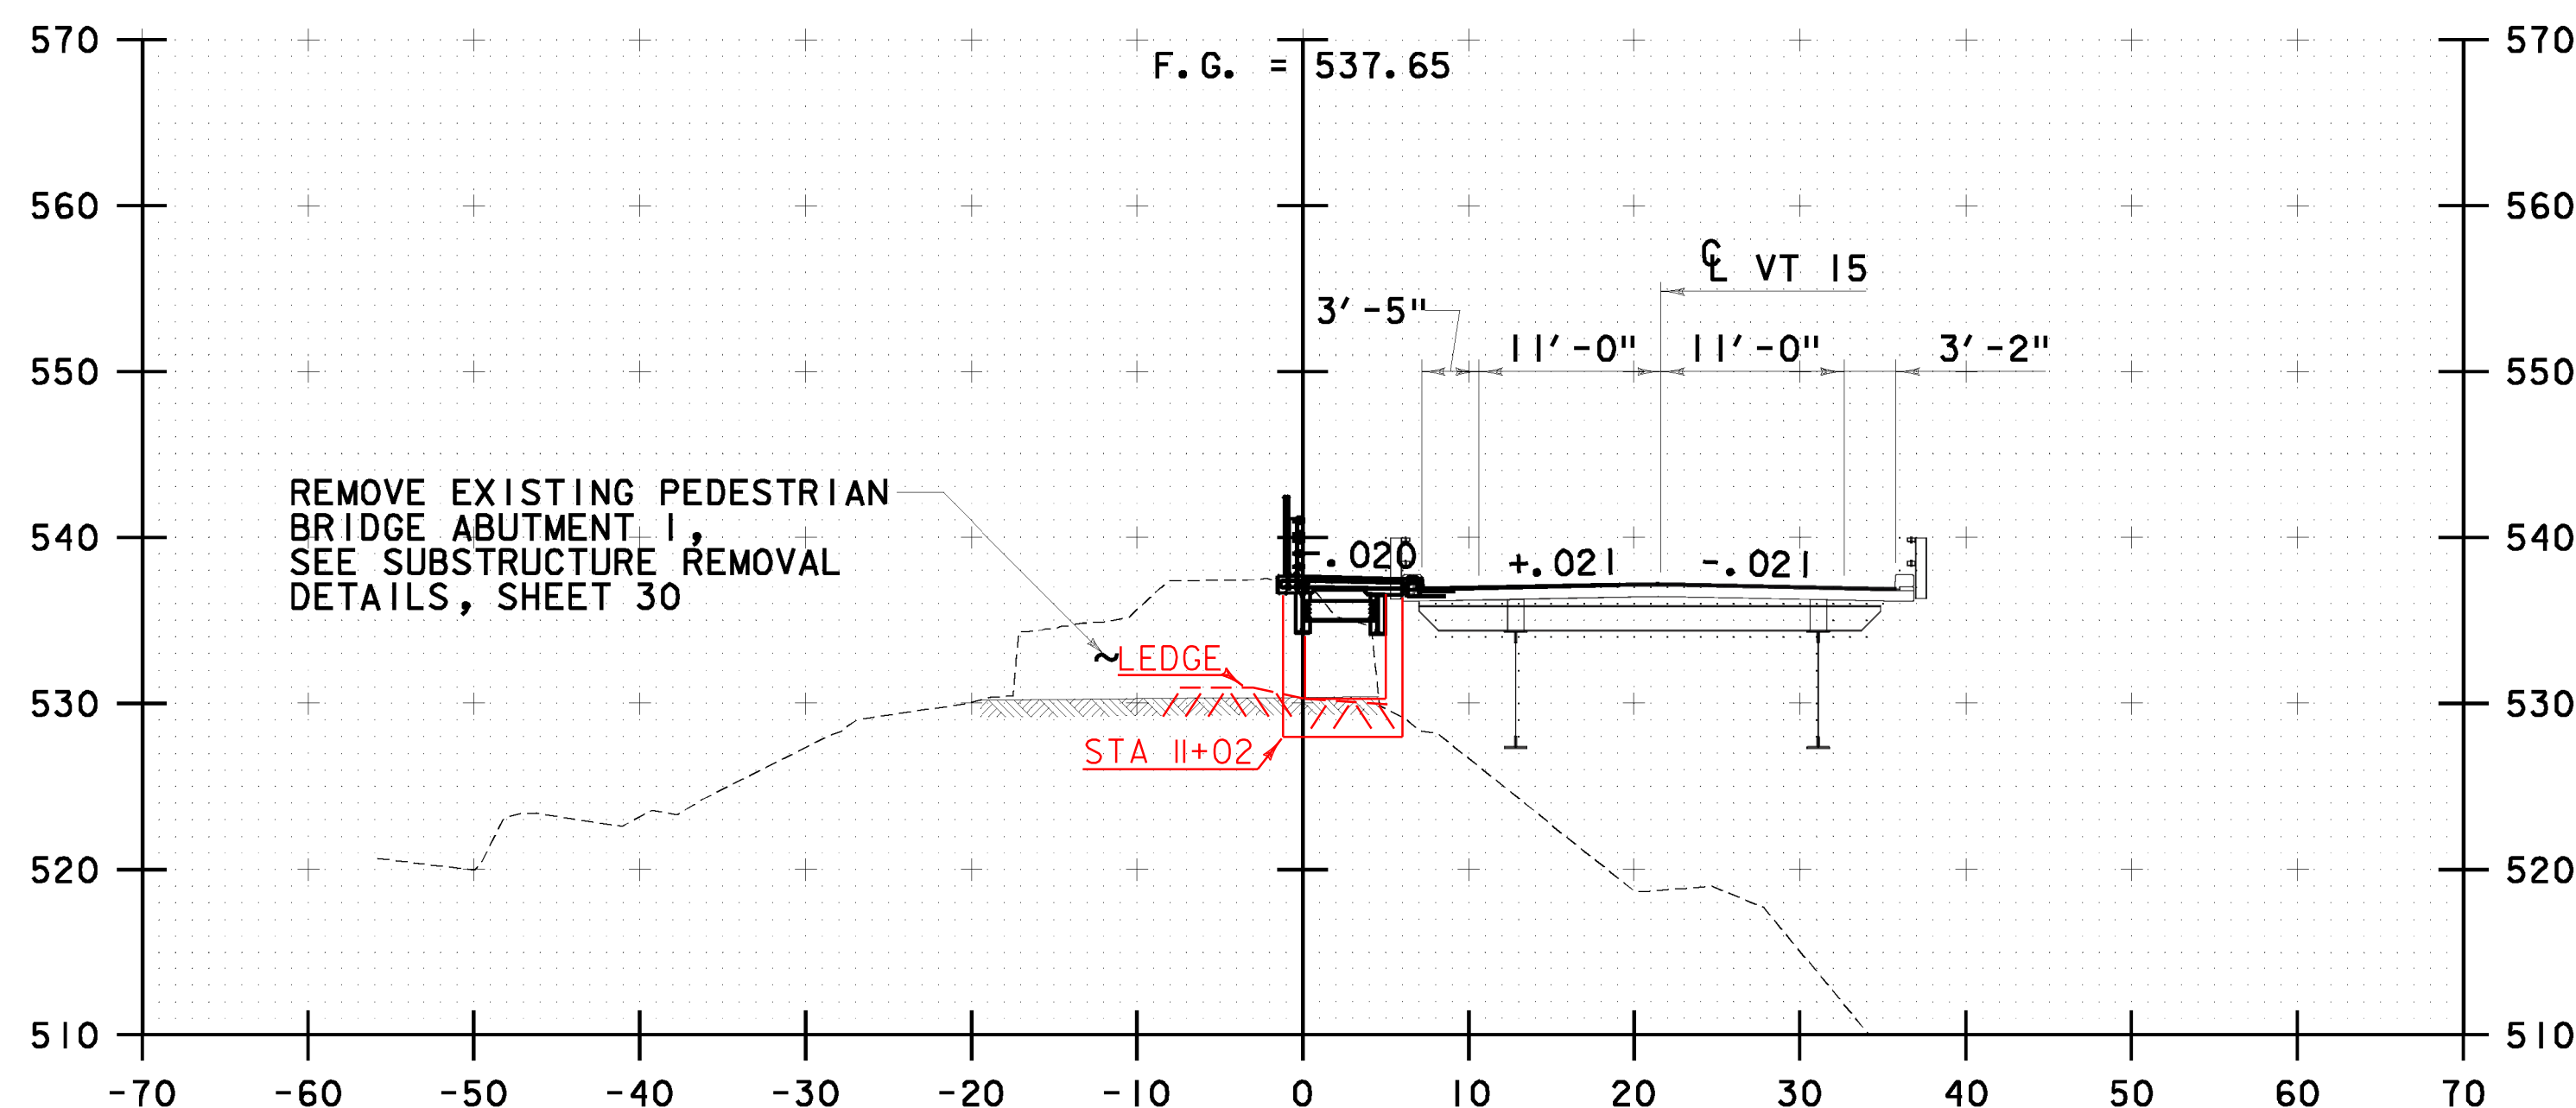

11+00

FILE NAME = V:\Projects\ANY\K2\21113\CA00\MSTN_08F004\Consultants\08F004\K52.dgn
 DATE/TIME = 4/7/2014
 USER = 4916

STA 10+50 TO STA 11+06

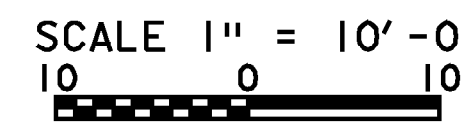

**PEDESTRIAN
BRIDGE/
SIDEWALK
CROSS
SECTIONS #2**

PROJECT NAME: JERICHO	PROJECT NUMBER: STP FTBR (3)
PROJECT LEADER: M.D.S.	DESIGNED BY: C.R.H.
DWG. NO.: PBXS-2	
PLOT DATE: 4/7/2014	DRAWN BY: C.R.H.
	CHECKED BY: D.E.G.
	SHEET 45 OF 62