




11+25

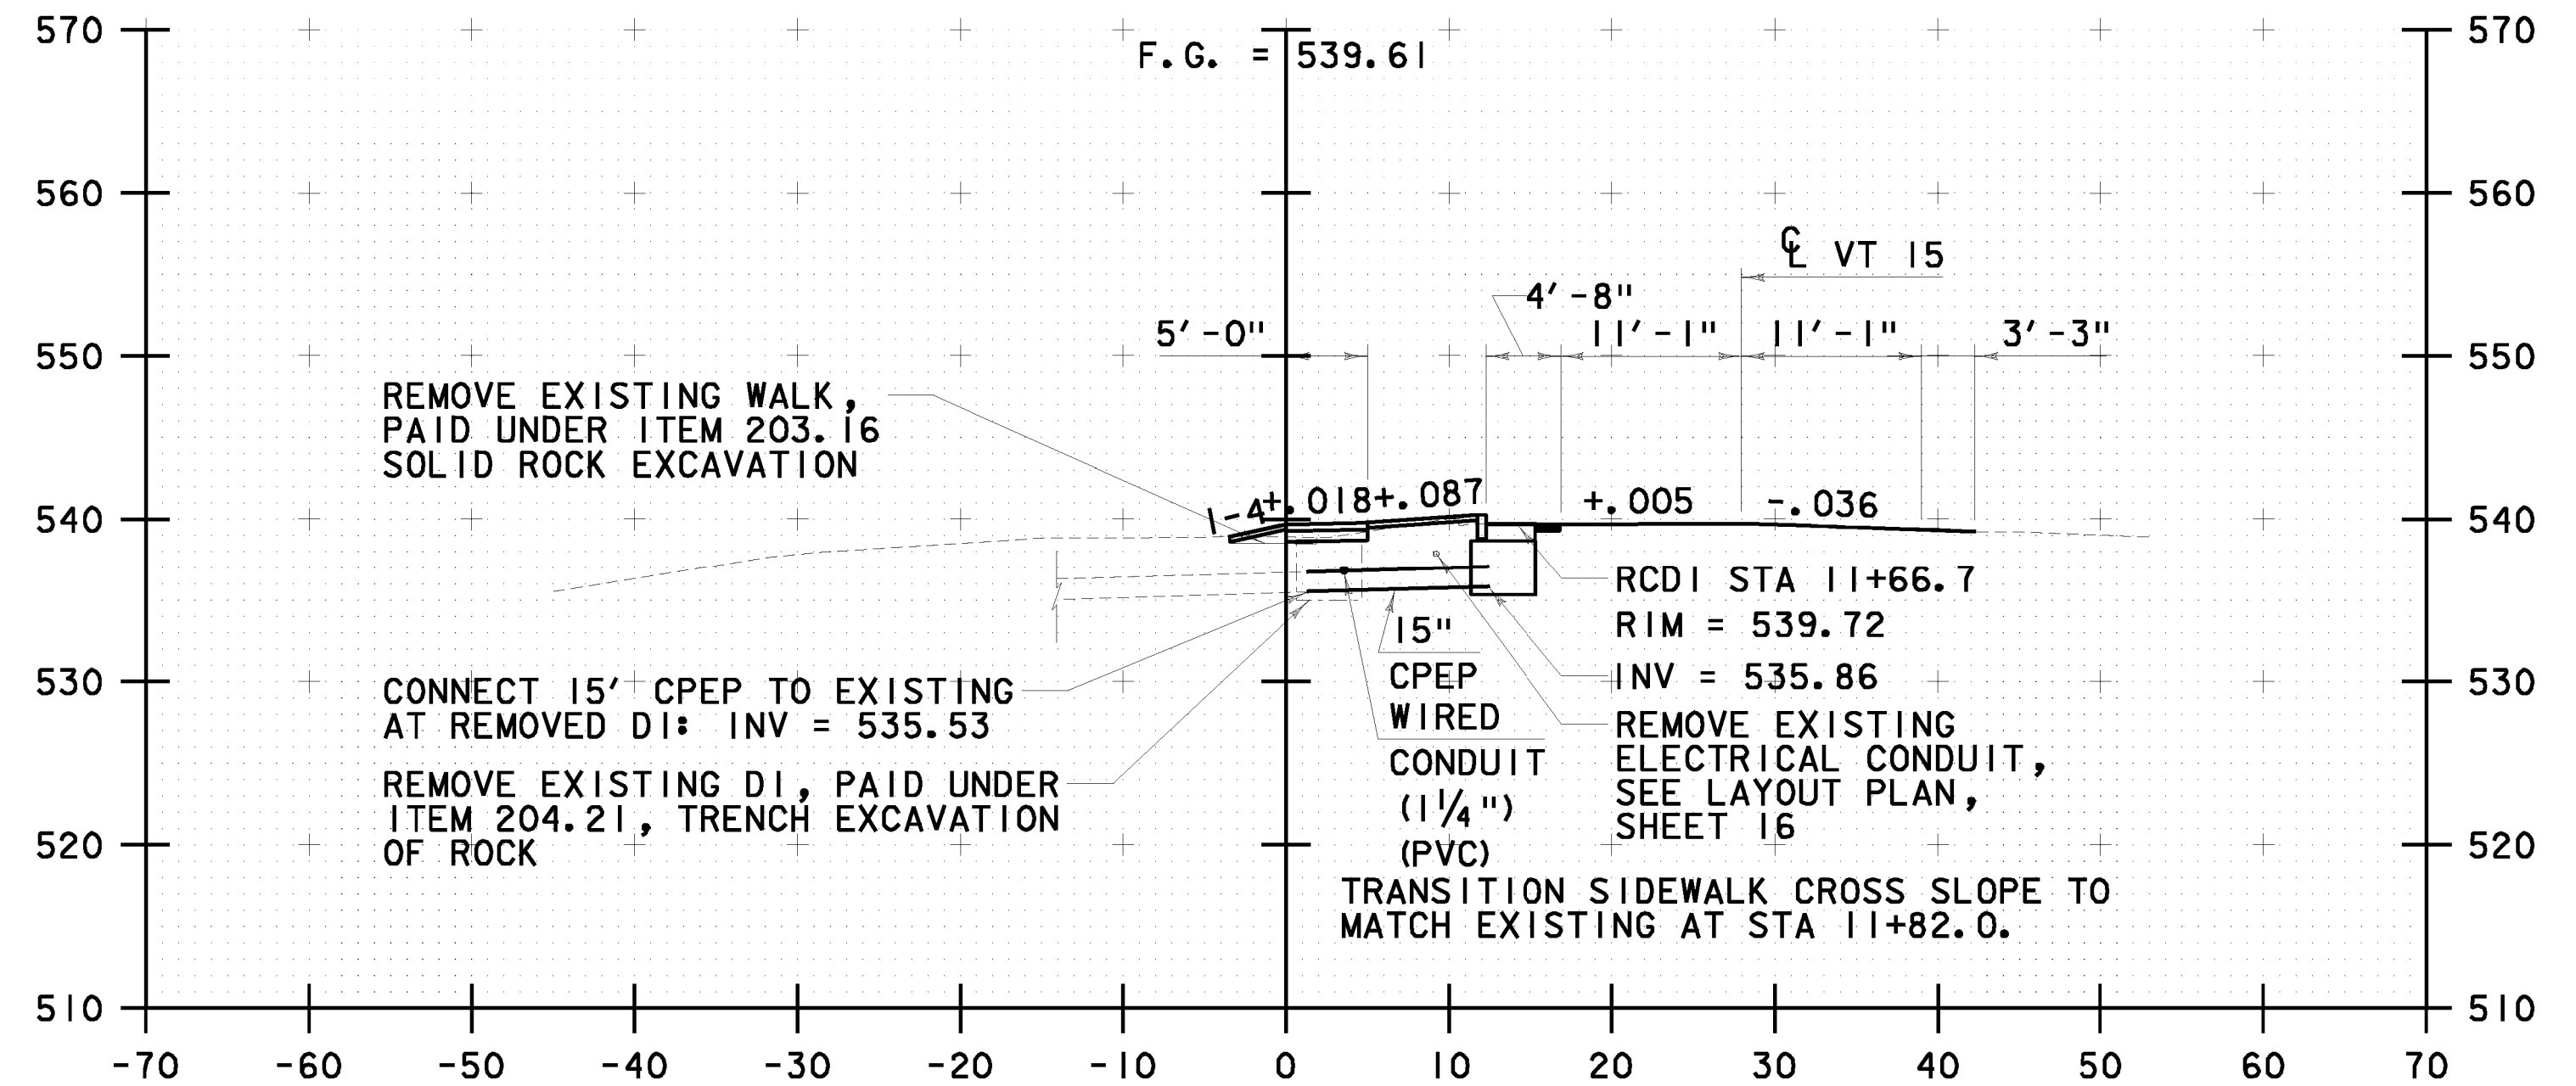

11+66.70

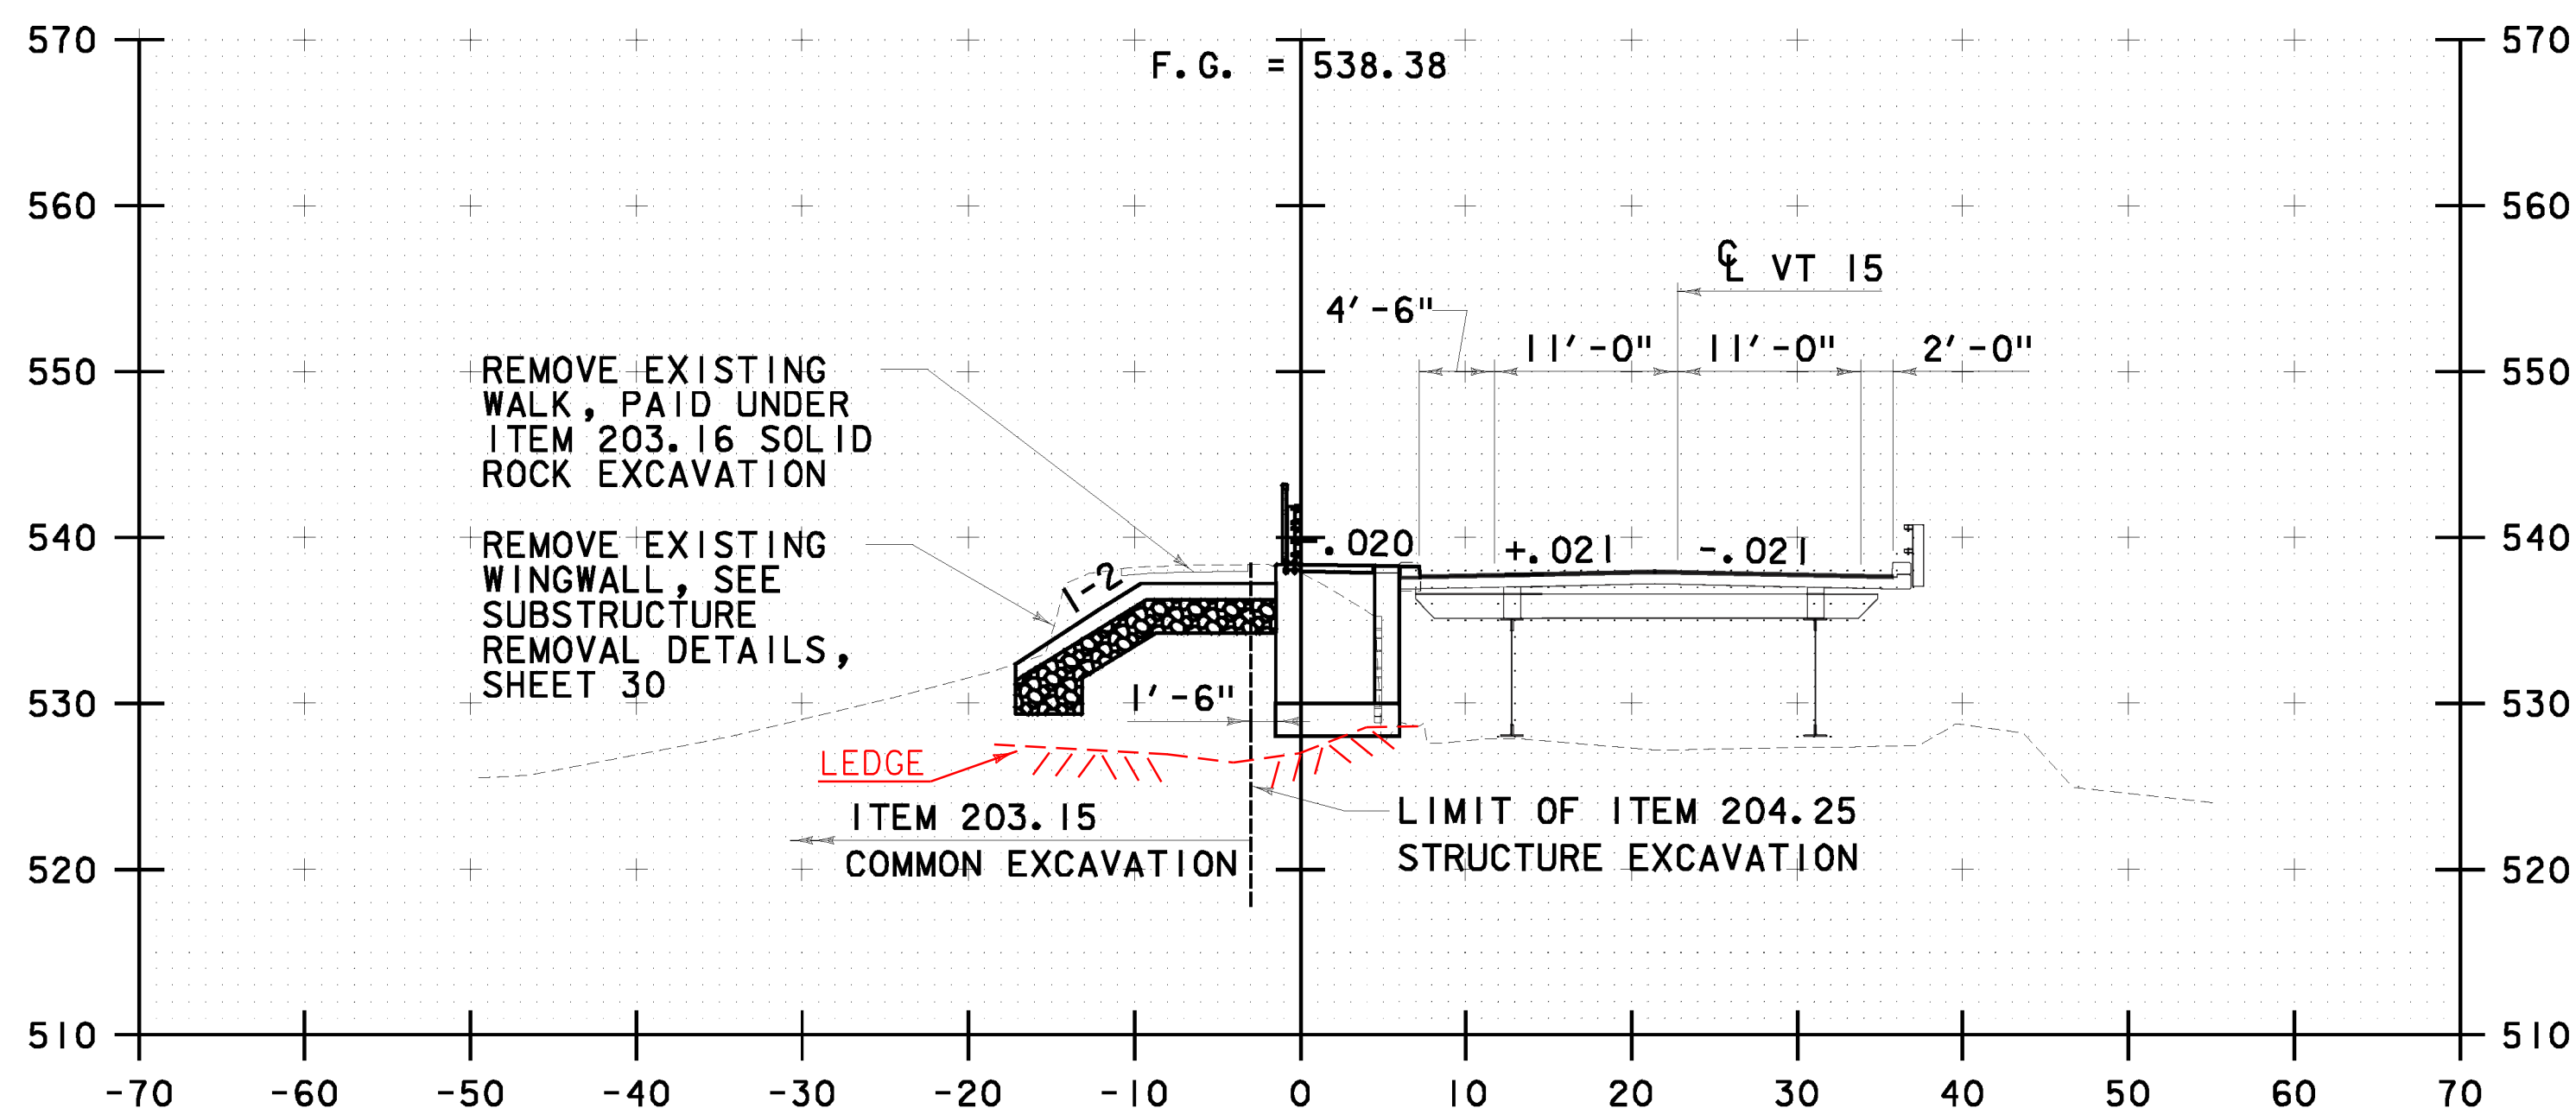


11+20

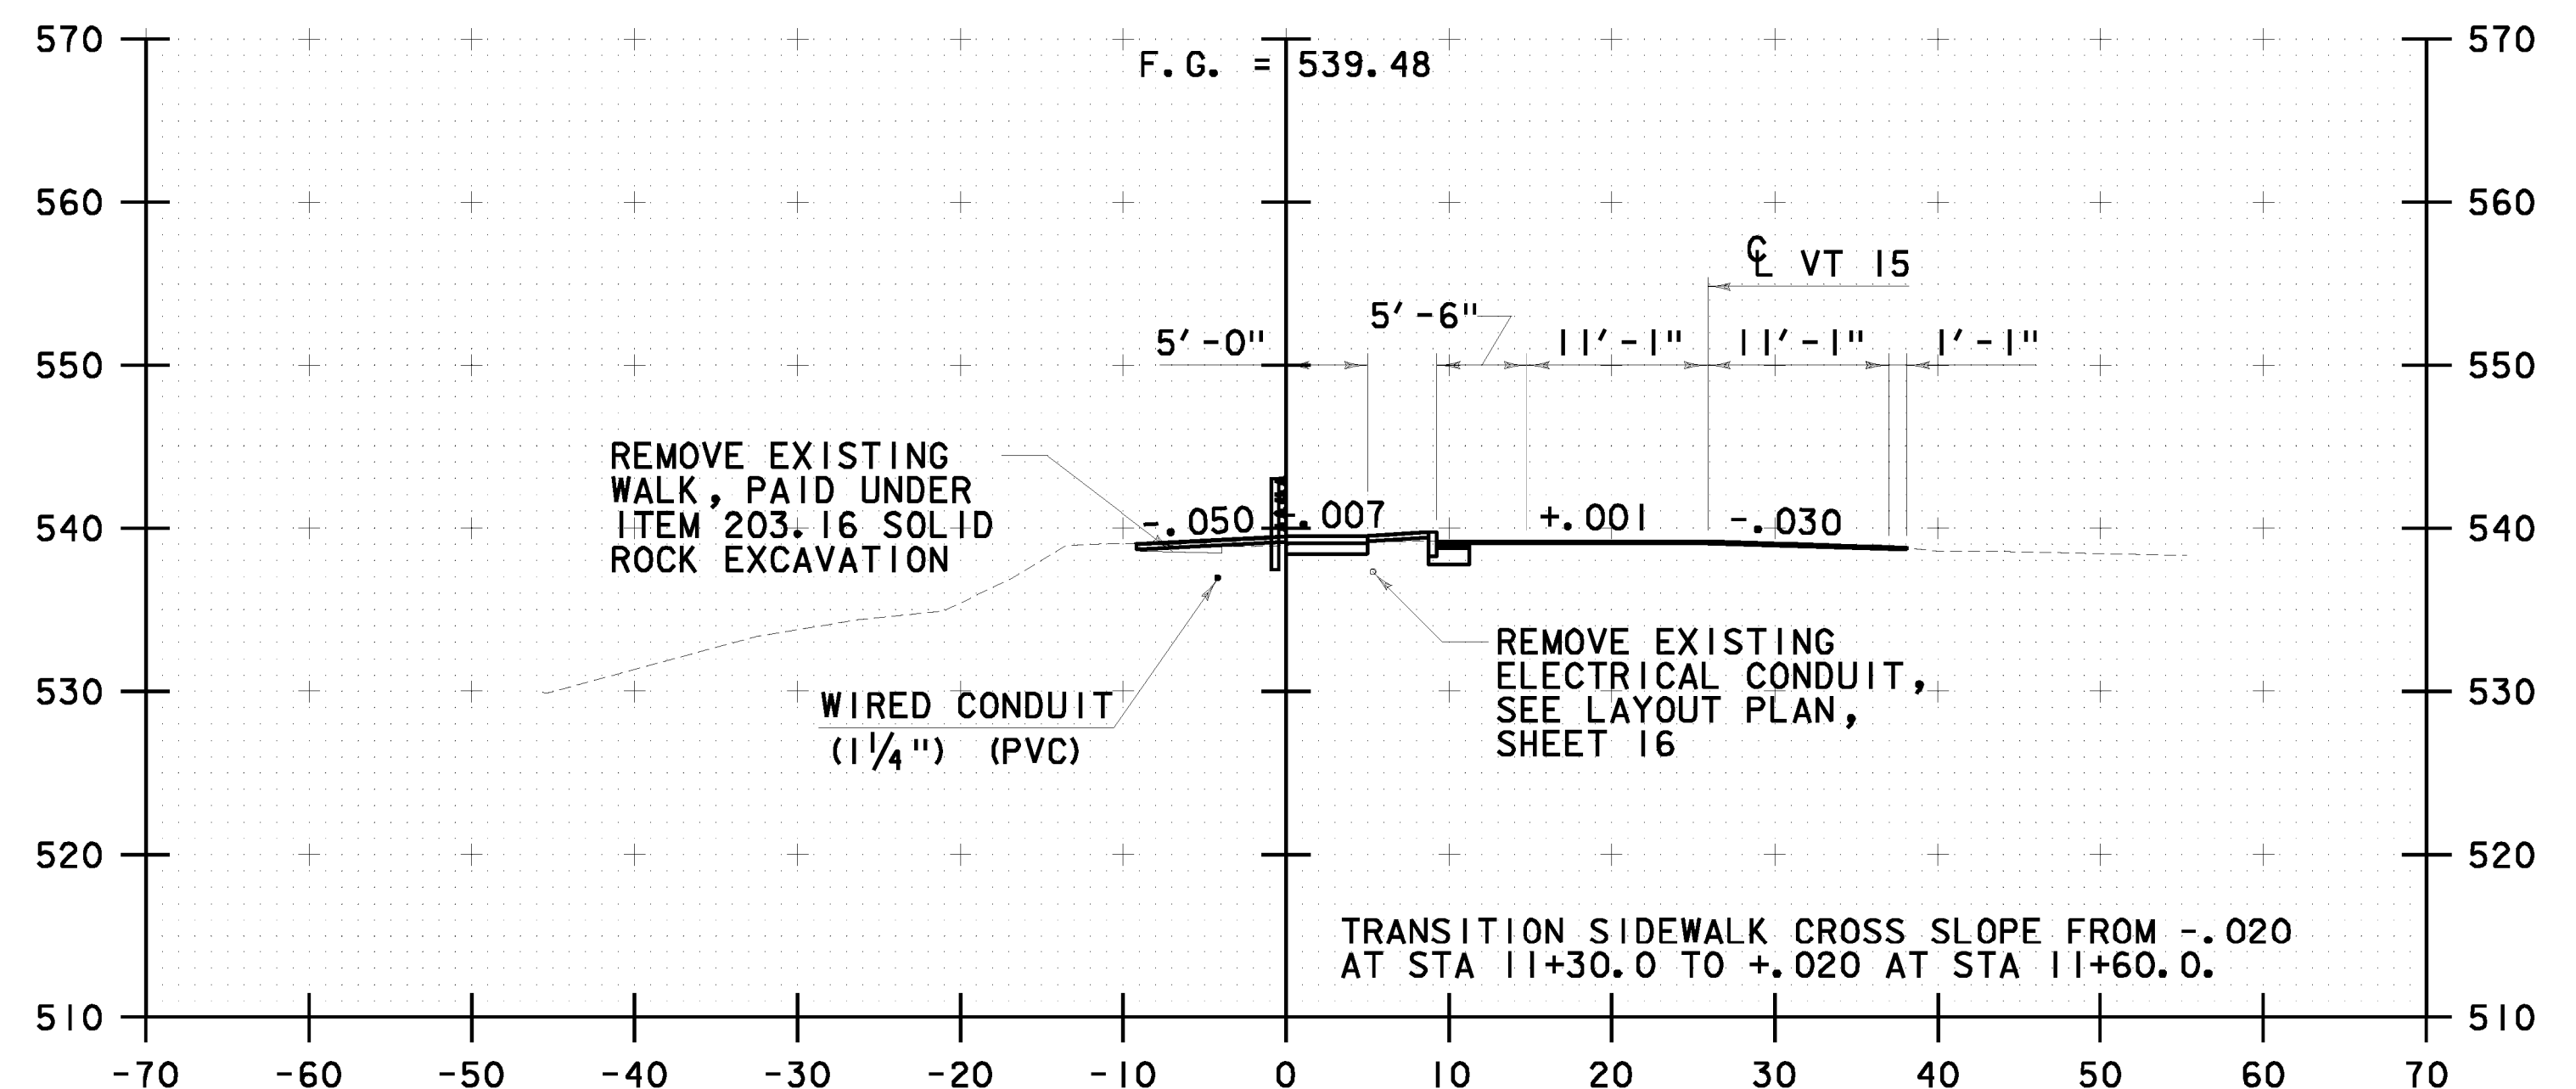

11+50

FILE NAME = V:\Projects\ANY\K2\21113\CA00\WSTN\08F004\Consultants\1081004\K53.dgn
 DATE/TIME = 4/7/2014
 USER = 4916

STA 11+20 TO STA 11+66.70

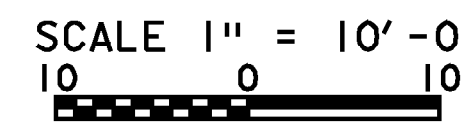

**PEDESTRIAN
 BRIDGE/
 SIDEWALK
 CROSS
 SECTIONS #3**

PROJECT NAME: JERICHO	PROJECT NUMBER: STP FTBR (3)
PROJECT LEADER: M.D.S.	DESIGNED BY: C.R.H.
DWG. NO.: PBXS-3	PLOT DATE: 4/7/2014
	DRAWN BY: C.R.H.
	CHECKED BY: D.E.G.
	SHEET 46 OF 62